


5+015.00

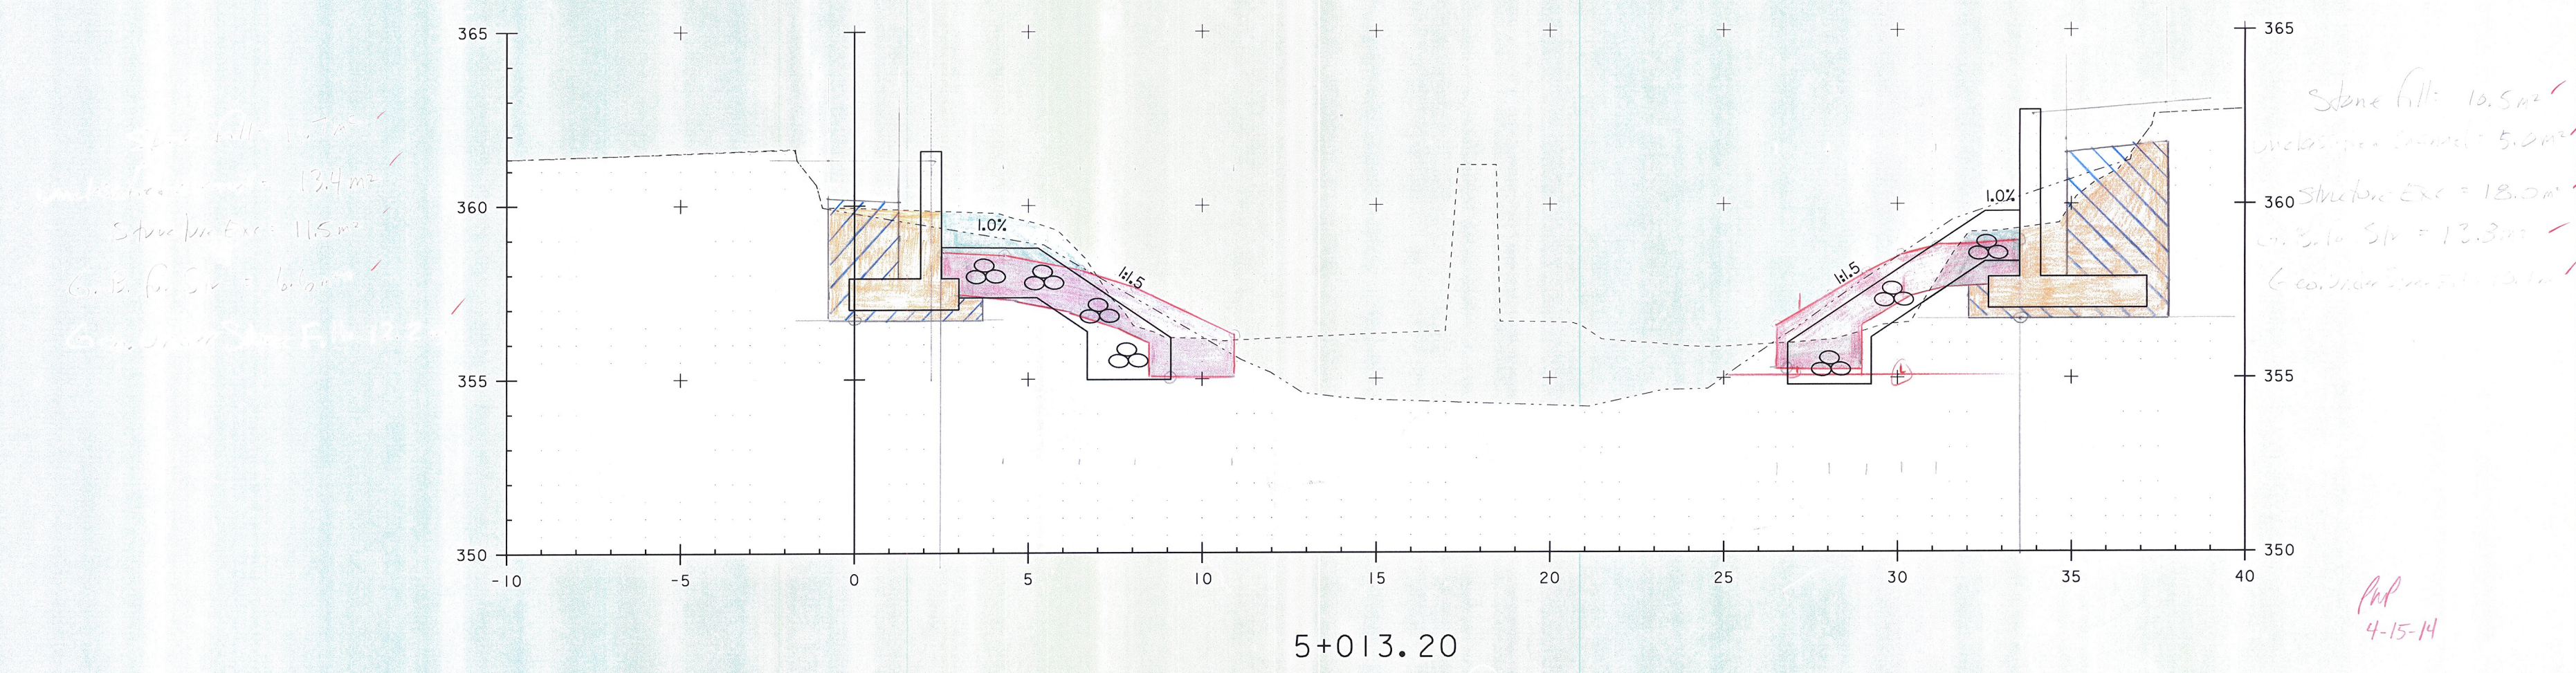

5+013.20

MLP  
4-15-14

SURFACE LEGEND	
-----	OG 2012
-----	OG 2009

PROJECT NAME: READSBORO  
 PROJECT NUMBER: BRF 0105(3) 300  
 FILE NAME: s89j08channelCrossSections300.dwg DATE: 15-FEB-2013  
 PROJECT LEADER: J. LACROIX DRAWN BY: D. KARABEGOVIC  
 DESIGNED BY: ----- CHECKED BY: M. LONGSTREET  
 CH XS SHEET 5 SHEET 6 OF 11

STA. 5+013 TO STA. 5+015