




Stone fill: 11.4m³
 1.5m x 1.5m x 1.4m
 2.0m x 1.5m x 1.2m
 1.5m x 1.5m x 1.2m


Stone fill: 11.4m³
 1.5m x 1.5m x 1.4m
 2.0m x 1.5m x 1.2m
 1.5m x 1.5m x 1.2m

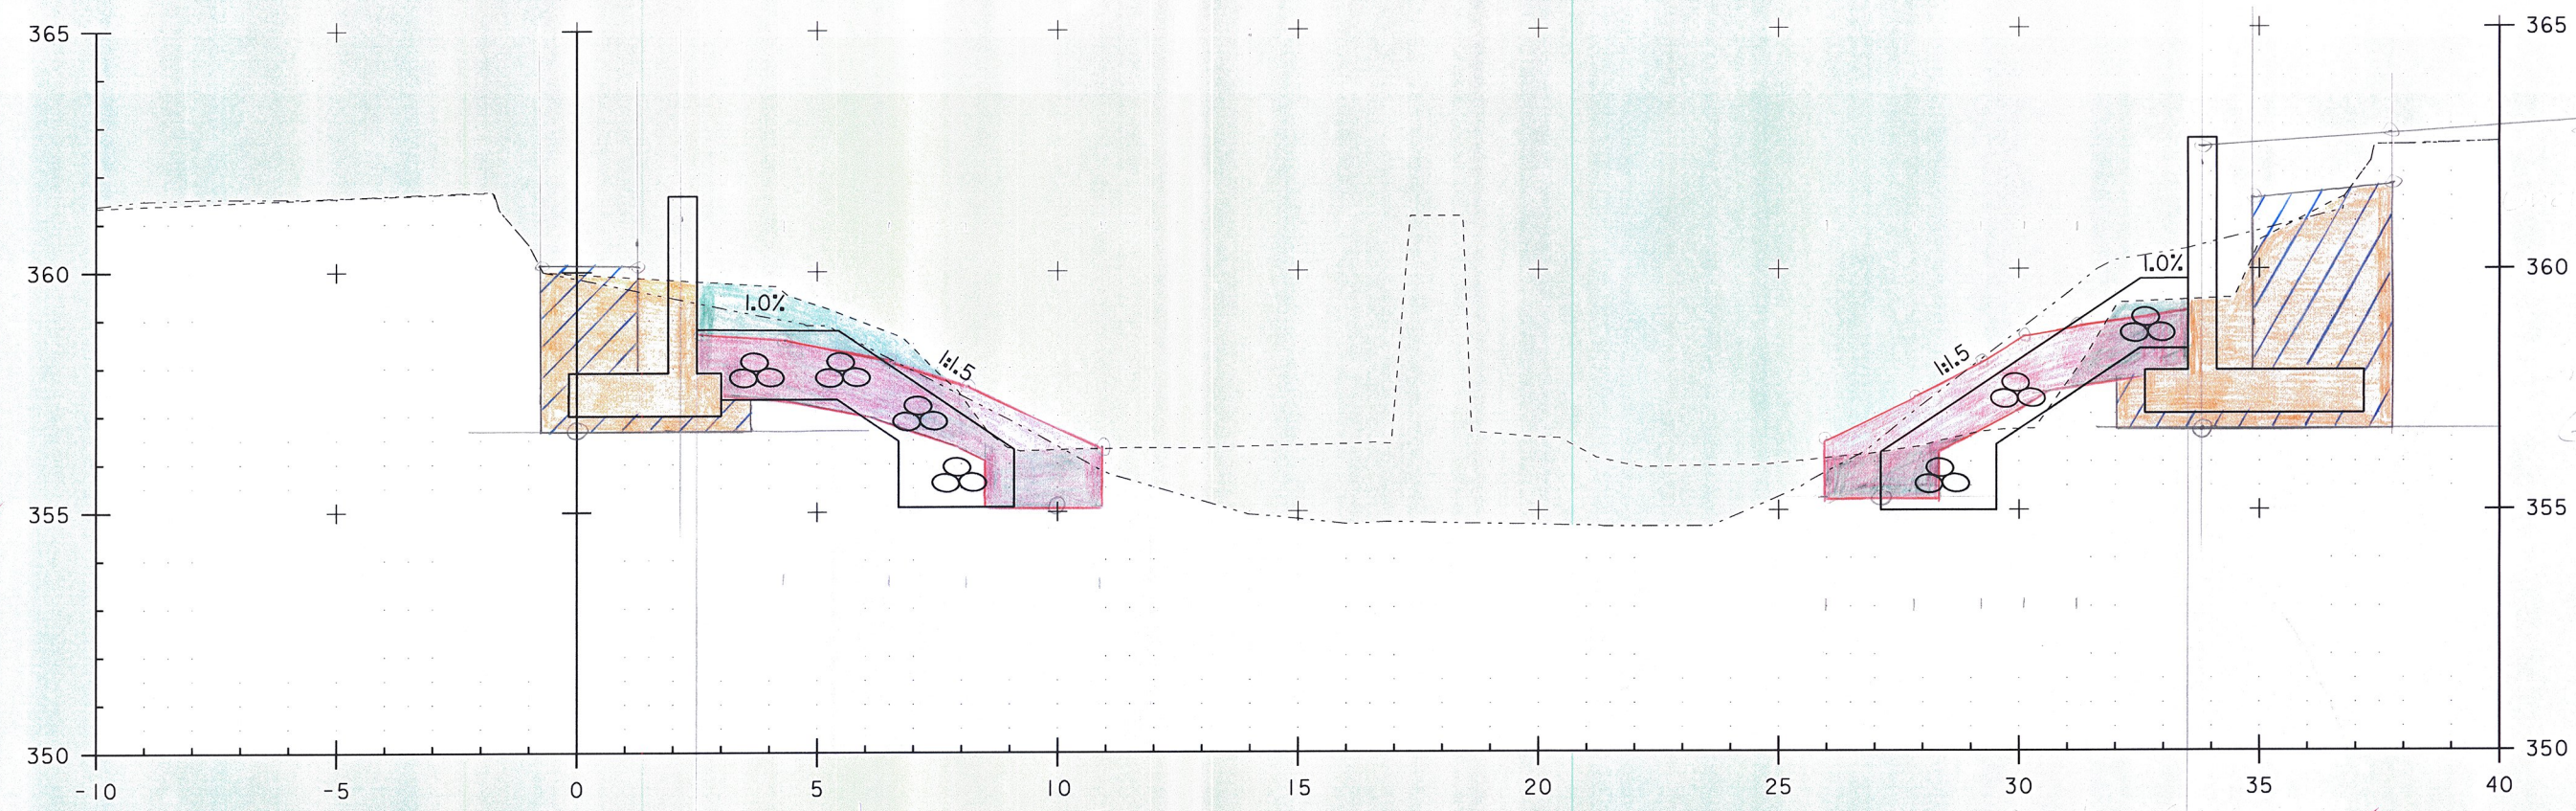

5+017.70

Stone fill: 11.4m³
 1.5m x 1.5m x 1.4m
 2.0m x 1.5m x 1.2m
 1.5m x 1.5m x 1.2m

Stone fill: 11.4m³
 1.5m x 1.5m x 1.4m
 2.0m x 1.5m x 1.2m
 1.5m x 1.5m x 1.2m

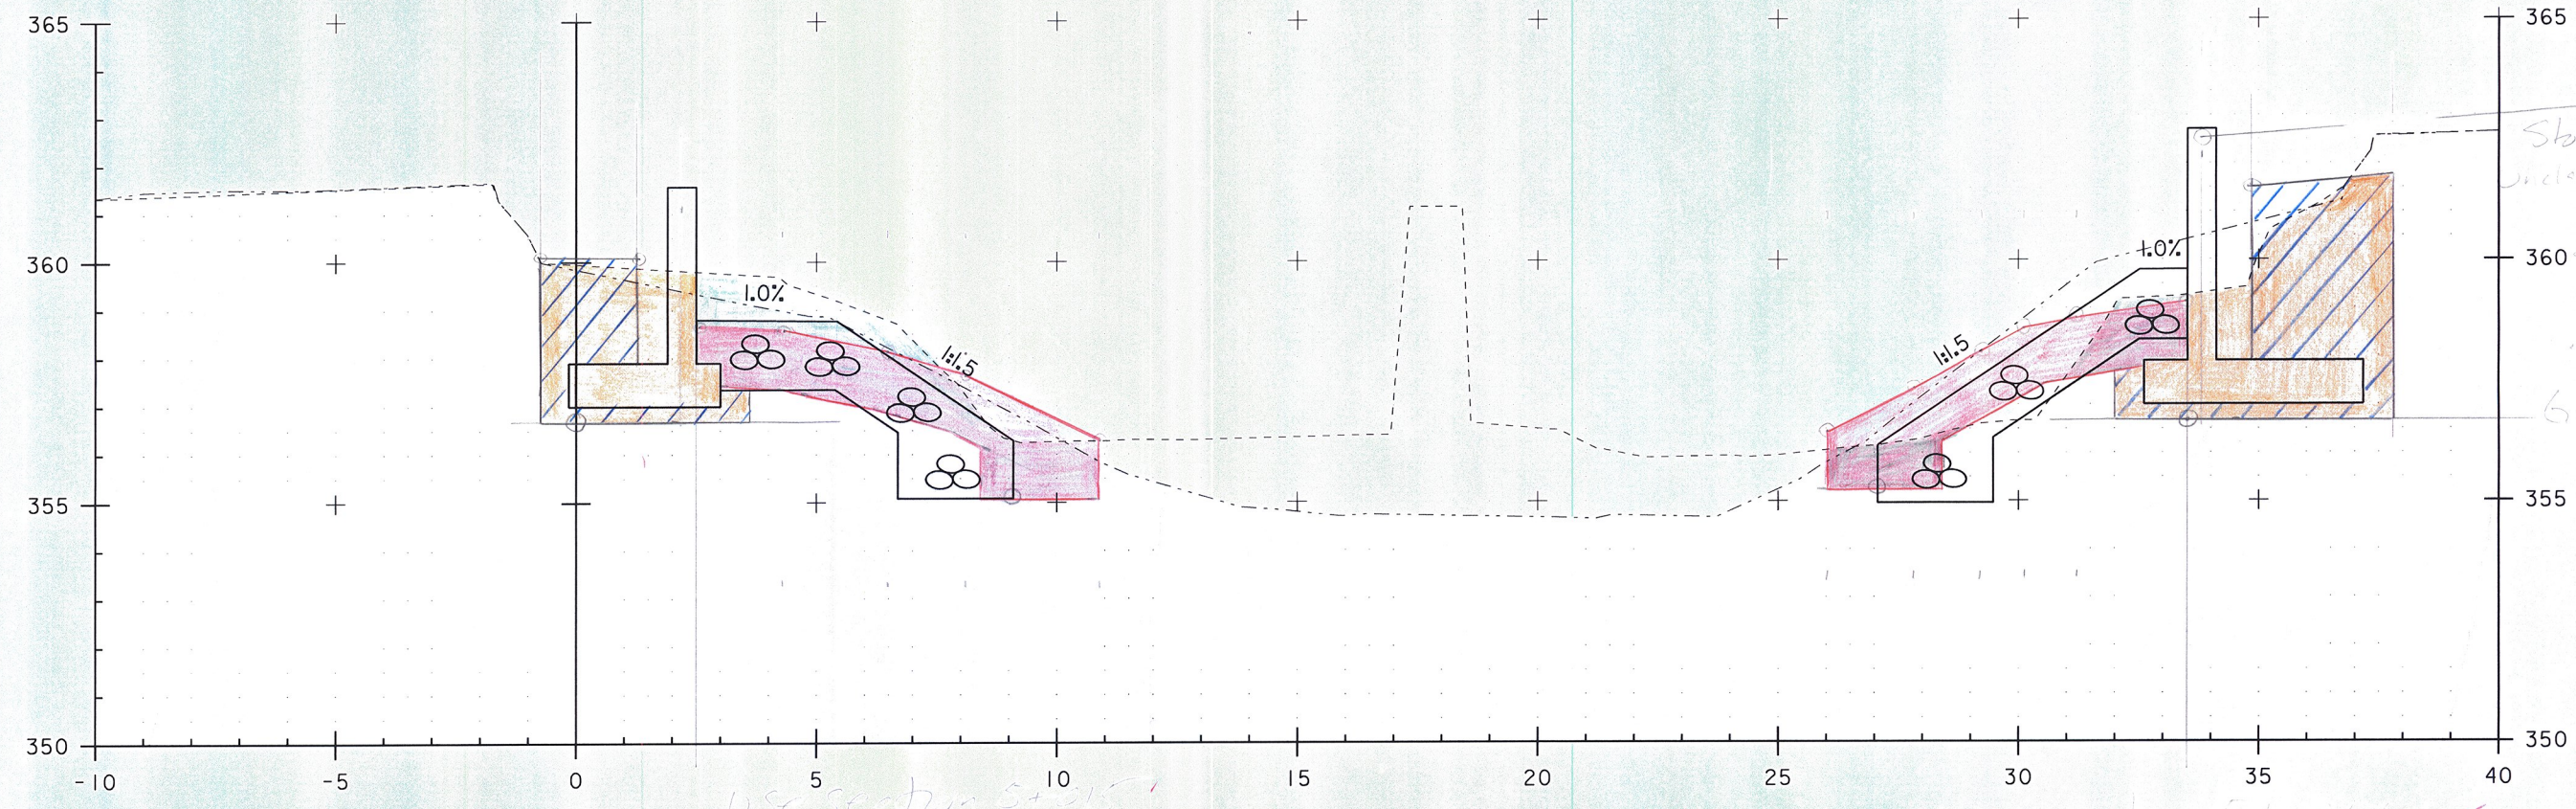

5+017.20

ML
4-15-14

SURFACE LEGEND	
-----	OG 2012
-----	OG 2009

PROJECT NAME: READSBORO
 PROJECT NUMBER: BRP 0105(3) 300
 FILE NAME: s891088channelCrossSections300.dwg DATE: 15-FEB-2013
 PROJECT LEADER: J. LACROIX DRAWN BY: D. KARABEGOVIC
 DESIGNED BY: CHECKED BY: M. LONGSTREET
 CH XS SHEET 6 SHEET 7 OF 11

STA. 5+017 TO STA. 5+018