




Stone fill = 12.3 m³
 Structure Exc = 11.6 m³
 Subgrade Exc = 1.6 m³
 Green Under Stone Fills 11.6 m³


Stone fill = 11.3 m³
 Structure Exc = 6.1 m³
 Subgrade Exc = 1.3 m³
 Green Under Stone Fills 11.3 m³

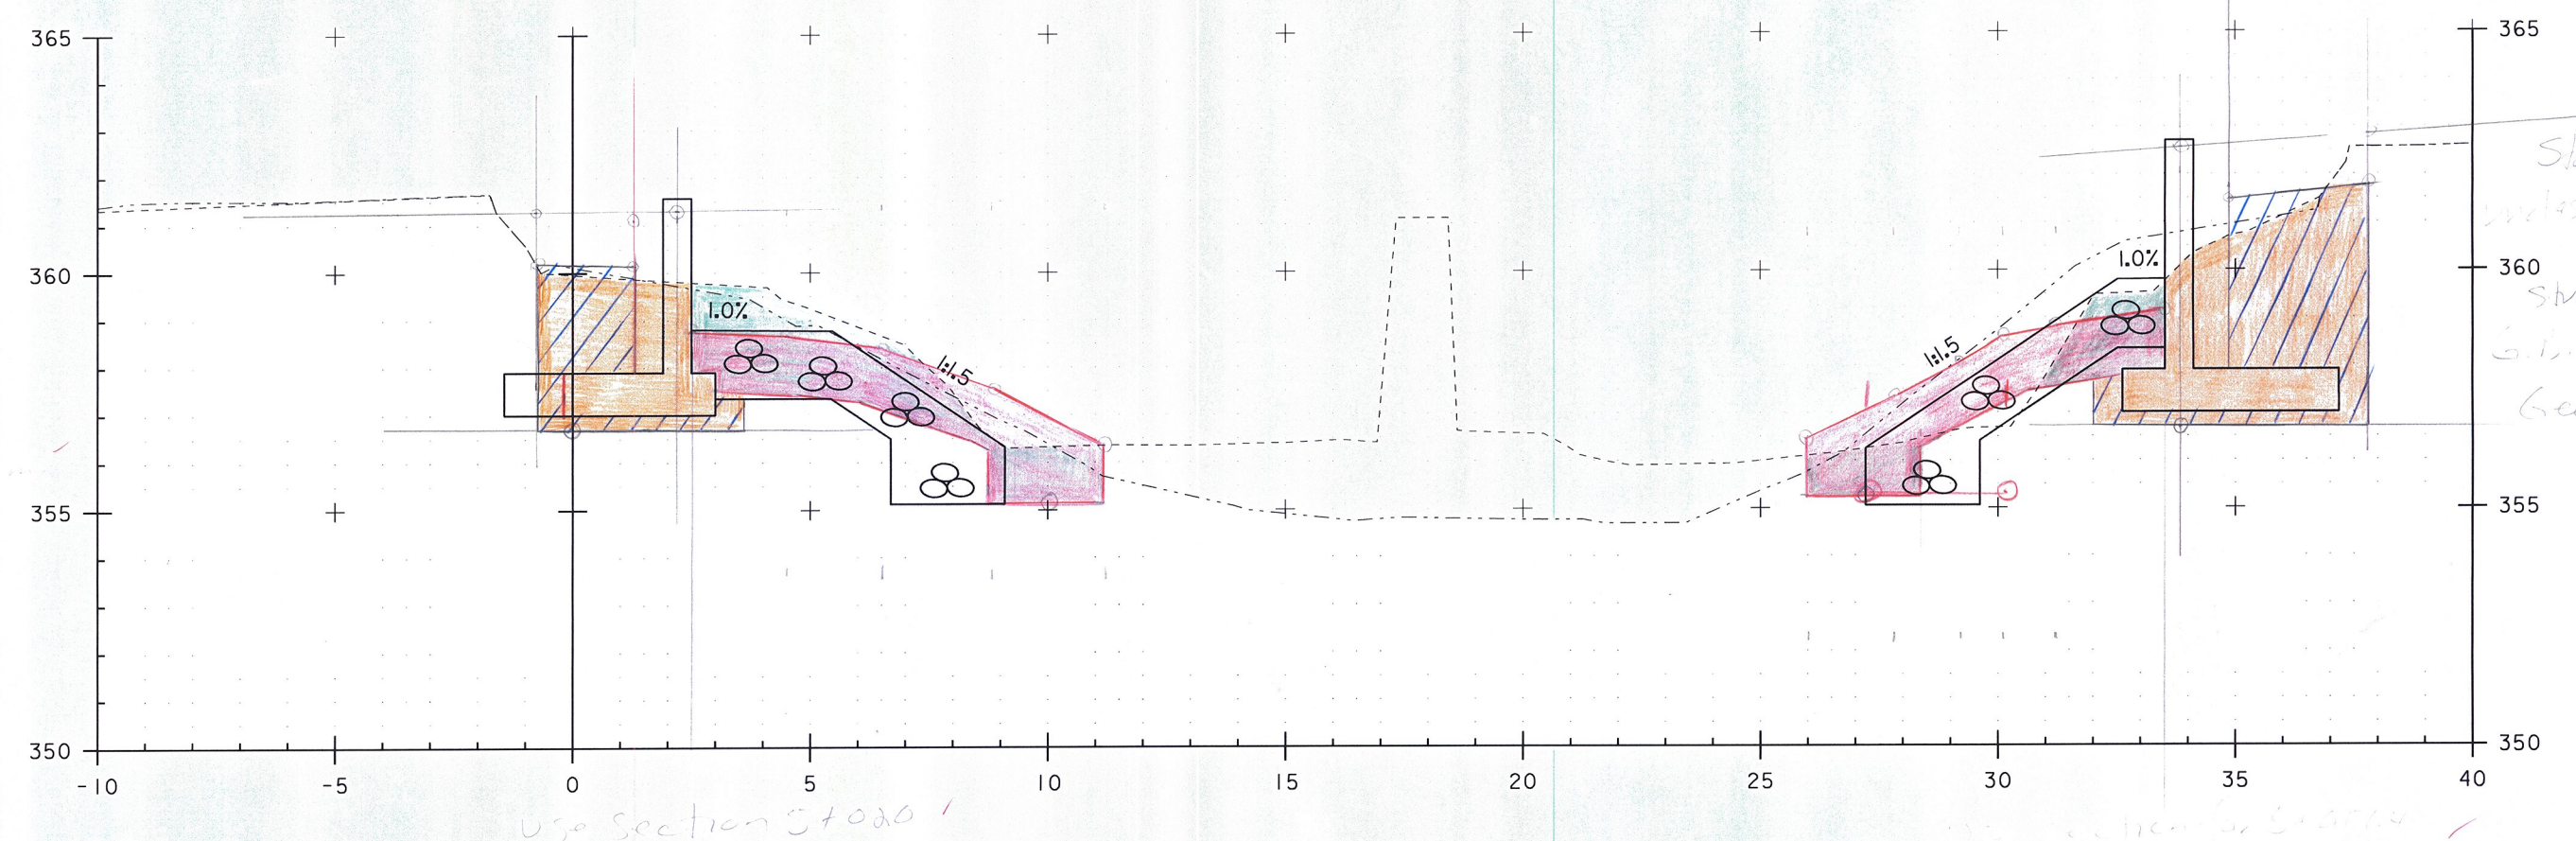

5+018.50

Stone fill = 11.6 m³
 Structure Exc = 13.3 m³
 Subgrade Exc = 1.6 m³

Stone fill = 11.3 m³
 Structure Exc = 5.7 m³
 Subgrade Exc = 1.4 m³

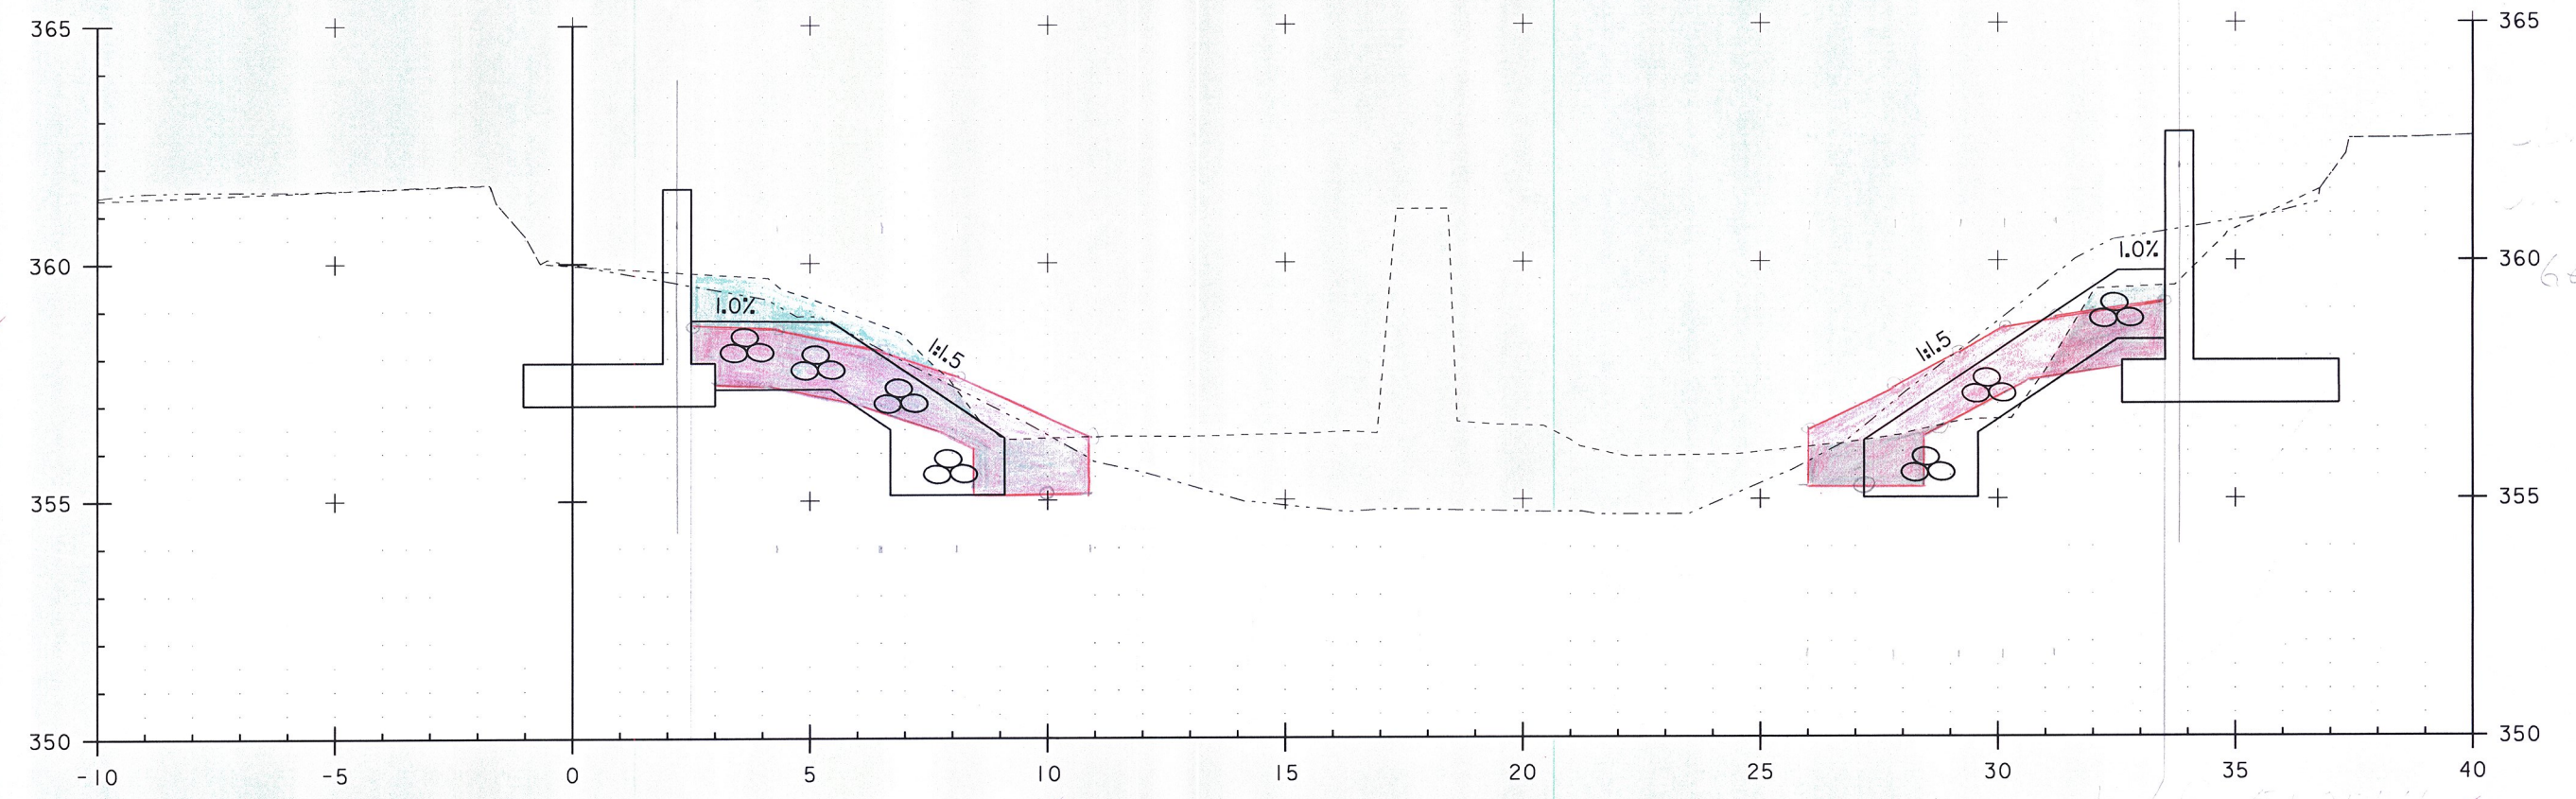

5+018.20

SURFACE LEGEND	
-----	OG 2012
-----	OG 2009

PROJECT NAME: READSBORO
 PROJECT NUMBER: BRF 0105(3) 300
 FILE NAME: s89j088channelCrossSections30014.dwg DATE: 15-FEB-2013
 PROJECT LEADER: J. LACROIX DRAWN BY: D. KARABEGOVIĆ
 DESIGNED BY: CHECKED BY: M. LONGSTREET
 CH XS SHEET 7 SHEET 8 OF 11

STA. 5+018 TO STA. 5+019

P.P.
 4-16-14