

INDEX OF SHEETS

1. TITLE SHEET
2. PRELIMINARY INFORMATION SHEET
3. BRIDGE QUANTITY AND EARTHWORKS SUMMARY SHEET
4. RIGHT-OF-WAY SHEET
5. PLAN SHEET
6. PROFILE SHEET
7. TRAFFIC CONTROL TYPICALS
8. TRAFFIC CONTROL NOTES
9. TRAFFIC CONTROL PLAN
10. BORING INFORMATION SHEET
11. BORING LOG SHEET
12. PLAN AND ELEVATION SHEET
13. GENERAL NOTES & MATERIAL TRANS. DETAIL
14. SLAB DETAILS
15. CURB AND RAIL DETAILS
16. ABUTMENT NO. 1 DETAILS
17. ABUTMENT NO. 2 DETAILS
18. WINGWALL DETAILS
19. CORNER DETAILS
20. GALVANIZED BOX BEAM BRIDGE RAIL DETAILS
21. BRIDGE RAIL CONNECTION/TRANSITION DETAILS
22. MANUFACTURED TERMINAL END SECTION DETAIL SHEET
23. REINFORCING STEEL SCHEDULE
- 24.-26. INFORMATION SHEETS (3 SHEETS)
- 27.-33. ROADWAY CROSS SECTIONS
- 34.-37. CHANNEL SECTIONS

LIST OF STANDARDS

E-100	01-06-97
E-101	03-10-97
E-102	08-08-95
E-102A	08-08-95
E-106	08-08-95
E-107	08-08-95
E-107A	08-08-95
E-121	08-08-95
E-140	08-30-96
E-150	01-15-97
E-160	08-18-95
E-170	08-09-95
E-171A	08-09-95
E-171B	08-09-95
E-171C	08-09-95
E-172	08-09-95
E-173	08-09-95
E-193	08-18-95
G-1	06-01-94
G-1d	06-01-94
G-18	06-01-94
J-3	08-07-95
T-1	06-01-94
T-2	06-01-94
SB-R4A-82	09-19-89
SB-R4B-82	03-30-88
SB-R6-82	01-06-95

RECORD PLANS

CONTRACTOR: Miller Const - Windsor, VT

RESIDENT ENGINEER: L. Grunewald

CONSTRUCTION BEGAN: May 4, 1998

CONSTRUCTION COMPLETE: August 31, 1999

RECORD PLANS BY: CADDENALS

I HEREBY CERTIFY THAT ALL THE CONSTRUCTION REQUIRED BY THIS SET OF DRAWINGS HAS BEEN ACCOMPLISHED AS INDICATED HEREIN.

BY L. Grunewald RESIDENT ENGINEER

DATE 03-07-03

NOTE: Any further information concerning final quantities, amounts or other details relative to this project may be found on microfilm in Central Files.

STATE OF VERMONT
AGENCY OF TRANSPORTATION



PROPOSED IMPROVEMENT
BRIDGE PROJECT



TOWN OF SUNDERLAND
COUNTY OF BENNINGTON

ROUTE NO : TH-1, CL. 2, MINOR COLLECTOR
BRIDGE NO : BR2


PROJECT LOCATION : BEGINNING AT A POINT ON TH-1, APPROXIMATELY 0.65 MILES NORTHEASTERLY FROM ITS INTERSECTION WITH TH-2 AND EXTENDING 0.04 MILES NORTHEASTERLY ALONG TH-1.

PROJECT DESCRIPTION : REHABILITATION AND WIDENING OF THE EXISTING STRUCTURE WITH MINIMAL APPROACH WORK.


LENGTH OF STRUCTURE : 43 FEET.
LENGTH OF ROADWAY : 157 FEET.
LENGTH OF PROJECT : 200 FEET.

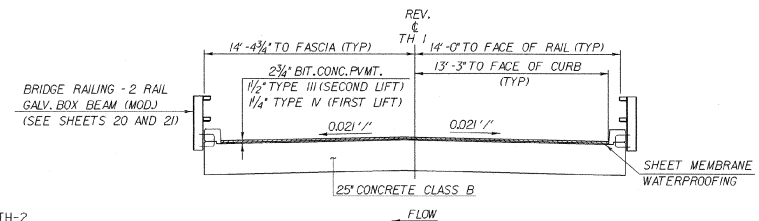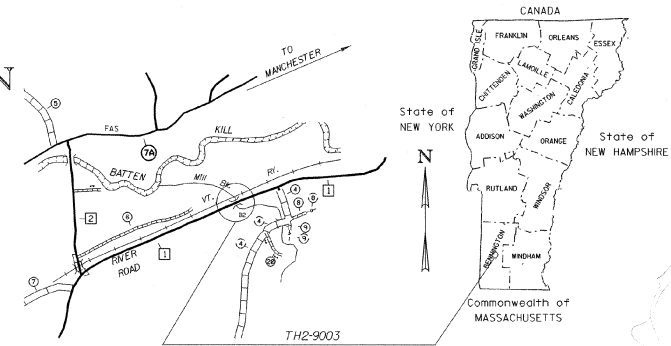

TYPICAL BRIDGE SECTION
SCALE 1/4" = 1'-0"
1 0 2 4 6

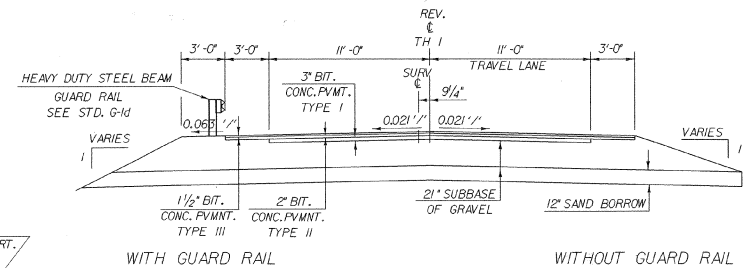

TYPICAL ROADWAY SECTION
SCALE 1/4" = 1'-0"
1 0 2 4 6

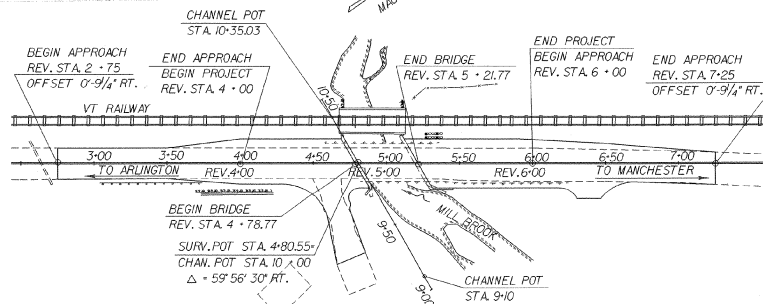

SCALE 1" = 40'-0"
0 20 40

CONVENTIONAL SIGNS

COUNTY LINE	---
TOWN LINE	- - - -
LIMITS OF ACCESS	—○—
POINT OF ACCESS	—X—
FENCE LINE	—X—
STONE WALL	—○—
TRAVELED WAY	—○—
GUARD RAIL	—○—
RAILROAD	—○—
SURVEY LINE	—○—
CULVERT	—○—
POWER POLE	—○—
TELEPHONE POLE	—○—
TREES	—○—
CONTROL OF ACCESS	—○—
PROPERTY LINE	—○—
PROP. TAKING LINE	—○—
SLOPE RIGHTS	—○—
TOP OF CUT	—○—
TOE OF SLOPE	—○—

DATUM

VERTICAL	NGVD 1929
HORIZONTAL	ASSUMED


THESE PLANS ARE SUBJECT TO SUCH ENGINEERING CHANGES AS MAY BE REQUIRED BY THE FEDERAL HIGHWAY ADMINISTRATION OR THE DIRECTOR OF CONSTRUCTION AND MAINTENANCE.

CONSTRUCTION IS TO BE CARRIED ON IN ACCORDANCE WITH THESE PLANS AND THE STANDARD SPECIFICATIONS FOR CONSTRUCTION DATED 1990, AS APPROVED BY THE FEDERAL HIGHWAY ADMINISTRATION ON MARCH 15, 1990 FOR USE ON THIS PROJECT, INCLUDING ALL SUBSEQUENT REVISIONS AND SUCH REVISED SPECIFICATIONS AND SPECIAL PROVISIONS AS ARE INCORPORATED IN THESE PLANS.

APPROVED: [Signature] DATE 6/26/97
DIRECTOR OF ENGINEERING

PROJECT SUNDERLAND TH2-9003
PROJECT NO. TH2-9003
SHEET 1 OF 37 SHEETS


**ARCHIVED
IN DPR**

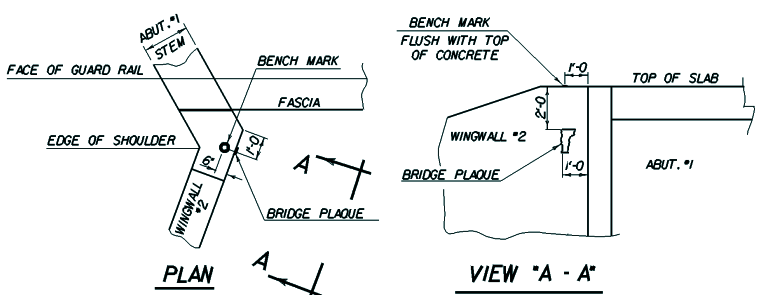

LOCATE BENCH MARK AND BRIDGE PLAQUE

THE BRIDGE PLAQUE AND BENCH MARK WILL BE SUPPLIED BY THE AGENCY OF TRANSPORTATION AND SHALL BE INSTALLED BY THE CONTRACTOR AT ABUTMENT #1 ON THE RIGHT SIDE AS SHOWN OR AS DIRECTED BY THE ENGINEER. (DETAILS ABOVE ARE NOT MEANT TO BE SITE SPECIFIC)

1'-6" x 1'-6" x 3'-0" GRANULAR BACKFILL FOR STRUCTURES WRAPPED WITH GEOTEXTILE FABRIC FOR FILTERS AT EACH WEEPHOLE LOCATION. THIS WILL BE PAID FOR BY THEIR RESPECTIVE PAY ITEMS.

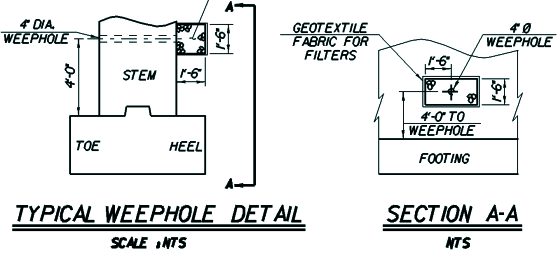

TYPICAL WEEPHOLE DETAIL

SCALE: NTS

SECTION A-A


NTS

**SEEDING FORMULA
RURAL AREAS**

% WT.	LBS./A.	NAME	PUR %	GERM %
37.5	22.5	CREeping RED FESCUE	98	85
37.5	22.5	TALL FESCUE	95	90
5.0	3.0	RED TOP	95	90
15.0	9.0	BIRD'SFOOT TREFOL	98	85
5.0	3.0	ANNUAL RYEGRASS	95	85
100.0	60.0			

GENERAL NOTES

- SEED MIXTURE: SHALL NOT HAVE A WEED CONTENT EXCEEDING 0.40% BY WEIGHT AND SHALL BE FREE OF ALL NOXIOUS SEED.
- SEED: TO BE APPLIED PER SEEDING FORMULAS OR AS DIRECTED BY THE ENGINEER.
- FERTILIZER: FORMULA 10-20-10, TO BE USED WITH SEED, APPLIED AT THE RATE OF 500 LBS./ACRE. (HYDRO SEEDERS MAY USE 19-19-19 FORMULA).
- AGRICULTURAL LIMESTONE: TO BE APPLIED AT THE RATE OF 2 TONS/ACRE, OR AS DIRECTED BY THE ENGINEER.
- HAY MULCH: TO BE PLACED ON EARTH SLOPES AT THE RATE OF 2 TONS/ACRE, OR AS DIRECTED BY THE ENGINEER.
- TOPSOIL: TO BE USED WITH SEED AS INDICATED ON THE PLANS, OR AS DIRECTED BY THE ENGINEER.
- TACK COAT: EMULSIFIED ASPHALT IS TO BE APPLIED AT THE RATE OF 0.015 GAL/SY BETWEEN SUCCESSIVE COURSES OF PAVEMENT AS DIRECTED BY THE ENGINEER.

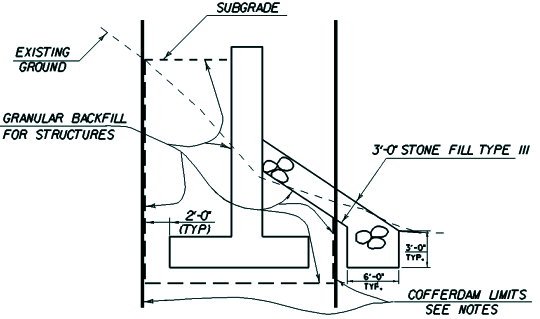

WINGWALL EARTHWORK TYPICAL

NOT TO SCALE

COFFERDAM NOTES

- COFFERDAM LIMITS ARE TO BE DETERMINED BY THE CONTRACTOR.
- IF A COFFERDAM IS CONSTRUCTED WHICH IS MORE THAN THE INDICATED MINIMUM DISTANCE OUTSIDE THE FOOTING LIMITS (SEE NOTE 3), PAYMENT FOR ALL UNCLASSIFIED CHANNEL EXCAVATION INCLUDING THAT PORTION WHICH IS INSIDE THE COFFERDAM BUT OUTSIDE THE MINIMUM COFFERDAM LIMITS SHOWN ABOVE WILL BE MADE AT THE CONTRACT UNIT PRICE FOR UNCLASSIFIED CHANNEL EXCAVATION.
- FOR PURPOSES OF ESTIMATED EARTHWORK QUANTITIES, THE LIMITS OF THE COFFERDAM HAVE BEEN ASSUMED TO BE 2'-0" OUTSIDE THE PERIMETER OF THE WINGWALL FOOTINGS (SEE DRAWING ABOVE).
- 1'-0" OF GRANULAR BACKFILL FOR STRUCTURES SHALL BE PLACED BELOW THE BOTTOM OF EACH WINGWALL.
- ALL IN STREAM CHANNEL WORK WILL TAKE PLACE IN A DRY CHANNEL. THIS MAY BE ACCOMPLISHED BY DIRECTING THE STREAM FLOW THROUGH A TEMPORARY CHANNEL - THROUGH TEMPORARY CULVERTS OR BY THE USE OF A COFFERDAM AND PUMPS. ABSOLUTELY NO GREEN CONCRETE CAN BE ALLOWED TO MIX WITH THE STREAM FLOW. PUMPING FROM EXCAVATION FOR FOOTINGS WILL BE CLARIFIED BEFORE BEING ALLOWED TO MIX WITH THE STREAM FLOW.

FINAL HYDRAULICS REPORT

HYDROLOGIC DATA

DRAINAGE AREA: 4.8 sq. mi. (12.4 sq. km)
 CHARACTER OF TERRAIN: Hilly to mountainous, mostly forested.
 CHARACTER & TYPE OF STREAM: Small, straight stream with narrow flood plain, locally braided and/or meandered.
 NATURE OF STREAMBED: Gravel, cobbles, and boulders.
 02.35+ 310 cfs (8.8 cms) 050+ 1220 cfs (34.3 cms)
 010+ 700 cfs (19.8 cms) 0100+ 1440 cfs (40.8 cms)
 025+ 1000 cfs (28.3 cms) 0500+ 2200 cfs (62.3 cms)
 DATE OF FLOOD RECORD: Unknown
 WATER SURFACE ELEV.: Unknown ESTIMATED DISCHARGE: Unknown
 NATURAL STREAM VELOCITY @ 025+ 8.2 fpm (24.5 mpm)
 ICE CONDITIONS: Moderate DEBRIS: Moderate
 DOES THE STREAM REACH MAXIMUM HIGHWATER ELEVATION RAPIDLY? Yes
 IS ORDINARY RISE RAPID? Yes
 IS STAGE AFFECTED BY UPSTREAM OR DOWNSTREAM CONDITIONS? Yes
 IF YES, DESCRIBE: Railroad bridge downstream < 10 ft. (3.0 m).
 Confluence with Batten Kill downstream 1300 ft. (400 m).
 WATERSHED STORAGE: 1% HEADWATERS UNIFORM THROUGHOUT WATERSHED X IMMEDIATELY ABOVE SITE

EXISTING STRUCTURE

STRUCTURE TYPE: Single span concrete T-beam bridge, YEAR BUILT: 1948
 CLEAR SPAN INORMAL TO STREAM: 33 ft. (10.1 m)
 VERTICAL CLEARANCE ABOVE STREAMBED: 3.5 ft. (1.07 m) average
 WATERWAY OF FULL OPENING: 100 sq. ft. (9.3 sq. m)
 DISPOSITION OF STRUCTURE: Remove Superstructure.
 TYPE OF MATERIAL UNDER SUBSTRUCTURE: Unknown
 WATER SURFACE ELEV. @ 02.35+ 652.5 VELOCITY: 1.8 fpm (2.38 mpm)
 010+ 652.1 " 3.8 fpm (12.68 mpm)
 025+ 652.3 " 8.2 fpm (25.50 mpm)
 050+ 654.0 " 3.7 fpm (12.65 mpm)
 0100+ 654.7 " 3.3 fpm (10.33 mpm)

LONG TERM STREAM BED CHANGES: None noted.
 IS THE ROADWAY OVERTOPPED BELOW THE 0100? Yes FREQUENCY: 0.80
 RELIEF ELEVATION: 654.5 DISCHARGE OVER ROAD @ 0100+ 80 cfs (2.3 cms)
 UPSTREAM STRUCTURE: TOWN Sunderland DISTANCE: 1400 ft. (427 m)
 HIGHWAY NO.: T.H. 4 STRUCTURE NO.: 11
 STRUCTURE TYPE: Concrete T-beam bridge
 CLEAR SPAN: 28 ft. (8.5 m) CLEAR HEIGHT: 7 ft. (2.1 m)
 YEAR BUILT: 1981 FULL WATERWAY: 150 sq. ft. (13.8 sq. m)
 DOWNSTREAM STRUCTURE: TOWN N. A. DISTANCE:
 HIGHWAY NO.: STRUCTURE NO.:
 STRUCTURE TYPE:
 CLEAR SPAN: CLEAR HEIGHT:
 YEAR BUILT: FULL WATERWAY:

DESIGN CRITERIA:

- DESIGN LIVE LOAD AASHTO HS25
- DESIGN SPAN 40'-6" (43'-0" BACK TO BACK)
- ALLOWABLE LOAD FOR SPREAD FOOTINGS ON SOIL 4 KSF
- ALLOWABLE LOAD FOR PILING N/A TYPE N/A ESTIMATED LENGTH N/A
- STRUCTURAL STEEL AASHTO GRADE N/A
- REINFORCING STEEL GRADE 60 #2 #31
- CONCRETE CLASS A $F_c \geq 4000$ PSI
- CONCRETE CLASS B $F_c \geq 3500$ PSI
- SILICA-FUME CONCRETE $F_c \geq 5000$ PSI

TRAFFIC MAINTENANCE:

- IS TRAFFIC TO BE MAINTAINED? YES IF YES, ON EXISTING STRUCTURE YES OR ON TEMPORARY BRIDGE N/A
- TEMPORARY BRIDGE REQUIREMENTS: ONE OR TWO WAY ONE-WAY TRAFFIC CONTROL SIGNALS REQUIRED YES

LOAD RATING (TONS)

LOADING LEVELS (LOAD FACTOR)	TRUCK								
	H	HS	SS2	6 AXLE	3A.STR.	4A.STR.	5A.STR.	5A.SEM	
INVENTORY	36	50							
A = 1.55	51	70	98		57	60	88		
OPERATING					84	117	111	68	72

TRAFFIC DATA

YEAR	ADT	DHV	% D	% T	ADTT
1996	1060	145		5	20
2016	1430	200	74	6	30

PROPOSED STRUCTURE

STRUCTURE TYPE: New Concrete Slab Bridge on Existing Substructure
 CLEAR SPAN INORMAL TO STREAM: 33 ft. (10.1 m)
 VERTICAL CLEARANCE ABOVE STREAMBED: 4.5 ft. (1.4 m) average
 WATERWAY OF FULL OPENING: 140 sq. ft. (13.0 sq. m)
 WATER SURFACE ELEV. @ 02.35+ 652.3 VELOCITY: 1.6 fpm (2.32 mpm)
 010+ 651.4 " 3.1 fpm (12.77 mpm)
 025+ 652.6 " 8.0 fpm (24.64 mpm)
 050+ 653.7 " 8.7 fpm (26.65 mpm)
 0100+ 654.7 " 9.7 fpm (29.96 mpm)

IS THE ROADWAY OVERTOPPED BELOW THE 0100? Yes FREQUENCY: 0.90+
 RELIEF ELEVATION: 654.5 DISCHARGE OVER ROAD @ 0100+ 40 cfs (11.0 cms)
 AVERAGE LOW ELEVATION OF SUPERSTRUCTURE: 652.4
 VERTICAL CLEARANCE @ 0 Water up to slab below a 025.
 SCOUR: 1 ft. (0.3 m) of contraction scour at 0100.
 REQUIRED CHANNEL PROTECTION: Stone Fills, Type III

PERMIT INFORMATION

AVERAGE DAILY FLOW: 10 cfs (0.3 cms)
 ORDINARY LOW WATER: 5 cfs (0.1 cms) DEPTH: 1 ft. (0.3 m)
 ORDINARY HIGH WATER: 130 cfs (3.7 cms) DEPTH: 2 ft. (0.6 m)

TEMPORARY BRIDGE REQUIREMENTS

STRUCTURE TYPE: Use stage construction on existing and new bridge.
 CLEAR SPAN INORMAL TO STREAM:
 VERTICAL CLEARANCE ABOVE STREAMBED:
 WATERWAY OF FULL OPENING:

**STATE OF VERMONT
AGENCY OF TRANSPORTATION**

Town Of **SUNDERLAND** Bridge No. **2**
 Highway No. **TH 1** Log Sta. **500**
TH 1 OVER THE MILL BROOK

PRELIMINARY INFORMATION SHEET

Designed By **P.M. THURBER** Drawn By **C.C. RICE**
 Checked By **C.W. MEUNIER** Date **2/97** Bridge Design Supervisor **2/97**
 G.S. ROGERS Date **2/97**
 PROJECT **SUNDERLAND** PROJECT NO. **TH2-9003**
 U.S.C. info. 89V189(20)/1020p.2p 3/2003 Jpm
 Bridge Sheet No. Sheet **2** of **37**

Sheet Number: 2

BRIDGE QUANTITY SHEET

STATE OF VERMONT
AGENCY OF TRANSPORTATION
STRUCTURES DIVISION


ITEM NO.	ITEM	UNIT	QUANTITY BREAKDOWN							TOTAL	FINAL	ITEM NO.	ITEM	UNIT	QUANTITY BREAKDOWN							TOTAL	FINAL
			ROADWAY	CHANNEL	SUPER-STRUCTURE	ABUTMENT NO. 1	ABUTMENT NO. 2	EROSION CONTROL								ROADWAY	CHANNEL	SUPER-STRUCTURE	ABUTMENT NO. 1	ABUTMENT NO. 2	EROSION CONTROL		
203.15	COMMON EXCAVATION	CY	1080							1080	1131	621.80	REMOVAL AND DISPOSAL OF GUARD RAIL	LF	205						205	205	
203.27	UNCLASSIFIED CHANNEL EXCAVATION	CY		60						60	47	621.90	TEMPORARY TRAFFIC BARRIER	LF	870						870	353	
203.31	SAND BORROW	CY	230							230	0	631.10	FIELD OFFICE-ENGINEERS	LS	1					1	0.98		
203.31 MOD	TRENCH EXCAVATION OF EARTH	CY							10	10	0	631.16	TESTING EQUIPMENT - CONCRETE	LS		0.8	0.1	0.1		1	1		
204.20	TRENCH EXCAVATION OF EARTH	CY							10	10	0	631.17	TESTING EQUIPMENT - BITUMINOUS	LS	0.9	0.1			1	1			
204.30	GRANULAR BACKFILL FOR STRUCTURES	CY				40	40			80	72.8	631.25	FIELD OFFICE TELEPHONE * (NABI)	LS	1				1	0.423			
204.40	COFFERDAM (REV STA 4+88 RT)	LS				1				1	1	635.10	MOBILIZATION	LS	1				1	1			
204.40	COFFERDAM (REV STA 5+37 RT)	LS				1				1	1	646.40	DURABLE 4" WHITE LINE	Y LF	1200				1200	0			
210.10	COLD PLANING-BITUMINOUS PAVEMENT	SY	242	PIKE						242		646.41	DURABLE 4" YELLOW LINE	Y LF	1200				1200	0			
301.15	SUBBASE OF GRAVEL	CY	670					40		710	650.3	646.61	TEMPORARY 4" YELLOW LINE	Y LF	2000				2000	1178			
404.65	EMULSIFIED ASPHALT	CWT	3							3	3	646.82	REMOVAL OF EXISTING PAVEMENT MARKINGS	SY	Y 115				115	0			
406.25	BITUMINOUS CONCRETE PAVEMENT (PG 58-34)	TON	357	WILK	18					375	354.19	649.31	GEOTEXTILE UNDER STONE FILL	SY		60			60	132			
501.25	CONCRETE, CLASS B	CY			99	16	27			142	40.70	649.51	GEOTEXTILE FOR SILT FENCE	SY				420	420	72			
501.60	SILICA-FUME CONCRETE	CY			4					4	2.69	649.61	GEOTEXTILE FOR FILTER CURTAIN	SY				100	100	0			
501.60 MOD	REINFORCING STEEL	LB			4600	1900	2700			0	0.57	651.15	SEED	LB				10	10	10			
507.15	REINFORCING STEEL	LB			4600	1900	2700			4600	4468	651.17	SEED - WINTER RYE	LB				10	10	0			
507.16	DRILLING AND GROUTING DOWELS	LF				135	135			270	207	651.18	FERTILIZER	LB				100	100	20			
507.17	EPOXY COATED REINFORCING STEEL	LB			15820	220	220			16260	1055	651.20	AGRICULTURAL LIMESTONE	TON				0.25	0.25	0.05			
507.19	MECHANICAL BAR CONNECTOR (#5 BARS)	EA				4	4			8	8	651.25	HAY MULCH	TON				0.25	0.25	0.32			
507.19	MECHANICAL BAR CONNECTOR (#6 EPOXY COATED) (3 ADDED FOR TESTING)	EA			46					46	0	651.26	HAY BALES FOR EROSION CONTROL	EA				100	100	0			
514.10	WATER REPELLENT	GAL			4	2	2			8	10	651.35	TOPSOIL	CY	20			30	50	31			
519.20	SHEET MEMBRANE WATERPROOFING	SY	ROSS I		140					140	134	651.40	GRUBBING MATERIAL	SY		40			40	65			
525.31	BRIDGE RAILING-2 RAIL GALV. BOX BEAM (MOD)	LF	Y		92					92	92	654.10	EROSION MATTING	SY				20	20	0			
527.10	MAINTENANCE OF TRAFFIC FOR BRIDGE PROJECTS	LS			1					1	1	656.50	TRANSPLANTING SHRUBS	EA	1			1	1	0			
529.10	REMOVAL OF BRIDGE PAVEMENT	SY			115					115	115	678.40	TEMPORARY TRAFFIC SIGNAL SYSTEM	Y EA	1			1	1	1			
529.20	PARTIAL REMOVAL OF STRUCTURE	EA			0.8	0.1	0.1			1	1	678.42	TEMPORARY DETECTOR	Y EA	2			2	2	2			
580.13	REPAIR OF CONCRETE SUBSTRUCTURE SURFACE CLASS I	SY			3	3				6	0	* NABI = NOT A BID ITEM											
580.14	REPAIR OF CONCRETE SUBSTRUCTURE SURFACE CLASS II	SY			3	3				6	0	900.06	EXTRA WORK ORDER NO. 6 C.O. #1	LS					0	0	1		
608.25	ALL PURPOSE EXCAVATOR RENTAL, TYPE I * (NABI)	HR						1		1	0	900.07	EXTRA WORK ORDER NO. 7 C.O. #1	LS					0	0	1		
608.45	TRUCK-MOUNTED ATTENUATOR	HR	4500	NOT USED						4500	0	TEMPORARY EROSION CONTROL ITEMS:											
613.10	STONE FILL, TYPE I	CY	10					10		20	2.5	(QUANTITIES INCLUDED UNDER EROSION CONTROL)											
613.12	STONE FILL, TYPE III	CY		70						70	108.7	204.20	TRENCH EXCAVATION OF EARTH	CY					10				
617.10	RELOCATE MAILBOX, SINGLE SUPPORT	EA	Y 1							1	1	301.15	SUBBASE OF GRAVEL	CY					40				
621.21	HEAVY DUTY STEEL BEAM GUARD RAIL	LF	Y 65							65	62	608.25	ALL PURPOSE EXCAVATOR RENTAL, TYPE I	HR					1				
621.505	MANUFACTURED TERMINAL SECTION	EA	X 2							2	2	613.10	STONE FILL, TYPE I	CY					10				
621.57	ENERGY ABSORPTION ATTENUATOR	EA	3							3	3	649.51	GEOTEXTILE FOR SILT FENCE	SY					40				
621.60	ANCHOR FOR STEEL BEAM GUARD RAIL	EA	X 2							2	1	651.17	SEED - WINTER RYE	LB				10					
621.70	GUARD RAIL APPROACH SECTION, TYPE I	EA	Y 1							1	1	651.26	HAY BALES FOR EROSION CONTROL	EA				10					
621.70	GUARD RAIL APPROACH SECTION, TYPE I (MOD)	EA	X 2							2	2	654.10	EROSION MATTING	SY				20					
621.71	GUARD RAIL APPROACH SECTION, TYPE II (MOD)	EA	X 1							1	1	EARTHWORKS SUMMARY:											
												PLANTIMETERED FILL:											
												MATERIAL AVAILABLE FOR FILL:											
												COMMON EXCAVATION:											
												UNCLASSIFIED CHANNEL EXCAVATION:											
												EXCAVATION WITHIN COFFERDAMS:											
												TOTAL MATERIAL AVAILABLE FOR FILL:											
												LESS FACTORED FILL:											
												WASTE:											

ARCHIVED
IN DPR

Sheet Number: 3


**ARCHIVED
IN DPR**

NOTE :
ELEVATIONS SHOWN TO THE NEAREST TENTH
ARE EXISTING ELEVATIONS ALONG THE SURVEY
LINE. ELEVATIONS SHOWN TO THE NEAREST
HUNDREDTH ARE PROPOSED ELEVATIONS
ALONG THE REVISED CENTER LINE.

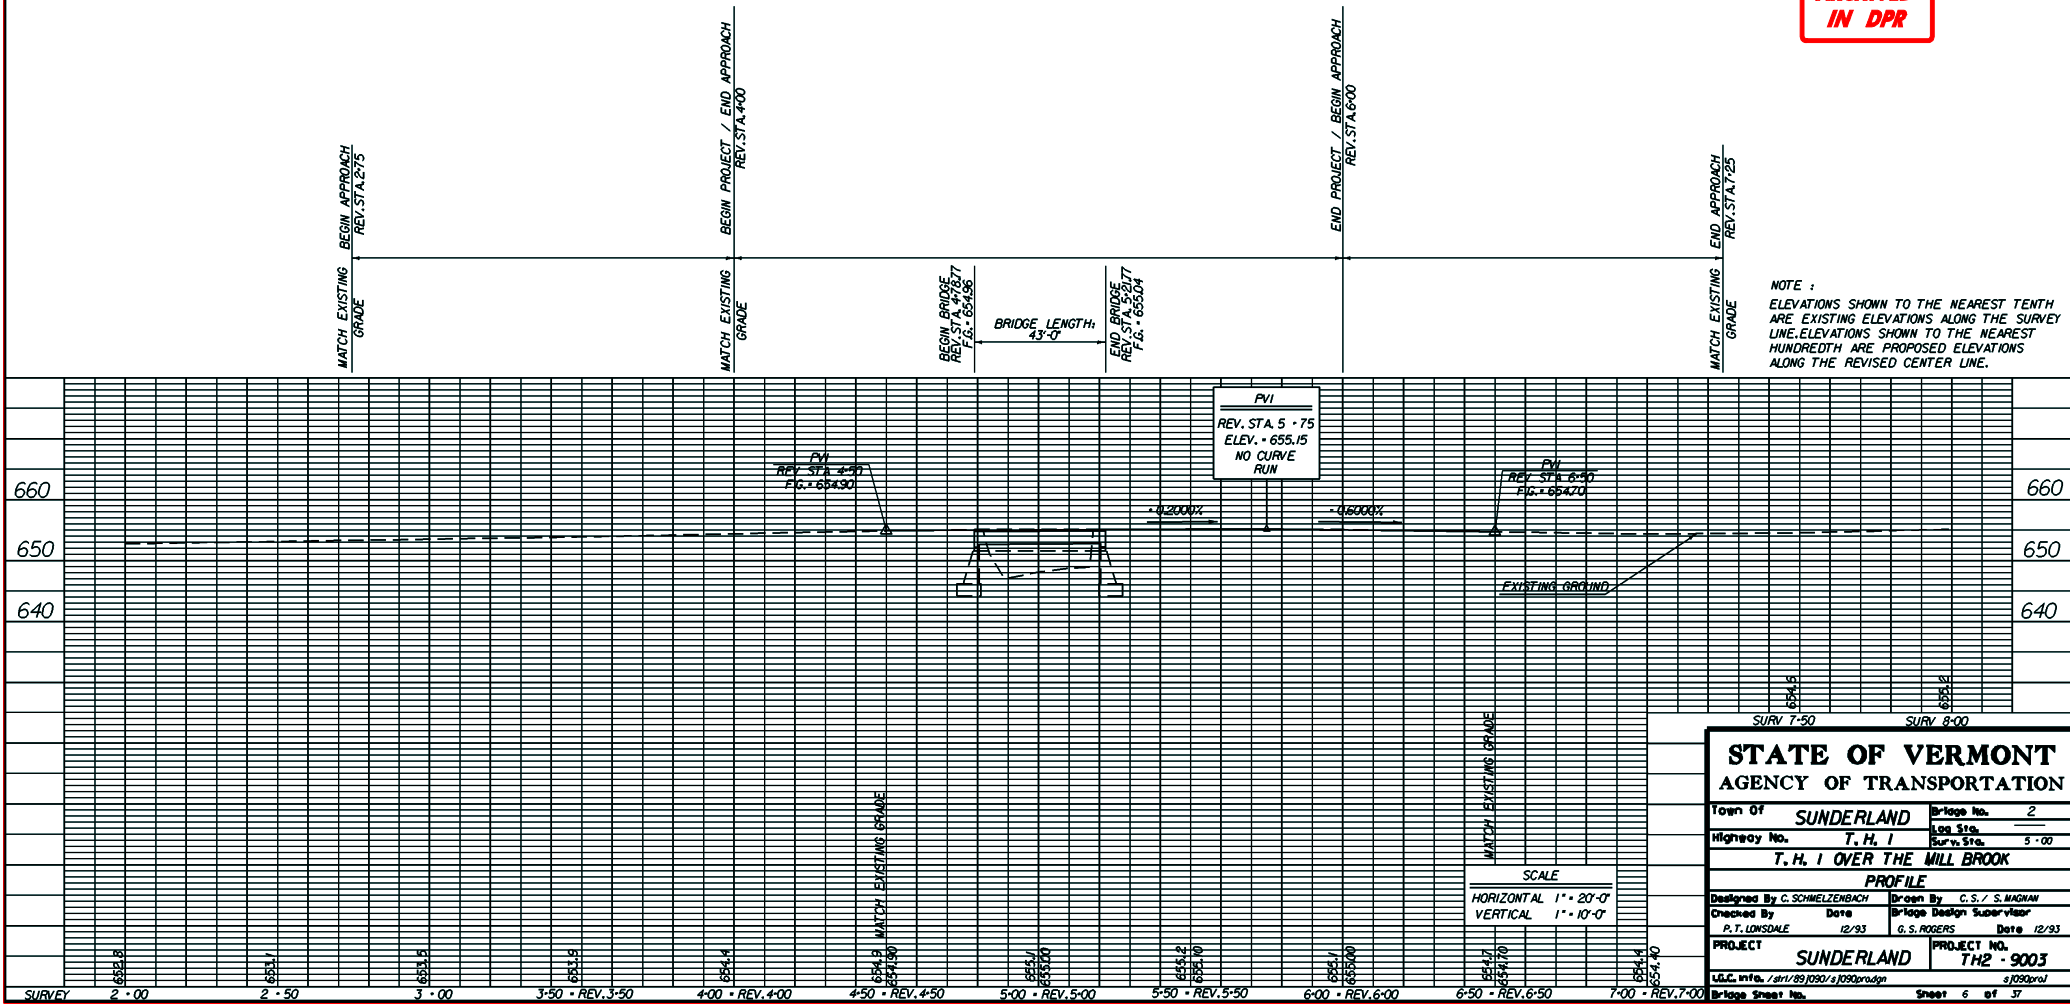


SURY 7-50		SURY 8-00	
STATE OF VERMONT AGENCY OF TRANSPORTATION			
Town Of	SUNDERLAND	Bridge No.	2
Highway No.	T. H. 1	Sign No.	
T. H. 1 OVER THE MILL BROOK		Run No.	5-00
PROFILE			
Designed By	C. SCHMELZENBACH	Drawn By	G. S. / S. MAGNAN
Checked By	R. T. LONSDALE	Bridge Design Supervisor	G. S. ROGERS
Date	12/93	Date	12/93
PROJECT	SUNDERLAND	PROJECT NO.	TH2 - 9003
LLC, info. / str / 89 1090 / s 1090 bridge		s 1090 corral	
Bridge Sheet No.		Sheet	6 of 37

Sheet Number: 6

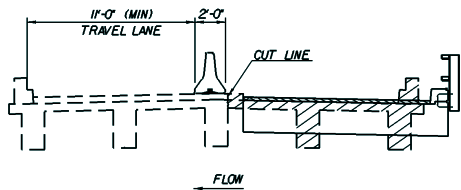


CONSTRUCTION PHASE ONE

SCALE : 1/4" = 1'-0"

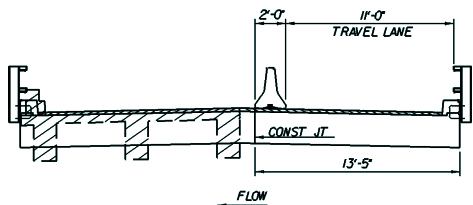

CONSTRUCTION PHASE TWO

SCALE : 1/4" = 1'-0"

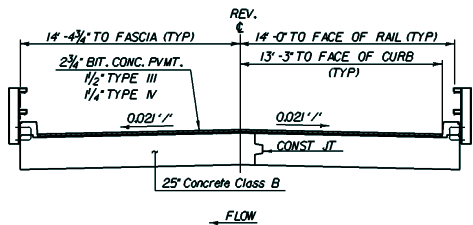

CONSTRUCTION PHASE THREE

SCALE : 1/4" = 1'-0"

NOTES :

1. TRAFFIC SHALL BE MAINTAINED USING A ONE-WAY DETOUR WITH A TEMPORARY TRAFFIC CONTROL SIGNAL.
2. THE ADVISORY SPEED LIMIT SHALL BE NO MORE THAN 25 MPH.
3. REMOVAL, RESETTING, OR REPLACING OF SIGNS, DELINEATORS, AND/OR REFLECTORS AND/OR THEIR POSTS ASSOCIATED WITH THE TRAFFIC CONTROL SHALL BE DONE AS PER SECTION 676. PAYMENT FOR THIS WORK SHALL BE SUBSIDIARY TO THE ITEM "MAINTENANCE OF TRAFFIC FOR BRIDGE PROJECTS."

PHASE ONE :

1. INSTALL TRAFFIC CONTROL PACKAGE AND RE-ROUTE TRAFFIC ONTO DETOUR
2. REMOVE EXISTING PAVEMENT ON CLOSED PORTION OF BRIDGE AND ROADWAY (SEE COLD PLANING LIMITS SHEET 29)
3. REMOVE EXISTING T-BEAM DECK AND PORTIONS OF ABUTMENTS
4. REMOVE UPSTREAM WINGWALLS
5. REPAIR ANY CRACKED AND/OR SPALLED AREAS ON THE RETAINED PORTION OF THE SUBSTRUCTURE
6. EXCAVATE CLOSED PORTION OF ROADWAY AND APPROACHES TO SUBGRADE
7. CONSTRUCT NEW UPSTREAM WINGWALLS AND BRIDGE SEATS
8. CONSTRUCT NEW UPSTREAM SLAB
9. CONSTRUCT NEW ROADWAY AND APPROACHES (SHOULDERS WILL REQUIRE WIDENING TO INSURE THAT A 11'-0" MINIMUM ROADWAY IS MAINTAINED IN THE AREAS WHERE RAIL DOES NOT EXIST)
10. PLACE SHEET MEMBRANE ON NEW PORTION OF SLAB
11. PAVE NEW PORTION OF ROADWAY AND SLAB. THE LIMITS SHALL BE AS DIRECTED BY THE RESIDENT ENGINEER.
12. INSTALL RAIL AND ANCHORS AND PLACE STONE FILL AROUND NEW UPSTREAM WINGWALLS
13. CONSTRUCT PHASE TWO TRAFFIC CONTROL PACKAGE

PHASE TWO :


1. COMPLETE PHASE TWO TRAFFIC CONTROL PACKAGE AND RE-ROUTE TRAFFIC ONTO DETOUR
2. REMOVE EXISTING PAVEMENT ON REMAINING PORTION OF BRIDGE AND ROADWAY (SEE COLD PLANING LIMITS SHEET 31)
3. REMOVE EXISTING DOWNSTREAM T-BEAMS, DECK AND PORTIONS OF EXISTING ABUTMENT
4. EXCAVATE REMAINING PORTION OF ROADWAY AND APPROACHES TO SUBGRADE
5. REPAIR ANY CRACKED AND/OR SPALLED AREAS ON THE RETAINED PORTION OF THE SUBSTRUCTURE
6. CONSTRUCT NEW BRIDGE SEATS
7. CONSTRUCT NEW DOWNSTREAM SLAB
8. CONSTRUCT NEW ROADWAY AND APPROACHES
9. PLACE SHEET MEMBRANE ON REMAINING PORTION OF NEW SLAB
10. INSTALL RAIL AND MANUFACTURED TERMINAL SECTIONS
11. PAVE REMAINING PORTION OF NEW ROADWAY AND SLAB. THE LIMITS SHALL BE AS DIRECTED BY THE RESIDENT ENGINEER.

PHASE THREE :

1. COMPLETE SLOPE, ROADWAY AND CHANNEL WORK
2. TRAFFIC CONTROL REQUIRED DURING THIS PHASE SHALL BE DETERMINED BY THE ENGINEER IN THE FIELD.
3. COSTS FOR PHASE THREE TRAFFIC CONTROL SHALL BE SUBSIDIARY THE ITEM MAINTENANCE OF TRAFFIC FOR BRIDGE PROJECTS, EXCEPT IF TEMPORARY TRAFFIC BARRIER IS REQUIRED, WHICH SHALL BE PAID FOR AS PER ITEM 621.90.

ARCHIVED
IN DPR

STATE OF VERMONT AGENCY OF TRANSPORTATION			
Town Of	SUNDERLAND	Bridge No.	2
Highway No.	TH 1	Log Sta.	N/A
		Surv. Sta.	5+00
TH 1 OVER THE MILL BROOK			
TRAFFIC CONTROL TYPICALS			
Designed By	P. M. THURBER	Drawn By	P. M. THURBER
Checked By	C. W. MEUNIER	Bridge Design Supervisor	G. S. ROGERS
Date	08/94	Date	08/94
PROJECT	SUNDERLAND	PROJECT NO.	TH2 - 9003
I.G.C. Info. / sht/89/090/sj090mp.dgn		sj090c2.para	
Bridge Sheet No.		Sheet	7 of 37

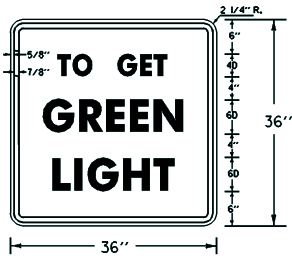

COLORS: BLACK TEXT & BORDER
WHITE REFL. BACKGROUND
MATERIALS PER STD. E-142


PHASING DIAGRAM AND SPECIAL NOTES FOR EACH LOCATION

PHASE	A		B		C	
INTERVAL	1	2	3	4	5	6
MINIMUM	10					5
EXTENSION	2				2	
MAXIMUM	18	3	24	18	3	24
HEAD A	G	Y	R	R	R	R
HEAD B	R	R	R	G	Y	R
HEAD C	R	R	R	R	R	G

SPECIAL REQUIREMENTS

APPROACH	TEMPORARY VEHICLE DETECTOR	DILEMMA ZONE LOOP	FLASHING BEACON ON ADVANCED WARNING SIGN
A	X		
B			
C	X		

ENTER CHECK MARK IN APPROPRIATE BOX WHEN REQUIRED ON THIS PROJECT

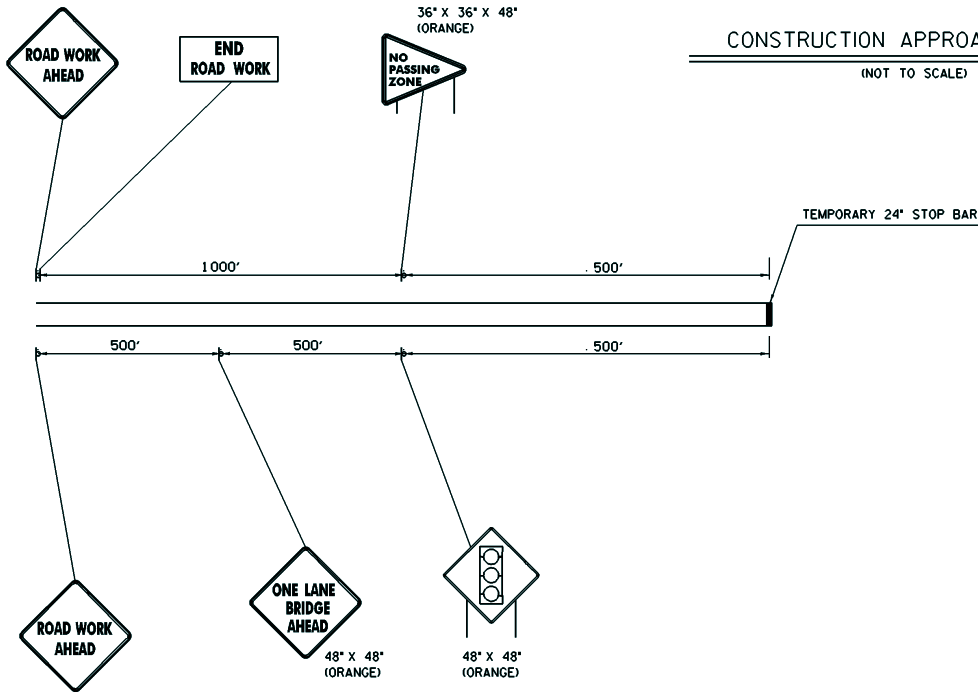

CONSTRUCTION APPROACH SIGNING

(NOT TO SCALE)

STANDARD SHEETS REQUIRED FOR USE WITH TEMPORARY DETOUR SHEETS INCLUDE:

E-100	E-150
E-101	E-160
E-102	E-170
E-102A	E-171A
E-106	E-176B
E-107	E-17C
E-107A	E-172
E-121	E-173
E-140	G-16

ATTENUATOR NOTES

AN ENERGY ABSORPTION ATTENUATOR WILL BE PLACED AS SHOWN ON THE TRAFFIC CONTROL PLAN SHEET TO ALLOW THE CONTRACTOR ACCESS TO THE WORK AREA. THIS ATTENUATOR WILL BE A TRUCK-MOUNTED ATTENUATOR AND WILL BE PAID FOR UNDER ITEM 608.45 "TRUCK-MOUNTED ATTENUATOR". SEE SPECIAL PROVISIONS. THE ENERGY ABSORPTION ATTENUATOR LOCATED @ REV STA 4+40 RT (C) SHALL BE SUITABLE FOR A NARROW WIDTH APPLICATION AND SHALL BE INSTALLED AS SHOWN ON THE TRAFFIC CONTROL PLAN SHEET. THIS ATTENUATOR WILL BE PAID FOR UNDER ITEM 621.57 "ENERGY ABSORPTION ATTENUATOR".

THE ATTENUATOR SHALL MEET THE REQUIREMENTS OF THE 1989 AASHTO "ROADSIDE DESIGN GUIDE", AND SHALL BE DESIGNED FOR A 4500 LB VEHICLE TRAVELING A 35 MPH.

IF THE ATTENUATOR IS DAMAGED BY AN ERRANT VEHICLE, ANY COST TO THE CONTRACTOR FOR REPLACEMENT OF ANY PART OR ALL OF THE ATTENUATOR SHALL BE PAID AS "EXTRA WORK" PER SECTION 109.06.

GENERAL

- THE CONTRACTOR SHALL INSURE THAT THE SIGNAL INSTALLATION CONFORMS TO THE "MANUAL ON UNIFORM TRAFFIC CONTROL DEVICES" WITH THE SUPPORTING STRUCTURES AS PER AASHTO'S STANDARD SPECIFICATIONS FOR STRUCTURAL SUPPORTS FOR HIGHWAY SIGNS, LUMINAIRES, AND TRAFFIC SIGNALS. CERTIFICATION SHALL NOT BE NECESSARY FOR TEMPORARY TRAFFIC SIGNAL EQUIPMENT.
- SIGNAL TIMING/TIMING ADJUSTMENTS REQUESTED BY THE RESIDENT ENGINEER SHALL BE ACCOMPLISHED WITHIN A 48 HOUR PERIOD AND PAYMENT SHALL BE SUBSIDIARY TO THE TRAFFIC SIGNAL ITEM. THE ALL-RED CLEARANCE INTERVAL IS BASED ON AN ASSUMED SPEED OF 15 MPH. THE RESIDENT ENGINEER SHALL MAKE SEVERAL TRIAL RUNS TO DETERMINE THE PROPER ALL-RED CLEARANCE INTERVAL.
- SIGNAL FACES SHALL CONSIST OF 12" LENSES, (RED, YELLOW, AND GREEN).
- THE BOTTOM OF THE HOUSING OF A SIGNAL FACE SUSPENDED OVER A ROADWAY SHALL NOT BE LESS THAN 16 1/2 FEET NOR MORE THAN 18 FEET ABOVE THE PAVEMENT GRADE AT THE CENTER OF THE ROADWAY. THE BOTTOM OF A SIGNAL FACE NOT MOUNTED OVER A ROADWAY SHALL NOT BE LESS THAN 8 FEET NOR MORE THAN 15 FEET ABOVE THE GROUND. CAUTION SHOULD BE USED TO INSURE COMPLIANCE WITH THE HEIGHT REQUIREMENTS IN THE EVENT THE NEW APPROACH GRADES DIFFER SIGNIFICANTLY FROM THE OLD ROAD GRADE.
- SIGNAL FACES FOR ANY ONE APPROACH SHALL NOT BE LESS THAN 8 FEET APART MEASURED HORIZONTALLY BETWEEN CENTER OF FACES.
- SIGNAL HEADS MAY BE HUNG ON A SPAN WIRE OR ON A CANTILEVER MAST ARM. AT LEAST ONE SIGNAL HEAD SHALL BE UNMISTAKABLY IN LINE WITH THE CENTER OF APPROACHING TRAFFIC AT ALL TIMES. THE SECOND SIGNAL HEAD MAY BE POST MOUNTED, LOCATED AT A DISTANCE NO GREATER THAN 14 1/2 FEET FROM THE CENTER OF THE APPROACH LANE WHEN THE STOP BAR IS 40 FEET FROM THE SIGNAL HEAD. CONSULT THE M.U.T.C.D. FOR ADDITIONAL INFORMATION CONCERNING SIGNAL PLACEMENT.
- SIGNAL HEAD PLACEMENT IS CRITICAL. HEADS SHALL BE ADJUSTED TO REFLECT LANE LOCATION CHANGES.
- THE SIGNAL SYSTEM SHALL CONSIST OF POLES, SIGNS AND POSTS. TEMPORARY PAVEMENT MARKINGS (AND REMOVALS), LUMINAIRES, AND SIGNAL EQUIPMENT TO PROVIDE FOR AN ADEQUATE DESIGN. IT ALSO INCLUDES PERMITS AND COST ASSOCIATED WITH PROVIDING ELECTRICAL POWER.
- THE CONTRACTOR SHALL PROVIDE AN ACTUATED CONTROLLER. THE APPROACHES NOTED SHALL HAVE A TEMPORARY VEHICLE DETECTOR. THE TYPE OF DETECTION SHALL BE INDICATED. THE CONTROLLER, VEHICLE DETECTORS AND ALL OTHER SIGNAL EQUIPMENT SHALL MEET OR EXCEED ALL NEMA STANDARDS.
- VEHICLE DETECTOR LOOPS SHALL BE 4' X 40' FOR PRESENCE DETECTION AT THE STOP BAR WITH THE NEAR PORTION LOCATED 5 FEET BEYOND THE STOP BAR. EXCEPT AT THE DRIVE AT REV STA +464 RT WHICH SHALL HAVE A 4' X 20' VEHICLE DETECTOR LOOP.

- ON SEMI-ACTUATED SIGNALS, PARTICULARLY WITH LONG BRIDGES, THE CONTROLLER SHOULD BE LOCATED ON THE SAME SIDE OF THE BRIDGE AS THE LOOP (HEAD "A" SIDE).
- INTERVAL TIMING SHOWN IN SECONDS.
- INTERCONNECT BETWEEN SIGNAL POLES BY WHATEVER MEANS POSSIBLE OR CONVENIENT TO PROVIDE FOR A SAFE INSTALLATION.
- PLACE TEMPORARY POLES BEHIND GUARDRAIL WHERE POSSIBLE.
- POLES SUPPORTING SPAN WIRES AND/OR MAST ARMS SHALL BE ADEQUATELY BRACED OR GUYED AND SHALL NOT BE PLACED SO AS TO CREATE A HAZARD TO THE TRAVELING PUBLIC.
- ALL TEMPORARY SIGNAL EQUIPMENT, SIGNS, ETC., SHALL BELONG TO THE CONTRACTOR AT THE END OF THE PROJECT AND HE SHALL BE RESPONSIBLE FOR THEIR REMOVAL, INCLUDING ANY TEMPORARY PAVEMENT MARKINGS, UTILITY POLES, WIRES, ETC..
- A 400 FOOT WATT MERCURY OR 200 WATT HPS LUMINAIRE AND MAST ARM SHALL BE PROVIDED ON A POLE ON EACH APPROACH AT A MOUNTING HEIGHT OF 30' ABOVE ROADWAY CENTERLINE TO LIGHT UP THE AREA AROUND THE SIGNAL HEADS AND STOP BAR FOR INCREASED VISIBILITY. THE RESIDENT ENGINEER SHALL DETERMINE THE ADEQUACY OF THE LIGHTING AND DIRECT CHANGES IF THE LIGHTING IS INSUFFICIENT.
- STOP BARS SHALL BE LOCATED A MINIMUM OF 40' AND A MAXIMUM OF 120' FROM THE NEAREST SIGNAL HEAD.
- PAYMENT FOR THE VEHICLE LOOP DETECTOR ITEM SHALL BE LINEAR FOOT OF SAWSLIT IN THE PAVEMENT, OR LOOP BURIED IN PVC CONDUIT ON A NON-PAVED APPROACH.
- THE SIGNS AND ASSOCIATED POSTS NOTED BELOW ARE SUBSIDIARY TO THE TRAFFIC CONTROL SIGNAL SYSTEM - INTERSECTION (MOD. ITEM, (STOP BARS, "STOP HERE ON RED", "SIGNAL AHEAD", "NO PASSING ZONE", AND "TO GET GREEN LIGHT").
- SEE STD. E-140 FOR "STOP HERE ON RED" SIGN DETAIL AND E-102 FOR "SIGNAL AHEAD" SYMBOL SIGN. THE "SIGNAL AHEAD" SIGN SHALL HAVE AN ORANGE BACKGROUND (REFLECTORIZED). SEE STD. E-121 FOR SIGN PLACEMENT. SEE STDS. E-170 THROUGH E-172 FOR ADDITIONAL INFORMATION ON SIGNALS AND DETECTORS.
- A "SIGNAL AHEAD" SIGN SHOULD BE PLACED 500' FROM THE SIGNAL OR AT A POSITION TO BE DETERMINED BY THE ENGINEER. ALL POSTS SHALL BE CONSIDERED AS SUBSIDIARY TO THE TRAFFIC SIGNAL ITEM.
- THE "NO PASSING" SIGN SHALL BE USED TO PREVENT PASSING FOR 750' IN ADVANCE OF THE STOP BAR. THE SIGN SHALL BE PER STANDARD E-102, EXCEPT THE COLOR SHALL BE A BLACK TEXT AND BORDER ON A REFLECTORIZED ORANGE BACKGROUND.
- ALL ELECTRICAL WORK SHALL MEET THE REQUIREMENTS OF THE NATIONAL ELECTRICAL CODE AND STATE INSPECTOR.

**ARCHIVED
IN DPR**

TD04.DGN

DATE	REVISIONS	BY
6/27/87	DELETE FTM	L.S.W.
6/27/87	CHANGE RPD	L.S.W.
	LENGTHEN LOOPS; ADDED "GREEN LIGHT" SIGN.	
5/28/88	UPDATE STD'S	DSP
3/91	ADD PAVEMENT MARKING NOTES & PHASE DIAGRAM	DSP

ONE-WAY DETOUR WITH TEMPORARY TRAFFIC SIGNAL

**STATE OF VERMONT
AGENCY OF TRANSPORTATION**

Town Of **SUNDERLAND** Bridge No. **2**
Highway No. **TH 1** Log Sta. **N/A**
Surv. Sta. **5+00**

TH 1 OVER THE MILL BROOK



TRAFFIC CONTROL NOTES

Designed By **P.M. THURBER** Drawn By **P.M. THURBER**
Checked by **C.W. MEUNIER** Date **08/94** Bridge Design Supervisor **G.S. ROGERS** Date **08/94**

PROJECT **SUNDERLAND** PROJECT NO. **TH2 - 9003**

I.G.C. Info. / s/rr/89/1092/s/1092mp.dgn s/1092cl.parm

Bridge Sheet No. **8** of **37**

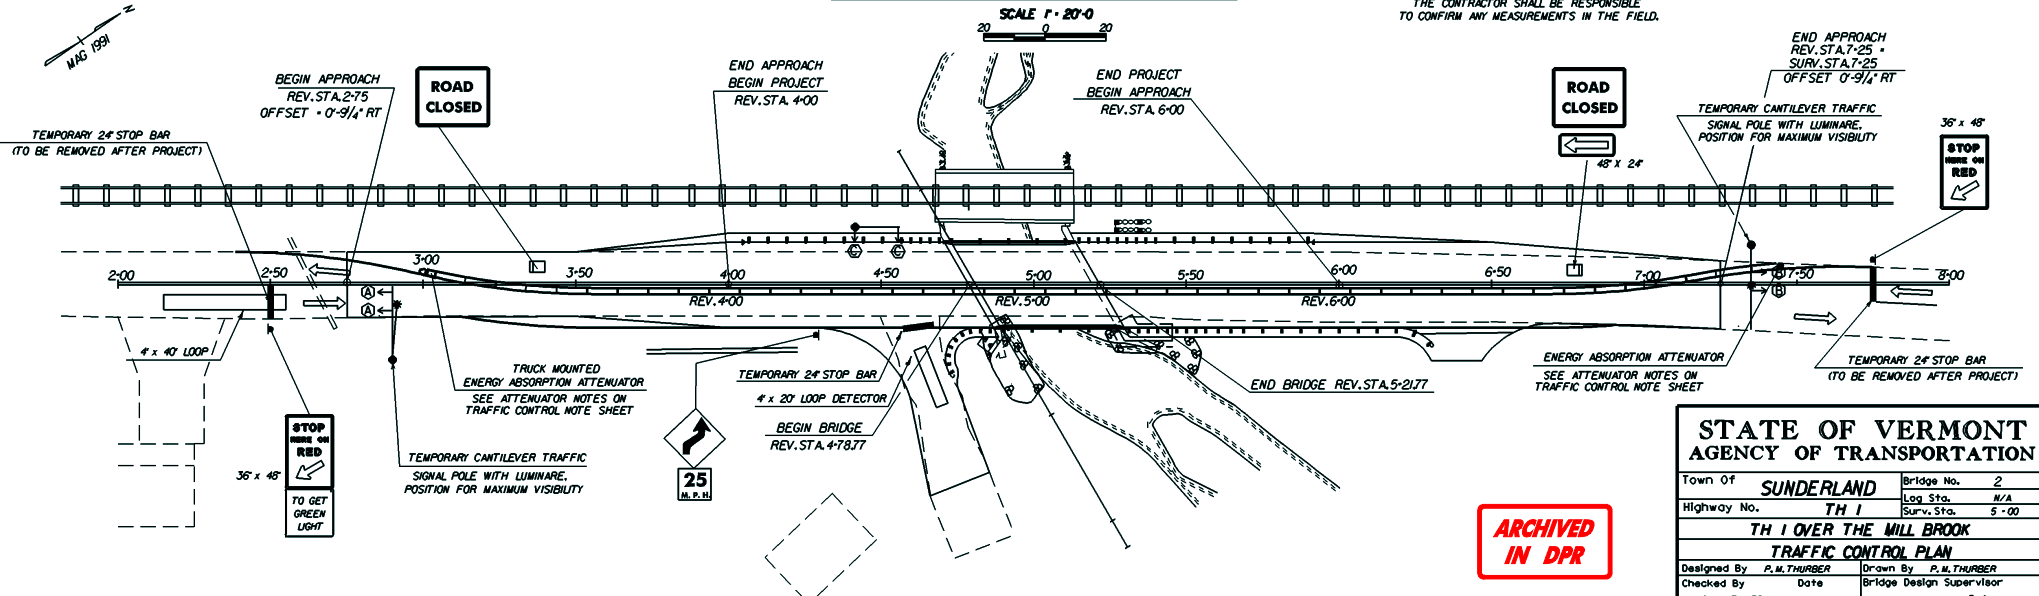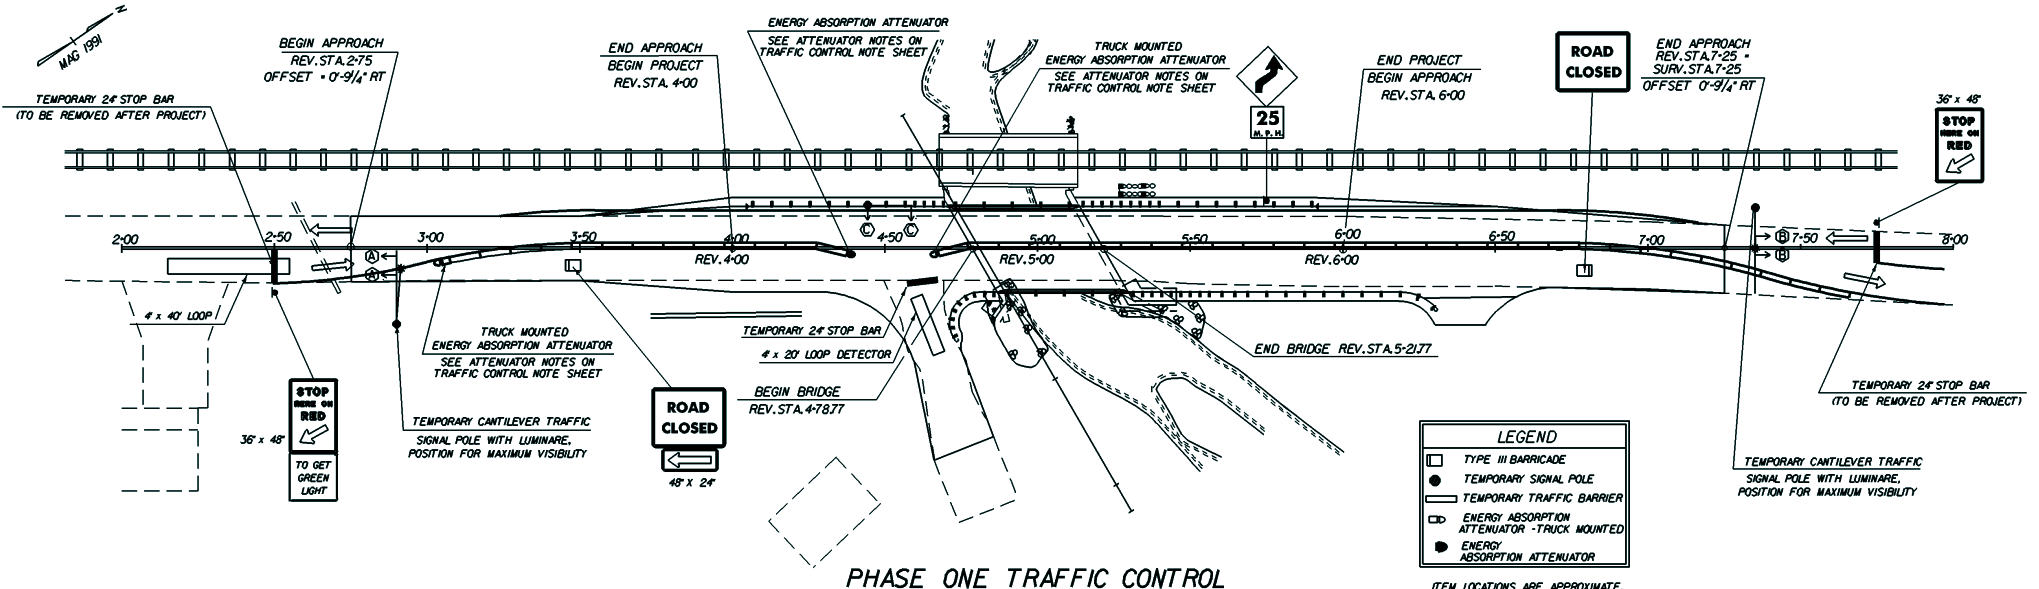

**ARCHIVED
IN DPR**

STATE OF VERMONT AGENCY OF TRANSPORTATION		
Town Of SUNDERLAND	Bridge No. 2	
Highway No. TH 1	Log Sta. N/A	Surv. Sta. 5+00
TH 1 OVER THE MILL BROOK		
TRAFFIC CONTROL PLAN		
Designed By P.M. THURBER	Drawn By P.M. THURBER	
Checked By C.W. MEUNIER	Date 2/97	Bridge Design Supervisor G.S. ROGERS
PROJECT SUNDERLAND	PROJECT NO. TH2 - 9003	Date 2/97
I.G.C. Info/gst/89/1090/s/1090mp.dgn		
Bridge Sheet No.	Sheet 9	of 37

Sheet Number: 9

SOIL CLASSIFICATION

AASHTO

- A1 Gravel and Sand
- A3 Fine Sand
- A2 Silty or Clayey Gravel and Sand
- A4 Silty Soil - Low Compressibility
- A5 Silty Soil - Highly Compressible
- A6 Clayey Soil - Low Compressibility
- A7 Clayey Soil - Highly Compressible

COMMONLY USED SYMBOLS

- ▼ Water Elevation
- ⊙ Standard Penetration Boring
- ⊕ Auger Boring
- ⊖ Rod Sounding
- ⊙ Sample
- N Standard Penetration Test
 - Blow Count Per Foot For:
 - 2" O. D. Sampler
 - 1 1/2" I. D. Sampler
 - Hammer Weight Of 140 Lbs.
 - Hammer Fall Of 30'
- VS Field Vane Shear Test
- US Undisturbed Soil Sample
- B Blast
- DC Diamond Core
- MD Mud Drill
- WA Wash Ahead
- HSA Hollow Stem Auger
 - AX Core Size 1 1/2"
 - BX Core Size 1 3/4"
 - NX Core Size 2 1/8"
- M Double Tube Core Barrel Used
- LL Liquid Limit
- PL Plastic Limit
- PI Plasticity Index
- NP Non Plastic
- w Moisture Content (Dry Wgt. Basis)
- D Dry
- M Moist
- MTW Moist To Wet
- W Wet
- Sat Saturated
- Bo Boulder
- Gr Gravel
- Sa Sand
- SI Silt
- CI Clay
- HP Hardpan
- Le Ledge
- NLTD No Ledge To Depth
- CNPF Can Not Penetrate Further
- TLOB To Ledge Or Boulder
- NR No Recovery
- Rec. Recovery
- %Rec. Percent Recovery
- RQD Rock Quality Designation
- CBR California Bearing Ratio
- < Less Than
- > Greater Than
- R Refusal (N > 100)

ROCK QUALITY DESIGNATION

R.Q.D. (%)	ROCK DESCRIPTION
<25	Very Poor
25 to 50	Poor
51 to 75	Fair
76 to 90	Good
>90	Excellent

SHEAR STRENGTH

UNDRAINED SHEAR STRENGTH IN P.S.F.	CONSISTENCY
<250	Very Soft
250-500	Soft
500-1000	Med. Stiff
1000-2000	Stiff
2000-4000	Very Stiff
>4000	Hard

CORRELATION GUIDE OF "N" TO DENSITY/CONSISTENCY


DENSITY (GRANULAR SOILS)		CONSISTENCY (COHESIVE SOILS)	
N	DESCRIPTIVE TERM	N	DESCRIPTIVE TERM
<5	Very Loose	<2	Very Soft
5-10	Loose	2-4	Soft
11-24	Med. Dense	5-8	Med. Stiff
25-50	Dense	9-15	Stiff
>50	Very Dense	16-30	Very Stiff
		31-60	Hard
		>60	Very Hard

COLOR

bk	Black	prk	Pink
bl	Blue	pu	Purple
brn	Brown	rd	Red
dk	Dark	tn	Tan
gr	Gray	wh	White
gn	Green	yel	Yellow
lf	Light	mtc	Multicolored
or	Orange		

BORING CHART

HOLE NO.	SURV. STATION	OFFSET	GROUND ELEV.	ELEV. TLOB
B1	4+82	15' RT.	655.01	
B2	5+35	14' RT.	654.94	

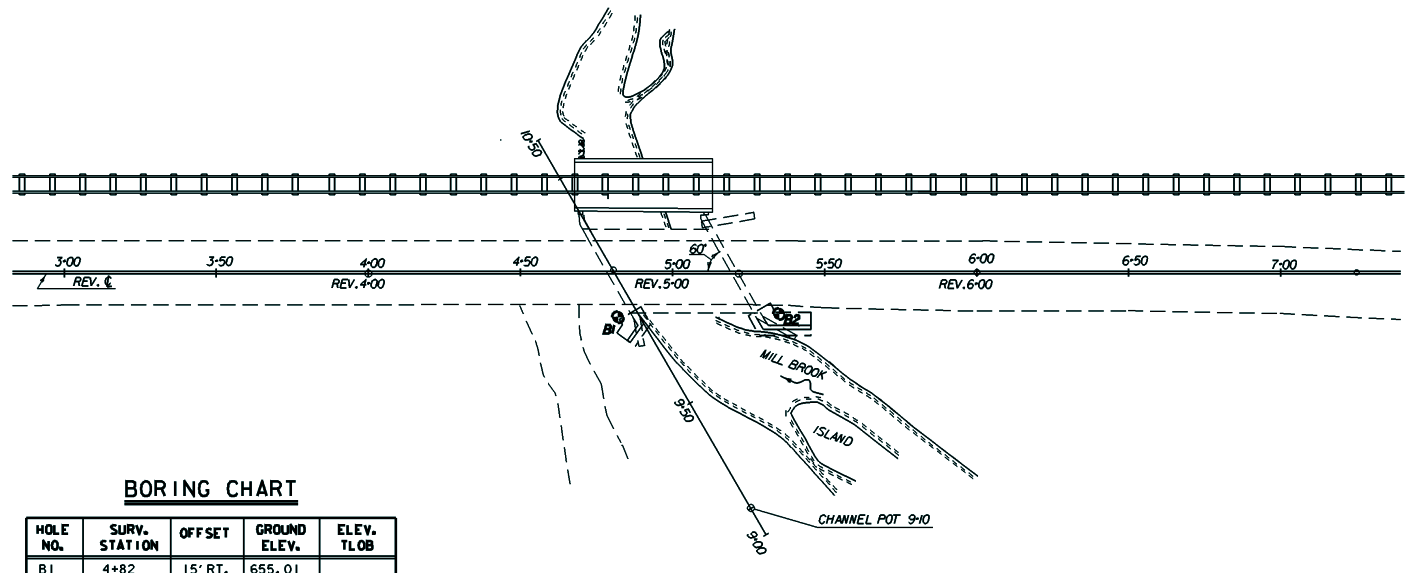

PLAN

SCALE 1" = 20'-0"

ARCHIVED
IN DPR

DEFINITIONS (AASHTO)

- BEDROCK (LEDGE)** - Rock in its native location of indefinite thickness.
- BOULDER** - A rock fragment with an average dimension > 12 inches.
- COBBLE** - Rock fragments with an average dimension between 3" and 12 inches.
- GRAVEL** - Rounded particles of rock < 3" and > 0.075" (#10 sieve).
- SAND** - Particles of rock < 0.075" (#10 sieve) and > 0.0025" (#200 sieve).
- SILT** - Soil < 0.0025" (#200 sieve), non or slightly plastic and exhibits no strength when air-dried.
- CLAY** - Fine grained soil, exhibits plasticity when moist and considerable strength when air-dried.
- VARVED** - Alternate layers of silt and clay.
- HARDPAN** - Extremely dense soil, cemented layer, not softened when wet.
- MUCK** - Soft organic soil containing > 10% organic material.
- MOISTURE CONTENT** - Weight of water divided by dry weight of soil.
- FLOWING SAND** - Granular soil so saturated (water) that it flows into drill casing during extraction of wash rod.
- STRIKE** - Angle from magnetic north to line of intersection of bed with a horizontal plane.
- DIP** - Inclination of bed with a horizontal plane.

GENERAL NOTES

- The subsurface explorations shown herein were made between March 24 and April 4, 1996 by the Agency.
- Soil and rock classifications, properties and descriptions are based on engineering interpretation from available subsurface information by the Agency and may not necessarily reflect actual variations in subsurface conditions that may be encountered between individual boring or sample locations.
- Observed water levels and/or conditions indicated are as recorded at the time of exploration and may vary according to the prevailing rainfall, methods of exploration and other factors.
- Engineering judgement was exercised in preparing the subsurface information presented herein. Analysis and interpretation of subsurface data was performed and interpreted for Agency design and estimating purposes. Presentation of the information in the Contract is intended to provide the Contractor access to the same data available to the Agency. The subsurface information is presented in good faith and is not intended as a substitute for personal investigation, independent interpretation, independent analysis or judgement by the Contractor.
- Pictorial structure details shown on the boring plan layout or soils profile are for illustrative purposes only and may not accurately portray final contract details.
- Terminology used on boring logs to describe the hardness, degree of weathering, and spacing of fractures, joints and other discontinuities in the bedrock is defined in the AASHTO Manual Subsurface Investigations, 1988.

**STATE OF VERMONT
AGENCY OF TRANSPORTATION**

Town Of	SUNDERLAND	Bridge No.	2
Highway No.	TH 1	Log Sta.	500
TH 1 OVER THE MILL BROOK			
BORING INFORMATION SHEET			
Designed By	P.T. LONSDALE	Drawn By	J.P. SPILAK
Checked By	C.W. MEUMER	Date	5/96
		Bridge Design Supervisor	G.S. ROGERS
		Date	5/96
PROJECT	SUNDERLAND	PROJECT NO.	TH2-9003
I.G.C. Info. / s111/891090/s1090bor.dgn			
Bridge Sheet No.		Sheet	10 of 37

STATE OF VERMONT AGENCY OF TRANSPORTATION MATERIALS & RESEARCH DIVISION SUBSURFACE INFORMATION		HOLE NO.: B-1 SHEET 1 OF 1 DATE STARTED: 4/3/96 DATE COMPLETED: 4/4/96							
PROJECT NAME: SUNDERLAND SITE NAME: TH 1 STATION: 4+82.00 GROUND EL.: 655.01		PROJECT NUMBER: TH2 9003 SITE NO.: BRIDGE 2 OFFSET: 15.00 G.W. DEPTH:							
BORING CREW CREW CHIEF: WILLIS DRILLER: CHABOT LOGGER:		BORING RIG: TRUCK BORING TYPE: WASH BORE SAMPLE TYPE: SPLIT BARREL							
DEPTH	SYMBOL	CLASSIFICATION OF MATERIALS (Description)	BLOWS PER FOOT	M.C. %	GRAVEL %	SAND %	FINES %	LL	PI
		Pavement							
		Boulders, no sample.							
5		No recovery.	12						
		A-1-a, Gr, moist, brn, Rec. = 0.8'	R	8.2	69.2	19.4	11.4		
		BXMC 7.4' - 10.5' Concrete							
10		No recovery, boulders.	R						
		No sample, boulders.							
15		A-1-b, SiGrSa, sat., brn, Rec. = 0.3'	7	11.2	33.4	46.4	20.2		
		A-2-4, Sa, wet, brn, Rec. = 0.3'	11	29.7	2	80.6	17.4		
20		A-2-4, Sa, MTW, brn, Rec. = 0.5'	21	23.4	1.8	79.9	18.3		
25		No recovery	14						
30		A-1-a, SaGr, moist, brn, Rec. = 0.1'	19	7.9	74.2	21.6	4.2		
35		A-1-a, SaGr, MTW, brn, Rec. = 0.5'	31	13.9	60.3	26.3	13.4		
40		A-1-a, Gr, MTW, brn, Rec. = 0.8'	38	11.6	78.3	13.4	8.3		
		Hole stopped @ 42'							
45									


BOTTOM OF W#2 FOOTING
ELEVATION = 643.00

STATE OF VERMONT AGENCY OF TRANSPORTATION MATERIALS & RESEARCH DIVISION SUBSURFACE INFORMATION		HOLE NO.: B-2 SHEET 1 OF 1 DATE STARTED: 3/24/96 DATE COMPLETED: 4/3/96							
PROJECT NAME: SUNDERLAND SITE NAME: TH 1 STATION: 5+35.00 GROUND EL.: 654.94		PROJECT NUMBER: TH2 9003 SITE NO.: BRIDGE 2 OFFSET: 14.00 G.W. DEPTH:							
BORING CREW CREW CHIEF: WILLIS DRILLER: CHABOT LOGGER:		BORING RIG: TRUCK BORING TYPE: WASH BORE SAMPLE TYPE: SPLIT BARREL							
DEPTH	SYMBOL	CLASSIFICATION OF MATERIALS (Description)	BLOWS PER FOOT	M.C. %	GRAVEL %	SAND %	FINES %	LL	PI
		Pavement							
5		No recovery	24						
10		No sample, boulders. BXMC 8.0' - 11.0'							
15		No recovery, boulders.							
20		A-1-a, SaGr, Moist, brn, Rec. = 0.5'	21	12.5	66.2	26.4	7.4		
25		A-2-4, SiSa, MTW, brn, Rec. = 0.8'	11	29.2	0	75.3	24.7		
30		A-2-4, SiSa, Moist, brn, Rec. = 1.2'	23	16	0	74.4	25.6		
35		A-4, SiSa, Moist, brn, Rec. = 0.6'	11	25.8	0	50.4	49.6		
40		A-2-4, Sa, Moist, brn, Rec. = 1.3'	20	24.4	8	75.3	16.7		
		Hole stopped @ 42'							
45									


BOTTOM OF W#4 FOOTING
ELEVATION = 643.00

ARCHIVED
IN DPR

STATE OF VERMONT AGENCY OF TRANSPORTATION			
Town Of	SUNDERLAND	Bridge No.	2
Highway No.	TH 1	Log Sta.	500
TH 1 OVER THE MILL BROOK			
BORING LOG SHEET			
Designed By	P.T. LONSDALE	Drawn By	J.P. SPILAK
Checked By	C.W. MEUMER	Bridge Design Supervisor	G.S. ROGERS
Date	5/96	Date	5/96
PROJECT	SUNDERLAND	PROJECT NO.	TH2-9003
I.G.C. Info. /str1/89/090/sj090bor.dgn		sj090bor2j	
Bridge Sheet No.		Sheet	11 of 37

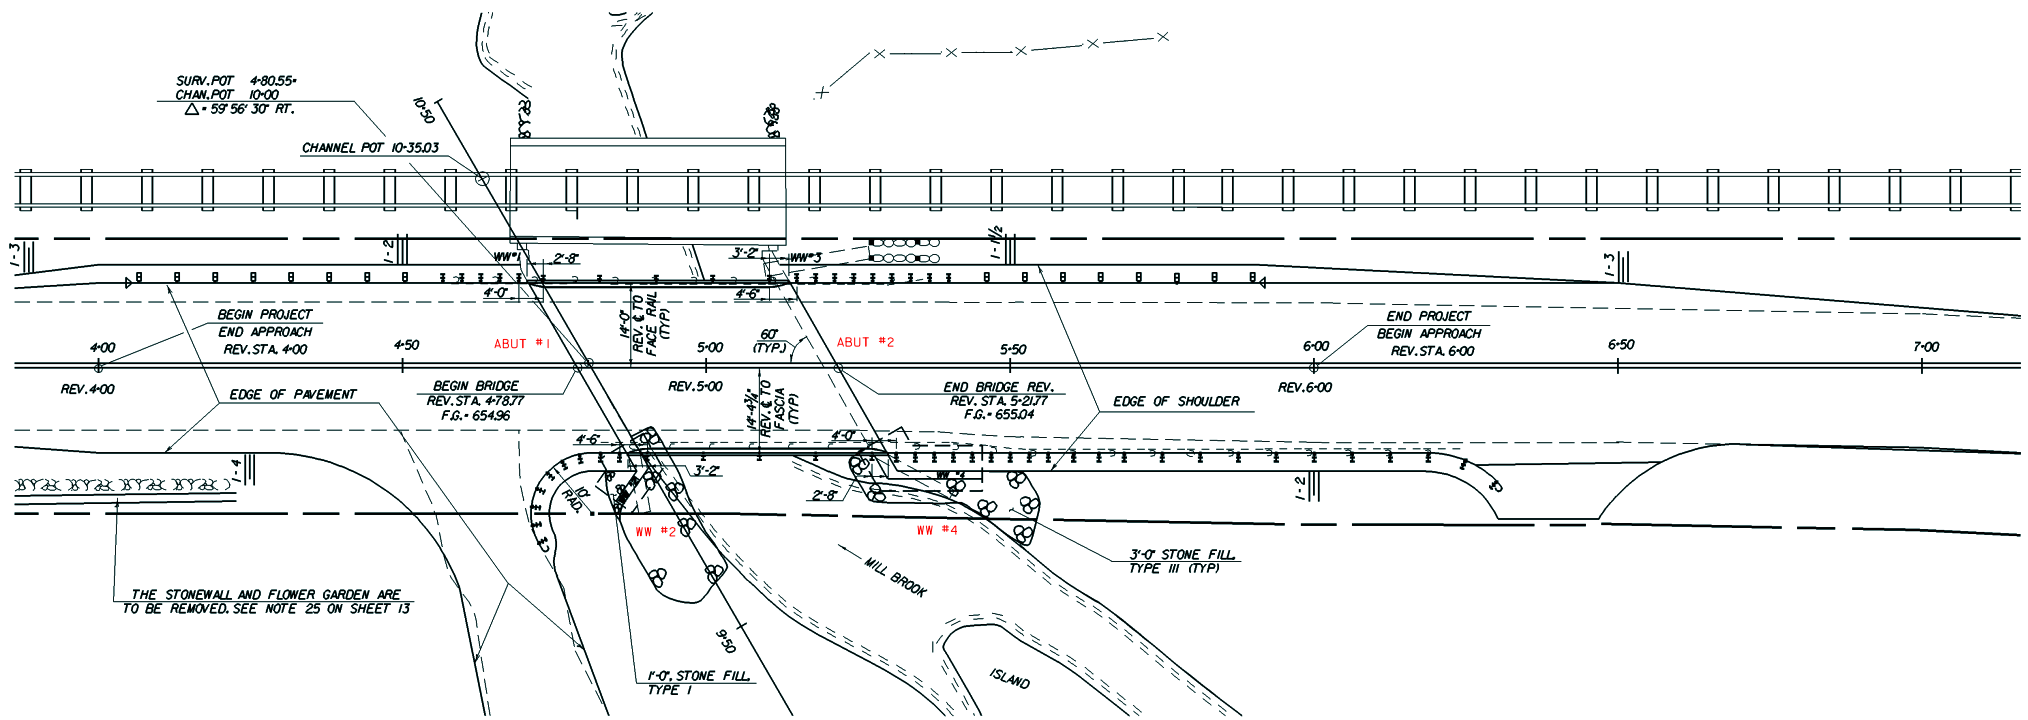

PLAN
SCALE 1" = 10'-0"

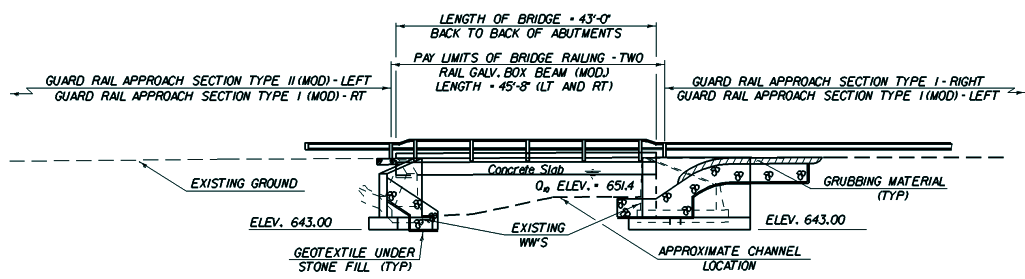

ELEVATION VIEW AT UPSTREAM FASCIA
SCALE 1" = 10'-0"


**ARCHIVED
IN DPR**

**STATE OF VERMONT
AGENCY OF TRANSPORTATION**

Town Of	SUNDERLAND	Bridge No.	2
Highway No.	TH 1	Log Sta.	5+00
TH 1 OVER THE MILL BROOK			
PLAN AND ELEVATION			
Designed By	C. SCHMELZENBACH	Drawn By	C. SCHMELZENBACH
Checked By	P.T. LOWSDALE	Date	11/93
		Bridge Design Supervisor	G.S. ROGERS
		Date	11/93
PROJECT	SUNDERLAND	PROJECT NO.	TH2 - 9003
L.G.C. Info. / svt/1/89/1090/s/1090pa.dgn		s/1090pa/para	
Bridge Sheet No.	Sheet 12	of 37	

GENERAL NOTES

- ALL MATERIALS AND CONSTRUCTION SHALL CONFORM TO STATE OF VERMONT, AGENCY OF TRANSPORTATION, 1990 STANDARD SPECIFICATIONS FOR HIGHWAY AND BRIDGE CONSTRUCTION, AND ITS LATEST REVISIONS, AND THE AASHTO SPECIFICATIONS FOR HIGHWAY BRIDGES, DATED 1992, AND ITS LATEST REVISIONS.
- THE CONTRACTOR SHALL TAKE ALL PRECAUTIONS NECESSARY TO PREVENT SILTATION OR POLLUTION, ESPECIALLY THE DISCHARGE OF RAW CONCRETE, INTO THE MILL BROOK, AS DIRECTED BY THE RESIDENT ENGINEER AND STANDARD SPECIFICATION, SECTION 105.
- IN-STREAM CONSTRUCTION SHALL BE CONDUCTED DURING THE PERIOD OF JUNE 1 - OCTOBER 1, UNLESS THE CONTRACTOR OBTAINS PERMISSION FROM THE AGENCY OF NATURAL RESOURCES TO DO WORK OUTSIDE OF THAT TIME FRAME.
- ALLOWABLE SOIL PRESSURE: 4 KSF
DESIGN SOIL PRESSURE: WINGWALL NO.2 215 KSF
WINGWALL NO.4 215 KSF
- THE BRIDGE SEATS SHALL BE POURED LEVEL FROM FRONT TO BACK OF ABUTMENT.
- ALL EXPOSED EDGES OF CONCRETE SHALL BE CHAMFERED R BY R.
- JOINTS AND SCORE MARKS IN CONCRETE SHALL BE CONSTRUCTED AS INDICATED ON THE PLANS OR AS DIRECTED BY THE RESIDENT ENGINEER.
- THE KEY ON CONCRETE JOINTS SHALL BE MONOLITHIC AND CONTINUOUS FOR THE FULL LENGTH OF THE JOINT. ANY UPWARD KEY SHALL BE PLACED INTEGRALLY WITH THE CONCRETE BELOW THE JOINT.
- REINFORCING PLACEMENT TOLERANCES SHALL BE:
SPACING: ± 1"
CLEARANCE: ± 1/4"
- ALL REINFORCING STEEL SHALL BE DETAILED AND FABRICATED USING PROCEDURES AND TOLERANCES IN ACCORDANCE WITH APPLICABLE PUBLICATIONS OF "CONCRETE REINFORCING STEEL INSTITUTE".
- MINIMUM COVER FOR REINFORCING STEEL IN SUBSTRUCTURES SHALL BE THREE (3) INCHES, UNLESS DETAILED OTHERWISE.
- WATER REPELLENT SHALL BE APPLIED TO ALL EXPOSED CONCRETE SURFACES EXCEPT THE UNDERSIDE OF THE SLAB BETWEEN DRIP BEADS.
- ALL DIMENSIONS ARE EITHER HORIZONTAL OR VERTICAL AND ARE GIVEN AT 68°F.
- THE ITEM "PARTIAL REMOVAL OF STRUCTURE" SHALL INCLUDE THE REMOVAL OF THE EXISTING SUPERSTRUCTURE, EXISTING ABUTMENTS TO THE ELEVATION SHOWN ON THE PLANS, AND ANY PORTION OF THE EXISTING WINGWALLS THAT FALL OUTSIDE THE LIMITS OF THE COFFERDAMS.
- THE ITEM 204.40 "COFFERDAM" SHALL BE USED AT REV STA 4+88 RT (WINGWALL NO.2) AND REV STA 5+37 RT (WINGWALL NO.4). SEE SHEET NO. 2 FOR COFFERDAM NOTES AND DETAIL.
- THE EXISTING ABUTMENTS AND WINGWALLS THAT FALL INSIDE THE COFFERDAM SHALL BE REMOVED UNDER THE ITEMS "COFFERDAM (REV STA 4+88 RT)" AND "COFFERDAM (REV STA 5+37 RT)".
- THE COST OF ANY ON-PROJECT SIGNS AND BARRICADES SHALL BE SUBSIDIARY TO ITEM 635.10 "MOBILIZATION." ANY OFF-PROJECT SIGNING SHALL BE THE RESPONSIBILITY OF THE TOWN OF SUNDERLAND, IN PARTICULAR A SIGN AT THE INTERSECTION OF TH 1 AND TH 2 WARNING OF THE CONSTRUCTION AND ONE LANE ROAD AHEAD.
- TRAFFIC SHALL BE MAINTAINED ON TH 1 (ONE) DURING THE CONSTRUCTION OF THE NEW BRIDGE. THIS WORK SHALL BE PAID FOR UNDER ITEM "MAINTENANCE OF TRAFFIC FOR BRIDGE PROJECTS".
- ACCESS TO THE DRIVES AT REV STA 2+20 RT AND REV STA 4+64 RT SHALL BE MAINTAINED. ALL WORK NECESSARY TO MAINTAIN ACCESS SHALL BE PAID FOR UNDER THE ITEM "MAINTENANCE OF TRAFFIC FOR BRIDGE PROJECTS".
- PAYMENT FOR REMOVAL OF EXISTING BITUMINOUS CONCRETE PAVEMENT ON THE BRIDGE SHALL BE MADE UNDER ITEM 529.10 "REMOVAL OF BRIDGE PAVEMENT". THE MATERIAL SHALL BECOME THE PROPERTY OF THE CONTRACTOR AND SHALL BE DISPOSED OF PROPERLY AT AN OFF-SITE LOCATION.
- ALL CONCRETE SHALL BE 501.25 "CONCRETE, CLASS B" EXCEPT FOR THE CONCRETE CURBS, WHICH WILL BE 501.60 "SILICA FUME CONCRETE".
- THE REINFORCING STEEL DETAILS CONTAINED IN THESE PLANS WHICH REQUIRE MECHANICAL BAR CONNECTORS ARE DETAILED BASED UPON USING THE TYPE OF MECHANICAL BAR CONNECTOR AS SHOWN ON SHEET 14. IF THE CONTRACTOR ELECTS TO USE ANOTHER TYPE OF CONNECTOR, THE LENGTHS OF THE AFFECTED REINFORCING STEEL BARS MAY CHANGE.
- THERE SHALL BE NO DISTURBANCES WITHIN ANY WETLAND AREA, EITHER ON THE WEST SIDE OF THE RAILROAD BED OR IN THE FORESTED WETLAND ON THE EAST SIDE OF TH 1. NO MACHINERY SHALL OPERATE IN EITHER OF THE WETLAND AREAS.
- A SILT FENCE SHALL BE INSTALLED IN THE AREA SHOWN ON SHEET 5 AND REMAIN IN PLACE DURING CONSTRUCTION IN ORDER TO PROTECT THE WETLANDS THAT ARE LOCATED IN THIS AREA. THIS SHALL BE PAID AS ITEM 649.51 "GEOTEXTILE FOR SILT FENCE".
- PORTIONS OF THE THE STONEWALL AND FLOWER GARDEN IN THE AREA OF REV STA 3+69 RT ~ REV STA 4+22 RT ARE TO BE REMOVED BY THE PROPERTY OWNER PRIOR TO CONSTRUCTION. THE RESIDENT ENGINEER SHALL ENSURE THAT THE PROPERTY OWNER HAS COMPLETED ANY AND ALL WORK THAT THEY WISH TO DO THEMSELVES. THE CONTRACTOR SHALL BE RESPONSIBLE FOR THE REMOVAL OF THE REMAINING PORTIONS.
- THE 8' HONEYSUCKLE LOCATED AT REV STA 4+86 - 26' RT SHALL BE TRANSPLANTED BY THE CONTRACTOR TO A LOCATION AS DETERMINED BY THE RESIDENT ENGINEER, IN CONSULTATION WITH THE PROPERTY OWNER. THIS WORK SHALL BE PAID AS ITEM 656.50 "TRANSPLANTING SHRUBS".
- ALL WORK AND STAGING SHALL BE DONE FROM THE ROADWAY. SPECIAL CARE SHALL BE TAKEN IN THE LAWN AREA OF REV STA 3+50 RT ~ REV STA 4+60 RT AS IT CONTAINS THE SEPTIC SYSTEM AND LEACH FIELD FOR THE 1/2 STORY WOOD FRAMED HOUSE ON THIS PROPERTY.

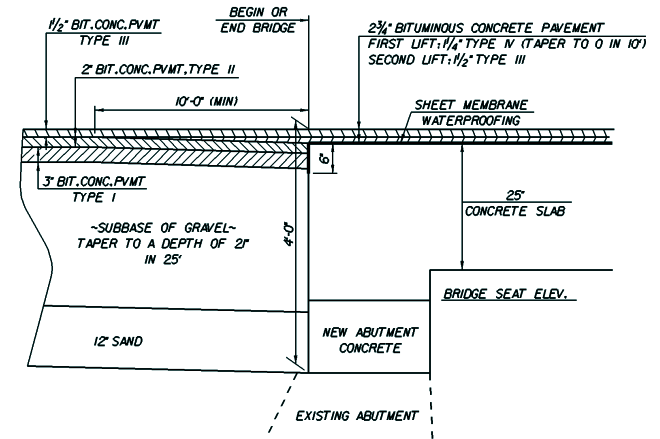


MATERIAL TRANSITION BEHIND ABUTMENTS

NTS

- ITEM 621.90, TEMPORARY TRAFFIC BARRIER, SHALL BE PAID ONLY ONCE PER PHASE OF CONSTRUCTION.
- THE SHORING FOR THE PLACEMENT OF PHASE I OF THE SLAB SHALL BE LEFT IN PLACE DURING THE FORMING AND PLACEMENT OF PHASE II.

**ARCHIVED
IN DPR**


STATE OF VERMONT AGENCY OF TRANSPORTATION			
Town Of	SUNDERLAND	Bridge No.	2
Highway No.	TH 1	Log Sta.	
		Surv. Sta.	500
TH 1 OVER THE MILL BROOK			
GENERAL NOTES AND MATERIAL TRANS. DETAIL			
Designed By	C.W. MEUNIER	Drawn By	C.C. RICE
Checked By	Date	Bridge Design Supervisor	Date
C.W. MEUNIER	12/96	G.S. ROGERS	12/96
PROJECT	SUNDERLAND	PROJECT NO.	TH2-9003
L.G.C. Info. / gmv/89/090/s/020gndgn s/020gen/			
Bridge Sheet No.		Sheet	13 of 37

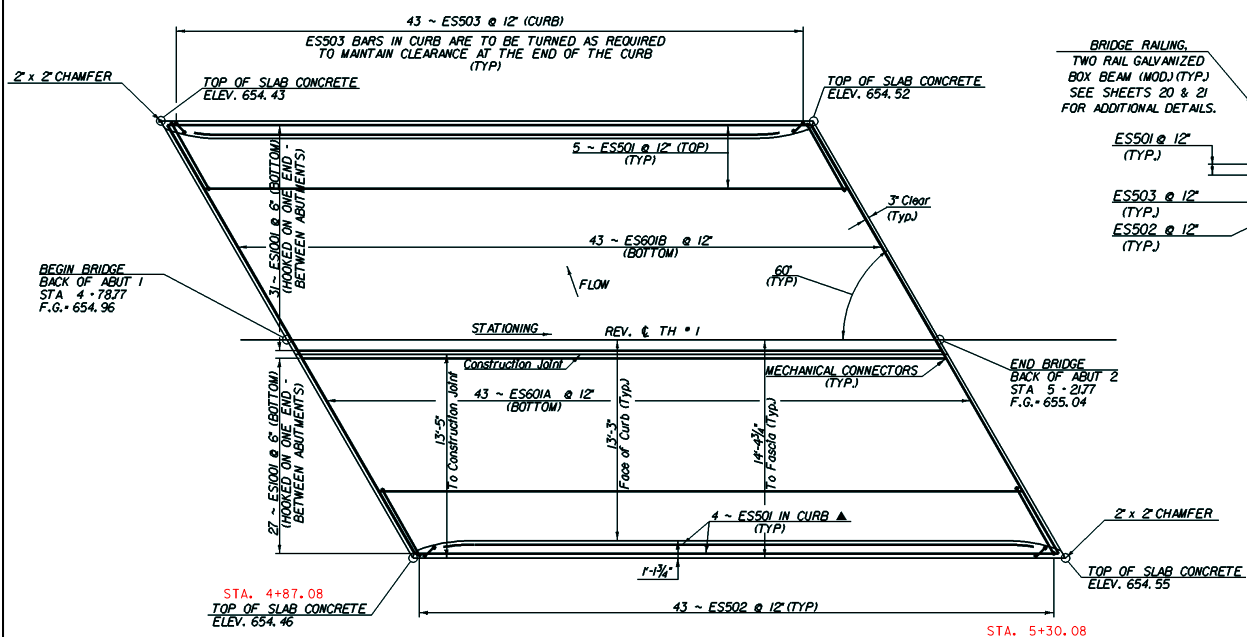

NOTES:

1. THE SLAB SHALL BE CAMBERED A TOTAL OF 3/4" AT MIDSPAN. THIS CAMBER SHALL APPROXIMATE A CIRCULAR CURVE.
2. THE SHORING FOR PHASE I SHALL BE LEFT IN PLACE DURING THE FORMING AND PLACEMENT OF PHASE II.
3. ▲ - CUT TO FIT IN THE FIELD.
4. COST OF TAR PAPER AND PIPE INSULATION AND ITS APPLICATION SHALL BE SUBSIDIARY TO CONCRETE, CLASS B.



SLAB REINFORCING PLAN
SCALE 1/4" = 1'-0"

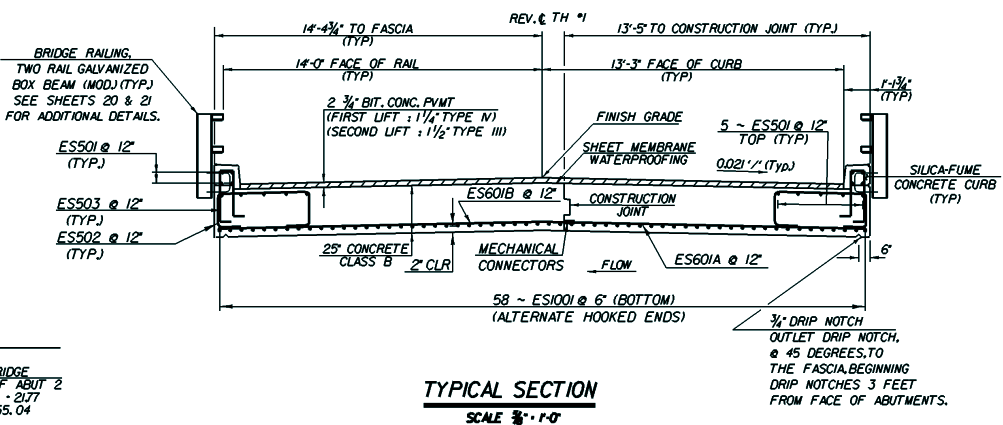

MECHANICAL BAR CONNECTOR DETAILS
M.T.S.


NOTE :

THE CONTRACTOR SHOULD NOTE THAT THERE MAY BE SOME COMPLICATIONS WITH FORMING THE MECHANICAL BAR CONNECTORS ON THE SKEW.

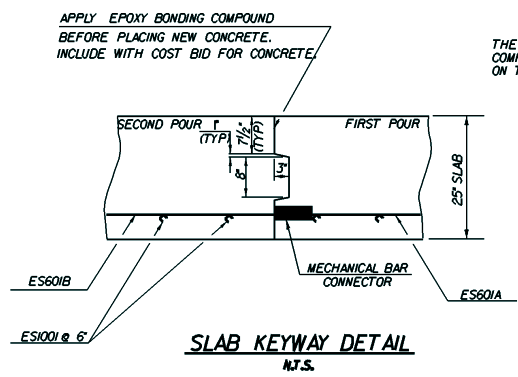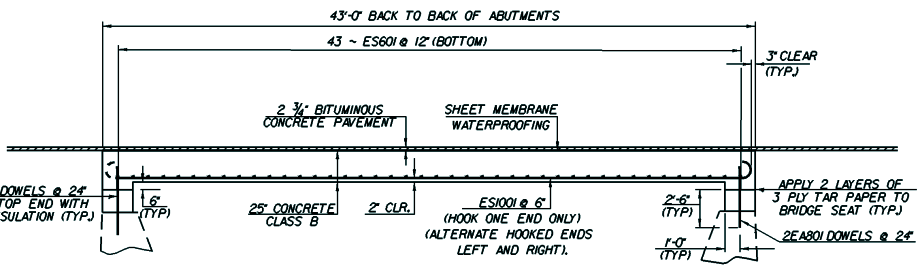

ARCHIVED IN DPR


STATE OF VERMONT AGENCY OF TRANSPORTATION			
Town Of	SUNDERLAND	Bridge No.	2
Highway No.	TH 1	Log Sta.	
		Surv. Sta.	
TH OVER THE MILL BROOK			
SLAB DETAILS			
Designed By	J.P. Spat	Drawn By	J.P. Spat
Checked By	C.W. MEUNIER	Date	11/96
		Bridge Design Supervisor	G.S. ROGERS
		Date	12/96
PROJECT	SUNDERLAND	PROJECT NO.	TH2 9003
L.G.C. Info. / 8/11/89 1090/s 1090a/b/d/g		s/090a/b/d	
Bridge Sheet No.		Sheet	14 of 37

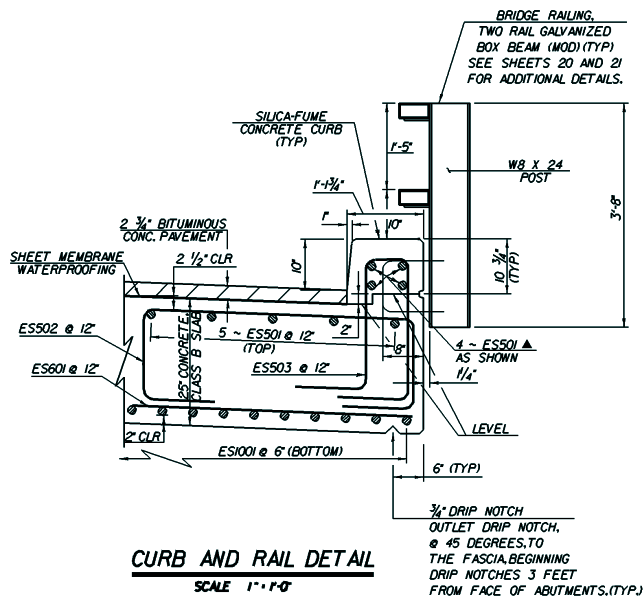


CURB AND RAIL DETAIL
SCALE 1"=1'-0"

NOTE:
SEE STD. DWG. SB-R6-82 FOR
POST ANCHORAGE DETAILS

3/4" DRIP NOTCH
OUTLET DRIP NOTCH,
@ 45 DEGREES, TO
THE FASCIA, BEGINNING
DRIP NOTCHES 3 FEET
FROM FACE OF ABUTMENTS. (TYP)

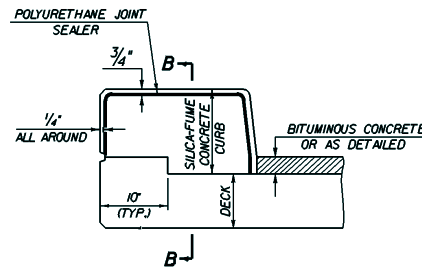


**TYPICAL SECTION THROUGH
CONCRETE CURB CONSTRUCTION JOINT**

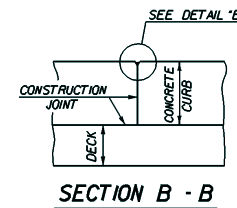


SECTION B - B


POLYURETHANE JOINT SEALER
PER SUBSECTION 524.06C
COLOR TO MATCH CONCRETE.
COST TO BE INCLUDED IN THE
UNIT PRICE BID FOR CONCRETE.

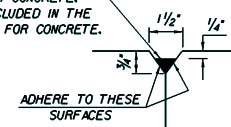


DETAIL "B"

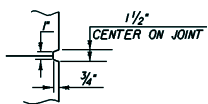

SCORE MARK DETAIL

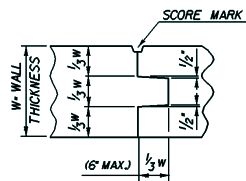

TYPICAL CONCRETE CONSTRUCTION JOINT

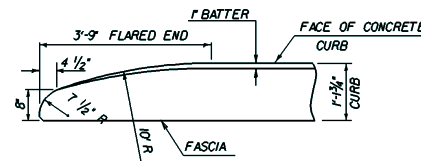

FLARED END DETAIL FOR 1'-1 3/4" CURB


NOTES

1. SHEET MEMBRANE WATERPROOFING SHALL EXTEND TO FACE OF CURB AS DETAILED.
2. CONSTRUCTION JOINTS THROUGH CONCRETE CURBS SHALL BE SPACED MAXIMUM 15'-0" CENTER TO CENTER AND SHALL BE 1'-6" MINIMUM FROM THE CENTER OF THE NEAREST BRIDGE RAIL POST. CONCRETE SHALL BE PLACED IN ALTERNATING SECTIONS WITH A MINIMUM OF 48 HOURS DELAY BETWEEN ADJACENT POURS.
3. LONGITUDINAL REINFORCING SHALL PASS THROUGH CONCRETE CURB CONSTRUCTION JOINTS.
4. CURB REINFORCING STIRRUP BARS SHALL BE TURNED AS REQUIRED TO FIT TAPERED ENDS.


**ARCHIVED
IN DPR**

**STATE OF VERMONT
AGENCY OF TRANSPORTATION**


Town Of	Sunderland	Bridge No.	20
Highway No.	TH 1	Log Sta.	
		Surv. Sta.	500
TH 1 OVER THE MILL BROOK CURB AND RAIL DETAILS			
Designed By	OW MEUNIER	Drawn By	J.P. Sizer/ C.C. Rice
Checked By	Date	Bridge Design Supervisor	
OW MEUNIER	12-96	GS Rogers	Date 1-97
PROJECT	Sunderland	PROJECT NO.	TH2 9003
LG.C. Info.	1urb/bv1/891090/410900.dwg	Sheet #	of 17
Revision Sheet No.		Sheet #	of 17

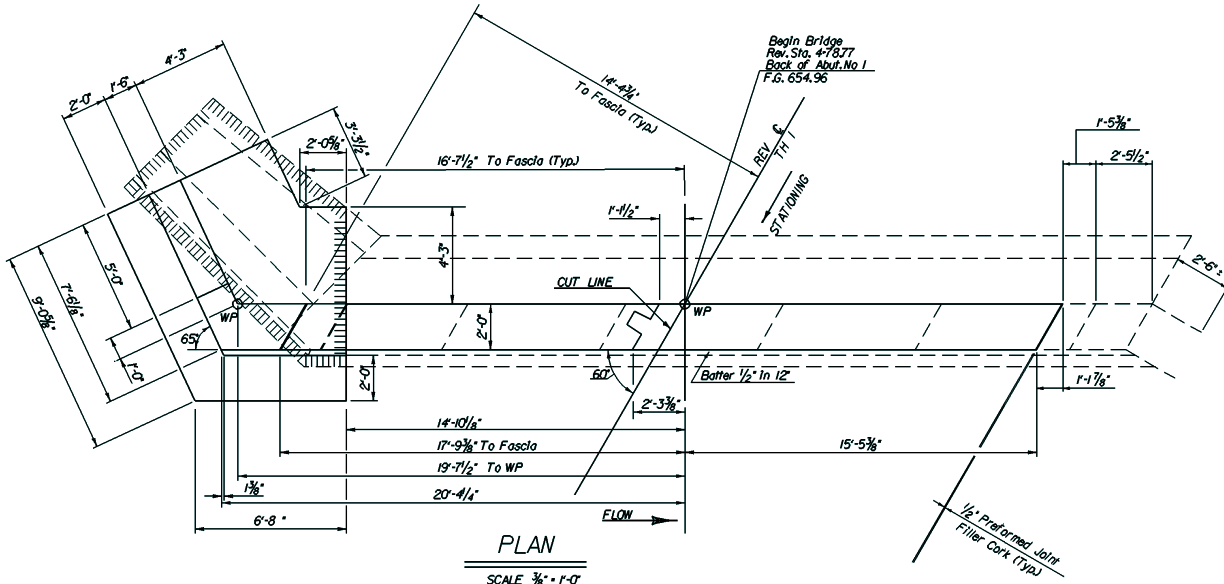


PLAN
SCALE 3/8" = 1'-0"

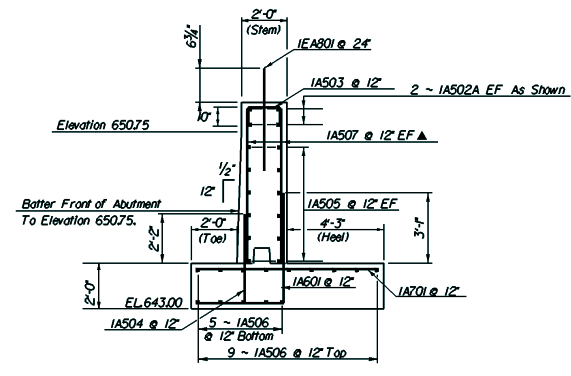

Section B-B
SCALE 3/8" = 1'-0"

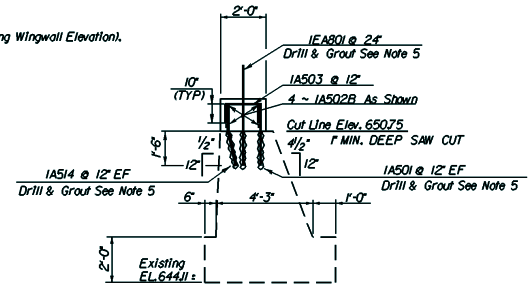

Section A-A
SCALE 3/8" = 1'-0"

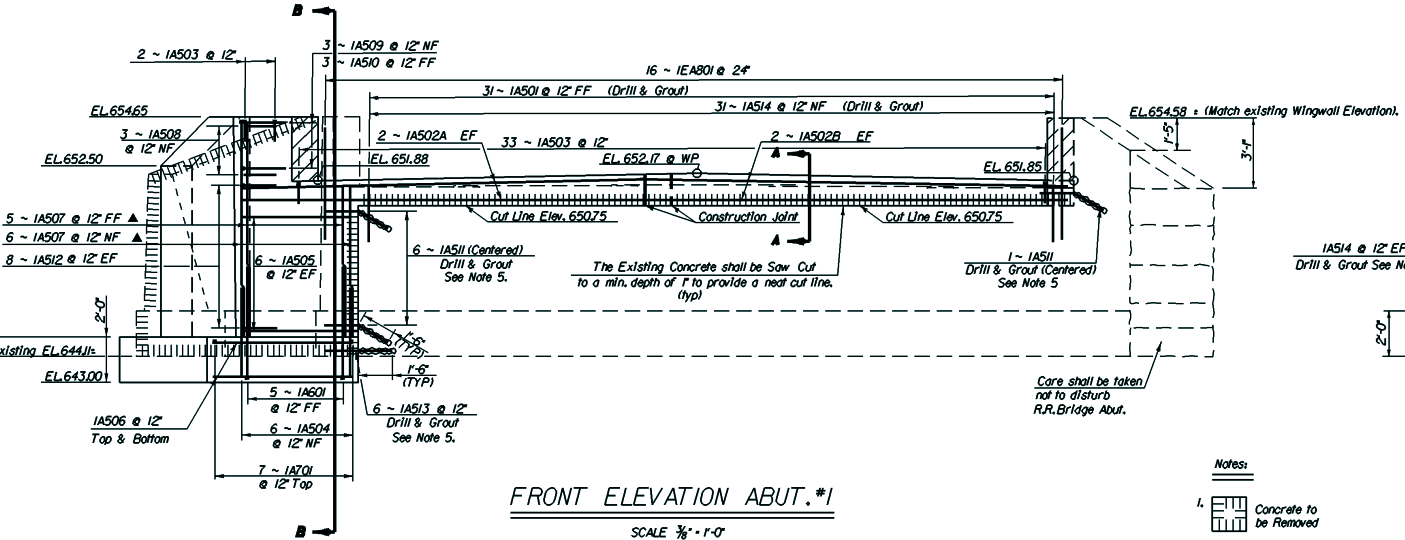

FRONT ELEVATION ABUT. #1
SCALE 3/8" = 1'-0"





Notes:

1. Concrete to be Removed
2. 3' Clear Unless Otherwise Noted
3. NF - Near Face
FF - Far Face
EF - Each Face
4. ▲ - Cut to Fit in the Field
5. Drill and Grout Dowels a Minimum of 1'-6" into Existing Concrete.

ARCHIVED
IN DPR

**STATE OF VERMONT
AGENCY OF TRANSPORTATION**

Town of	Sunderland	Bridge No.	2
Highway No.	TH 1	Log. Sta.	
TH #1 over the Mill Brook			
Abutment #1 Details			
Designed By	JP Spilat	Drawn By	JP Spilat
Checked By	CS Meunier	Bridge Design Supervisor	CS Meunier
PROJECT	Sunderland	PROJECT NO.	TH2 9003
L.G.C. Info. / str/89/020/sj090au.dgn		s/j090au	
Bridge Sheet No.		Sheet	16 of 37

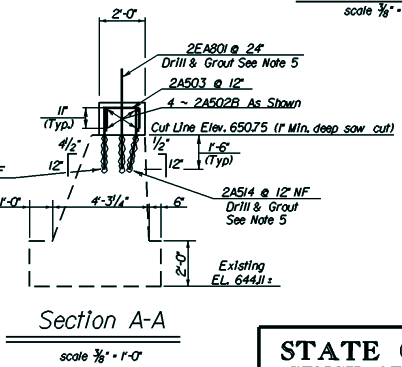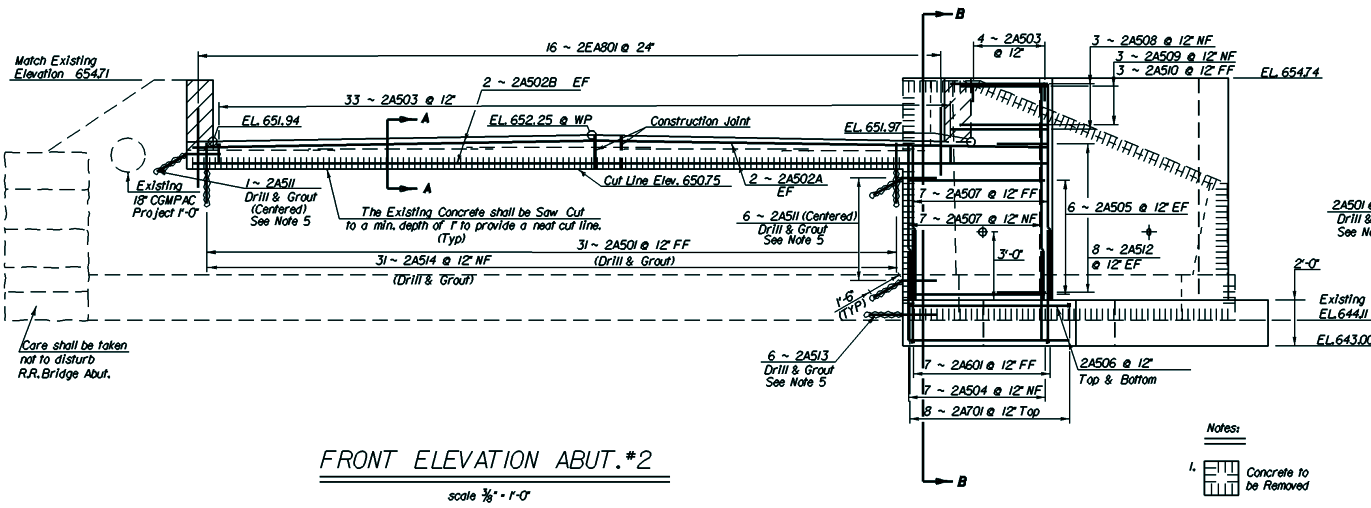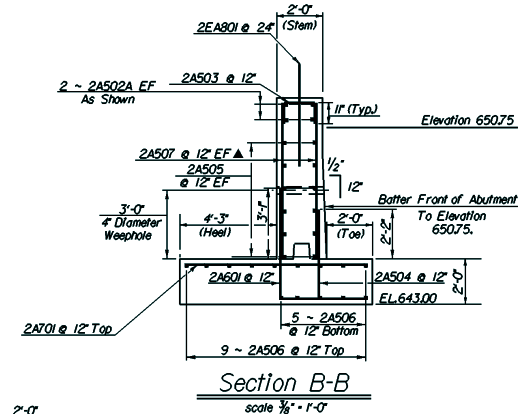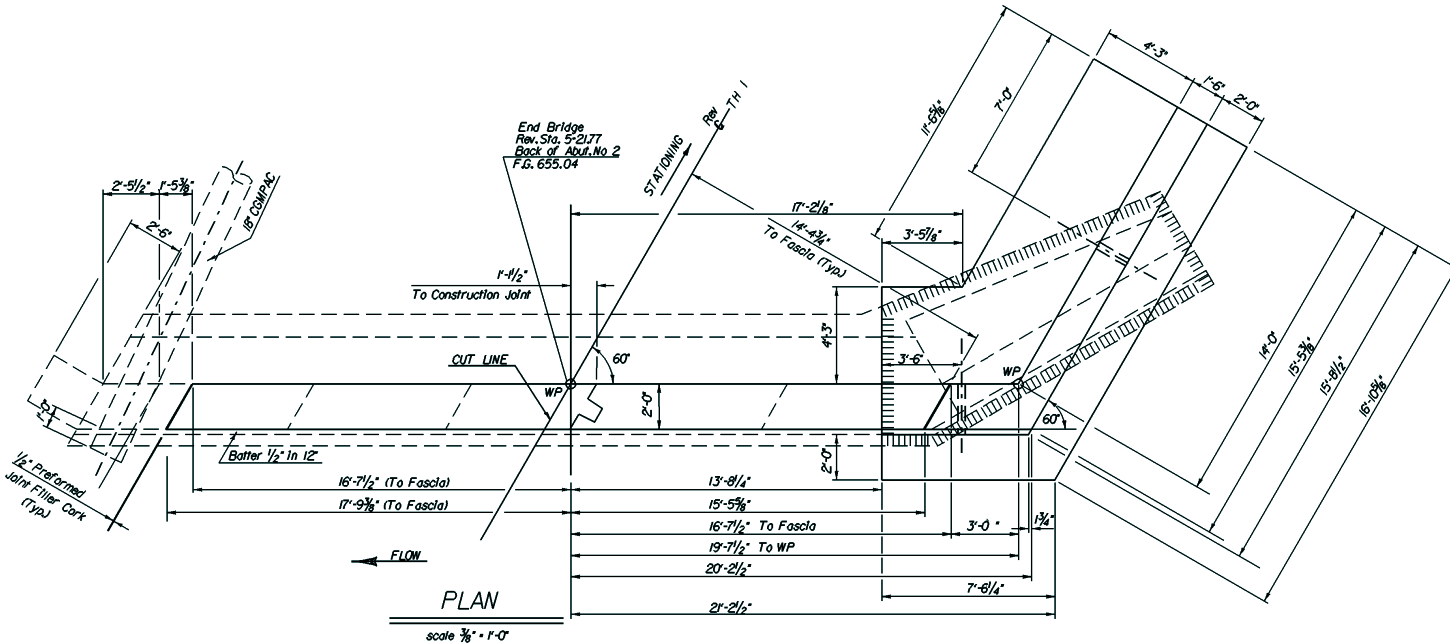


- Notes:
- Concrete to be Removed
 - 3" Clear Unless Otherwise Noted
 - NF - Near Face
FF - Far Face
EF - Each Face
 - ▲ - Cut to Fit In the Field

Section A-A
scale 3/8" = 1'-0"

FRONT ELEVATION ABUT.#2
scale 3/8" = 1'-0"


ARCHIVED
IN DPR

STATE OF VERMONT AGENCY OF TRANSPORTATION			
Town of Sunderland	Bridge No. 2		
Highway No. TH 1	Log. Sta. TH 1		
TH 1 over the Mill Brook Abutment #2 Details			
Designed By JP Salati	Drawn By JP Salati		
Checked By C.W. Mearns	Date 1/97	Bridge Design Supervisor	Date 1/97
PROJECT Sunderland		PROJECT NO. TH2 9003	
L.G.C. Info. / gvr/891090/sj090a02.dgn s/j090a02			
Bridge Sheet No.		Sheet 17 of 37	

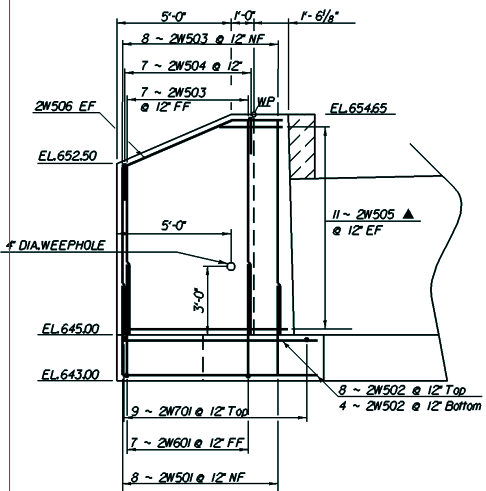


WINGWALL * 2 ELEVATION

SCALE 3/8" = 1'-0"

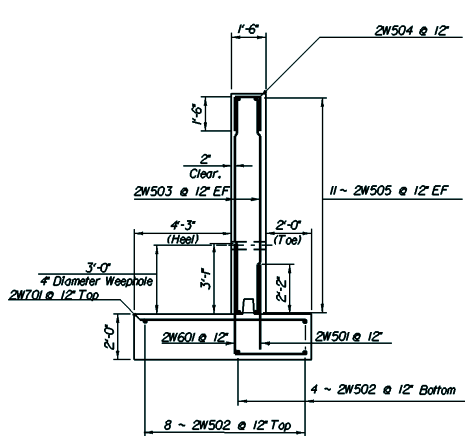


WINGWALL * 2 TYPICAL SECTION

SCALE 3/8" = 1'-0"

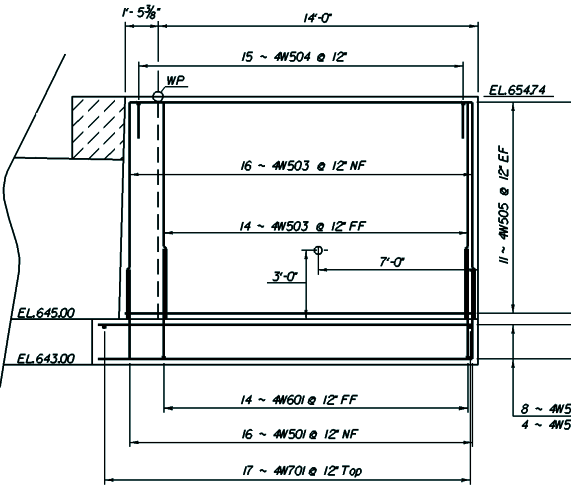


WINGWALL * 4 ELEVATION

SCALE 3/8" = 1'-0"

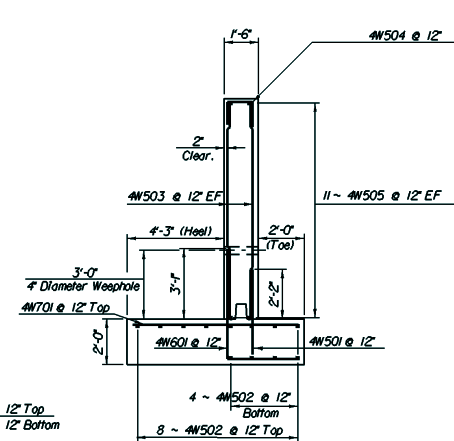


WINGWALL * 4 TYPICAL SECTION

SCALE 3/8" = 1'-0"

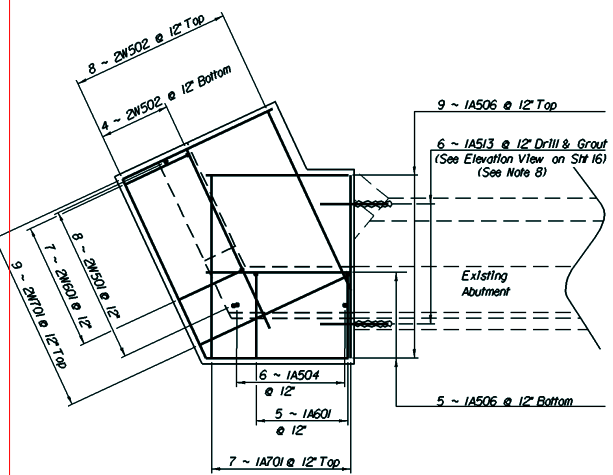

FOOTING REINFORCEMENT ABUT.*1.

SCALE 3/8" = 1'-0"

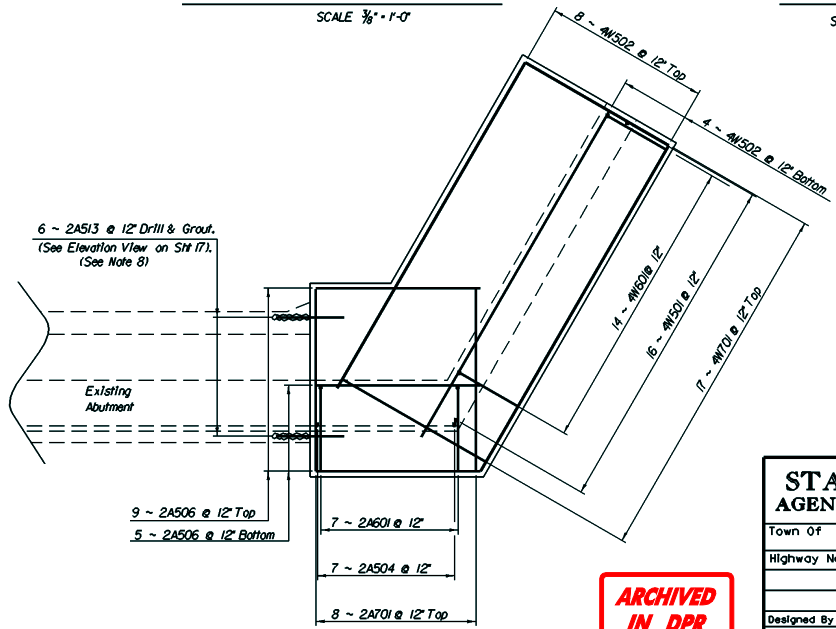

FOOTING REINFORCEMENT ABUT.*2.

SCALE 3/8" = 1'-0"

NOTE:


1. NF - Near Face
2. FF - Far Face
3. EF - Each Face
4. ▲ - Cut To Fit In The Field.
5. 3" Clear Unless Otherwise Specified.
6. See Sheet 19 For Corner Details.
7. See Sheet 2 For Weephole Details.
8. Drill & Grout Dapels a Minimum of 1'-6" Into Existing Concrete

**ARCHIVED
IN DPR**

PLOTTED 26-JUN-1997


STATE OF VERMONT AGENCY OF TRANSPORTATION	
Town Of Sunderland	Bridge No. 2
Highway No. TH 1	Log Sta. TH 1
Surv. Sta. TH 1	
TH 1 Over the Mill Brook	
Wingwall Details	
Designed By JP Soltz	Drawn By JP Soltz
Checked By Date	Bridge Design Supervisor Date
Of Number 10/96	GS Pages Date 1/97
PROJECT Sunderland	PROJECT NO. TH2 9003
L.G.C. Info. / 2/11/89 1000/3/1990wv.dgn 3/1990wv	
Bridge Sheet No.	Sheet 18 of 37

Sheet Number: 18

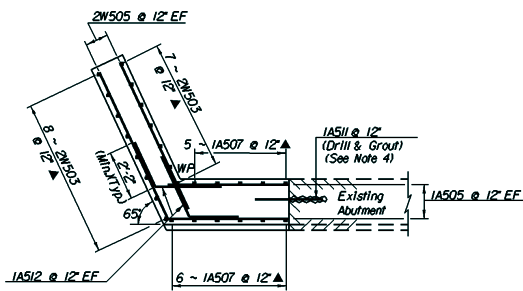


Corner Detail Abutment Number 1

Below Bridge Seat Elevation.
Scale: $\frac{3}{8}$ " = 1'-0"

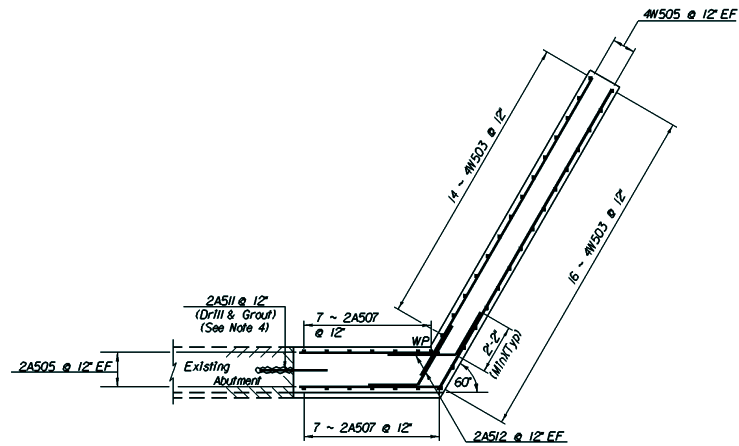


Corner Detail Abutment Number 2

Below Bridge Seat Elevation.
Scale: $\frac{3}{8}$ " = 1'-0"

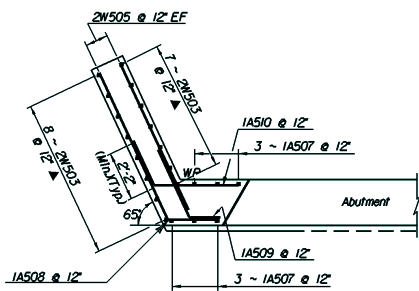

Corner Detail Abutment Number 1

Above Bridge Seat Elevation.
Scale: $\frac{3}{8}$ " = 1'-0"

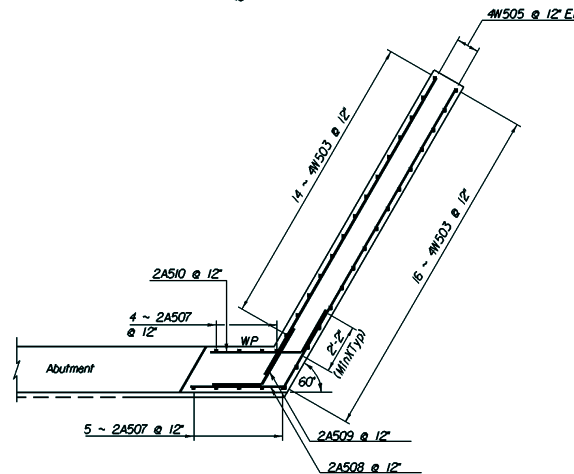

Corner Detail Abutment Number 2


Above Bridge Seat Elevation.
Scale: $\frac{3}{8}$ " = 1'-0"

1. NF = Near Face
FF = Far Face
EF = Each Face
2. ▲ = Cut to Fit in the Field
3. 3" Clear Unless Otherwise Noted
4. Drill and Grout Dowsels a Minimum of 1'-6" into Existing Concrete.

**ARCHIVED
IN DPR**

**STATE OF VERMONT
AGENCY OF TRANSPORTATION**

Town Of	Sunderland	Bridge No.	2
Highway No.	TH 1	Log Sta.	
	TH "I over the Mill Brook	Surv. Sta.	
Corner Details			
Designed By	<i>OW Mauler</i>	Drawn By	<i>JP Salati</i>
Checked By		Bridge Design Supervisor	
OW Mauler	Date	GS Rogers	Date
	10/96		12/96
PROJECT	Sunderland	PROJECT NO.	TH2 9003
I.G.C. Info. / s11/09/090/s1000r.dgn			
Bridge Sheet No.		Sheet	19 of 37

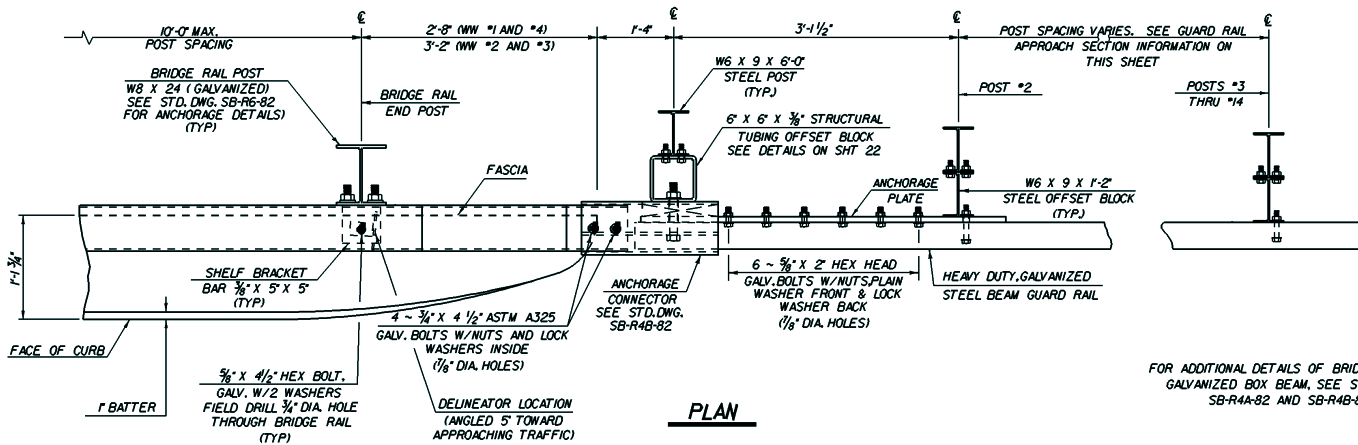

PLAN

**GUARD RAIL
APPROACH SECTION
TYPE I**

POST NO.	SPACING
1	3'-1/2"
2	3'-1/2"
3	3'-1/2"
4	3'-1/2"
5	3'-1/2"
6	3'-1/2"
7	3'-1/2"
8	3'-1/2"
9	4'-2"
10	4'-2"
11	4'-2"
12	4'-2"
13	6'-3"
14	6'-3"


50'-0" PAY LENGTH GUARD RAIL APPROACH SECTION, TYPE I

**GUARD RAIL
APPROACH SECTION
TYPE I (MOD)**

POST NO.	SPACING
1	3'-1/2"
2	3'-1/2"
3	3'-1/2"
4	3'-1/2"
5	3'-1/2"
6	3'-1/2"
7	3'-1/2"
8	3'-1/2"
9	3'-1/2"

25'-0" PAY LENGTH GUARD RAIL APPROACH SECTION, TYPE I (MOD)

FOR ADDITIONAL DETAILS OF BRIDGE RAILING, GALVANIZED BOX BEAM, SEE STD.DWG. SB-R4A-82 AND SB-R4B-82

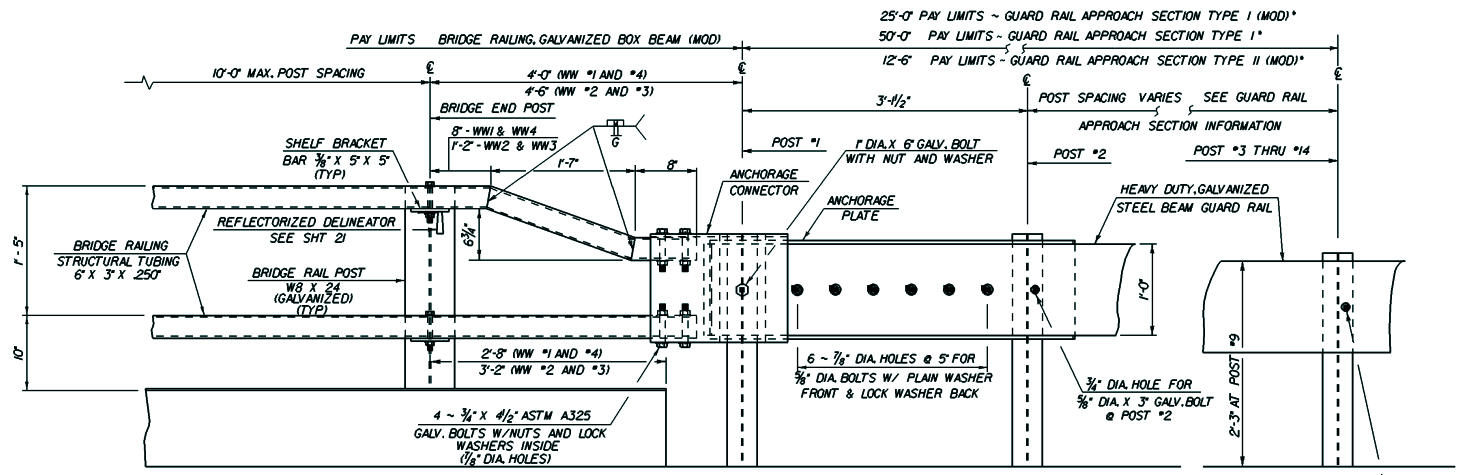

ELEVATION

**GUARD RAIL
APPROACH SECTION
TYPE II (MOD)**

POST NO.	SPACING
1	3'-1/2"
2	3'-1/2"
3	3'-1/2"
4	3'-1/2"
5	3'-1/2"

12'-6" PAY LENGTH GUARD RAIL APPROACH SECTION TYPE II (MOD)

FOR ADDITIONAL INFORMATION ON THE CONNECTION/TRANSITION DETAILS AT POST NO. 1, SEE SHT 21.
• FOR LOCATIONS SEE SHEET 12.

**ARCHIVED
IN DPR**

**STATE OF VERMONT
AGENCY OF TRANSPORTATION**


Town Of	SUNDERLAND	Bridge No.	2
Highway No.	TH 1	Log Sta.	
		Surv. Sta.	500
TH 1 OVER THE MILL BROOK			
GALVANIZED BOX BEAM BRIDGE RAIL DETAILS			
Designed By	C.W. MEUMER	Drawn By	G.C. RICE
Checked By	C.W. MEUMER	Date	11/96
		Bridge Design Supervisor	G.S. ROGERS
		Date	11/96
PROJECT	SUNDERLAND	PROJECT NO.	TH2-9003
I.G.C. Info. /str/89/090/a/0901.dwg		1/0909.dwg	
Bridge Sheet No.		Sheet	20 of 37

BOX BEAM BRIDGE RAIL NOTES

- BRIDGE RAILING AND GUARD RAIL APPROACH SECTIONS ARE DESIGNED IN ACCORDANCE WITH THE LATEST AASHTO SPECIFICATIONS.
- ALL PLATES, BARS, AND ANGLES SHALL BE ASTM A36 STEEL. UNLESS OTHERWISE SPECIFIED, ALL BOLTS SHALL BE ASTM A307. STRUCTURAL STEEL TUBING SHALL BE ASTM A500 COLD-FORMED GRADE B AS MODIFIED IN SECTION 732.03(a).
- ALL BOX BEAM BRIDGE RAILING, AND COMPONENTS SHALL CONFORM TO SECTION 525 OF THE STANDARD SPECIFICATIONS. ALL OTHER SLEEVES, ANCHOR BOLTS, AND ATTACHMENT HARDWARE SHALL BE A325 STEEL AND GALVANIZED TO ASTM A153 AFTER FABRICATION.
- THE FABRICATOR SHALL SUBMIT SHOP DRAWINGS, INCLUDING WELDING PROCEDURES TO THE STRUCTURES DIVISION, FOR APPROVAL IN ACCORDANCE WITH THE PROVISIONS OF SECTION 506.04 - SHOP DRAWINGS. ALL WELDING SHALL CONFORM WITH SECTION 506.J0.
- THE RAIL SYSTEM SHALL BE CONTINUOUS WITH EACH TUBE SECTION ATTACHED TO A MINIMUM OF TWO POSTS. JOINTS SHALL BE SPLICED AS SHOWN, WITH CONNECTIONS LOCATED ONE DIRECTLY ABOVE THE OTHER.
- A BRIDGE RAILING JOINT SPLICE SHALL BE PROVIDED AT EACH SUPERSTRUCTURE EXPANSION JOINT. THE RAIL JOINT OPENING SHALL BE 1 INCH UNLESS OTHERWISE NOTED.
- THE BOX BEAM RAIL SHALL BE SHOP BENT TO MATCH RADI LESS THAN 950 FEET.
- DELINEATORS SHALL BE MOUNTED AS SHOWN ON SB-R44-82. PAYMENT FOR DELINEATORS SHALL BE SUBSIDIARY TO OTHER ITEMS.
- SEE STD. SB-R6-82 FOR POST ANCHORAGE DETAILS WHEN USING FASCIA MOUNTED BRIDGE RAIL POSTS.
- PROCEDURE QUALIFICATION FOR ALL WELDS SHALL BE PERFORMED AND APPROVED PRIOR TO FABRICATION. WELDER QUALIFICATION WILL BE REQUIRED FOR EACH PROCEDURE. PROCEDURE AND WELDER QUALIFICATION ACCEPTANCE SHALL BE APPROVED BY RADIOGRAPHIC TESTING.


APPROACH RAIL NOTES

- REFER TO STANDARD G-1 OR G-1d FOR ADDITIONAL APPROACH RAIL DETAILS.
- ALL POSTS FOR HEAVY DUTY STEEL BEAM GUARD RAIL SHALL BE STEEL, IN ACCORDANCE WITH SECTION 728 "GUARD RAIL, GUIDE POST AND BARRIERS" UNLESS OTHERWISE SPECIFIED IN THE CONTRACT.
- APPROACH RAIL SPLICES SHALL LAP IN DIRECTION OF TRAFFIC FLOW.
- ANCHORAGE CONNECTOR AND ANCHORAGE PLATE SHALL BE ASTM A36 STEEL GALVANIZED TO ASTM A123 AFTER FABRICATION.
- APPROACH RAILING SHALL BE HEAVY DUTY STEEL BEAM FOR EITHER TYPE OF GUARD RAIL APPROACH SECTION.
- ALLOWABLE DIMENSIONAL TOLERANCE FOR BENT SECTIONS IS +/- 1/16 OF AN INCH.
- THE UNIT PRICES BID FOR EITHER TYPE OF GUARD RAIL APPROACH SECTION, SHALL INCLUDE ANCHORAGE CONNECTOR, ANCHORAGE PLATE, HEAVY DUTY STEEL BEAM GUARD RAIL, POSTS, OFFSET BLOCKS, BLOCKING, BOLTS, AND ALL NECESSARY HARDWARE.

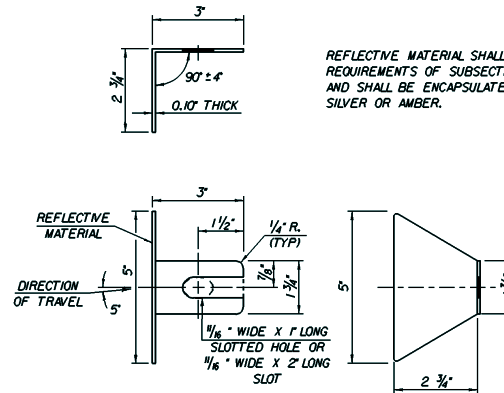

DELINEATOR DETAILS

THIS REFLECTORIZED ALUMINUM DELINEATOR IS TO BE ERECTED EVERY 30 FEET OR CLOSEST POST. DELINEATOR SHALL MEET SPECIFICATION REQUIREMENTS FOR ASTM B209 ALLOY 5052 - H32.

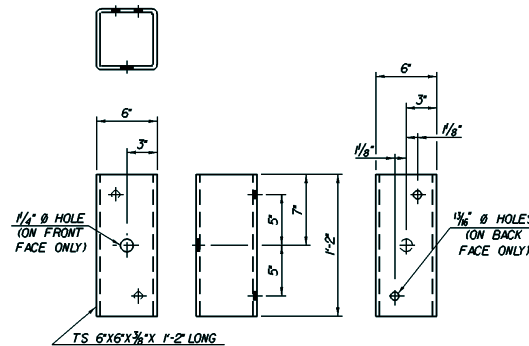


STRUCTURAL TUBING OFFSET BLOCK DETAILS
(OCCURS AT POST NO.1 WHEN USING APPROACH RAIL UTILIZING STEEL POSTS)

**ARCHIVED
IN DPR**



STATE OF VERMONT AGENCY OF TRANSPORTATION			
Town Of	SUNDERLAND	Bridge No.	2
Highway No.	TH 1	Log Sta.	
TH 1 OVER THE WILL BROOK		Surv. Sta.	500
BRIDGE RAIL CONNECTION/TRANSITION DETAILS			
Designed By	C.W. MEUMER	Drawn By	C.C. RICE
Checked By	C.W. MEUMER	Bridge Design Supervisor	
Date	11/96	Date	11/96
PROJECT	SUNDERLAND	PROJECT NO.	TH2-9003
U.G.C. Info.	/srt/189/050/s/050r1.dgn		3/050r1.dgn
Bridge Sheet No.		Sheet	2 of 37

PLOTTED 26-JUN-1997

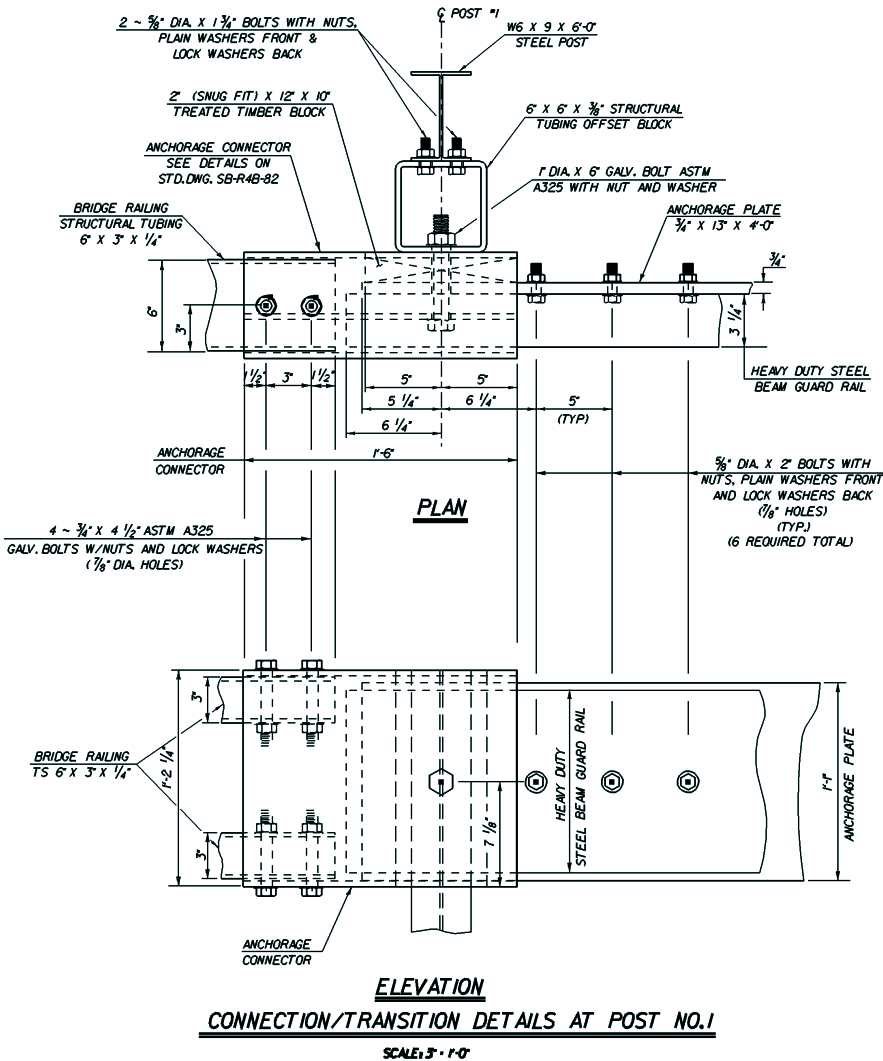

CONNECTION/TRANSITION DETAILS AT POST NO.1

SCALE: 3/4" = 1'-0"

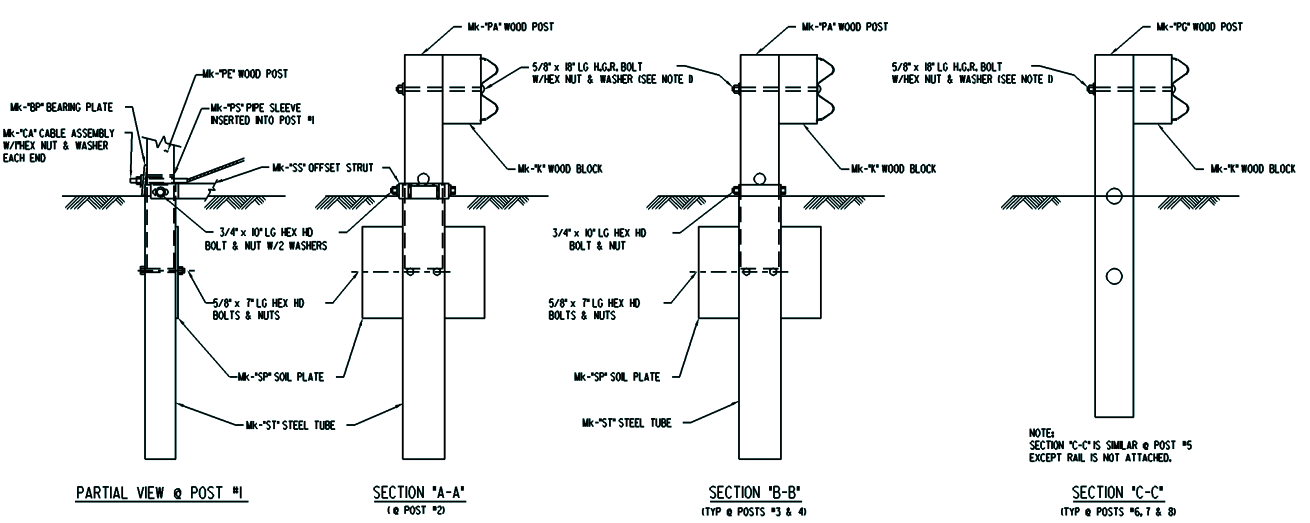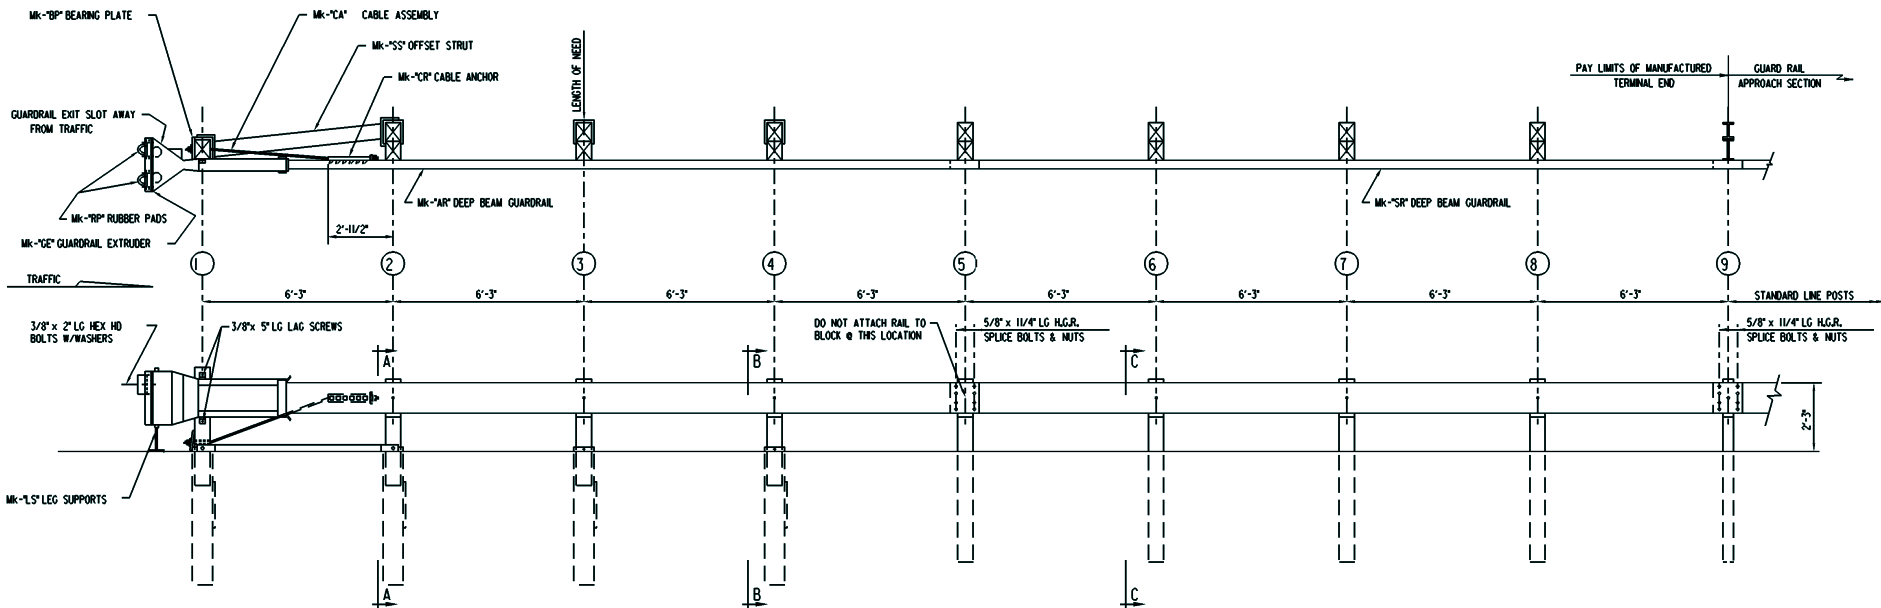

MATERIAL REQUIRED FOR EACH END SECTION (2 REQUIRED)

MK	QTY	DESCRIPTION
PE	1	WOOD POST
LS	2	LEG SUPPORT
RP	2	RUBBER PAD
SR	1	DEEP BEAM GUARD RAIL (2GA)
AR	1	DEEP BEAM GUARD RAIL (2GA)
PS	1	PIPE SLEEVE
SP	4	SOIL PLATE
K	7	WOOD BLOCK
PG	4	WOOD POST
PA	3	WOOD POST
ST	4	STEEL TUBE
BP	1	BEARING PLATE
CR	1	CABLE ANCHOR
CA	1	CABLE ASSEMBLY
SS	1	OFFSET STRUT (LEFT OR RIGHT)
GE	1	GUARDRAIL EXTRUDER
HARDWARE		
4	3/4" x 10" LG HD BOLT	
4	3/4" HEX NUT	
4	3/4" WASHER	
7	5/8" x 18" H.G.R. POST BOLT	
16	5/8" x 11/4" H.G.R. SPLICE BOLT	
8	5/8" x 1" HEX HD BOLT	
16	5/8" HEX NUT	
15	5/8" WASHER	
2	3/8" x 5" LAG SCREW	
4	3/8" x 2" HEX HD BOLT	
4	3/8" WASHER	
2	F HEX NUT	
2	F WASHER	

- NOTES:
 1) THE 5/8" FLAT WASHER IS USED UNDER THE NUT, BEHIND THE POST ONLY. NO WASHER IS USED AT THE RAIL.
 2) THE BREAKAWAY POSTS @ LOCATIONS #5, 6, 7 & 8 MAY BE AS SHOWN OR MAY UTILIZE POSTS AS SHOWN IN OPTION 'A' WITH FOUNDATION TUBES.
 3) THE ET-2000 WAS TESTED ON FLAT & LEVEL TERRAIN. IT IS NOT RECOMMENDED ON SLOPES.
 4) MANUFACTURER SUGGESTS CUSTOMER TO PROVIDE REFLECTORIZER OF TERMINAL.

ARCHIVED IN DPR

STATE OF VERMONT AGENCY OF TRANSPORTATION

Town Of **SUNDERLAND** Bridge No. **2**
 Highway No. **TH 1** Log Sta. **500**
 Surv. Sta. **500**

TH 1 OVER THE MILL BROOK

MANUFACTURED TERMINAL END DETAIL SHEET

Designed By **C.W. MEUNIER** Drawn By **C.C. RICE**
 Checked By **C.W. MEUNIER** Date **11/96** Bridge Design Supervisor **G.S. ROGERS** Date **11/96**


PROJECT **SUNDERLAND** PROJECT NO. **TH2-9003**
 LG.C. Info. / gsv/89/0901/sj0901.dgn s/j0901me/

Bridge Sheet No. **22** of **37**

NO.	PIECES	SIZE	LENGTH	MARK	TYPE	A	B	C	D	E	F	G	H	J	K	R	O	NO.	PIECES	SIZE	LENGTH	MARK	TYPE	A	B	C	D	E	F	G	H	J	K	R	O
SLAB																		ABUTMENT NO. 2																	
19	5	42-5		ES501	STR	▲												31	5	2-5	2A501	STR													
44	6	15-0		ES601A	STR													4	5	19-11	2A502A	STR													
44	6	17-7		ES601B	STR													4	5	17-6	2A502B	STR													
87	5	9-8		ES502	SG	1-0	1-6	4-8	1-6							1-0	7	5	3-11	2A504	STR														
86	5	7-9		ES503	SS	1-0	2-7	0-7	2-7							1-0	12	5	6-2	2A505	STR														
60	10	43-10		ES1001	I	1-5	42-5										15	5	7-0	2A506	STR														
ABUTMENT NO. 1																		WINGWALL NO. 4																	
31	5	2-4		1A501	STR													18	8	4-6	2EA801	STR													
4	5	17-9		1A502A	STR													37	5	3-4	2A503	17		0-11	1-6	0-11									
4	5	17-6		1A502B	STR													3	5	5-0	2A509	19		2-2	2-10										
6	5	3-11		1A504	STR													3	5	6-2	2A510	19		2-2	4-0										
13	5	5-3		1A505	STR													7	5	3-0	2A511	19		1-6	1-6										
14	5	6-2		1A506	STR													16	5	5-2	2A512	19		2-2	3-0										
11	5	9-3		1A507	STR													31	5	2-5	2A514	19		0-11	1-6										
3	5	2-1		1A508	STR	▲												8	6	8-7	2A601	17			3-9	4-10									
6	5	3-0		1A513	STR													8	7	8-0	1A701	STR													
8	7	8-0		1A701	STR													18	8	4-5	1EA801	STR													
18	8	4-5		1EA801	STR													WINGWALL NO. 2																	
35	5	3-2		1A503	17		0-10	1-6	0-10									8	5	3-11	2W501	STR													
3	5	4-0		1A509	19		1-4	2-8										12	5	8-6	2W502	STR													
3	5	5-11		1A510	19		2-2	3-9										15	5	9-5	2W503	STR													
7	5	3-0		1A511	19		1-6	1-6										23	5	7-0	2W505	STR	▲												
16	5	5-1		1A512	19		2-2	2-11										10	7	7-3	2W701	STR													
31	5	2-4		1A514	19		0-10	1-6										7	5	4-1	2W504	17		1-6	1-1	1-6									
6	6	8-7		1A601	17			3-9	4-10									2	5	7-6	2W506	19		2-3	5-2										
WINGWALL NO. 1																		WINGWALL NO. 3																	
8	5	3-11		2W501	STR													15	5	9-5	2W503	STR													
12	5	8-6		2W502	STR													23	5	7-0	2W505	STR	▲												
15	5	9-5		2W503	STR													10	7	7-3	2W701	STR													
23	5	7-0		2W505	STR	▲												7	5	4-1	2W504	17		1-6	1-1	1-6									
10	7	7-3		2W701	STR													2	5	7-6	2W506	19		2-3	5-2										
7	5	4-1		2W504	17		1-6	1-1	1-6								8	6	7-11	2W601	17		4-10	3-1											
2	5	7-6		2W506	19		2-3	5-2									WINGWALL NO. 4																		
8	6	7-11		2W601	17		4-10	3-1									15	5	4-1	4W504	17		1-6	1-1	1-6										
WINGWALL NO. 5																		WINGWALL NO. 6																	
WINGWALL NO. 7																		WINGWALL NO. 8																	
WINGWALL NO. 9																		WINGWALL NO. 10																	
WINGWALL NO. 99																		WINGWALL NO. 100																	

~ NOTES ~


- UNLESS OTHERWISE DESIGNATED, ALL BAR REINFORCEMENT FOR CONCRETE IN SIZES UP TO AND INCLUDING NO. 18 SHALL CONFORM TO THE REQUIREMENTS OF THE "SPECIFICATIONS FOR DEFORMED BILLET-STEEL BARS FOR CONCRETE REINFORCEMENT", AASHTO M 31 (ASTM A 615-S1). ALL BARS SHALL BE GRADE 60, UNLESS OTHERWISE DESIGNATED.
- FOR TYPICAL BENDING DETAILS, RECOMMENDED PIN DIAMETER "D" OF BENDS AND HOOKS, AND OTHER STANDARD PRACTICE, SEE CURRENT CONCRETE REINFORCING STEEL INSTITUTE "MANUAL OF STANDARD PRACTICE".
- BARS WHICH REQUIRE MORE ACCURATE BENDING THAN STANDARD PRACTICES SHOULD HAVE LIMITS INDICATED.
- ALL DIMENSIONS ARE OUT TO OUT OF BAR EXCEPT "A" AND "G" ON STANDARD 180 DEGREE AND 135 DEGREE HOOKS.
- "J" DIMENSION ON 180 DEGREE HOOKS TO BE SHOWN ONLY WHERE NECESSARY TO RESTRICT HOOK SIZE. OTHERWISE, STANDARD HOOKS ARE TO BE USED.
- "H" DIMENSION ON STIRRUPS TO BE SHOWN ONLY WHEN NECESSARY TO MAINTAIN CLEARANCES.
- WHERE SLOPE DIFFERS FROM 45 DEGREES, DIMENSIONS "H" AND "K" MUST BE SHOWN.
- ▲ DENOTES BARS TO BE CUT IN FIELD.
- * DENOTES ONE EXTRA BAR ADDED FOR TESTING PURPOSES.
- △ DENOTES TWO EXTRA BARS ADDED FOR TESTING PURPOSES.
- "E" IN PREFIX DENOTES EPOXY COATED REINFORCING STEEL.

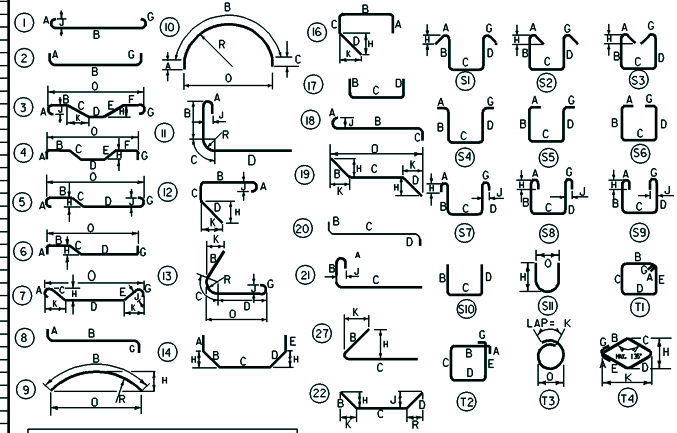

ASTM STANDARD REINFORCING BARS			
BAR SIZE DESIGNATION	WEIGHT POUNDS PER FOOT	NOMINAL DIMENSIONS ROUND SECTION	
		DIAMETER INCHES	CROSS SECTIONAL AREA SQ. INCHES
#3	.376	.375	.11
#4	.668	.500	.20
#5	1.043	.625	.31
#6	1.502	.750	.44
#7	2.044	.875	.60
#8	2.670	1.000	.79
#9	3.400	1.128	1.00
#10	4.303	1.270	1.27
#11	5.313	1.410	1.56
#14	7.65	1.693	2.25
#18	13.60	2.257	4.00


ARCHIVED IN DPR
PLOTTED 26-JUN-1997

STATE OF VERMONT	
AGENCY OF TRANSPORTATION	
Town Of SUNDERLAND	Bridge No. 2
Highway No. TH 1	Log Sta. 500
TH OVER THE MILL BROOK	
REINFORCING STEEL SCHEDULE	
Designed by C.W. MEUNIER	Drawn by C.C. RICE
Checked by R.T. LANSDALE	Bridge Design Supervisor G.S. ADGERS
Date 2/97	Date 2/97
PROJECT SUNDERLAND	PROJECT NO. TH2-9003
<small>L.C.L. Info. / rev/29/00/s/000rd.dwg</small>	
Bridge Sheet No.	Sheet 23 of 37

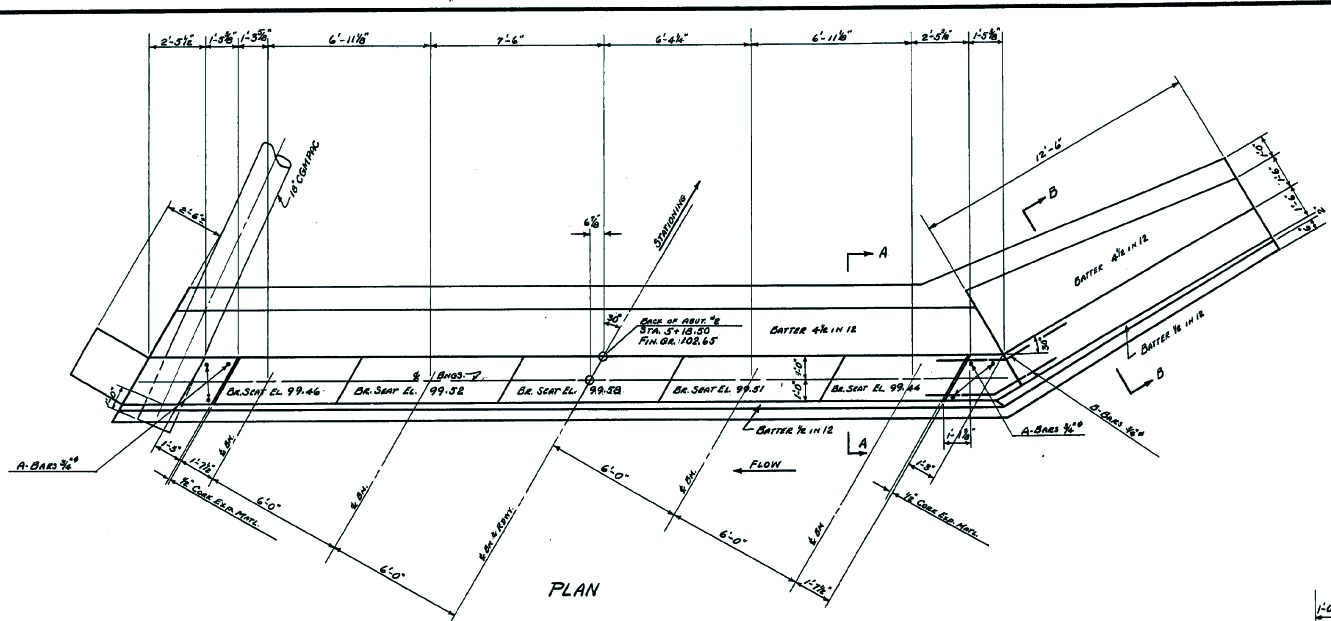


PLAN


REINFORCING STEEL				
BAR	SIZE	NO. REIN.	TOT. LENTH	DETAIL
A	3/4"	6	5'-0"	STRAIGHT
B	3/4"	8	6'-0"	

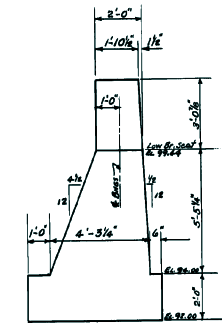

SECTION A-A

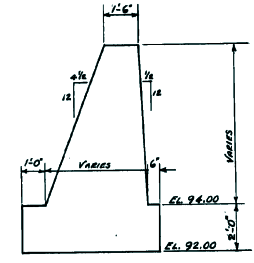

SECTION B-B

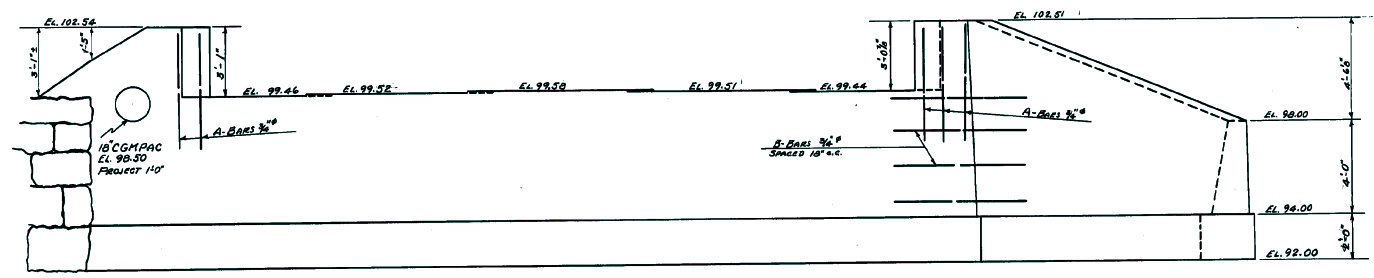

FRONT ELEVATION ABUT #2


THIS SHEET FOR INFORMATION PURPOSES ONLY

SUNDERLAND MILL BROOK
DETAILS OF ABUT #2
SCALE 3/8" = 1'-0"

ESTIMATED QUANTITIES


ARCHIVED IN DPR	STRUCTURE EXCAVATION	75' C.Y.	Surveyed by J.L.H. Designed by J.L.H. Drawn by J.M.P. Checked by L.M.R. Series S.A. No. 18-1946 Filed Sheet 24 of 37 Sheets
	CONCRETE CLASS "D"	54' C.Y.	
	REINFORCING STEEL	117' LB.	

CARE SHALL BE TAKEN NOT TO DISTURB R.C. BARRAGE & ABUTMENT

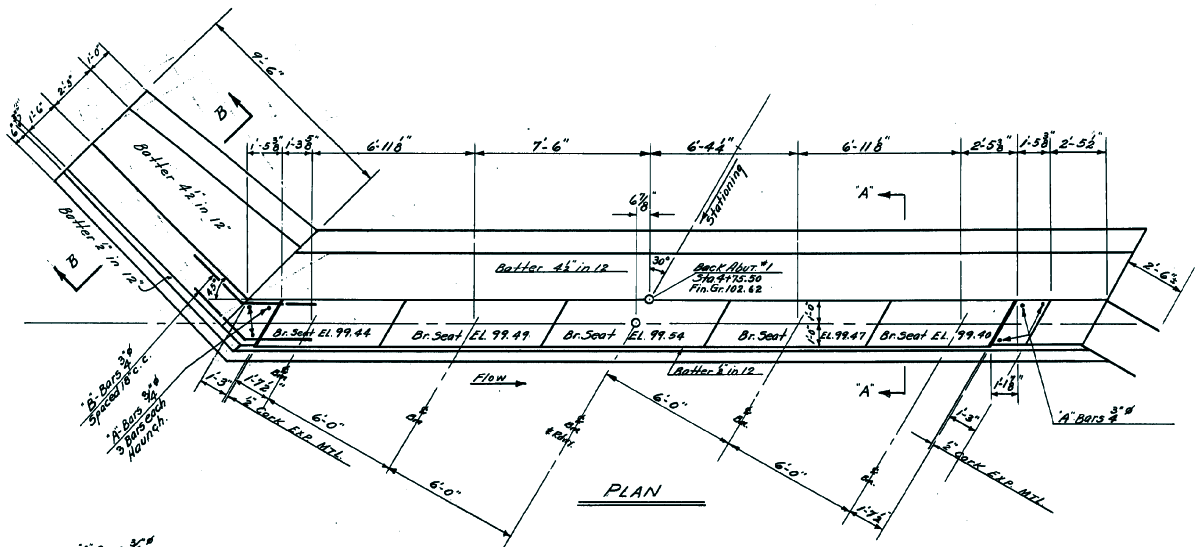


REINFORCING STEEL


BAR SIZE	No. REQ.	LENG.	DETAIL	
A	3/8"	6	5'-0"	Straight
B	3/4"	8	6'-0"	Straight

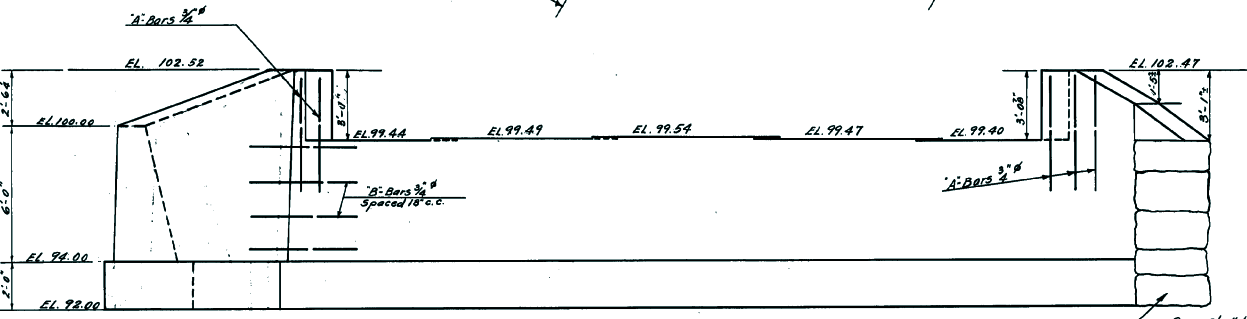

FRONT ELEVATION ABUT #1

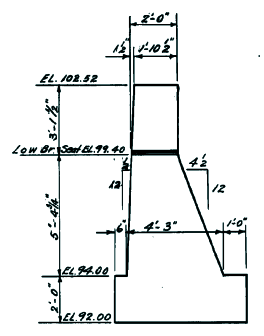

SECTION 'A-A'

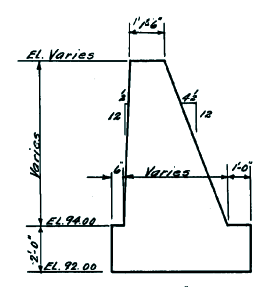

SECTION 'B-B'

THIS SHEET FOR
INFORMATION PURPOSES
ONLY






SUNDERLAND
MILL BROOK
DETAIL OF ABUT #1
SCALE 3/8" = 1'-0"

ESTIMATED QUANTITIES

Structure Excavation	30 C.Y.	Surveyed by	J.L.H.
Concrete Class "B"	52 C.Y.	Designed by	J.L.H.
Reinforcing Steel	117 Lbs.	Drawn by	J.L.H.
		Traced by	H.R.C.
		Checked by	L.M.R.
		Series	S-99, No. 18-46
		Filed	7/1/47
		Sheet	25 of 31
		Sheets	

ARCHIVED
IN DPR

4-18-47
7/1/47

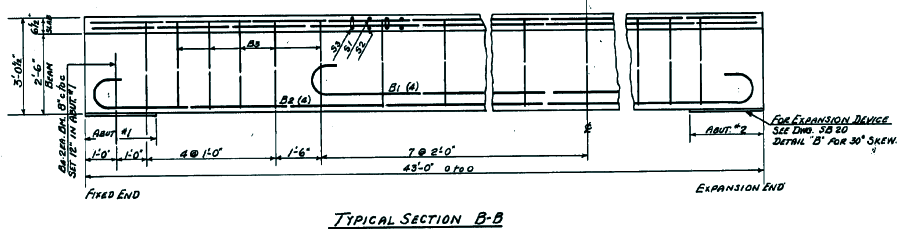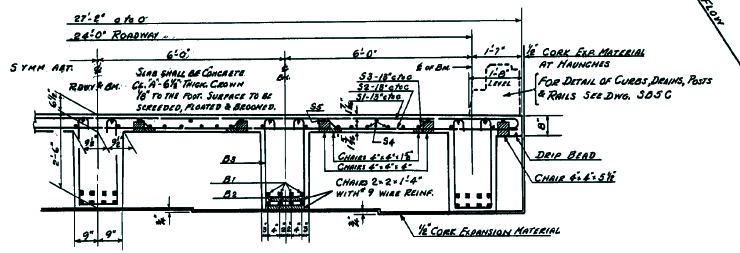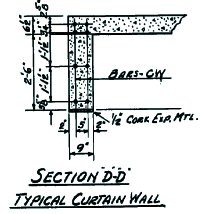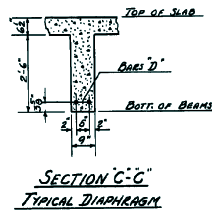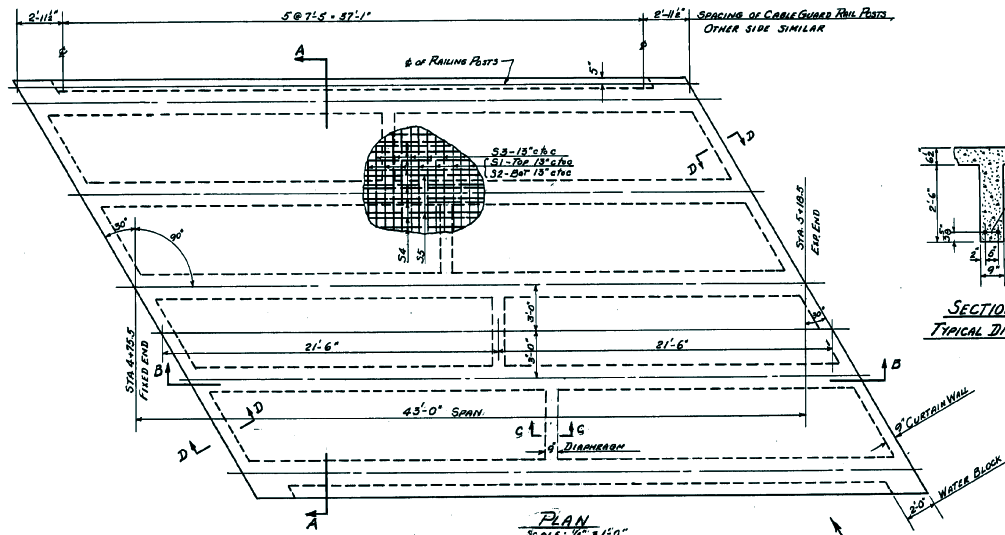

REINFORCING STEEL SCHEDULE			
BAR	NO.	SIZE	DETAIL
B1	20	1 1/2"	32'-6"
B2	20	1 1/2"	43'-0"
B3	125	1/2"	6'-1"
B4	10	1 1/2"	3'-0"
S1	40	3/8"	25'-5"
S2	40	3/8"	26'-8"
S3	40	3/8"	29'-5"
S4	96	3/8"	22'-5"
S5	20	3/8"	22'-8"
CW	32	3/8"	16'-10"
D	8	3/8"	8'-8"

NOTES

All Bar Dimensions are to E of Bars.
 All Reinforcing Steel to be intermediate grade, deformed bars.
 All Covers to be Class 'A'.
 Quantities for Curbs and Guard Rail Posts are included in the Estimated Quantities on this Drawing.
 Bridge Designed in accordance with AASHTO Specifications 1944 and Standard Road & Bridge Specifications, State of Vermont, Dept. of Highways 1934, for H15(44) Live Load & 25' /sk Paving Allowance.

THIS SHEET FOR INFORMATION PURPOSES ONLY

SUNDERLAND
 SUPERSTRUCTURE DETAILS
 BRIDGE OVER MILL BROOK

ESTIMATED QUANTITIES

ARCHIVED IN DPR	CONCRETE CLASS 'A'	65 CY.
	REINFORCING STEEL	18,126 LBS.

Surveyed by	MES	5/1947
Designed by	MES	5/1947
Drawn by	DWR	6/1947
Checked by	LMB	7/1947
Series	SA	No. 18-1946
Sheet	20	of 21




650

2+00



650

1+50

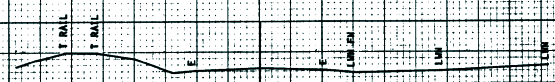

650

1+00



650

0+50




650

0+00


**ARCHIVED
IN DPR**

PROJ STA.	0+00	TO STA.	0+00
PROJECT NAME	SUNDERLAND MAIN		
NO.	TM2-0003	DATE	04/23/91
SURVEYED BY	BOSS	DATE	04/21/91
SHEET	04	OF	27 SHEETS


SCALE 1" = 10 FEET

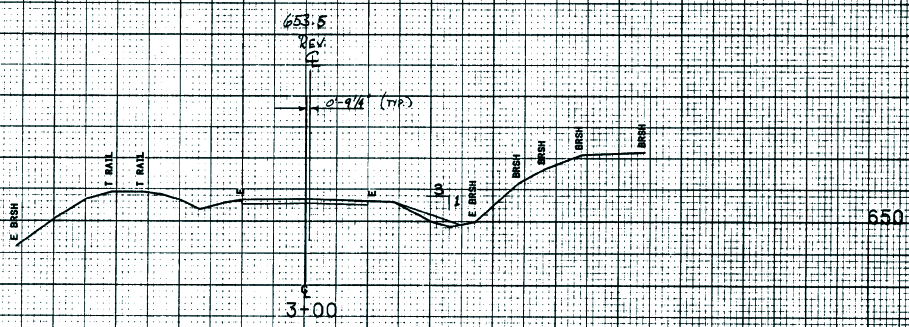


REV. STA 2+75 ~ BEGIN APPROACH

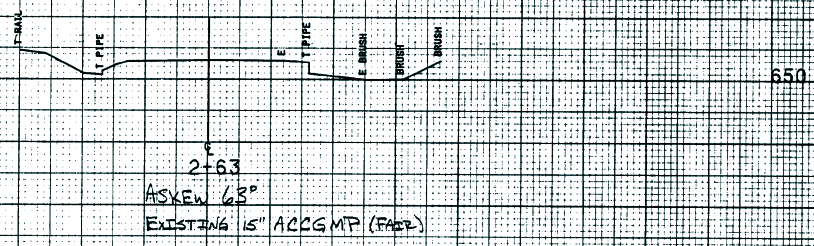

2+63
ASKEN 63°
EXISTING IS ACCG MP (FARR)

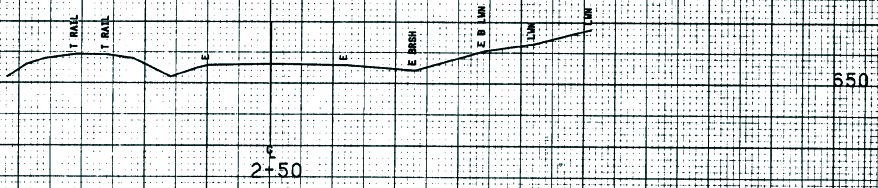

2+50

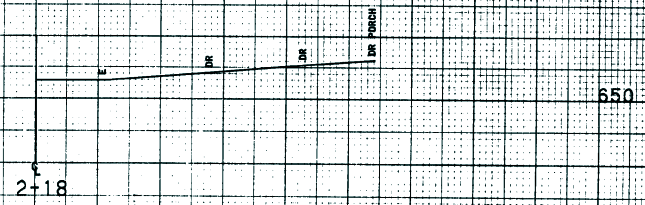


2+18

**ARCHIVED
IN DPR**


FROM STA.	2+18	TO STA.	3+00
PROJECT NAME	SUNDERLAND MAIN		
IND.	782-8003	PLOTTED	04/25/91
SURVEYED BY	ROSS	DATE	04/21/85
SHEET	26	OF	37

SCALE: 1" = 10 FEET

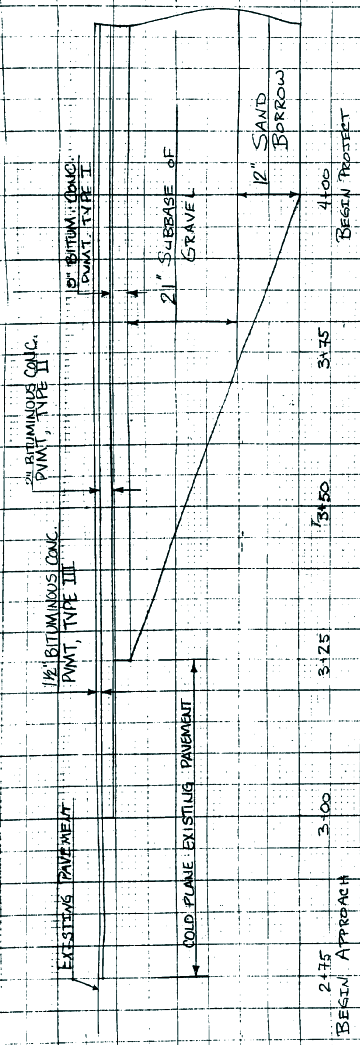


SUBBASE TRANSITION

HORIZ SCALE = 1" = 10'
VERT SCALE = 1" = 1'-0"

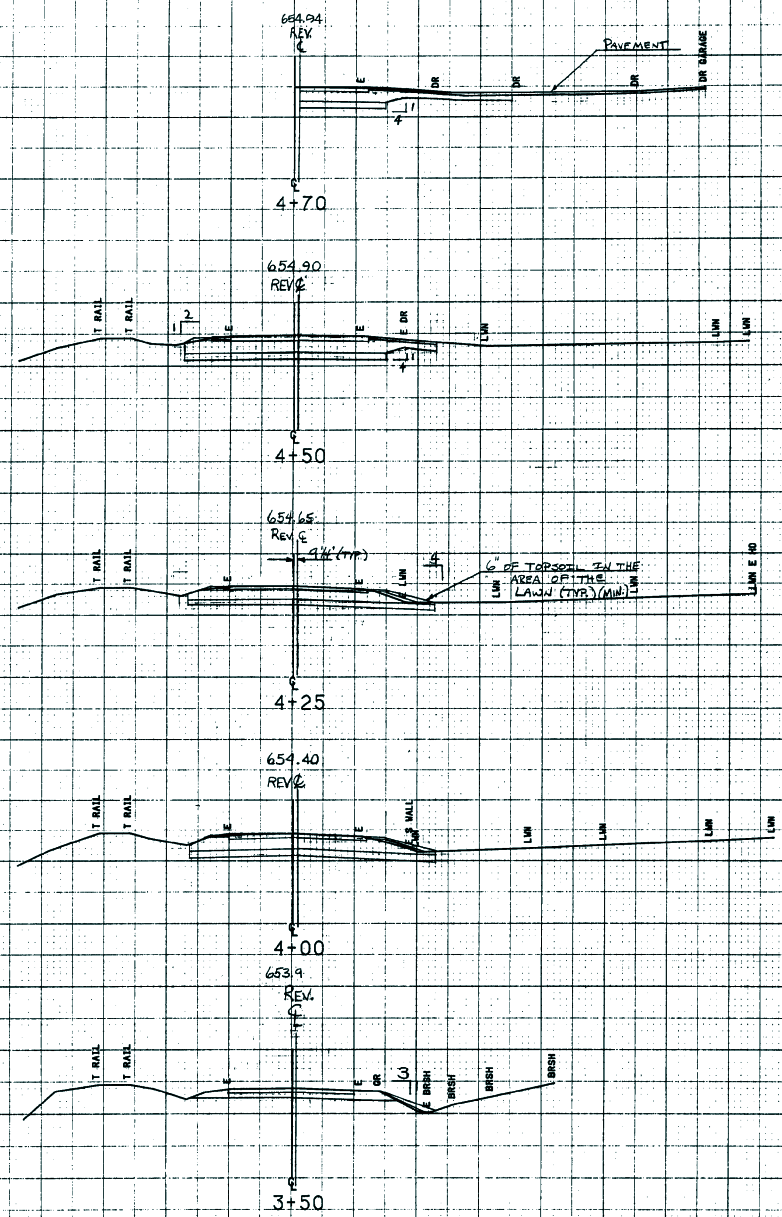

650 REV STA 4+64 RT - CONSTRUCT PAVED DRIVE

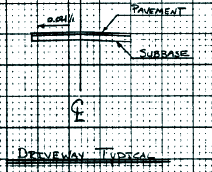

650 REV STA 4+50
END TOPSOIL

650 REV STA 4+00
BEGIN TRAFFIC
END APPROACH


SEE SUBBASE TRANSITION
DETAIL ON THIS SHEET.

650 REV STA 3+50
BEGIN TOPSOIL

**ARCHIVED
IN DPR**

SCALE 1" = 10 FEET


FROM STA.	3+50	TO STA.	4+70
PROJECT NAME	SUNDERLAND MAIN		
NO.	TH2-8003		
SURVEYED BY	BOSS	PLOTTED	04/23/91
SHEET	26	OF	37 SHEETS

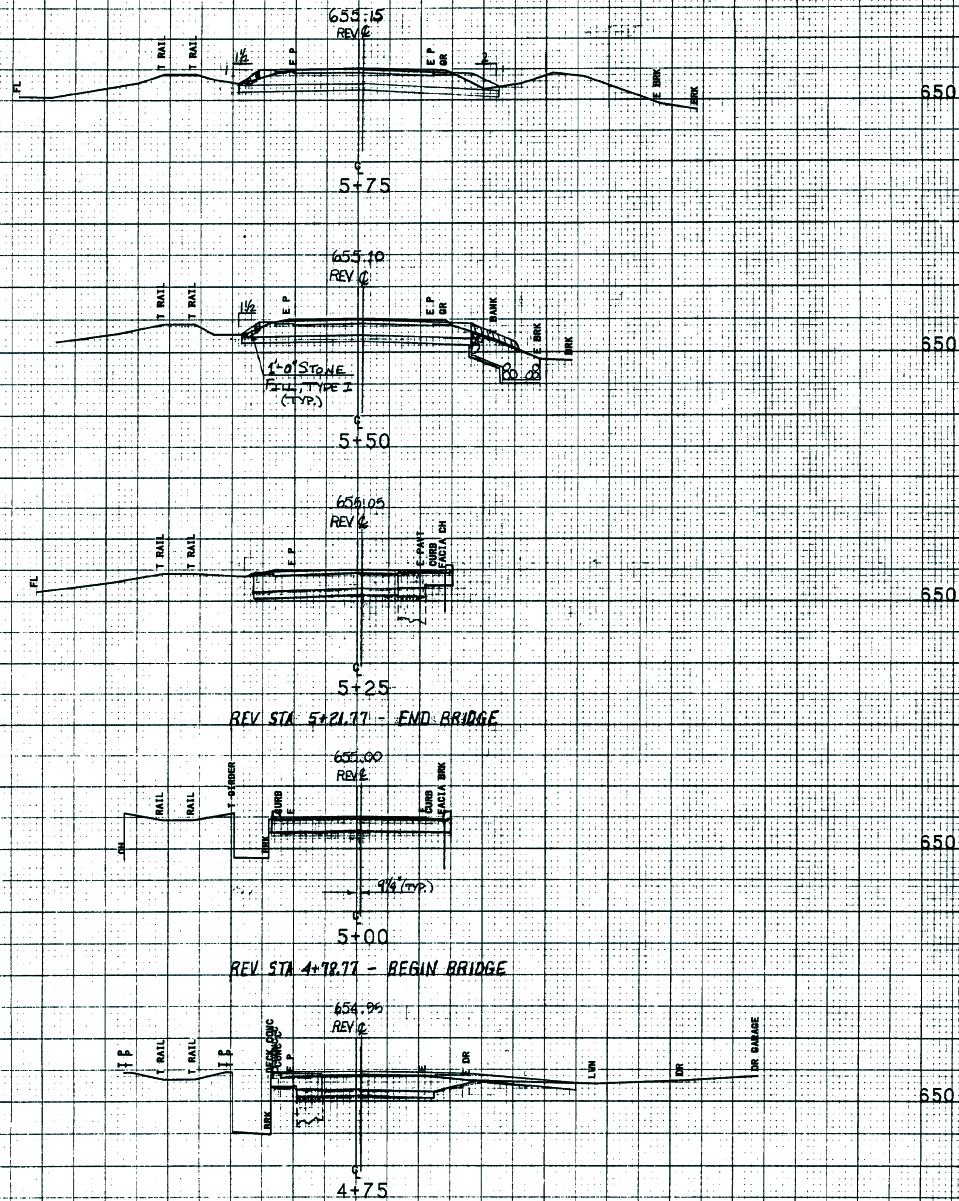

ARCHIVED
IN DPR


FROM STA.	4+75	TO STA.	5+75
PROJECT NAME	SUNDERLAND, MAIN		
NO.	TH2-9003	PLOTTED	04/25/91
SURVEYED BY	ROSS	DATE	04/91 0344
SHEET	22	OF	27 SHEETS

SCALE 1" = 10 FEET

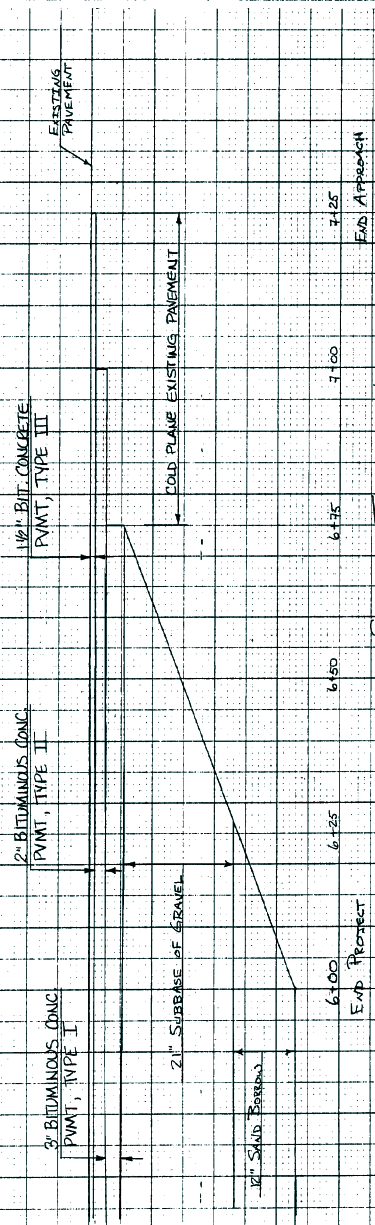

SUBBASE TRANSITION

HORIZ. SCALE 1" = 10'
VERT. SCALE 1" = 1'-0"

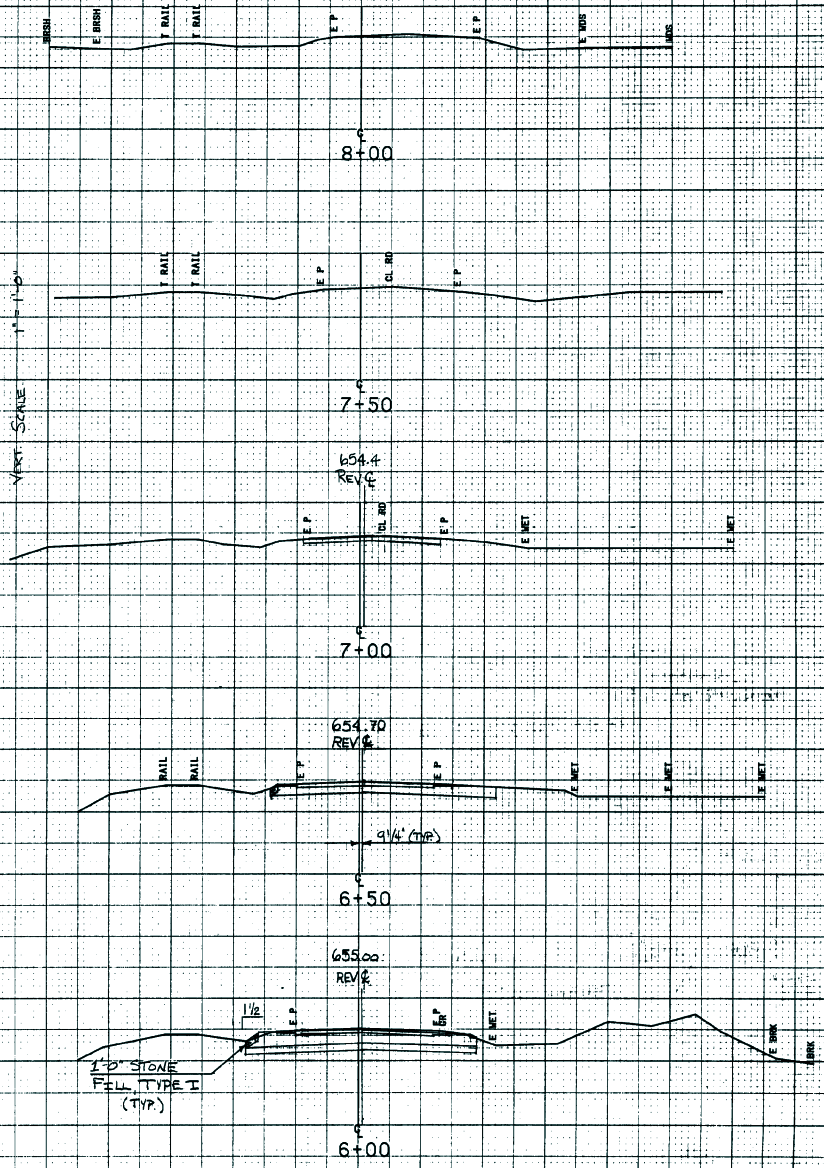


REV STA 7+25 =
SUN W/P 1725 AS 0-44
END APPROACH

SEE SUBBASE TRANSITION
DETAIL ON THIS SHEET.

REV STA 6+00
END PROJECT
BEGIN APPROACH



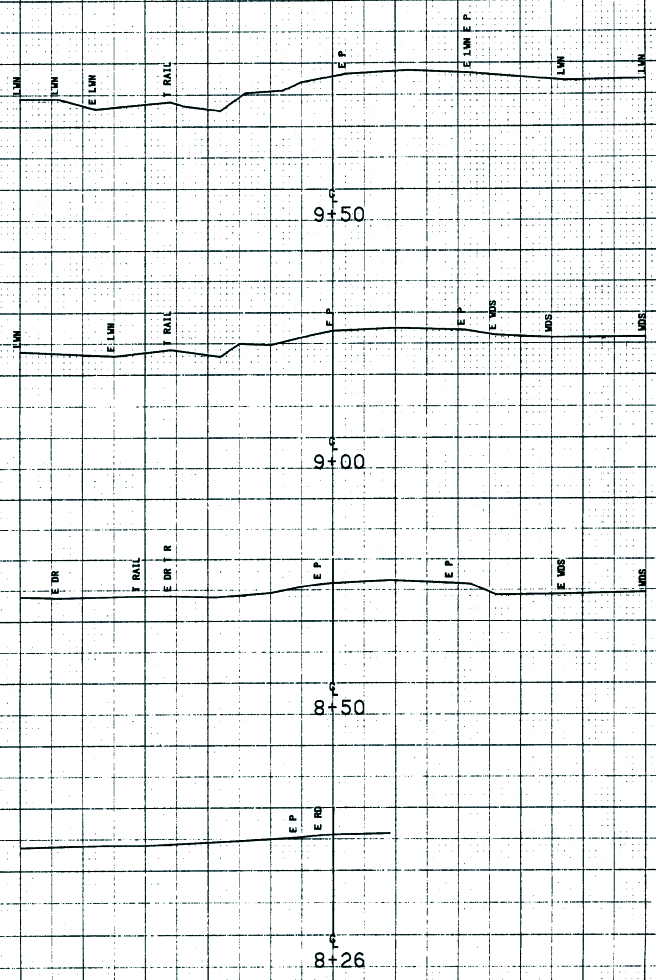

650

9+50

650

9+00

650

8+50

650

8+26

**ARCHIVED
IN DPR**




10+00

650

**ARCHIVED
IN DAP**

FROM STA.	10+00	TO STA.	10+00
PROJECT NAME	SUNDERLAND MAIN		PLOTTED 04/23/91
INC.	TH2-8003		
SURVEYED BY	ROSS		04/21/91
SHEET NO.	37	OF	37 SHEETS

SCALE 1" = 10 FEET

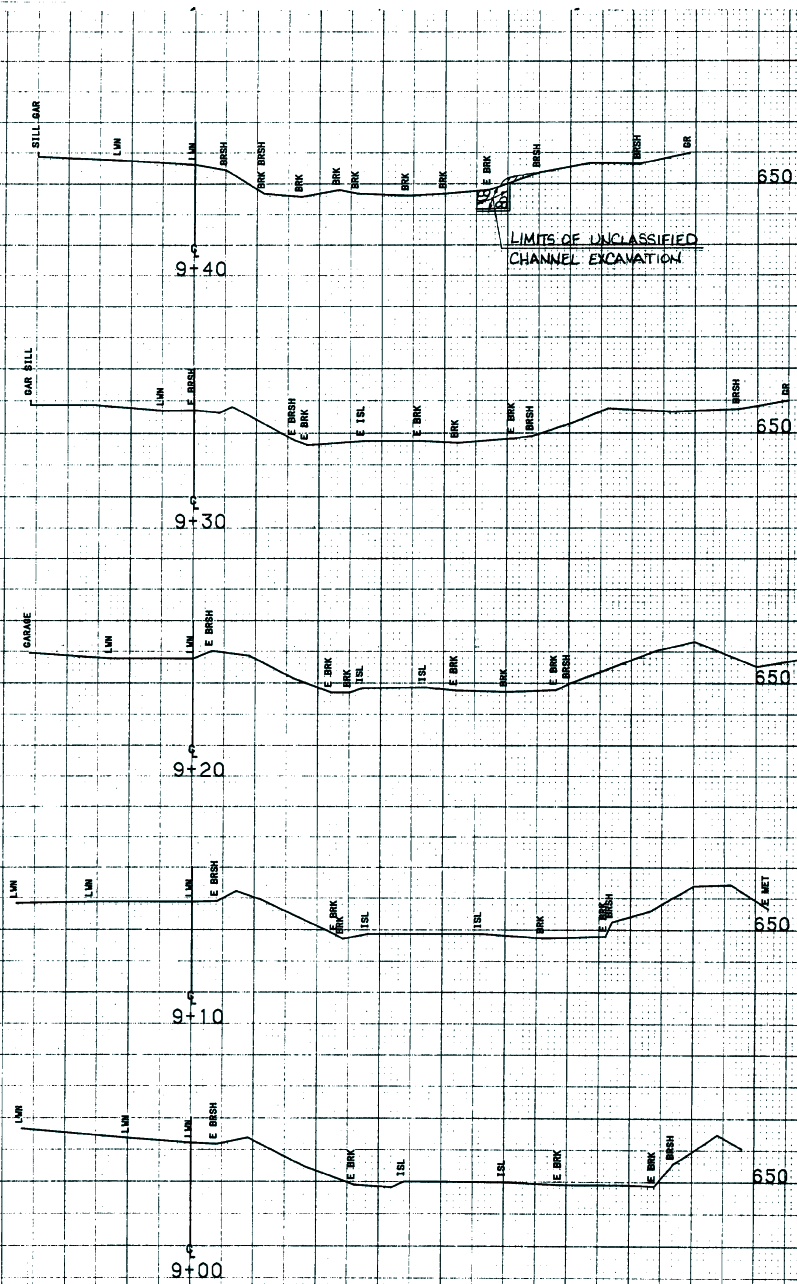



STA 9+38 BT ~ BEGIN UNCLASSIFIED CHANNEL EXCAVATION. GEOTEXTILE UNDER STONE FILL, STONE FILL (TYPE III) AND GRUBBING MATERIAL.

**ARCHIVED
IN
DPR**



FROM STA.	9+00	TO STA.	9+40
PROJECT NAME	SUNDERLAND CH		
NO.	TH2 8003		
SURVEYED BY	ROSS		
DATE	04/91		
PLOTTED	04/23/91		
SHEET	24	OF	37 SHEETS

SCALE 1" = 10 FEET


STA 9+86 LT ~ END GRANULAR
BACKFILL FOR STRUCTURES; END STONE FILL,
TYPE III; END GEOTEXTILE UNDER STONE FILL
STA 9+82 LT - END GRUBBING MATERIAL

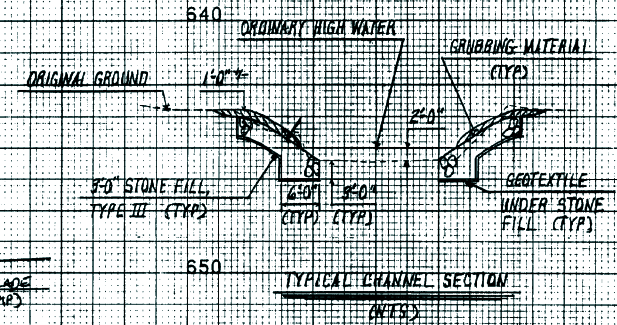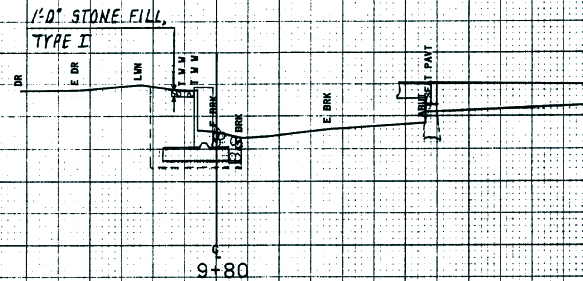

STA 9+77 LT ~ END UNCLASSIFIED CHANNEL
EXCAVATION
STA 9+72 LT - BEGIN GRANULAR
BACKFILL FOR STRUCTURES

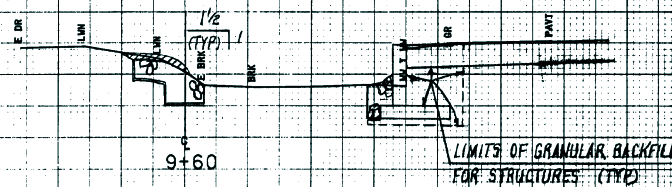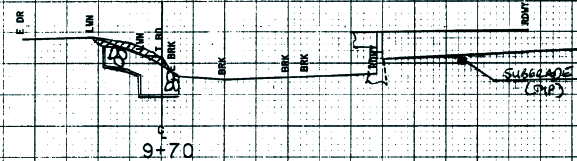

STA 9+51 LT ~ BEGIN UNCLASSIFIED
CHANNEL EXCAVATION, GEOTEXTILE UNDER
STONE FILL, STONE FILL (TYPE II) AND
GRUBBING MATERIAL

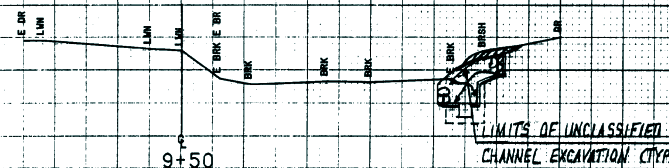

STA 9+46 RT ~ END GRANULAR
BACKFILL FOR STRUCTURES; END
STONE FILL, TYPE III; END GEOTEXTILE
UNDER STONE FILL; END GRUBBING
MATERIAL


STA 9+41 RT ~ END UNCLASSIFIED
CHANNEL EXCAVATION

STA 9+47 RT ~ BEGIN GRANULAR
BACKFILL FOR STRUCTURES

**ARCHIVED
IN DPR**

FROM STA.	9+50	TO STA.	9+80
PROJECT NAME	SUNDERLAND CR	PLOTTED	04/23/91
NO.	TH2 8003		
SURVEYED BY	9688		
SHEET 33	OF 37	SHEETS	04/91 0344

SCALE 1" = 10 FEET

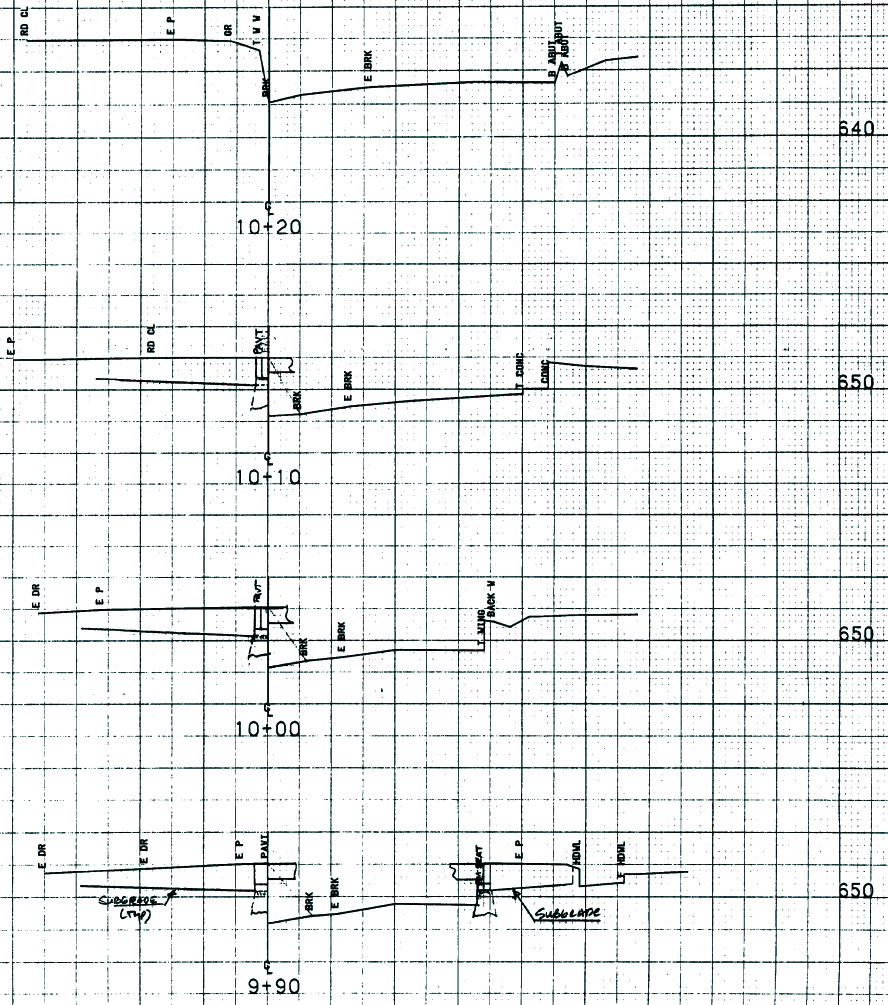

**ARCHIVED
IN DPR**

FROM STA.	9+90	TO STA.	10+20
PROJECT NAME	SUNDERLAND CH		
NO.	TH2 8003	PLOTTED	04/23/91
SURVEYED BY	ROSS	DATE	04/20/91
SHEET	3/4	OF	3 SHEETS

SCALE 1" = 10 FEET




10+50

640


**ARCHIVED
IN DPR**

SCALE 1" = 10 FEET

FROM STA.	10+50	TO STA.	10+50
PROJECT NAME	SUNDERLAND CN		
NO.	TH2 8003	PLOTTED	04/23/91
SURVEYED BY	JPS		
SHEET	37	OF	37 SHEETS

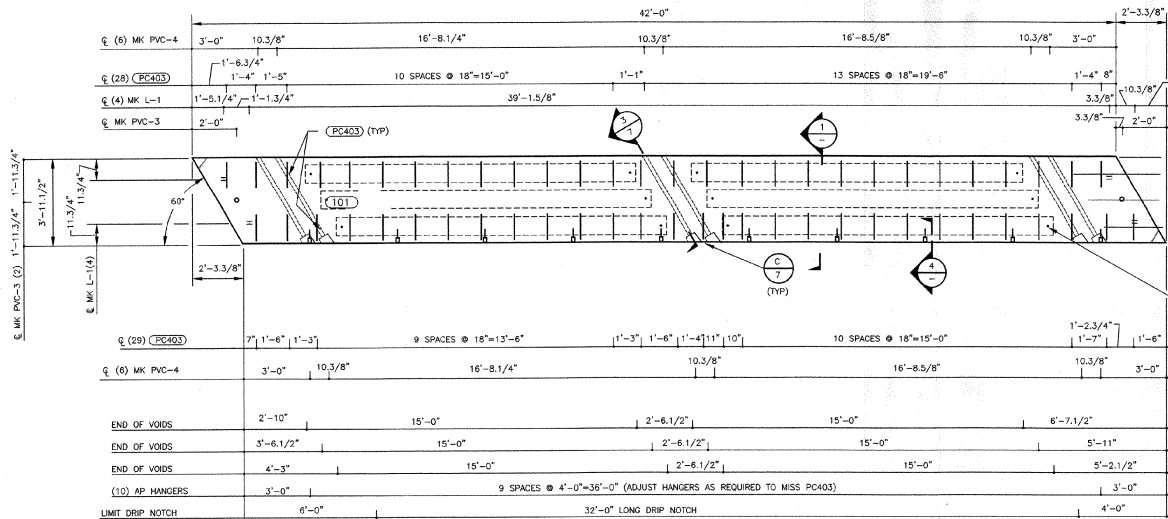


TOP IN FORM
SCALE 3/8" = 1'-0"

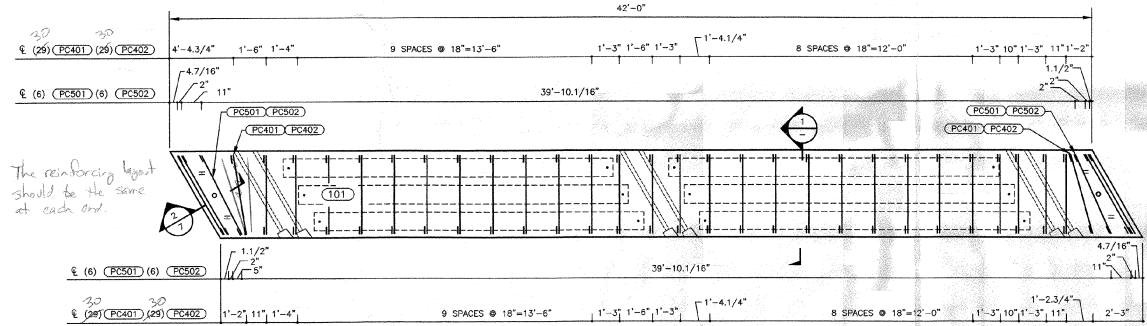


REINFORCING PLAN
SCALE 3/8" = 1'-0"

See detailing note on sheet 101

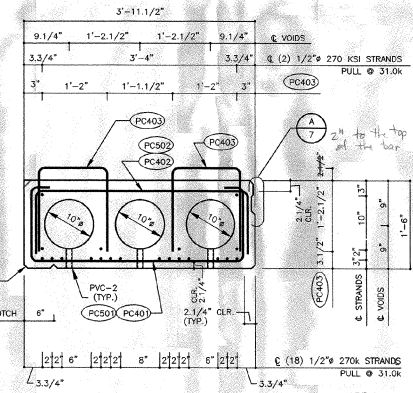

SECTION 1
20 TOTAL STRAND @ 31.0K



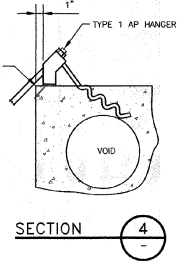


SECTION 4

BILL OF MATERIAL		CAST IN PRODUCTS	
DESCRIPTION	QTY.	TOTAL	
2" I.D. x 3'-11.3/8" PVC-4	6	6	
1" I.D. x 4" PVC-2	12	12	
10" VOID TUBE	6	6	
x 15'-0"			
LIFT LOOP MK L-1	4	4	
2" I.D. x 1'-4" PVC-3	2	2	
BLOCKOUT B-1	6	6	
PLATE P-1	6	6	
TYPE 1 AP HANGER BY DAYTON	10	10	
REINFORCING STEEL			
PC401	30	29	29
PC402	30	29	29
PC403	57	57	57
PC501	6	6	6
PC502	6	6	6
PRODUCT DATA			
CAMBER AT RELEASE		CAMBER FINAL	
WT: 30,450 LBS VOL: 7.6 CY EACH			
1. RELEASE STRENGTH = 4,000 PSI			
2. 28 DAY STRENGTH = 5,000 PSI			
3. REIN. STEEL GRADE 60			
GENERAL NOTES			
1. CLOUSED AREAS REFLECT LATEST REVISION			
2. TOP FINISH - RAKED TO 1/4" AMPLITUDE			
3. 3/4" CHAMFER ON ALL CORNERS.			
STATE	TOWN	FED. AID PROJ. NO.	
FISCAL YR. SHEET NO. TOTAL SHEETS			
PROJECT FILE NO.			
NO. REQUIRED	MARK NO.		
1	101		
SEAL			
PRECAST Structures, Inc. 1000 W. 12th St., Burlington, VT 05401 TEL: 802-249-7666 FAX: 802-249-7667			
BRIDGE NO. TH 1 STATE NO. TH2-9003 SHEET NO. 1 OF 8			

RECEIVED
 AUG 10 1998
 DESIGNED BY: [Signature]
 CHECKED BY: [Signature]
 APPROVED BY: [Signature]
 DATE: 8/1/98

MOHLIN & COMPANY
 100 W. 12th St., Burlington, VT 05401
 TEL: 802-249-7666 FAX: 802-249-7667
 PROJECT: TH 1 OVER MILL BROOK VERMONT
 SHEET TITLE: BRIDGE PLAN
 SCALE: NOT TO SCALE CHECKED: [Signature]
 DATE: [Signature]
 DRAWN BY: [Signature] APPROVED: [Signature]

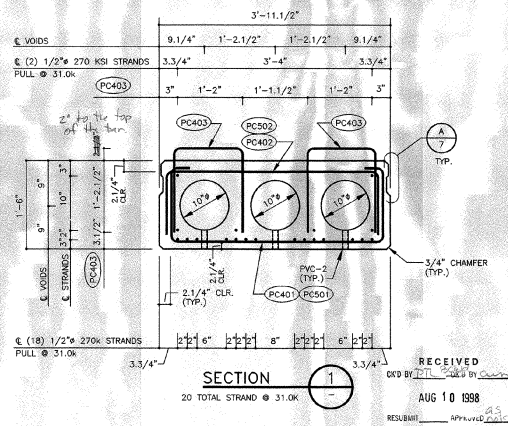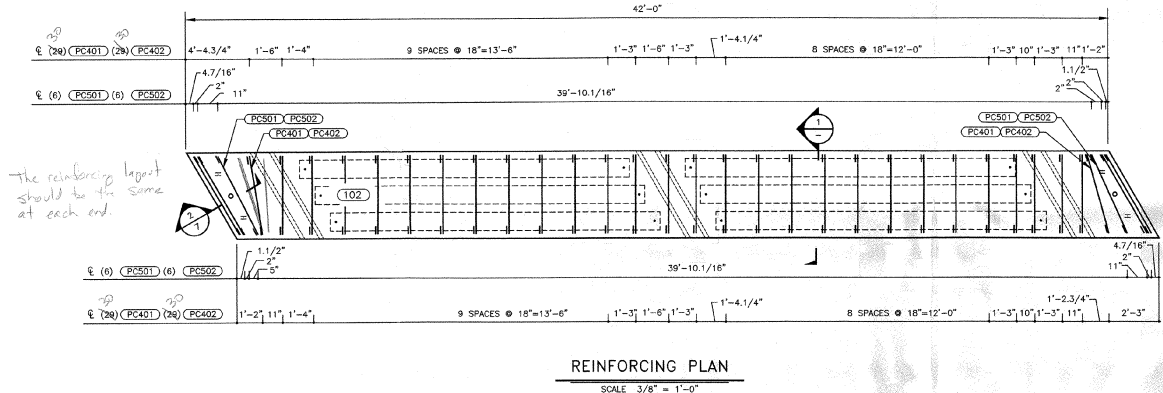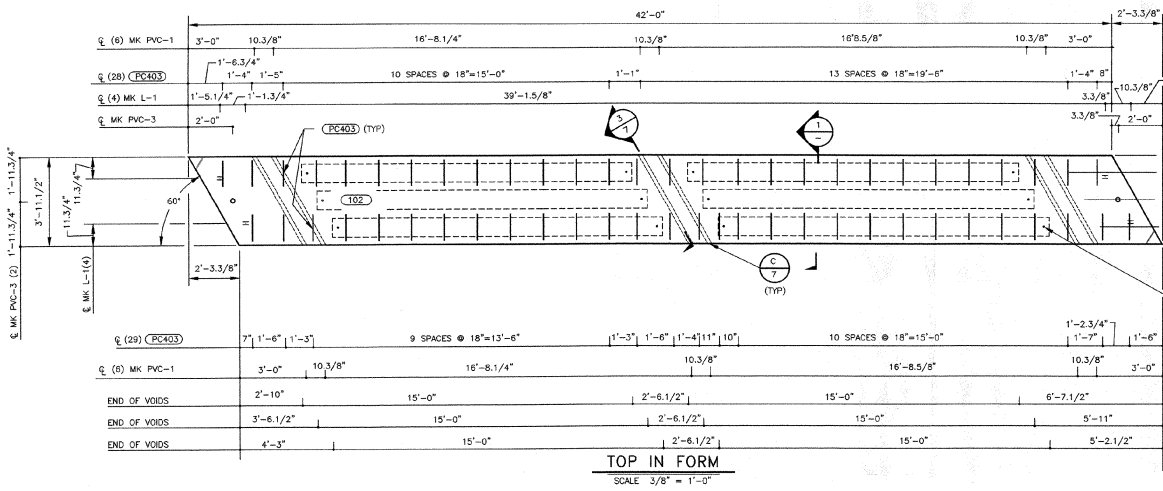


BILL OF MATERIAL		DATE REV	BY	ISSUED FOR APPROVAL
CAST IN PRODUCTS				
DESCRIPTION	QTY	TOTAL		
2" 1.0x4'-6.1/2" PVC-1	6	12		
1" 1.0x4" PVC-2	12	24		
10" VOID TUBE x 15'-0"	6	12		
LIFT LOOP MK L-1				
4	8			
2" 1.0x1'-4" PVC-3				
2	4			
REINFORCING STEEL				
PC401	50	29	85	
PC402	30	29	86	
PC403	57	114		
PC501	6	12		
PC502	6	12		
PRODUCT DATA				
CAMBER AT RELEASE	CAMBER FINAL			
WT. 30,450 LBS VOL. 7.6 CY EACH				
1. RELEASE STRENGTH - 4,000 PSI				
2. 28 DAY STRENGTH - 5,000 PSI				
3. REINF. STEEL GRADE 60				
GENERAL NOTES				
1. CLOUDED AREAS REFLECT LATEST REVISION				
2. TOP FINISH - RAKED TO 1/4" AMPLITUDE				
3. 3/4" CHAMFER ON ALL CORNERS.				
STATE	TOWN	FED. AID PROJ. NO.		
FISCAL YR. SHEET NO. TOTAL SHEETS				
PROJECT FILE NO.				
NO. REQUIRED	MARK NO.			
2	102			
SEAL				
<div style="display: flex; justify-content: space-between;"> <div> <p>RECEIVED AUG 10 1998</p> </div> <div> <p>MOHLIN & COMPANY HAS PROVIDED DRAFTING SERVICES ONLY. DESIGN BY SIRKO ASSOCIATES, DENVER CO.</p> </div> </div>				

PROJECT: TH 1 OVER MILL BROOK
BRIDGE PLAN
VENOMT
SCALE: 1/8" = 1'-0"
DATE: 8/11/98
DESIGNED BY: [Signature]
DRAWN BY: VCE

MOHLIN & COMPANY
1000 STATE ST., SUITE 100
DENVER, CO. 80202


BRIDGE NO. TH 1
STATE NO. VT
TH2-9003
SHEET NO. 2 OF 8

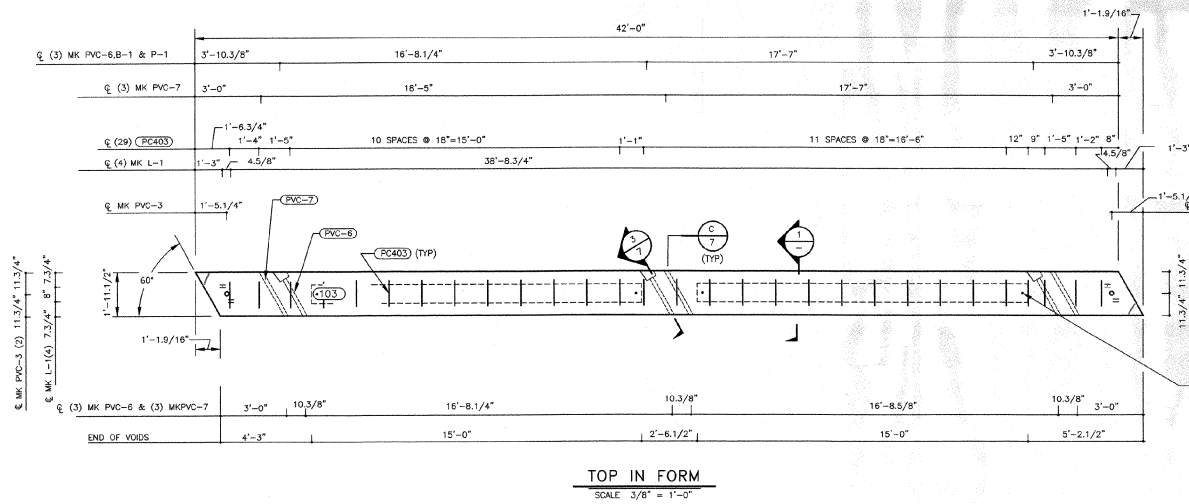

TOP IN FORM
SCALE 3/8" = 1'-0"


VOID TUBES
The long corners should be chamfered

DRAIN PVC-2
4" FROM END OF VOID TUBE
TOP 4 PLACES
SEE SECTION 1
THIS SHEET

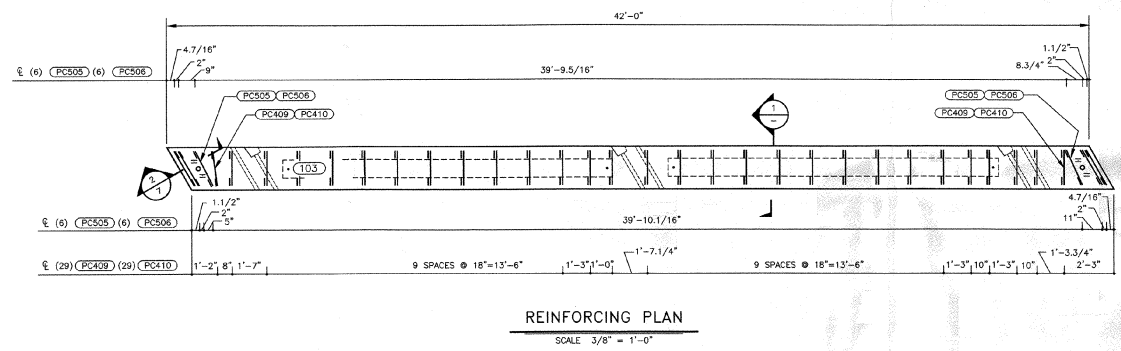

REINFORCING PLAN
SCALE 3/8" = 1'-0"

See the detensioning note on sheet 101.

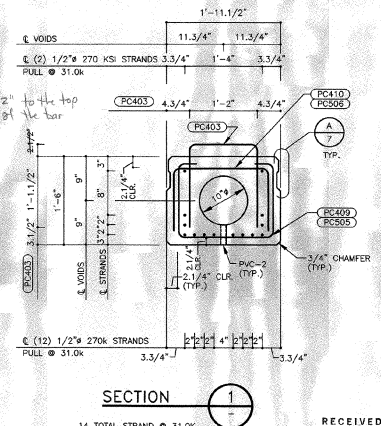

SECTION 1

14 TOTAL STRAND @ 31.0K

RECEIVED
BY P.T.L. 066 BY C.M.P.
AUG 10 1998
RESUBMITTED APPROVED
BY G.S.R. DATE 8/13/98

BILL OF MATERIAL
CAST IN PRODUCTS

DESCRIPTION	QTY.	TOTAL
2" I.D.x1'-7.5/8" PVC-6	3	3
1" I.D.x4" PVC-2	4	4
10" VOID TUBE x 15'-0"	2	2
LIFT LOOP MK L-1	4	4
2" I.D.x1'-4" PVC-3	2	2
2" I.D.x2'-2.3/4" PVC-7	3	3
BLOCKOUT B-1	3	3
PLATE P-1	3	3

REINFORCING STEEL

PC403	29	29
PC409	29	29
PC410	29	29

PRODUCT DATA

CAMBER AT RELEASE CAMBER FINAL
WT: 16,530 LBS. VOL: 4.1 CY EACH
1. RELEASE STRENGTH - 4,000 PSI
2. 28 DAY STRENGTH - 5,000 PSI
3. REINF. STEEL GRADE 60

GENERAL NOTES

- CLOUDED AREAS REFLECT LATEST REVISION
- TOP FINISH - RAKED TO 1/4" AMPLITUDE
- 3/4" CHAMFER ON ALL CORNERS.

STATE TOWN FED. AID PROJ. NO.




FISCAL YR. SHEET NO. TOTAL SHEETS

NO. REQUIRED	MARK NO.
1	103

SEAL

MOHLEN & COMPANY HAS PROVIDED DRAFTING SERVICES ONLY. DESIGN BY BIRKO ASSOCIATES, DENVER CO.

PROJECT TH 1 OVER MILL BROOK
LOCATION: SUNDERLAND VERMONT
SCALE: 3/8" = 1'-0"
DATE: 8/13/98
DRAWN BY: VOD
CHECKED BY: VOD
APPROVED BY: VOD
BRIDGE NO. TH 1
STATE NO. VT
TH2-9003
SHEET NO. 3 OF 8

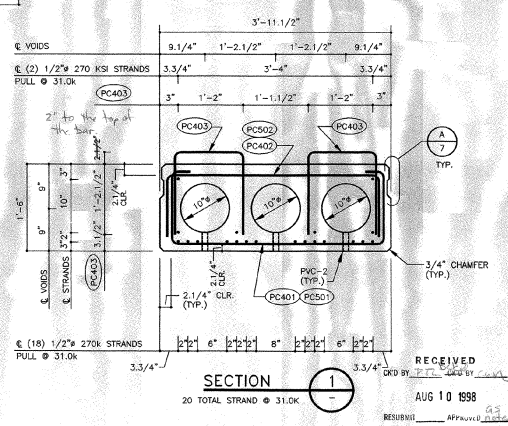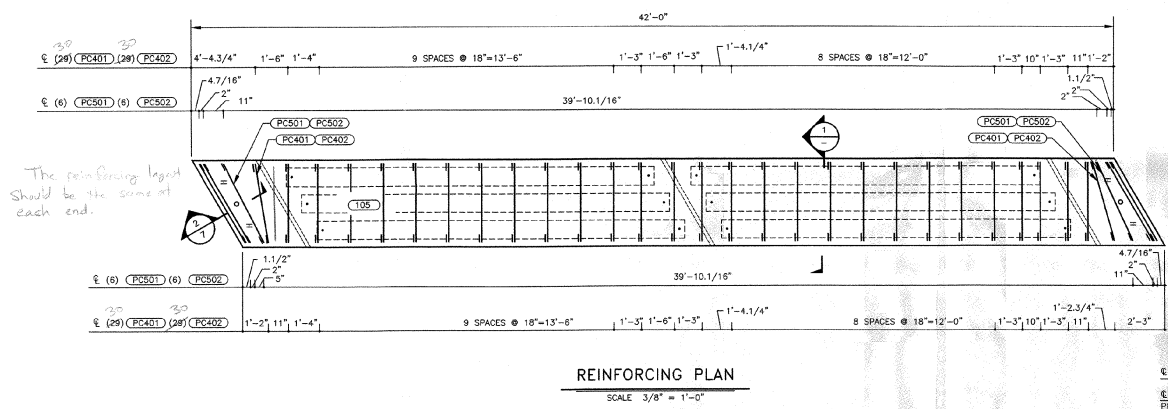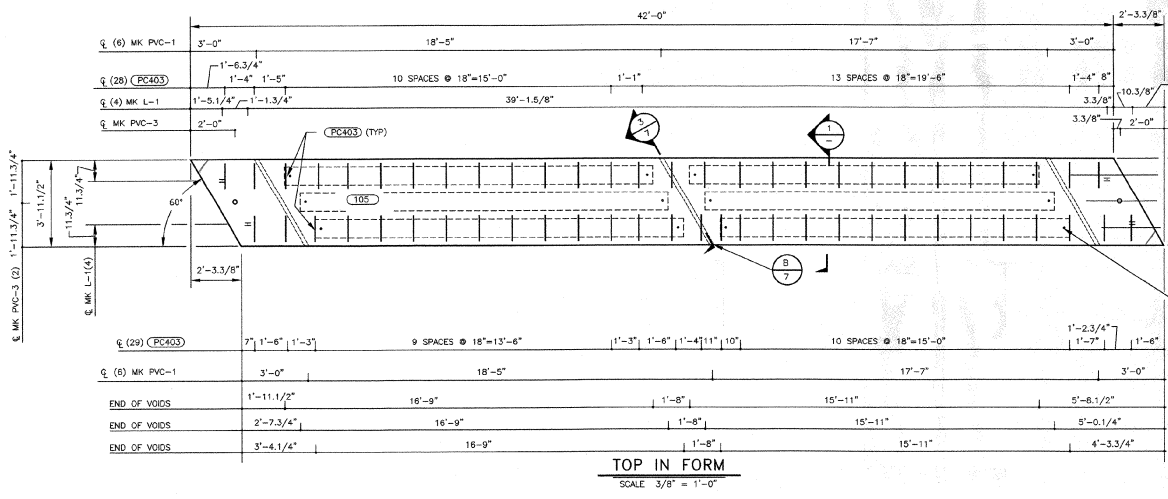

BILL OF MATERIAL		BR	SP
CAST IN PRODUCTS		DATE REV	ISSUED FOR APPROVAL
DESCRIPTION	QTY	TOTAL	DATE
2" I.D. x 4'-6.1/2" PVC-1	3	6	
1" I.D. x 4" PVC-2	12	24	
10" VOID TUBE x 15'-11"	3	6	
10" VOID TUBE x 16'-9"	3	6	
LIFT LOOP MK L-1	4	8	
2" I.D. x 1'-4" PVC-3	2	4	

REINFORCING STEEL		BR	SP
DESCRIPTION	QTY	TOTAL	DATE
PC401	20	20	
PC402	20	20	
PC403	57	114	


PRODUCT DATA	
CAMBER AT RELEASE	CAMBER FINAL
WT: 30,450 LBS EACH	VOL: 7.6 CY EACH
1. RELEASE STRENGTH = 4,000 PSI	
2. 28 DAY STRENGTH = 5,000 PSI	
3. REINF. STEEL GRADE 60	

GENERAL NOTES	
1. CLOUDED AREAS REFLECT LATEST REVISION.	
2. TOP FINISH - RAKED TO 1/4" AMPLITUDE.	
3. 3/4" CHAMFER ON ALL CORNERS.	


PROJECT FILE NO.	
NO. REQUIRED	MARK NO.
2	105

RECEIVED	
DATE	BY
AUG 10 1998	


MOHLIN & COMPANY
 PRECAST STRUCTURES, INC.
 BRIDGE PLAN
 PROJECT TH 1 OVER MILL BROOK
 VERMONT
 LOCATION SUNDERLAND
 DRAWN BY MCD
 CHECKED BY MCD
 DATE 8/2/98
 SCALE 3/8" = 1'-0"
 SHEET NO. 5 OF 8
 BRIDGE NO. TH 1
 STATE NO. VT
 SHEET NO. TH2-9003

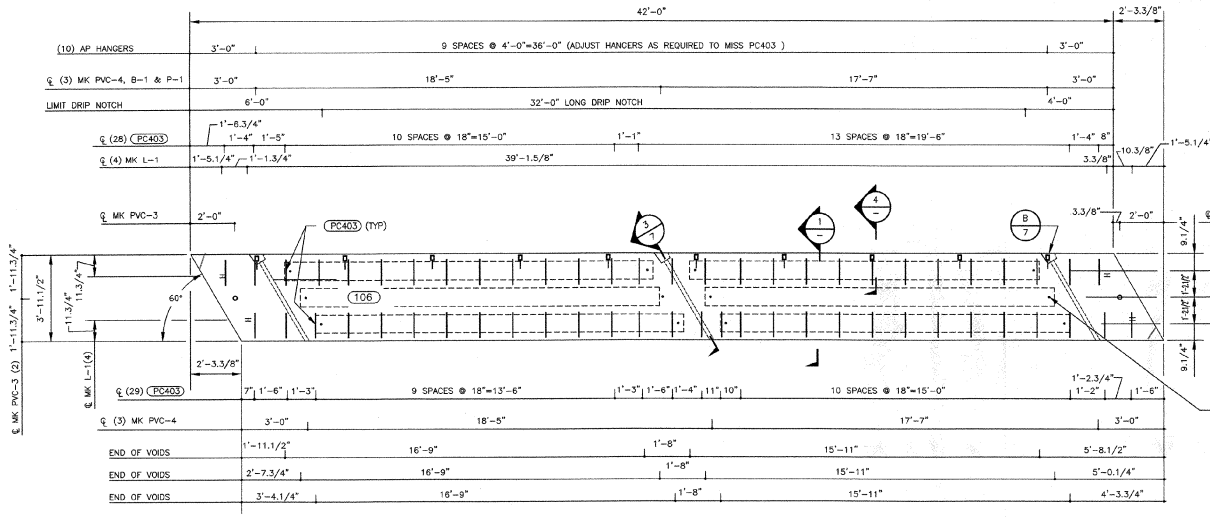


TOP IN FORM
SCALE 3/8" = 1'-0"

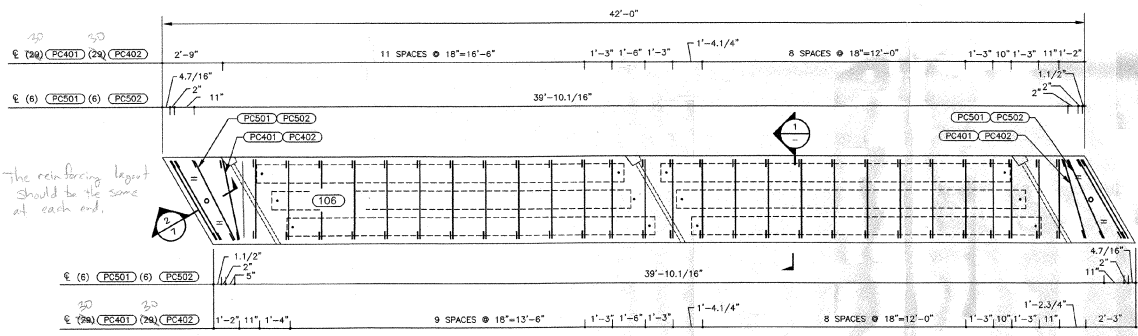

REINFORCING PLAN
SCALE 3/8" = 1'-0"

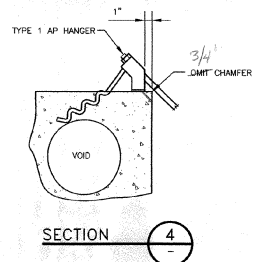

SECTION 4

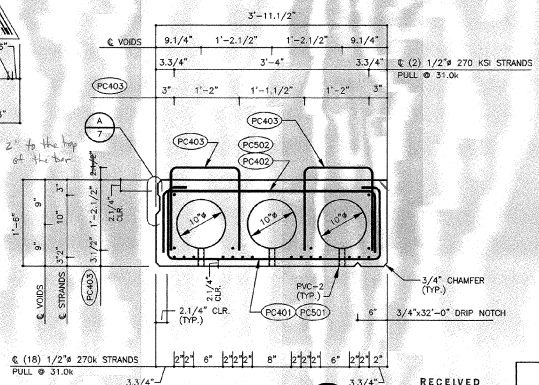

SECTION 1

BILL OF MATERIAL			REVISIONS		DATE	
CAST IN PRODUCTS			BY	DATE	ISSUED FOR APPROVAL	DATE
DESCRIPTION	QTY.	TOTAL				
2" I.D.x3'-11.3/8" PVC-4	3	3				
1" I.D.x4" PVC-2	12	12				
10" VOID TUBE x 15'-11"	3	3				
10" VOID TUBE x 16'-9"	3	3				
LIFT LOOP MK L-1	4	4				
2" I.D.x1'-4" PVC-3	2	2				
BLOCKOUT B-1	3	3				
PLATE P-1	3	3				
TYPE 1 AP HANGER BY DAYTON	10	10				

REINFORCING STEEL		
PC#	QTY.	TOTAL
PC401	30	29
PC402	30	29
PC403	57	57

PRODUCT DATA		
CAMBER AT RELEASE	CAMBER FINAL	
WT. 30,450 LBS. EACH	VOL. 7.6 CY EACH	
1. RELEASE STRENGTH - 4,000 PSI		
2. 28 DAY STRENGTH - 5,000 PSI		
3. REIN. STEEL GRADE 60		

GENERAL NOTES		
1. CLOUDED AREAS REFLECT LATEST REVISION.		
2. TOP FINISH - RAKED TO 1/4" AMPLITUDE.		
3. 3/4" CHAMFER ON ALL CORNERS.		

STATE	TOWN	FED. AID PROJ. NO.


FISCAL YR.	SHEET NO.	TOTAL SHEETS

PROJECT FILE NO.	
NO. REQUIRED	MARK NO.
1	106


MOHLIN & COMPANY HAS PROVIDED DRAFTING SERVICES ONLY. DESIGN BY SIRKO ASSOCIATES, DENVER CO.

PROJECT: TH 1 OVER MILL BROOK
 LOCATION: SUNDERLAND VERMONT
 DRAWN BY: VCD
 CHECKED BY: VCD
 SCALE: 3/8" = 1'-0"
 SHEET NO. 1 OF 8
 DATE: 8/1/98


RECEIVED
 AUG 10 1998
 BY: G.S.A. DATE: 8/1/98

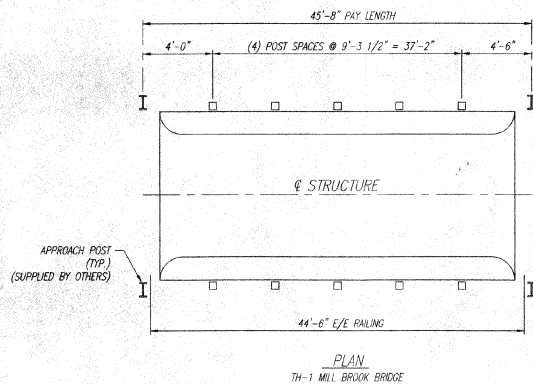


PLAN
TH-1 MILL BROOK BRIDGE

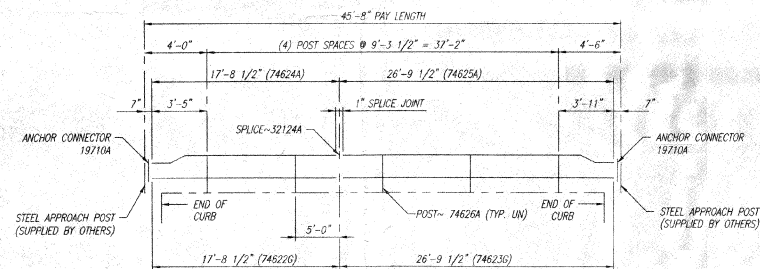


ELEVATION OF BRIDGE RAILING
LOOKING FROM ϵ OF BRIDGE (TYP. BOTH SIDES)

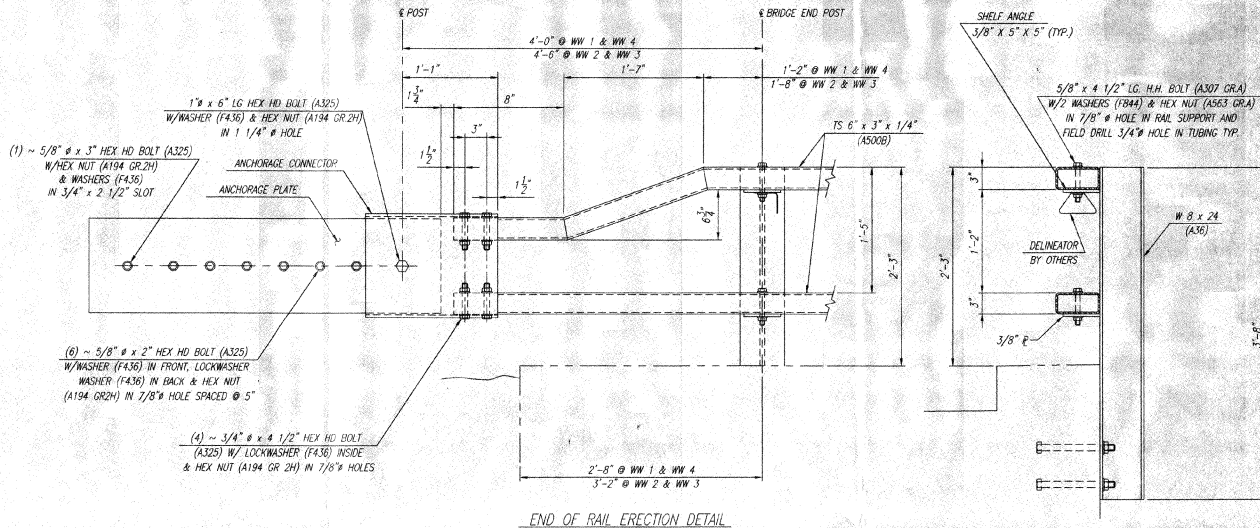

END OF RAIL ERECTION DETAIL

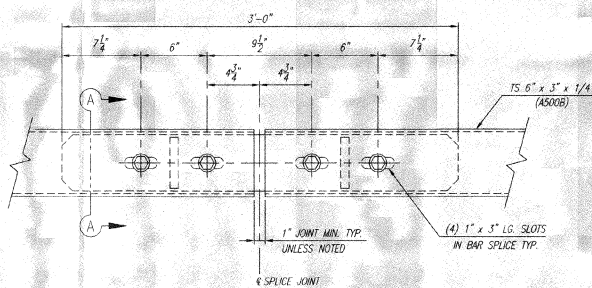

SPLICE DETAIL

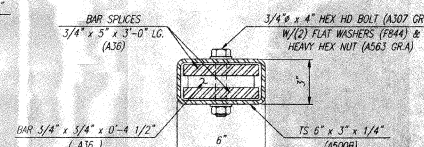

SECTION ~ A - A
(ROTATED 90° CCW)

APPROVAL DRAWING

ISSUED
JUL 22 1998
ISSUED

SHOP DETAILS ARE ON SHT. D1 & D2 OF 2 (22) 101820

REV.	CHG'D	BY	DATE	REMARKS
1	T.P.	S.H.	7/21/98	CHANGED PER APPROVAL COMMENTS

92 LF BRIDGE RAIL-2 RAIL


VERMONT AGENCY OF TRANSPORTATION HIGHWAY NO. TH1 TOWN OF SUNDERLAND STATE PROJECT NO. TH 2-9083 CUSTOMER F. R. LAFAYETTE INC.	BRIDGE OVER MILL BROOK P.O. No. 12785	DRAWN W.B. CHECKED R.M.H. APPROVED DATE 6-18-98 ENG. FILE # 101820E1	SHEET NO. ET OF 1 DRAWING NO. (22) 101820
---	--	--	--

RECEIVED
CPL
JUL 28 1998
RESUBMIT APPROVED
BY G.S.R. DATE 7/27/98

This drawing and the information shown hereon is the sole property of TRINITY INDUSTRIES, INC. Neither the drawing nor such information is to be used for any purpose other than that for which it was specifically furnished by TRINITY INDUSTRIES, INC. nor is any reproduction authorized without written permission.

TRINITY INDUSTRIES, INC. **SURO**


DALLAS, TX GRAND, OH FORT WORTH, TX
CENTERVILLE, VA UMA, OH ELIZABETHTOWN, KY

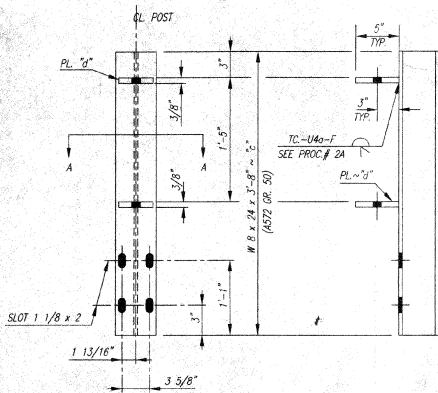


10 ~ 74626A POST

EACH POST 74626A CONSISTING OF:

SUB MK	QUAN.	DESCRIPTION
c	1	W 8 x 24 x 3'-8" (A572 GR. 50)
d	2	PL 5" x 3/8" x 5" LG. (A36)

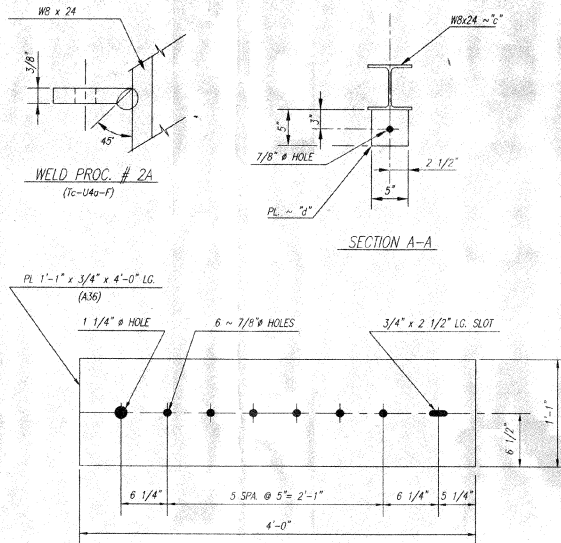

4 ~ 811G ANCHOR PLATE

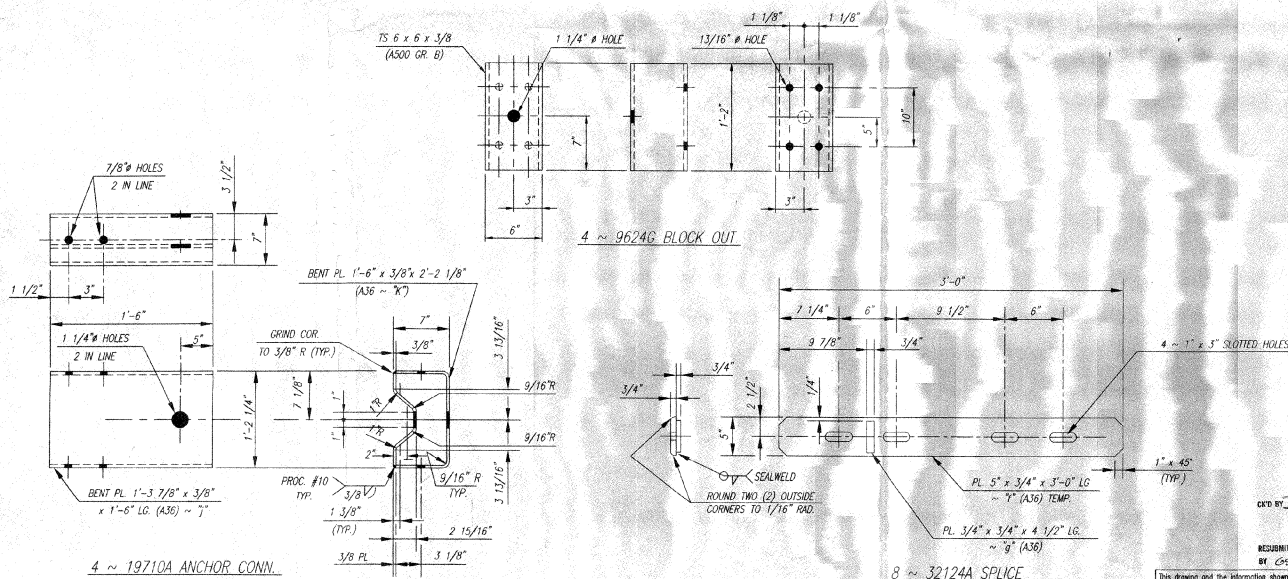

4 ~ 9624G BLOCK OUT

4 ~ 19710A ANCHOR CONN.

8 ~ 32124A SPLICE

BILL OF MATERIAL

PRODUCT CODE	QTY	DESCRIPTION	WT	REMARKS
74626A	10	2 RAIL POST	99#	
32124A	8	SPLICE	37#	
19710A	4	ANCHOR CONN.	83#	
811G	4	ANCHOR PLATE	135#	
9624G	4	BLOCK OUT	34#	
HARDWARE				
3706G	16	3/4 # x 4" HEX HD. BOLT	A307 GR. A A153	
3700G	32	3/4 # FLAT WASHER	F844 A123	
3704G	16	3/4 # HEX NUT (HVV)	A307 GR. A A153	
4433G	20	5/8 # x 1 1/2" HEX HD. BOLT	A307 GR. A A153	
3350G	40	5/8 # FLAT WASHER	F844 A123	
3350G	20	5/8 # HEX NUT	A563 GR. A A153	
3917G	4	1" # x 6" HEX HD. BOLT	A325 A153	
4902G	4	1" # FLAT WASHER	F436 A123	
4903G	4	1" # HEX NUT	A194 Gr.2H A153	
4421G	4	5/8 # x 3" HEX HD. BOLT	A325 A153	
3404G	24	5/8 # x 2" HEX HD. BOLT	A325 A153	
4322G	32	5/8 # FLAT WASHER	F436 A123	
3310G	24	5/8 # LOCK WASHER	F436 A123	
3351G	28	5/8 # HEX NUT	A194 Gr.2H A153	
4796G	16	3/4 # x 4 1/2" HEX HD. BOLT	A325 A123	
4699G	16	3/4 # LOCK WASHER	F436 A123	
3711G	16	3/4 # HEX NUT	A194 Gr.2H A153	
PAY QUANTITIES				
9'-0" LIN FT.	ITEM NO. 525.31	2-RAIL GALV. BOX BEAM BRIDGE RAILING		

HARDWARE NOTE:

VERMONT DEPT. OF HIGHWAYS HIGH STRENGTH HARDWARE A325 OR A449 REQUIRES MANUFACTURER'S CERTIFICATE SHOWING HEAT NO. PHYSICAL PROPERTIES AND CHEMICAL ANALYSIS.
 CARBON A307 HARDWARE REQUIRES THE MANUFACTURER'S CERTIFICATE OF COMPLIANCE.

NOTES:

1. ALL POSTS TO BE CHAMFY V NOTCH TESTED
2. INSPECTED BY GUNWELL
3. FINISH GALV A123
4. W8 x 24 POST SHALL MEET MINIMUM CHAMFY TOLERANCE REQUIREMENTS
5. ALL WELDING SHALL CONFORM WITH VERMONT STANDARD SPECIFICATIONS SECTION 506.10

APPROVAL DRAWING
ISSUED
 JUL 22 1998
SUED


ERECTION DETAILS ARE ON SHEETS E1 OF 1 (22) 101820

1	D.D.	SH	7/21/98	CHANGED PER APPROVAL COMMENTS	REMARKS
REV	CHWD	BY	DATE		
92 LF BRIDGE RAIL-2 RAIL					
VERMONT AGENCY OF TRANSPORTATION HIGHWAY NO. TH1 TOWN OF SUNDERLAND STATE PROJECT NO. TH 2-9003 BRIDGE OVER MILL BROOK				DRAWN	WB.
CUSTOMER: F. R. LAFAYETTE INC.				CHECKED	F.M.H.
P.O. NO. 12785				APPROVED	
DATE: 6-18-98				DATE	6-18-98
SHEET: 01 OF 2				ENG. FILE #	10182001
DRAWING NO. (22) 101820				DATE	01 OF 2
TRINITY INDUSTRIES, INC.				SPRO	
DALLAS, TX		GRAND, OH		FORT WORTH, TX	
CENTERVILLE, UT		LIMA, OH		ELIZABETHTOWN, KY	


RECEIVED
 CWD BY: [Signature]
 JUL 28 1998
 REQUESTED APPROVED BY: G.S.L. DATE: 7/21/98

This drawing and the information shown thereon is the sole property of TRINITY INDUSTRIES, INC. Neither the drawing nor such information is to be used for any purpose other than that for which it was specifically furnished by TRINITY INDUSTRIES, INC. nor is any reproduction authorized without written permission.


1: DDB/VP/10/10/0001 5th JUL 21 11:21:58 1998 Plot: 17: Sued: 1: Trinity

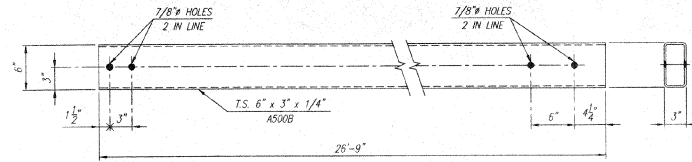


2 ~ END RAILS ~ 74623G

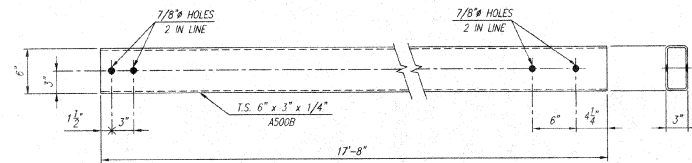

2 ~ END RAILS ~ 74622G

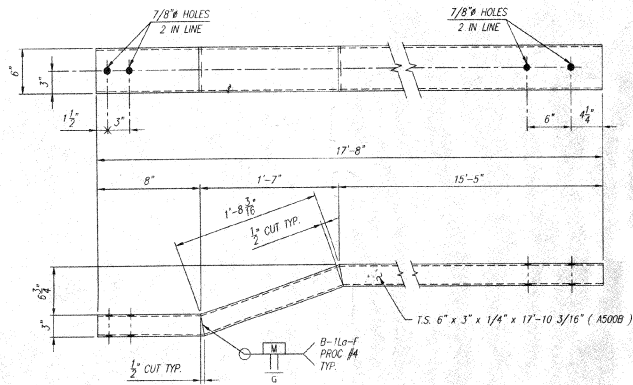

2 ~ END RAILS ~ 74624A

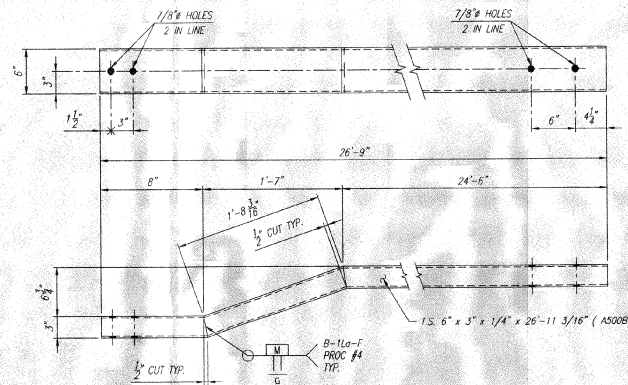

2 ~ END RAILS ~ 74625A

BILL OF MATERIAL

PRODUCT CODE	QTY	DESCRIPTION	WT	REMARKS
RAILS				
74622G	2	TS 6 x 3 x 1/4 x 17'-8"	280#	
74623G	2	TS 6 x 3 x 1/4 x 26'-9"	323#	
74624A	2	TS 6 x 3 x 1/4 x 17'-10 3/16"	265#	
74625A	2	TS 6 x 3 x 1/4 x 26'-11 3/16"	396#	

- NOTES:
 1. ALL POSTS TO BE CHAPPY V-NOTCH TESTED.
 2. INSPECTED BY CONWELL.
 3. FINISH GALV. A123
 4. W8 x 24 POSTS SHALL MEET MINIMUM CHAPPY V-NOTCH TOUGHNESS REQUIREMENTS.
 5. ALL WELDING SHALL CONFORM WITH VERMONT STANDARD SPECIFICATIONS SECTION 506.10.

APPROVAL DRAWING

ISSUED
 JUL 22 1998
 ISSUED

ERECTION DETAILS ARE ON SH. E1 OF 1 (22) 101820

REV.	CHKD.	BY	DATE	REMARKS
1	T.P.	S.H.	7/21/98	CHANGED PER APPROVAL COMMENTS
92 LF BRIDGE RAIL - 2 RAIL				
VERMONT AGENCY OF TRANSPORTATION HIGHWAY NO. 174 TOWN OF SUNDERLAND STATE PROJECT NO. TH 2-9003 BRIDGE OVER MILL BROOK				DRAWN: W.B. CHECKED: R.M.H. APPROVED:
CUSTOMER: F. R. LAFAYETTE INC. P.O. No. 12785				DATE: 6-18-98
				ENG. FILE # 10182002
				DRAWING No. 02 OF 2
				REV. (22) 101820

RECEIVED
 BY: [Signature] DATE: JUL 28 1998

This drawing and the information shown thereon is the sole property of TRINITY INDUSTRIES, INC. Neither the drawing nor such information is to be used for any purpose other than that for which it was specifically furnished by TRINITY INDUSTRIES, INC., nor is any reproduction authorized without written permission.

TRINITY INDUSTRIES, INC. **SYRO**
 WINDLA, UT GRAND, OH FORT WORTH, TX
 CENTERVILLE, UT LIMA, OH ELIZABETHTOWN, KY