


INDEX OF SHEETS

1. TITLE
2. PRELIMINARY INFORMATION
3. BRIDGE AND ROADWAY TYPICAL QUANTITY
- 4-5. DRAINAGE SHEET
6. RIGHT OF WAY
- 7-8. LAYOUT
9. PROFILE - MAINLINE
10. PROFILE - SIDELINE
11. TRAFFIC SIGN LAYOUT
12. TRAFFIC SUMMARY SHEET
13. BORING
14. PLAN AND ELEVATION
15. EROSION CONTROL
16. GENERAL NOTES
17. SLAB TYPICAL SECTIONS
18. SLAB REINFORCING PLAN
19. ABUTMENT # 1 DETAILS
20. ABUTMENT # 2 DETAILS
21. WINGWALL DETAILS
22. FOOTING REINFORCING PLAN
23. MISCELLANEOUS DETAILS
24. REINFORCING STEEL SCHEDULE
- 25-29. MAINLINE SECTIONS
- 30-33. CHANNEL SECTIONS


LIST OF STANDARDS

G-18	06-01-94
B-5	06-01-94
B-71	03-10-95
D-2	06-01-94
D-4	06-01-94
E-100	01-06-97
E-101	03-10-97
E-102	08-08-95
E-102A	08-08-95
E-106	08-08-95
E-107	08-08-95
E-107A	08-08-95
E-121	08-08-95
E-143	09-20-95
E-160	05-20-99
E-164	05-20-99
E-191	02-01-99
E-193	08-18-95
G-1	01-03-00
G1d	01-03-00
G-4	06-01-94
SB-R6-82	01-06-95
SB-R7-90	01-11-95
T-1	06-01-94
T-2	06-01-94

STATE OF VERMONT AGENCY OF TRANSPORTATION

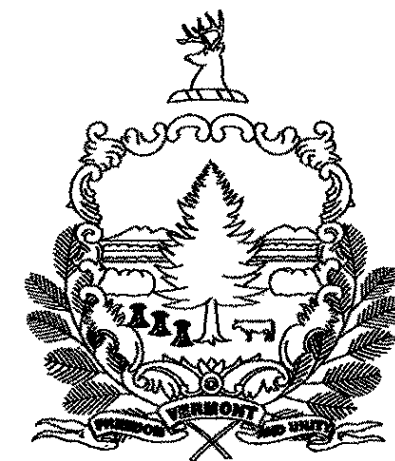

PROPOSED IMPROVEMENT BRIDGE PROJECT TOWN OF HALIFAX COUNTY OF WINDHAM

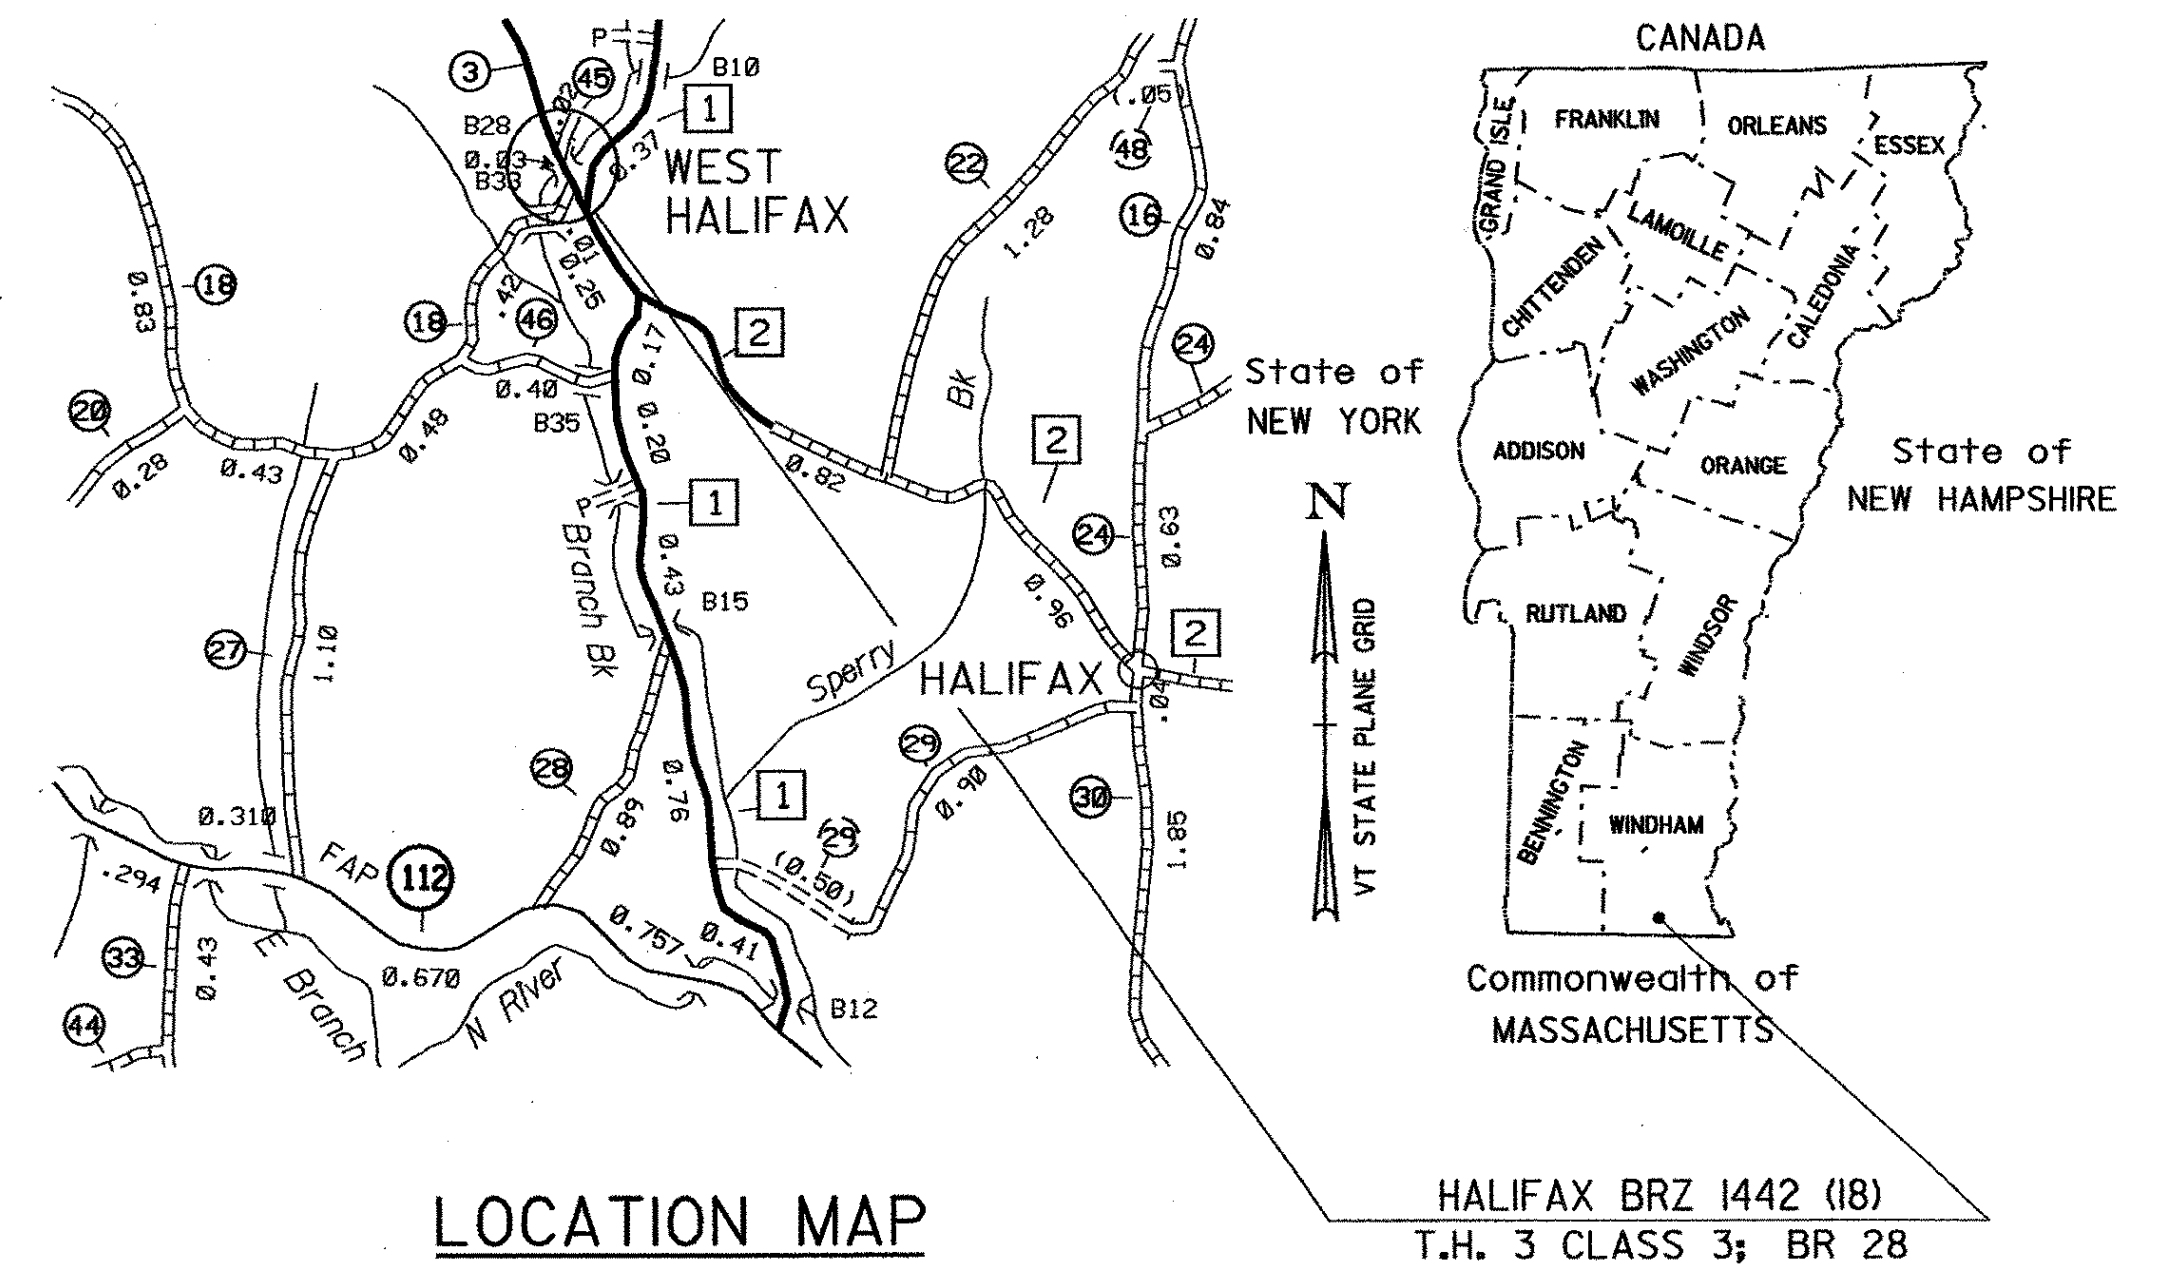

ROUTE NO : T.H. 3 CLASS 3 BRIDGE NO : 28
 PROJECT LOCATION : BEGINNING OF THE INTERSECTION OF T.H. 3 AND T.H. 18 AND EXTENDING NORTHERLY ALONG T.H. 3 FOR 0.066 MILES.
 PROJECT DESCRIPTION : CONSTRUCTION OF A NEW STRUCTURE ALONG WITH RELATED ROADWAY APPROACH AND CHANNEL WORK.
 LENGTH OF STRUCTURE : 34.00 FEET.
 LENGTH OF ROADWAY : 241.00 FEET.
 LENGTH OF PROJECT : 275.00 FEET.

RECORD PLANS


CONTRACTOR: F.W. WHITCOMB CONSTRUCTION - WALPOLE, NH
 RESIDENT ENGINEER: FRED ROSS
 CONSTRUCTION BEGAN: JULY 16, 2002
 CONSTRUCTION COMPLETE: MAY 21, 2003
 RECORD PLANS BY: F. ROSS, K. NORTH

I HEREBY CERTIFY THAT ALL THE CONSTRUCTION REQUIRED BY THIS SET OF DRAWINGS HAS BEEN ACCOMPLISHED AS INDICATED HEREIN.
 BY: *Fred Ross* RESIDENT ENGINEER
 DATE: 2/2/04

NOTE: Any further information concerning final quantities, amounts or other details relative to this project may be found at Central Files in the electronic archives.

CONVENTIONAL SYMBOLS

COUNTY LINE	— — — — —
TOWN LINE	— — — — —
LIMITS OF ACCESS	— — — — —
POINT OF ACCESS	X
FENCE LINE	X — X — X — X —
STONE WALL	— — — — —
TRAVELED WAY	— — — — —
RAILROAD	— — — — —
SURVEY LINE	— — — — —
CULVERT	— — — — —
POWER POLE	⊕
TELEPHONE POLE	⊕
TREES	⊕
CONTROL OF ACCESS	— — — — —
PROPERTY LINE	— — — — —
R.O.W. TAKING LINE	— — — — —
SLOPE RIGHTS	— — — — —
TOP OF CUT	— — — — —
TOE OF SLOPE	— — — — —

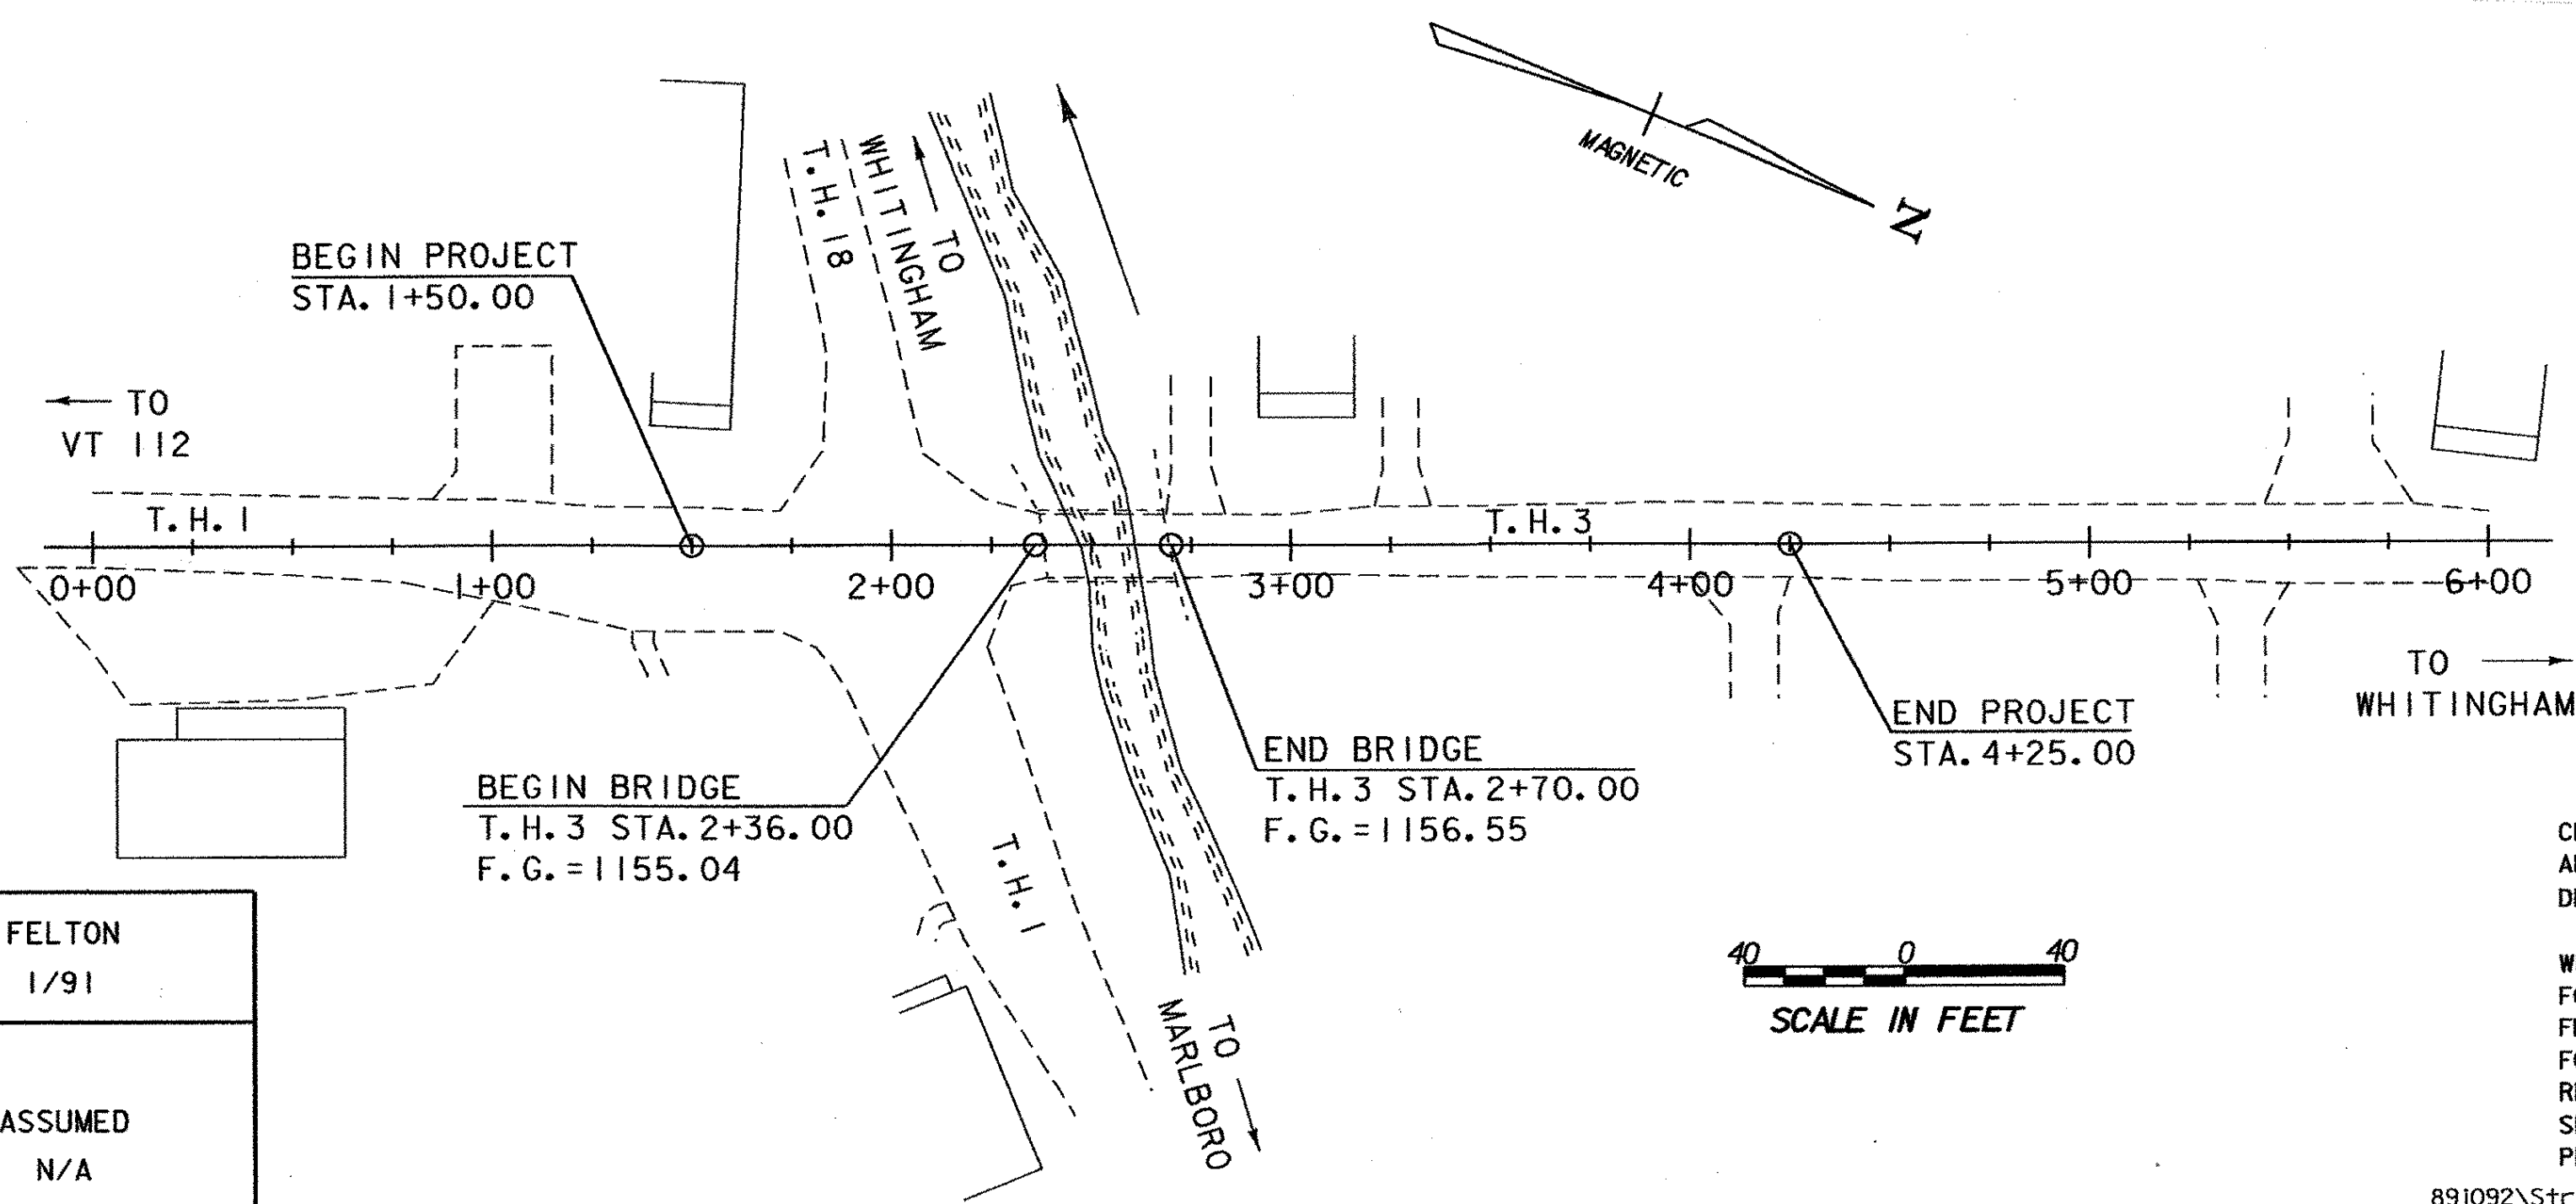

SURVEYED BY : FELTON
 SURVEYED DATE : 1/91
 DATUM
 VERTICAL : ASSUMED
 HORIZONTAL : N/A

THESE PLANS ARE SUBJECT TO SUCH ENGINEERING CHANGES AS MAY BE REQUIRED BY THE FEDERAL HIGHWAY ADMINISTRATION OR THE DIRECTOR OF PROJECT DEVELOPMENT.
 CONSTRUCTION IS TO BE CARRIED ON IN ACCORDANCE WITH THESE PLANS AND THE STANDARD SPECIFICATIONS FOR CONSTRUCTION DATED 1990, AS APPROVED BY THE FEDERAL HIGHWAY ADMINISTRATION ON MARCH 15, 1990 FOR USE ON THIS PROJECT, INCLUDING ALL SUBSEQUENT REVISIONS AND SUCH REVISED SPECIFICATIONS AND SPECIAL PROVISIONS AS ARE INCORPORATED IN THESE PLANS.

DIRECTOR OF PROJECT DEVELOPMENT
 APPROVED: *[Signature]* DATE: 1/2/00
 PROJECT MANAGER : R. R. WHITCOMB
 PROJECT NAME : HALIFAX
 PROJECT NUMBER : BRZ 1442 (18)
 SHEET 1 OF 33 SHEETS