



MAINLINE PROFILE

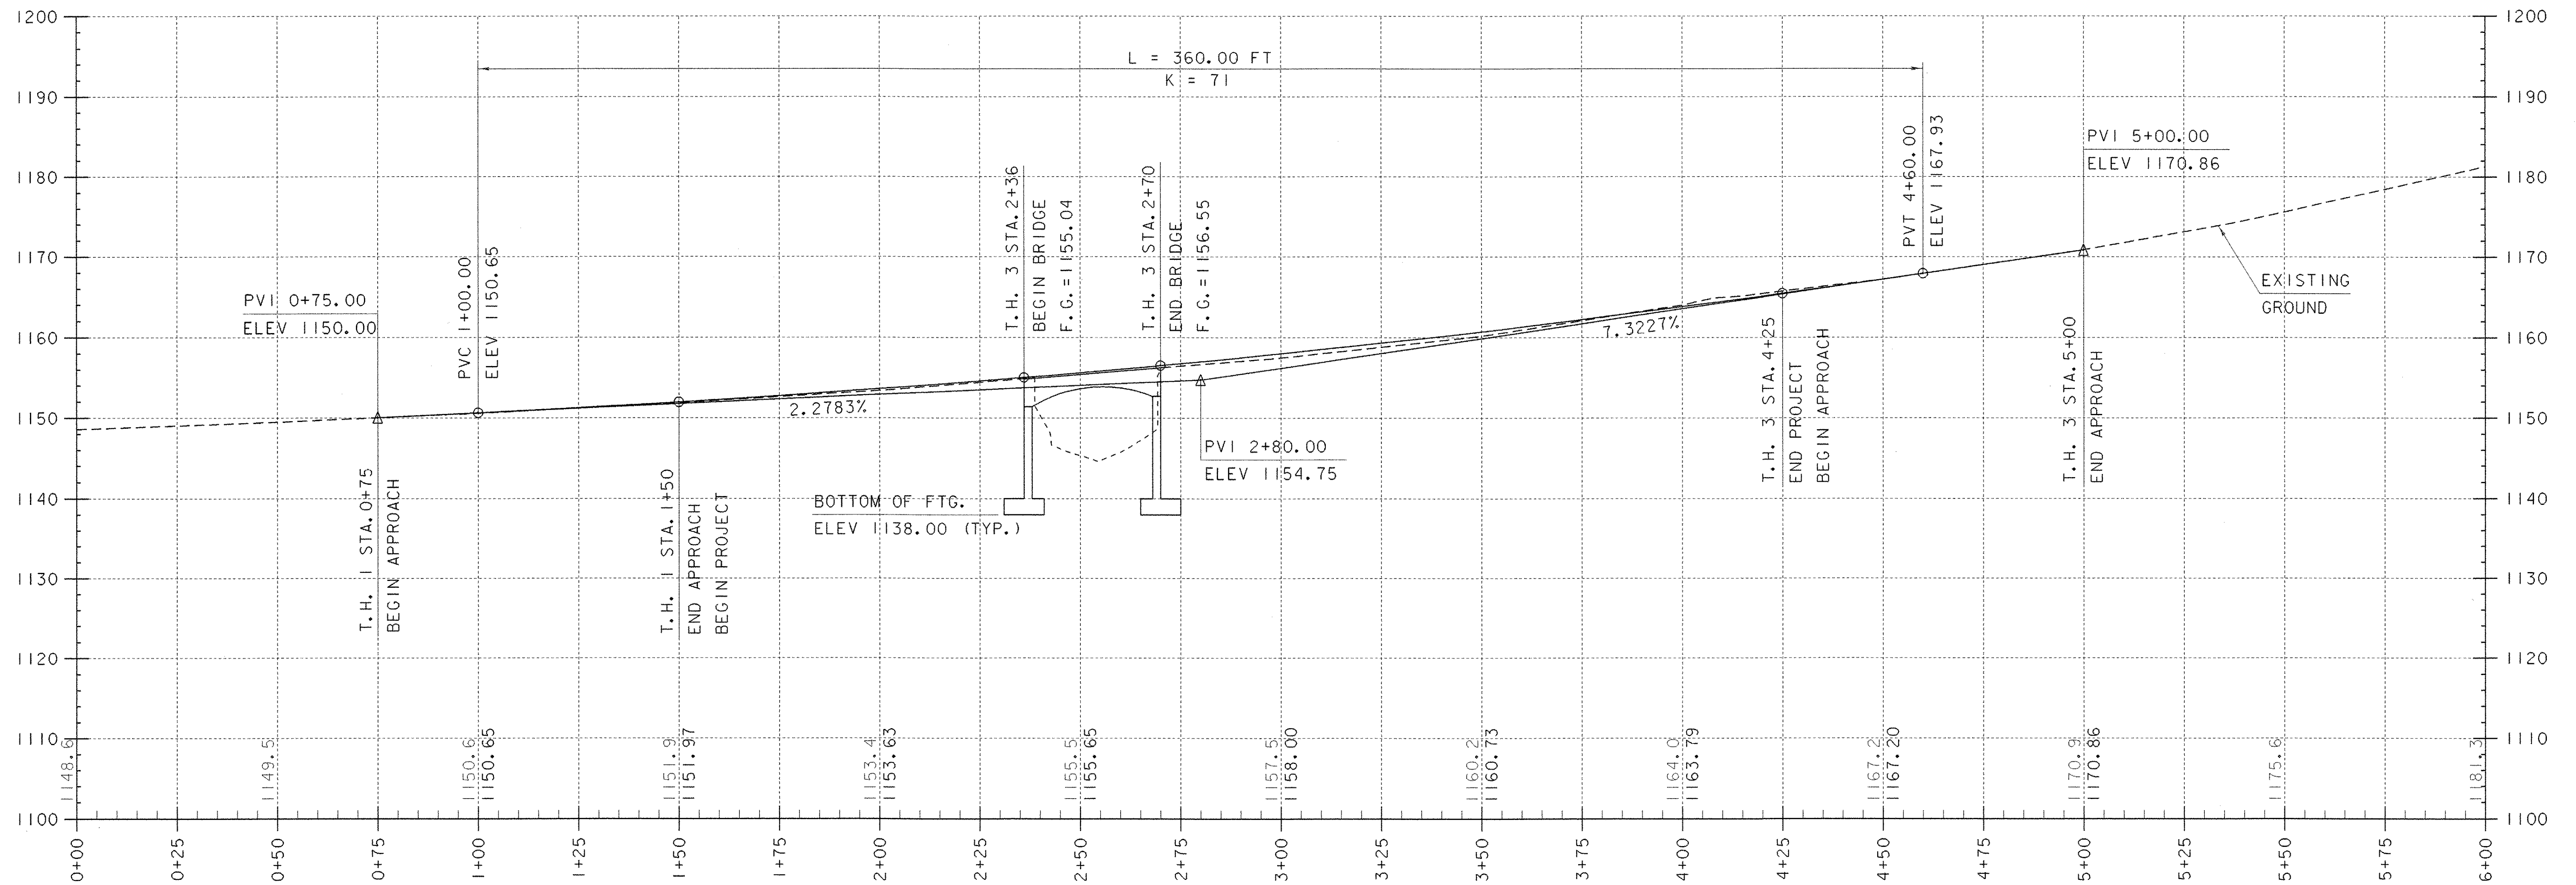

DATUM	
VERTICAL	ASSUMED
HORIZONTAL	N/A

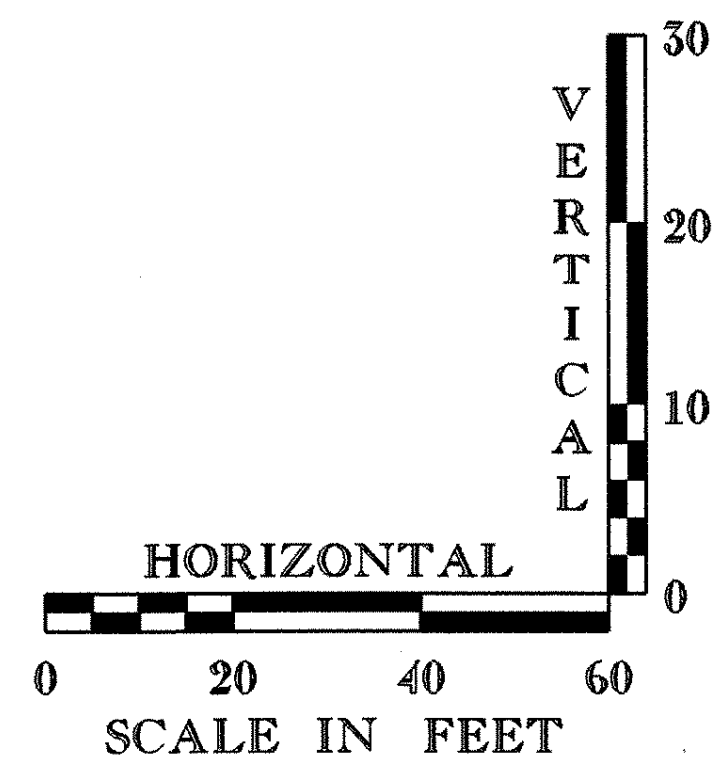

NOTE:
GRADES SHOWN TO THE NEAREST TENTH ARE
EXISTING GROUND ALONG REVISED CENTERLINE.
GRADES SHOWN TO THE NEAREST HUNDREDTH
ARE FINISH GRADE ALONG REVISED CENTERLINE.

PROJECT: HALIFAX	PROJECT NO.: BRZ 1442 (18)
DESIGN FILE NAME: 89j092\structures\sj092xsl.dgn	PLOT DATE: 17-NOV-2000
IPARM FILE NAME: sj092pfil	SURVEY DATE: 1/91
SURVEYED BY: FELTON	DRAWN BY: G. ROY
PROJECT MANAGER: R.R. WHITCOMB	SHEET: 10 OF 33
MAINLINE PROFILE SHEET	