

WOOD MARKER POST
ML 3+92 +/- RT.(4)
ML 4+24 +/- LT.(4)

WOOD MARKER POSTS
ML 3+92 +/- RT. (4)
ML 4+24 +/- LT. (4)

- LEGEND**
- FILTER CURTAIN
 - SILT FENCE
 - HAY BALES
 - DITCH W/ CHECK DAMS

BEGIN PROJECT
REV. S.L. STA. 18+50.00

BEGIN PROJECT
STA. 1+50.00

BEGIN BRIDGE
T.H.3 STA. 2+36.00
F.G.= #155.04

END BRIDGE
T.H.3 STA. 2+70.00
F.G.= #156.55

END PROJECT
STA. 4+25.00


END PROJECT
REV. S.L. STA. 19+50.12

NOTES:

1. AN ALTERNATE TEMPORARY CONTROL PLAN MAY BE SUBMITTED BY THE CONTRACTOR FOR APPROVAL BY THE RESIDENT ENGINEER.
2. SPECIAL CONSIDERATION MUST BE GIVEN TO THE FIRST PUMP-DOWN OF THE COFFERDAMS. THIS WILL CONTAIN THE GREATEST VOLUME OF WATER WITH A HIGH SEDIMENT LOAD. THE CONTRACTOR MAY PROVIDE ADDITIONAL SEDIMENT TRAPS WITHIN THE RIGHT-OF-WAY IF REQUIRED OR CONTROL THE RATE OF DRAW-DOWN. ADDITIONAL SEDIMENT TRAPS MUST BE APPROVED BY THE RESIDENT ENGINEER.
3. AFTER COMPLETION OF THE SUBSTRUCTURE, THE SEDIMENT IN THE TRAPS SHALL BE REMOVED AND THE GROUND RESTORED TO ITS ORIGINAL SLOPES OR GRADED AS SHOWN ON THE CONSTRUCTION DRAWINGS.
4. THE CONTRACTOR WILL USE OTHER TEMPORARY OR PERMANENT EROSION CONTROL MEASURES AS NECESSITATED BY THE SEQUENCE OF CONSTRUCTION AND AS DIRECTED BY THE RESIDENT ENGINEER. SEE SECTION 105.23 OF THE VERMONT AOT STANDARD SPECIFICATIONS FOR CONSTRUCTION DATED 1990.

DATUM

VERTICAL	ASSUMED
HORIZONTAL	N/A

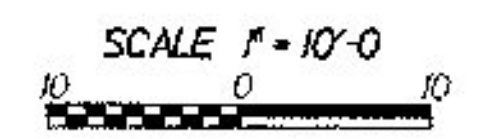

**SEEDING FORMULA
RURAL AREAS**

% WT.	LBS./A.	NAME	PUR %	GERM %
37.5	22.5	CREeping RED FESCUE	98	85
37.5	22.5	TALL FESCUE	95	90
5.0	3.0	RED TOP	95	90
15.0	9.0	BIRDSFOOT TREFOL	98	85
5.0	3.0	ANNUAL RYEGRASS	95	85
100.0	60.0			

GENERAL NOTES

- SEED MIXTURE: SHALL NOT HAVE A WEED CONTENT EXCEEDING 0.40% BY WEIGHT AND SHALL BE FREE OF ALL NOXIOUS SEED.
- SEED: TO BE APPLIED PER SEEDING FORMULAS OR AS DIRECTED BY THE ENGINEER.
- FERTILIZER: FORMULA 10-20-10, TO BE USED WITH SEED, APPLIED AT THE RATE OF 500 LBS./ACRE. (HYDRO SEEDERS MAY USE 19-19-19 FORMULA).
- AGRICULTURAL LIMESTONE: TO BE APPLIED AT THE RATE OF 2 TONS/ACRE, OR AS DIRECTED BY THE ENGINEER.
- HAY MULCH: TO BE PLACED ON EARTH SLOPES AT THE RATE OF 2 TONS/ACRE, OR AS DIRECTED BY THE ENGINEER.
- TOPSOIL: TO BE USED WITH SEED AS INDICATED ON THE PLANS, OR AS DIRECTED BY THE ENGINEER.

PROJECT: HALIFAX	PROJECT NO.: BRZ 1442 (18)
DESIGN FILE NAME: 89j092\structures\sj092ero.dgn	PLOT DATE: 17-NOV-2000
IPARM FILE NAME: sj092ero.1	SURVEY DATE: 1/91
SURVEYED BY: FELTON	DRAWN BY: J. ARMSTRONG
PROJECT MANAGER: R. R. WHITCOMB	SHEET: 16 OF 33
EROSION CONTROL SHEET	