


* 1/2" TYPE IV OVER
1/4" TYPE IV

BRIDGE TYPICAL SECTION


SCALE: 3/8" = 1'-0"
(SECTION IS PERPENDICULAR TO C OF TH3)

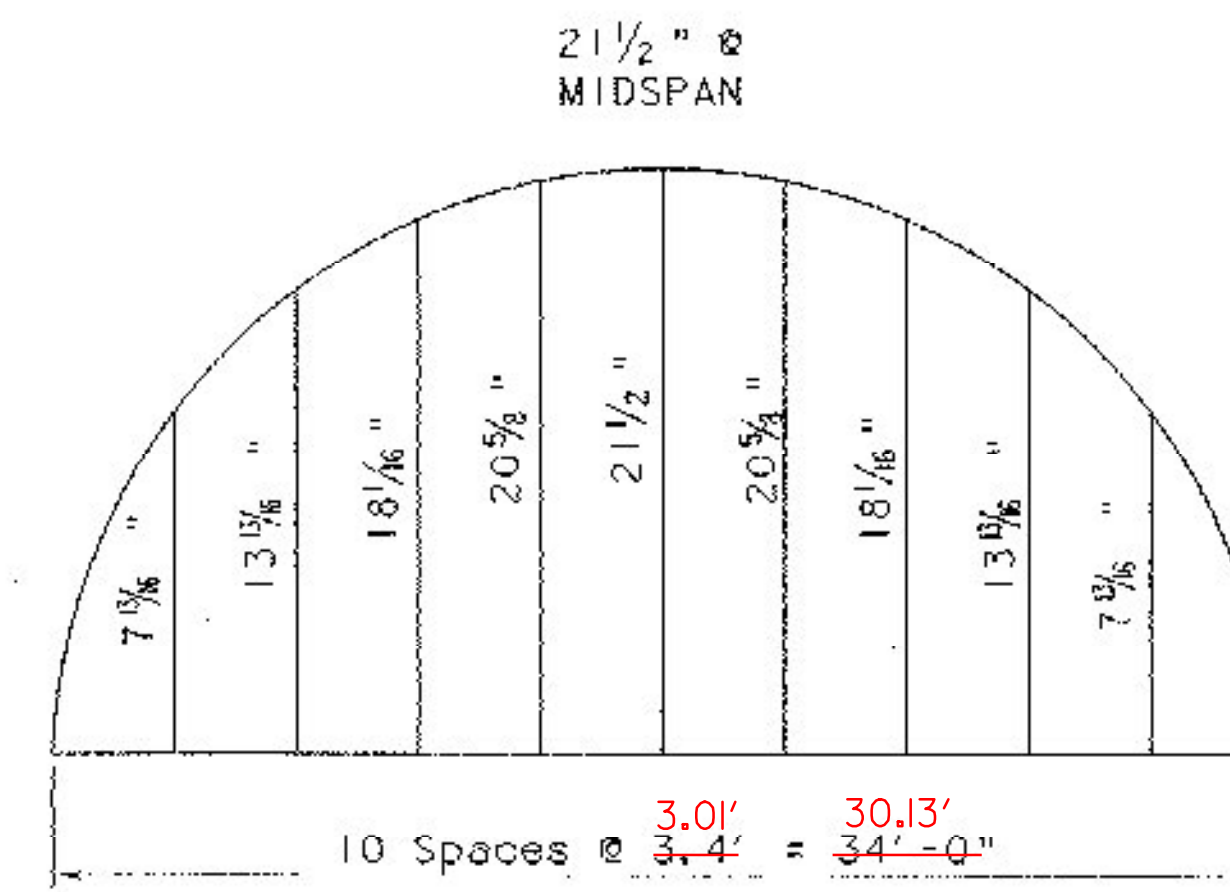

SET CONSTRUCTION FORMS TO THIS CIRCULAR CURVE CAMBER.
CAMBER IS PERPENDICULAR TO ABUTMENTS.
1/2" ADDED FOR IMMEDIATE AND FORM DEFLECTION

CAMBER DIAGRAM

NTS

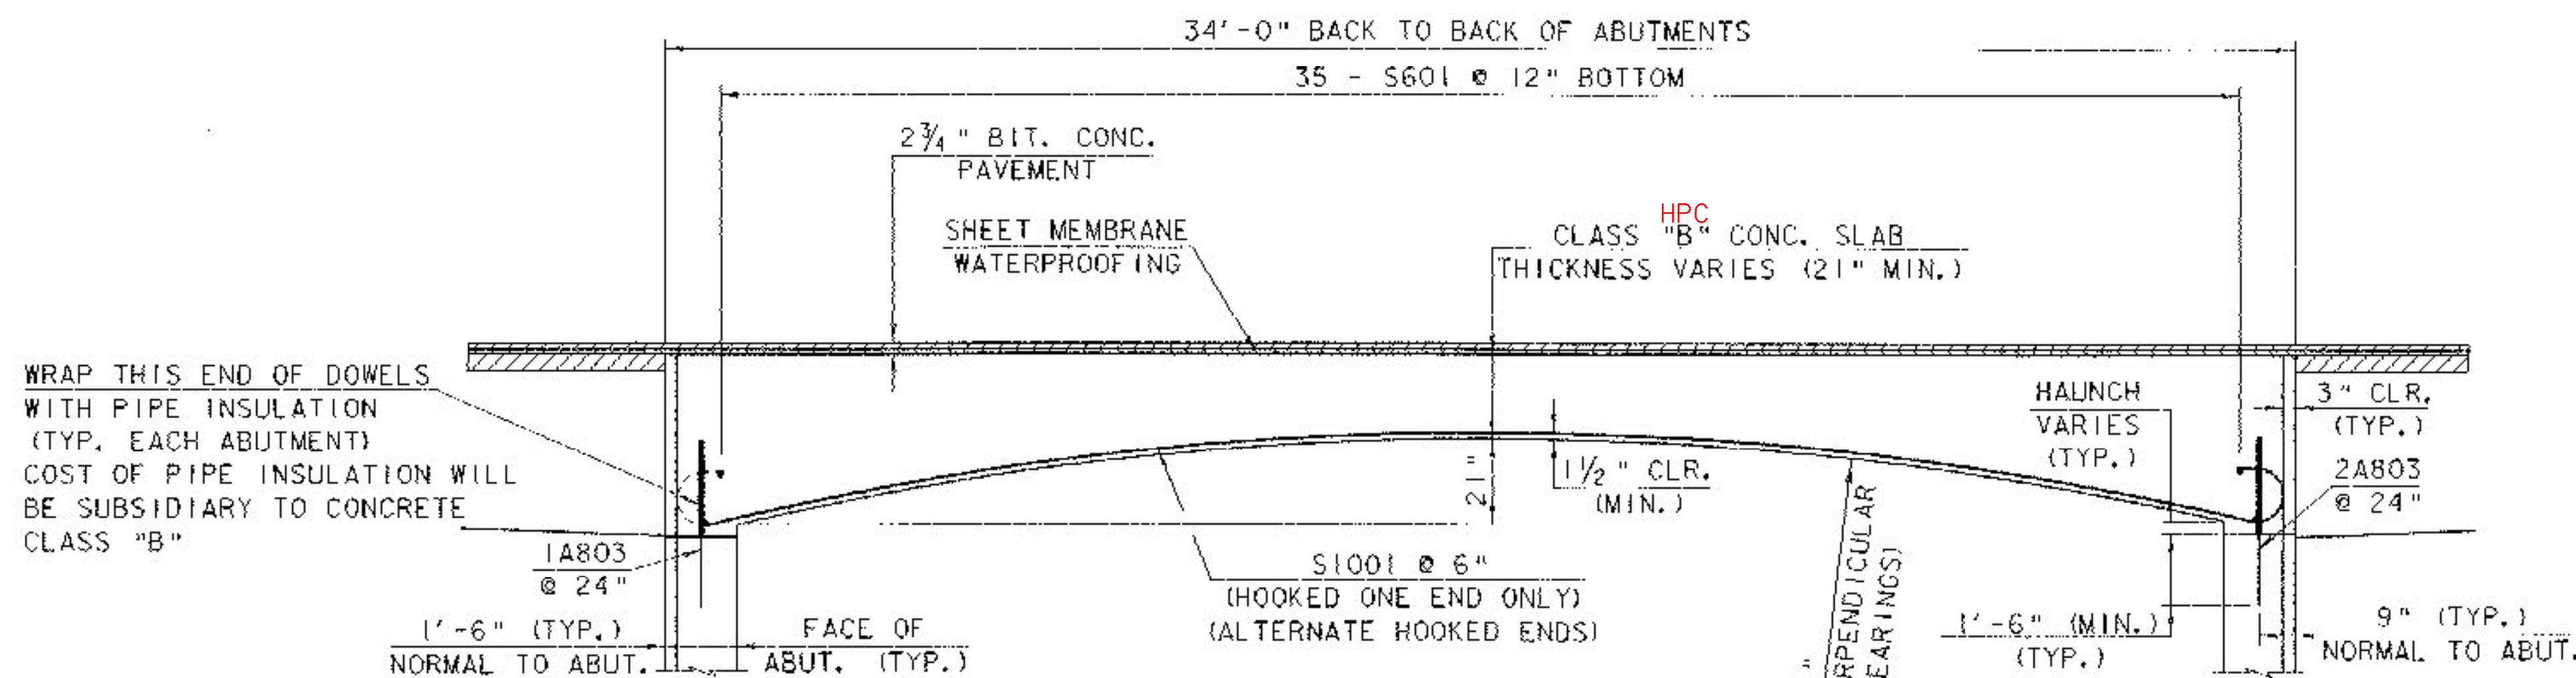

ELEVATION ALONG C OF ROADWAY

SCALE: 3/8" = 1'-0"

R = 65'-8 3/8"
(RADIUS OF ARCH IS PERPENDICULAR
TO CENTERLINE OF BEARINGS)

**STATE OF VERMONT
AGENCY OF TRANSPORTATION**

Town Of	HALIFAX	Bridge No.	28
Highway No.	T.H. 3	Log. Sta.	
		Surv. Sta.	2+53
T.H. 3 OVER THE BRANCH BROOK			
SLAB TYPICAL SECTIONS			
Designed By	T.A. SUMNER	Drawn By	K. CHISHOLM
Checked By	T.A. SUMNER	Date	8/00
		Project Manager	R.R. WHITCOMB Date 8/00
PROJECT	HALIFAX	PROJECT NO.	BRZ 1442 (18)
I.C.C. Info. 89\092\structures\sj092s1b.dgn		sj092typ2.i	
Bridge Sheet No.		Sheet	18 of 33