


ABUTMENT NO. 2 PLAN

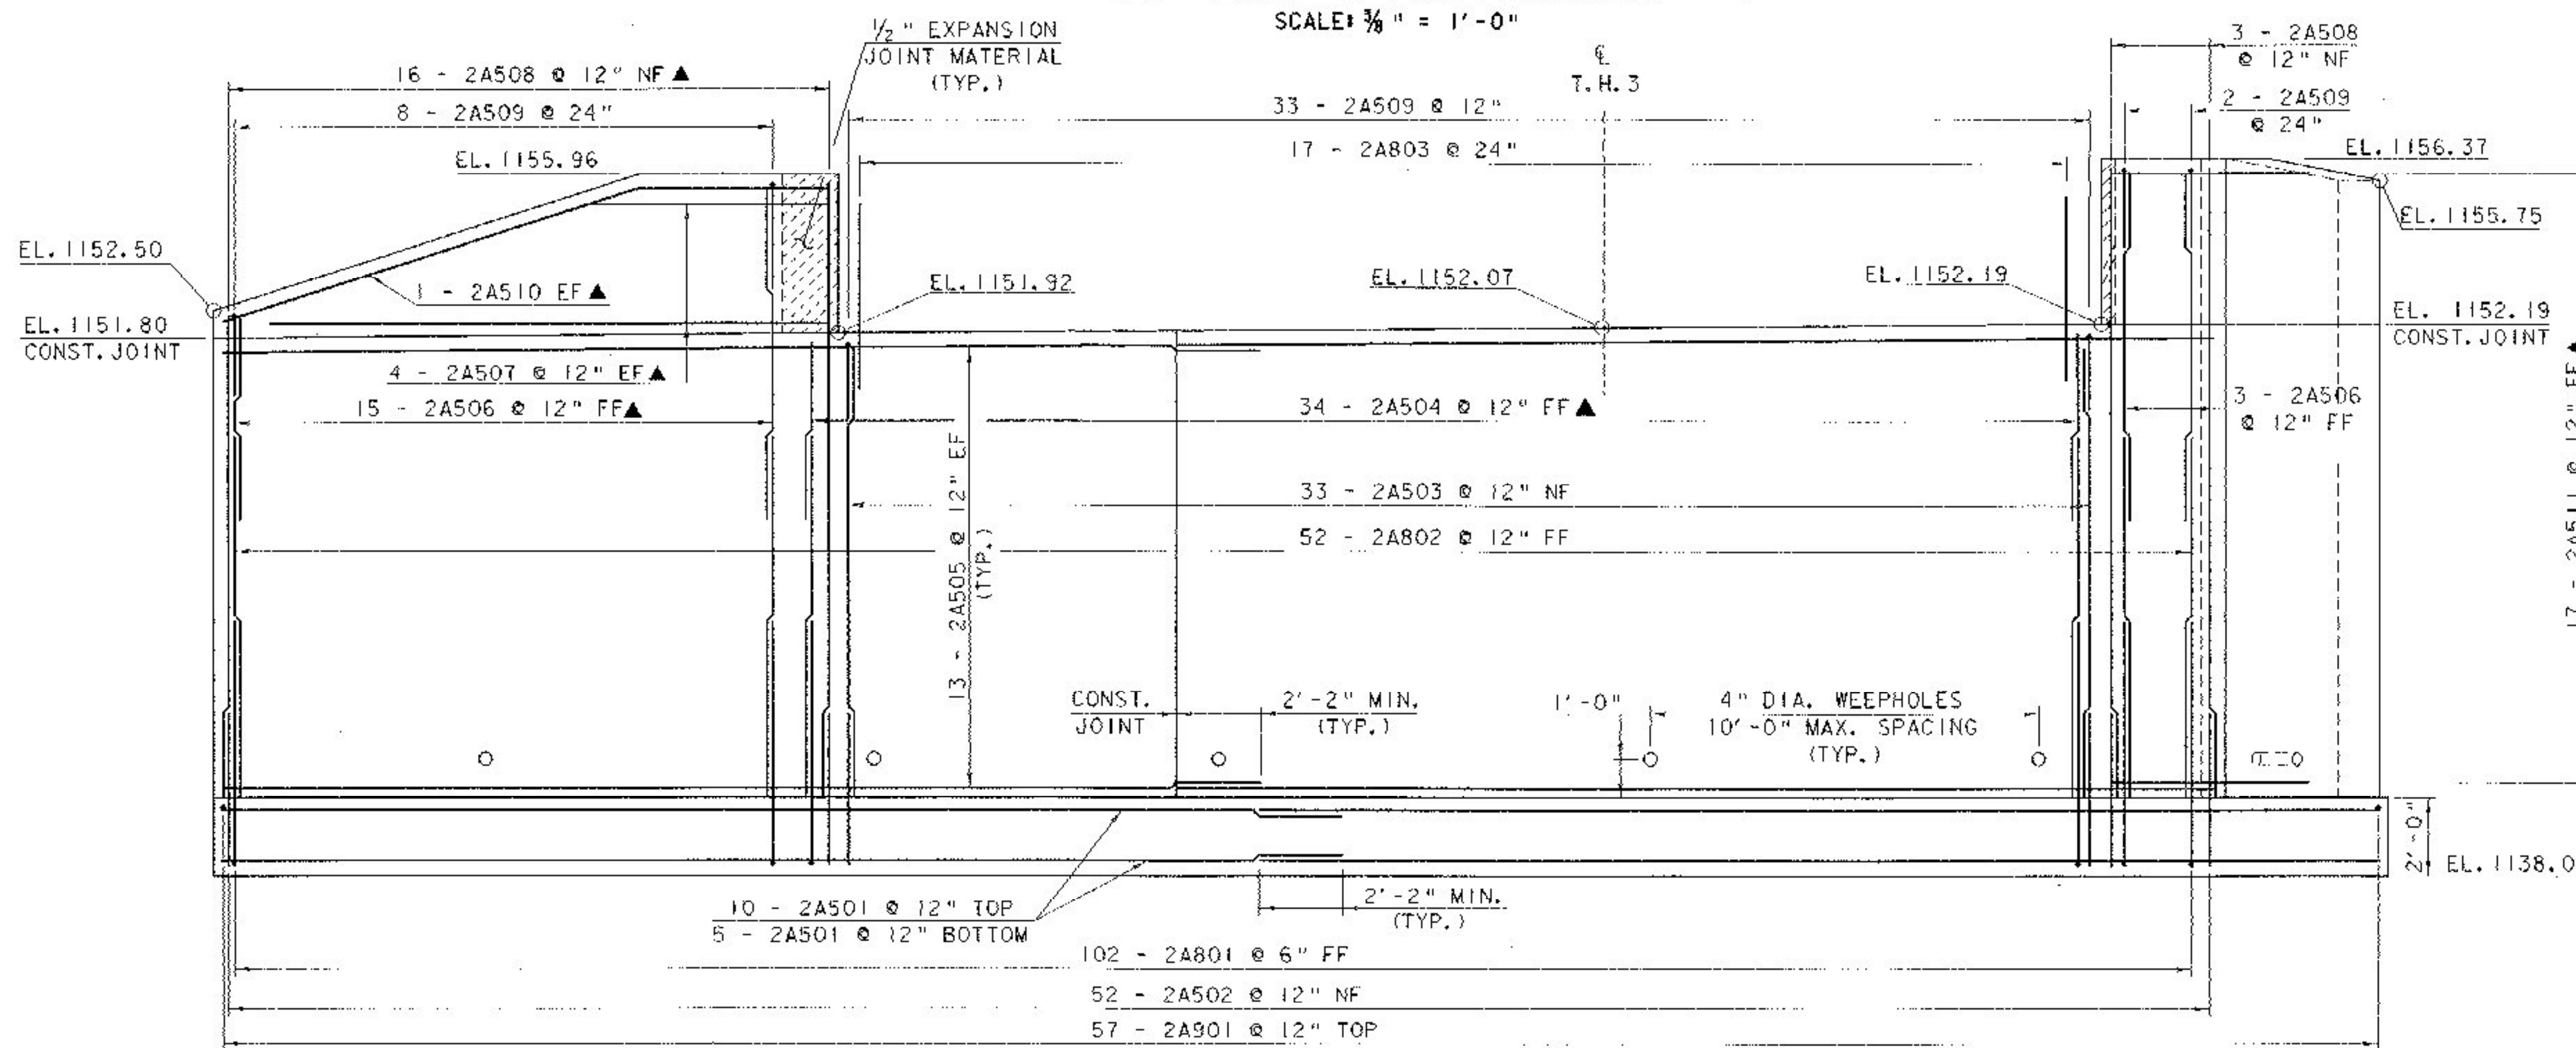

ABUTMENT NO. 2 ELEVATION

NOTE:

- NF = NEAR FACE
- FF = FAR FACE
- EF = EACH FACE
- ▲ = CUT TO FIT IN FIELD
- 3" CLR. UNLESS OTHERWISE SPECIFIED ON THE PLANS.

**STATE OF VERMONT
AGENCY OF TRANSPORTATION**

| | | | |
|--------------------------------------|-----------|-----------------|---------------|
| Town Of | HALIFAX | Bridge No. | 28 |
| Highway No. | T.H. 3 | Log Sta. | |
| | | Surv. Sta. | |
| T.H. 3 OVER THE BRANCH BROOK | | | |
| ABUTMENT NO. 2 DETAILS | | | |
| Designed By | T. SUMNER | Drawn By | K. CHISHOLM |
| Checked By | Date | Project Manager | |
| T. SUMNER | 8/00 | R. R. WHITCOMB | Date 8/00 |
| PROJECT | HALIFAX | PROJECT NO. | BRZ 1442 (18) |
| LG.C. Info. /str3/89/092/s/092ab.dgn | | s/092ab2.i | |
| Bridge Sheet No. | | Sheet | 21 of 33 |