


TRANSITION OF SUBBASE DEPTH  
 SCALE: VERT. 1" = 1'-0"  
 HOR. 1" = 15'-0"

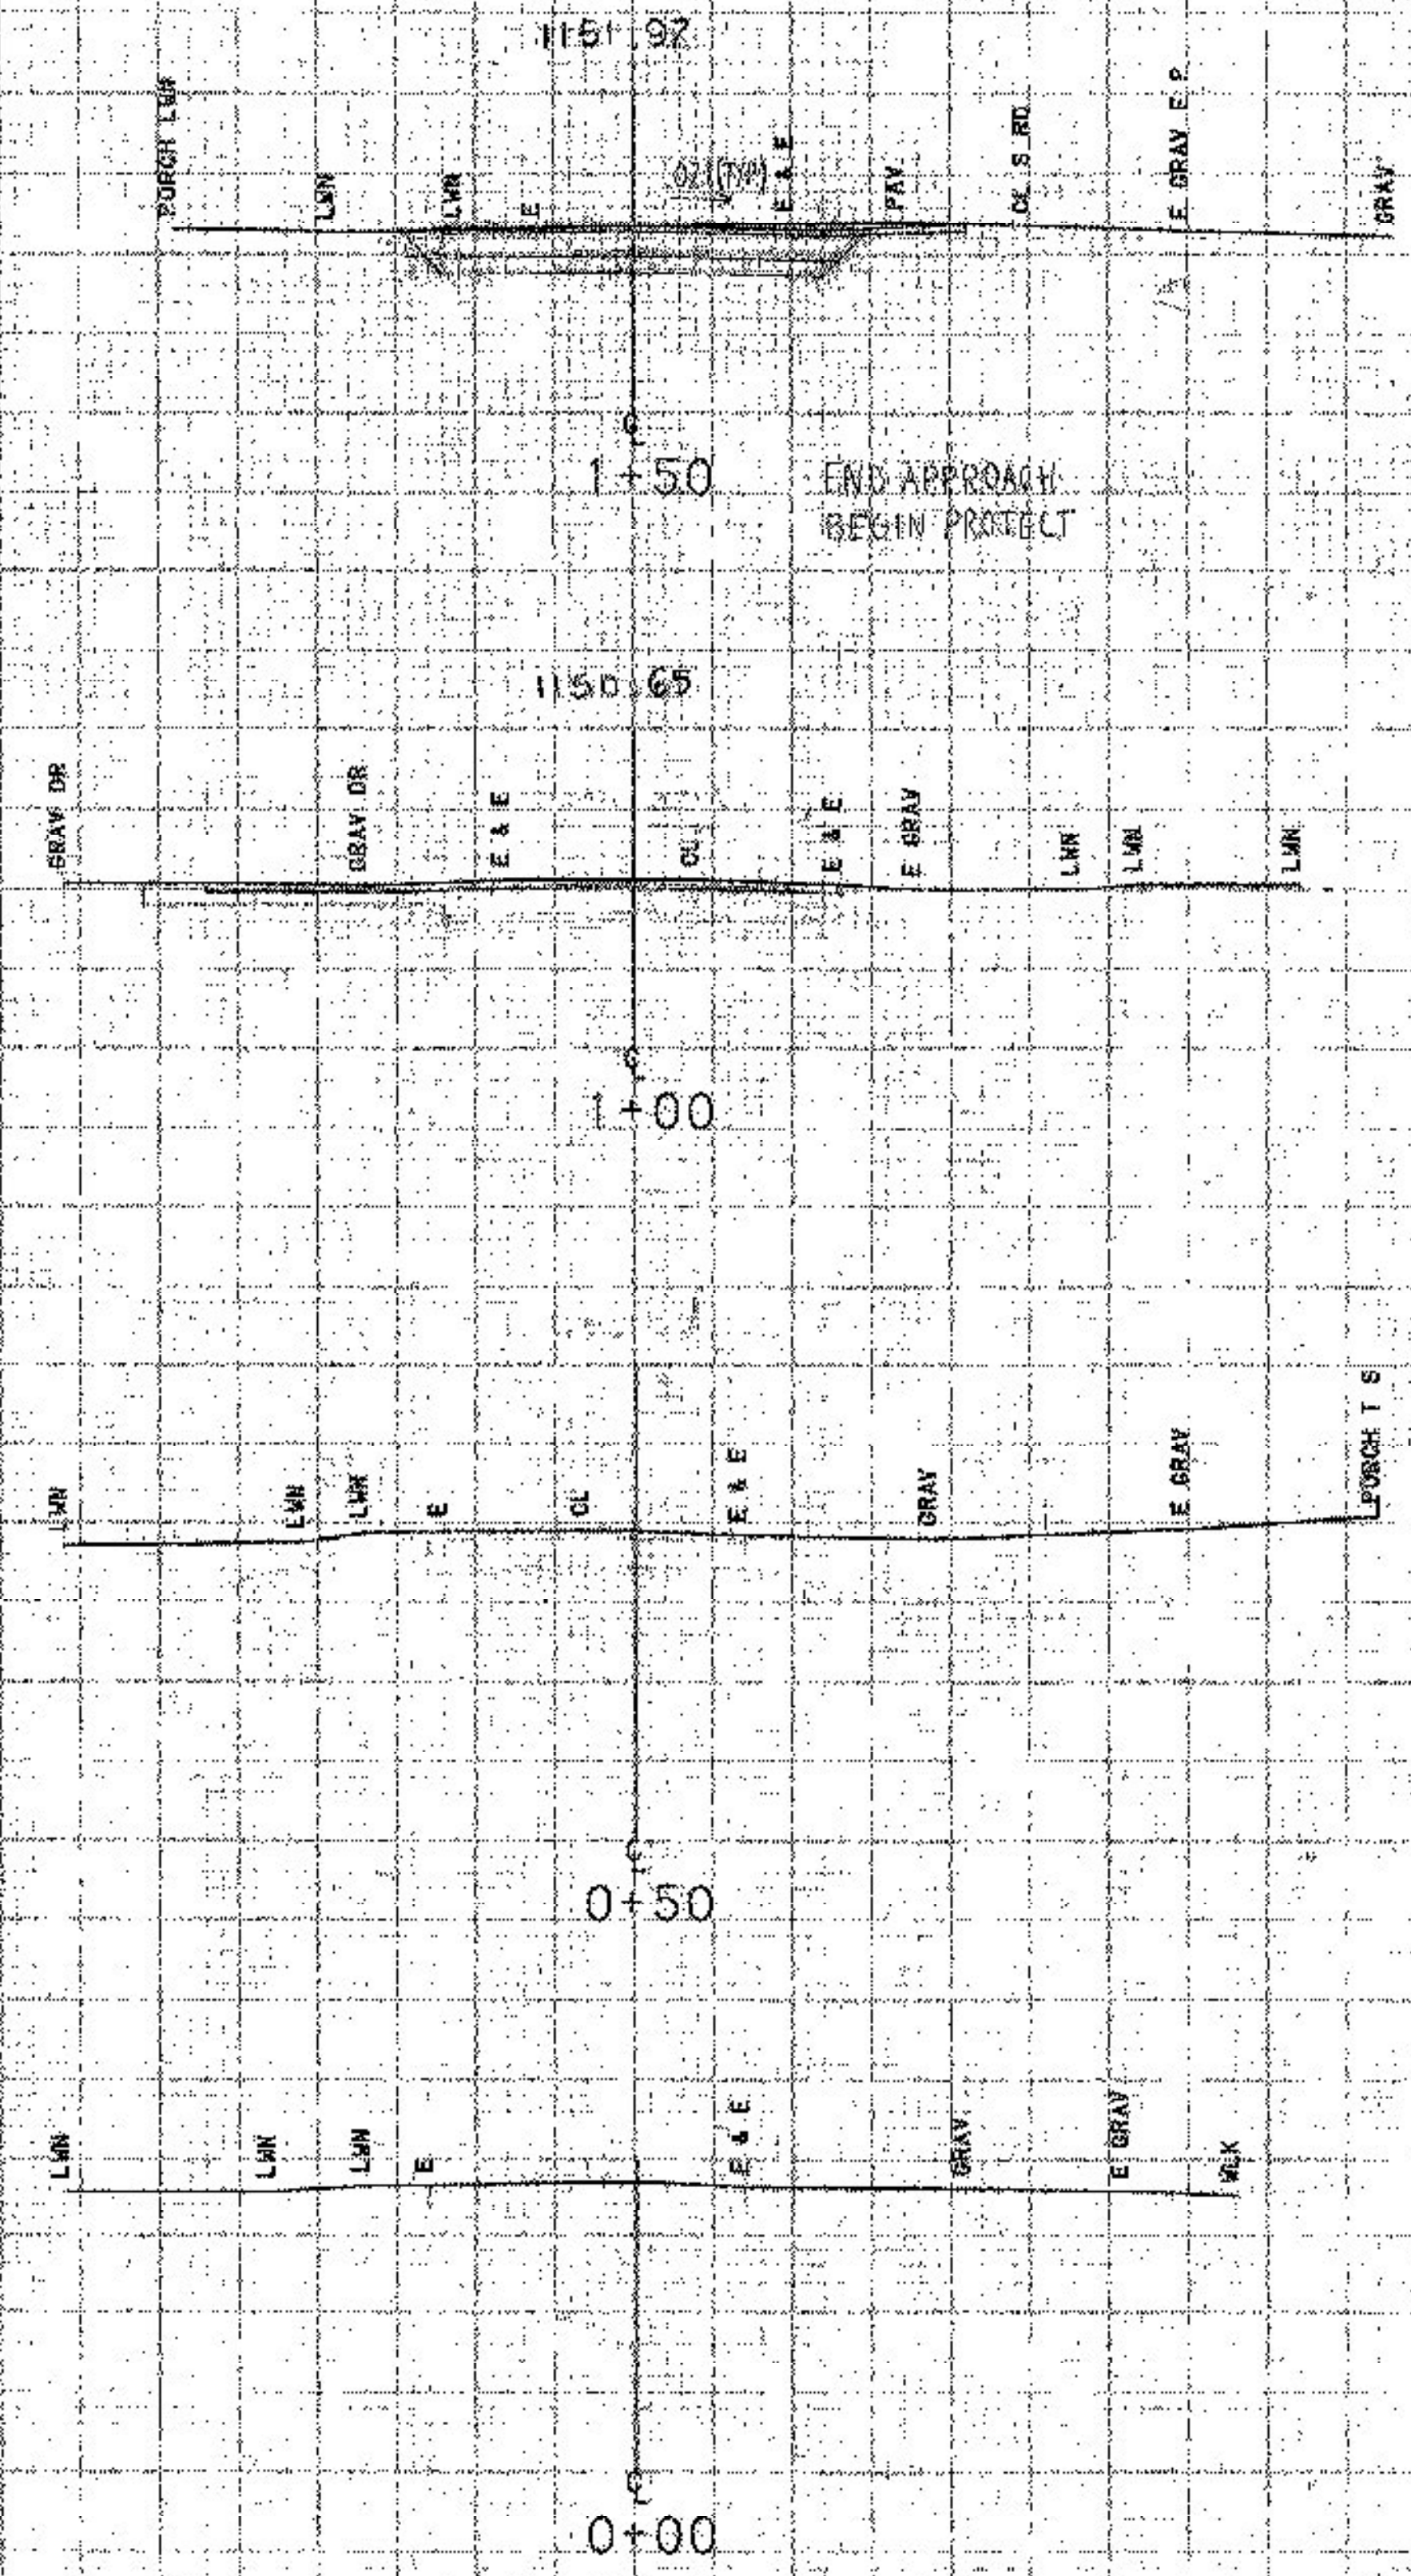

STA. 0+75 MATCH EXISTING  
 BEGIN APPROACH

FROM STA. 0+00 TO STA. 1+50  
 PROJECT NAME HALIFAX MAIN  
 NO. BR21442 (18) PLOTTED 04/24/91  
 SURVEYED BY FELTON 01/93 0340  
 SHEET 2 OF 3 SHEETS

SCALE 1" = 10 FEET