

END APPROACH
5+00
4+75

4+50

4+50

END PROJECT
1+2500

4+00

BITUM CONCRETE PAVEMENT TYPE III

25' COLD PLANING AREA

BITUM CONCRETE PAVEMENT TYPE I


MATCH EXISTING

SUBBASE OF GRANVEL

SAND BORDER

TRANSITION OF SUBBASE DEPTH TH. 3

SCALE: VEG. 1" = 1'-0"
HOR. 1" = 40'-0"

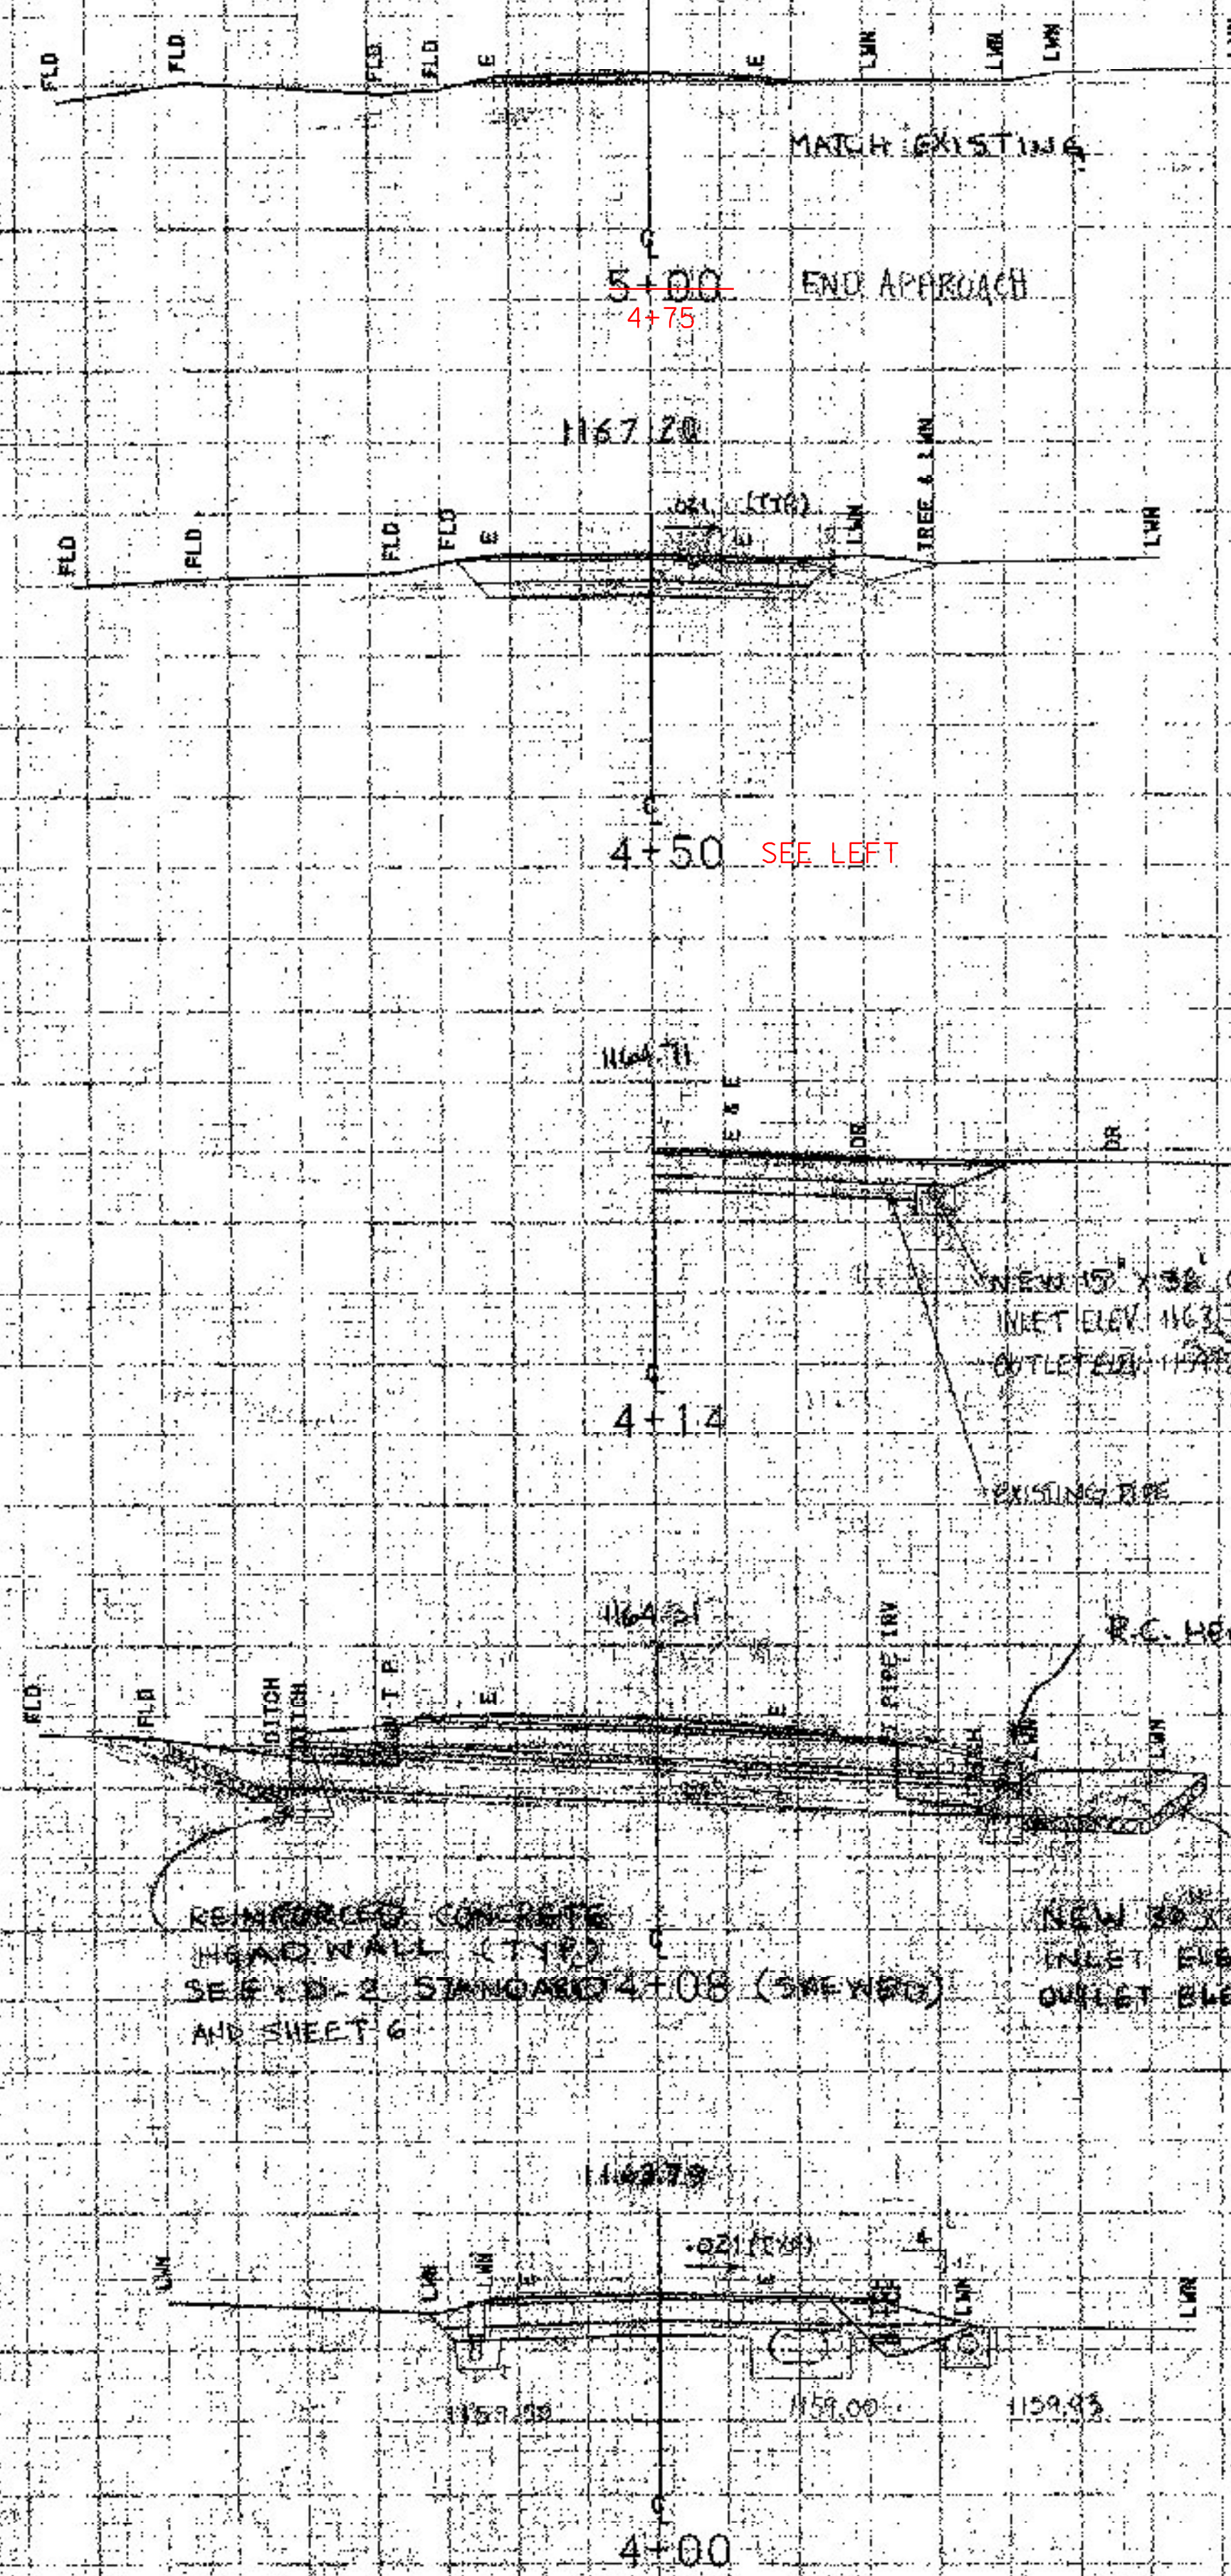

STA. 4+25 END PROJECT
BEGIN APPROACH

FROM STA. 4+00 TO STA. 5+00
 PROJECT NAME HALIFAX MAIN
 NO. BRZ1412 (18) PLOTTED 04/24/94
 SURVEYED BY FELTON 01/25/93
 SHEET 23 OF 23 SHEETS

SCALE 10 FEET