



1180

6+00

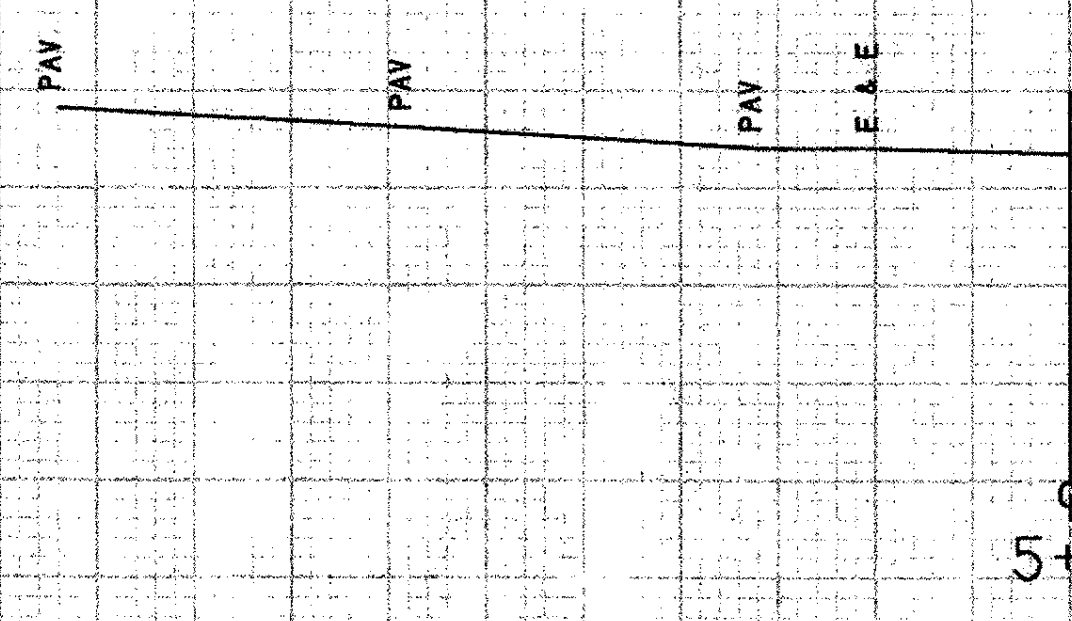


1170

5+60

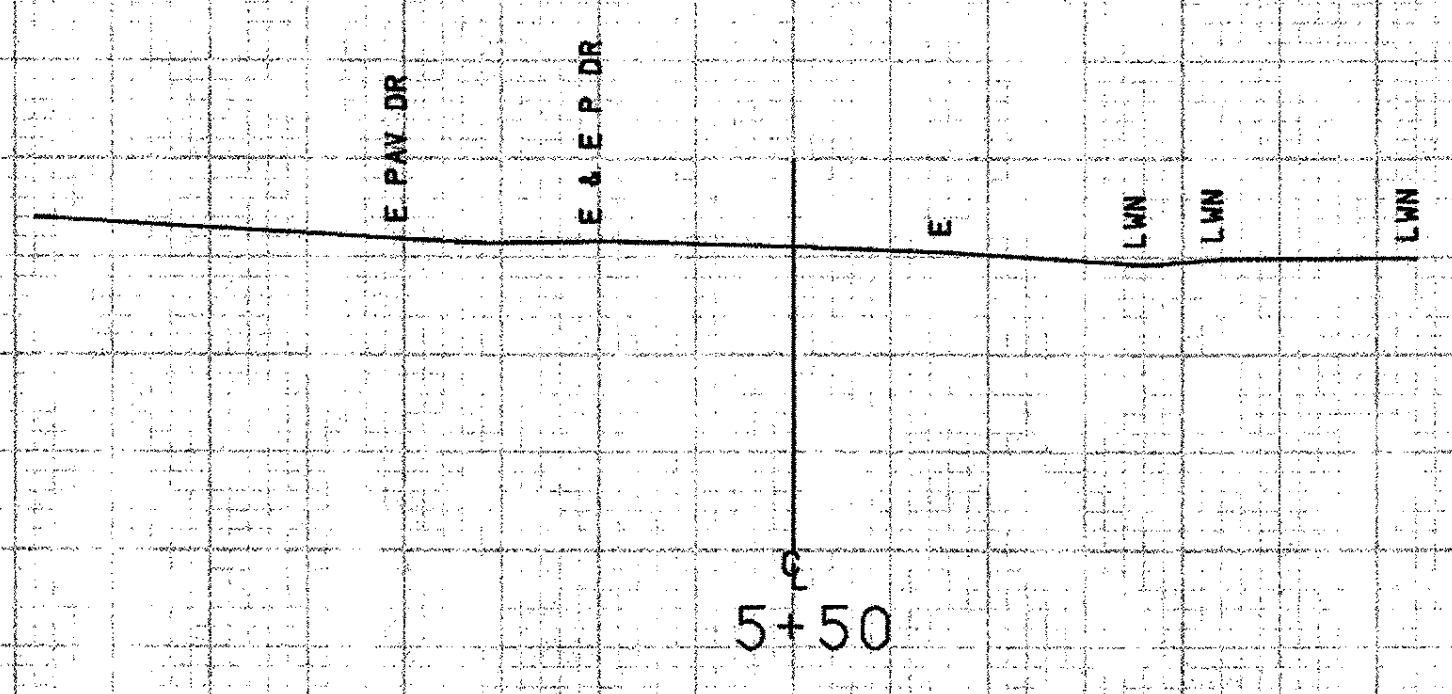

1170

5+50

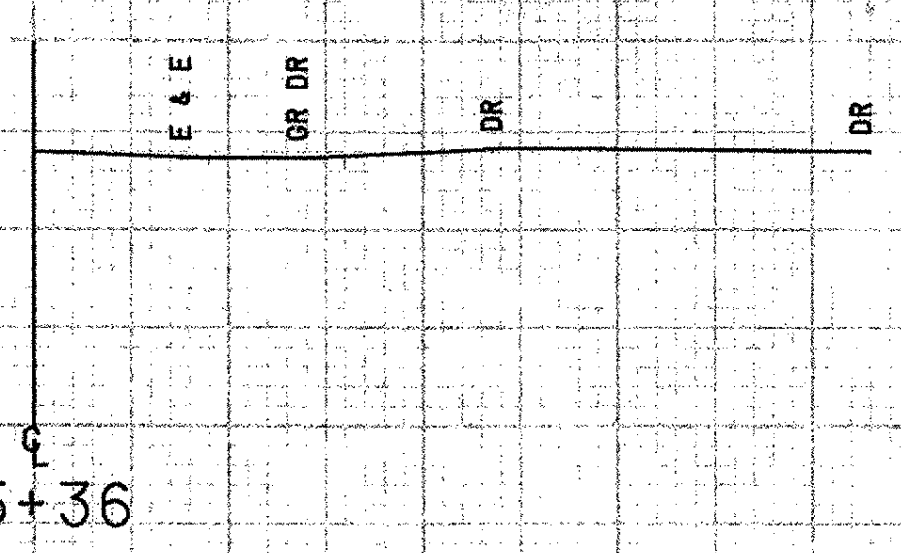

1170

5+36

FROM STA.	5+36	TO STA.	6+00
PROJECT NAME	HALIFAX MAIN		
NO.	BR21442 (18)	PLOTTED	04/24/91
SURVEYED BY	FELTON		01/91 0340
SHEET	29	OF	33 SHEETS

SCALE 1" = 10 FEET