



1150

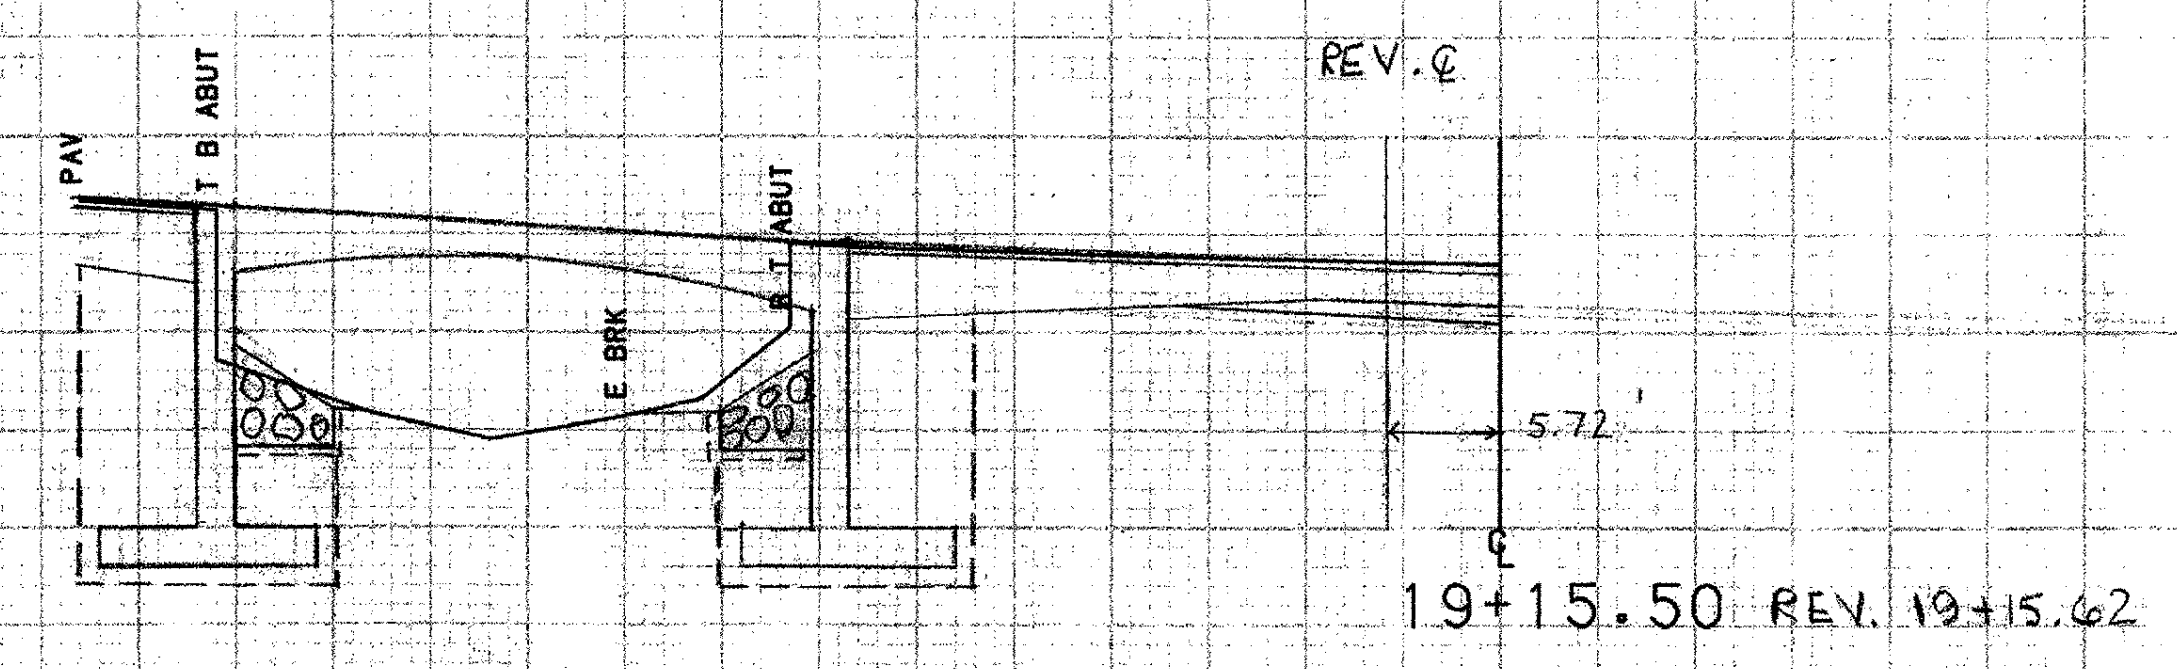


1150

* NOTE :
NO GRUBBING MATERIAL
UNDER BRIDGE

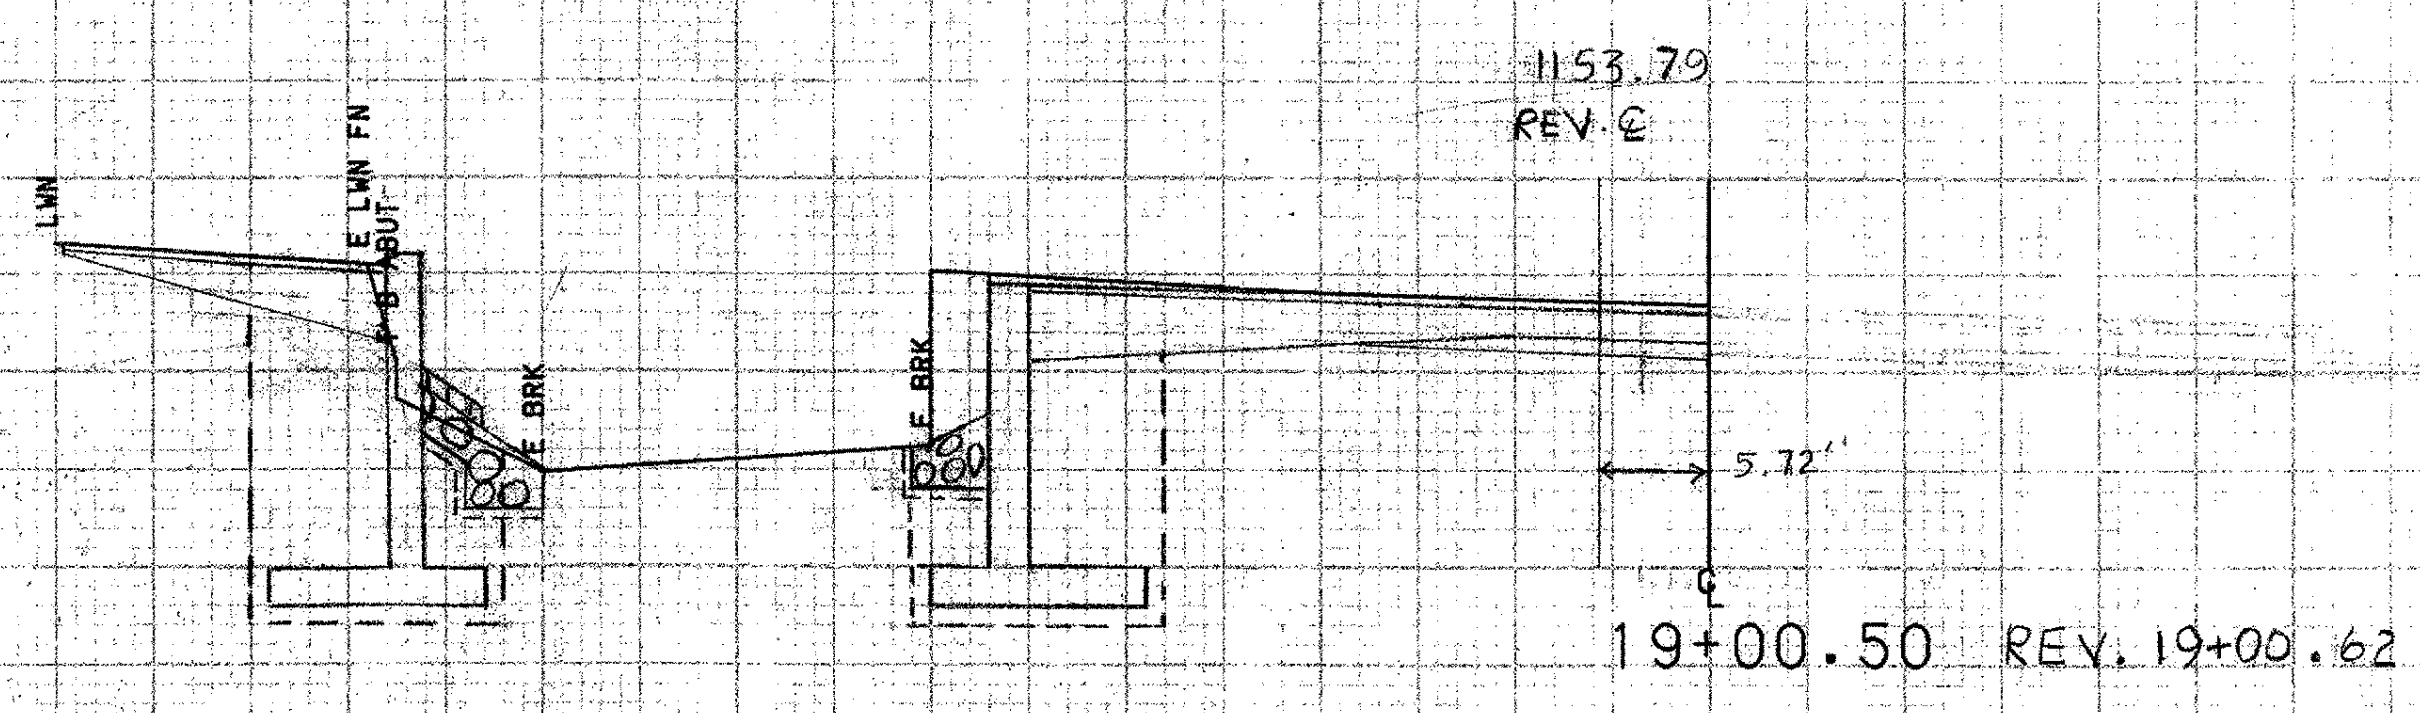


1150

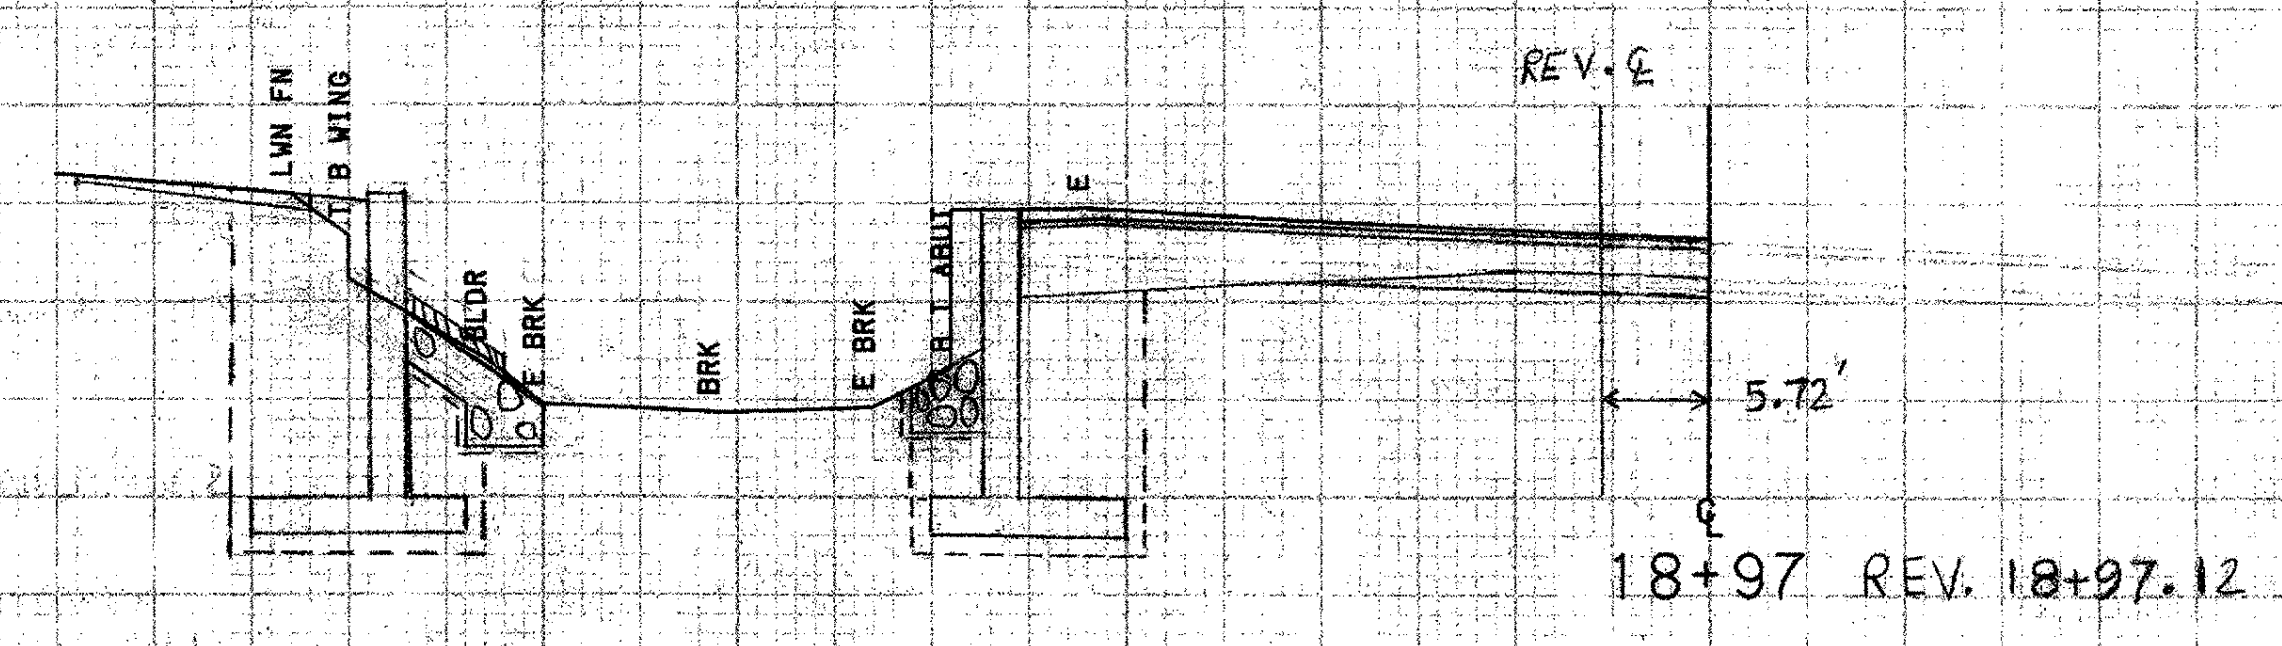

1150

SIDELINE STA. 18+82.5, ABUT. NO. 2
BEGIN UNCLASSIFIED CHAN. EXCAVATION
GEOTEXTILE UNDER STONE FILL
STONE FILL, TYPE II
GRUBBING MATERIAL

SIDELINE STA. 18+80, ABUT. NO. 1
BEGIN UNCLASSIFIED CHAN. EXCAVATION
GEOTEXTILE UNDER STONE FILL
STONE FILL, TYPE II
GRUBBING MATERIAL

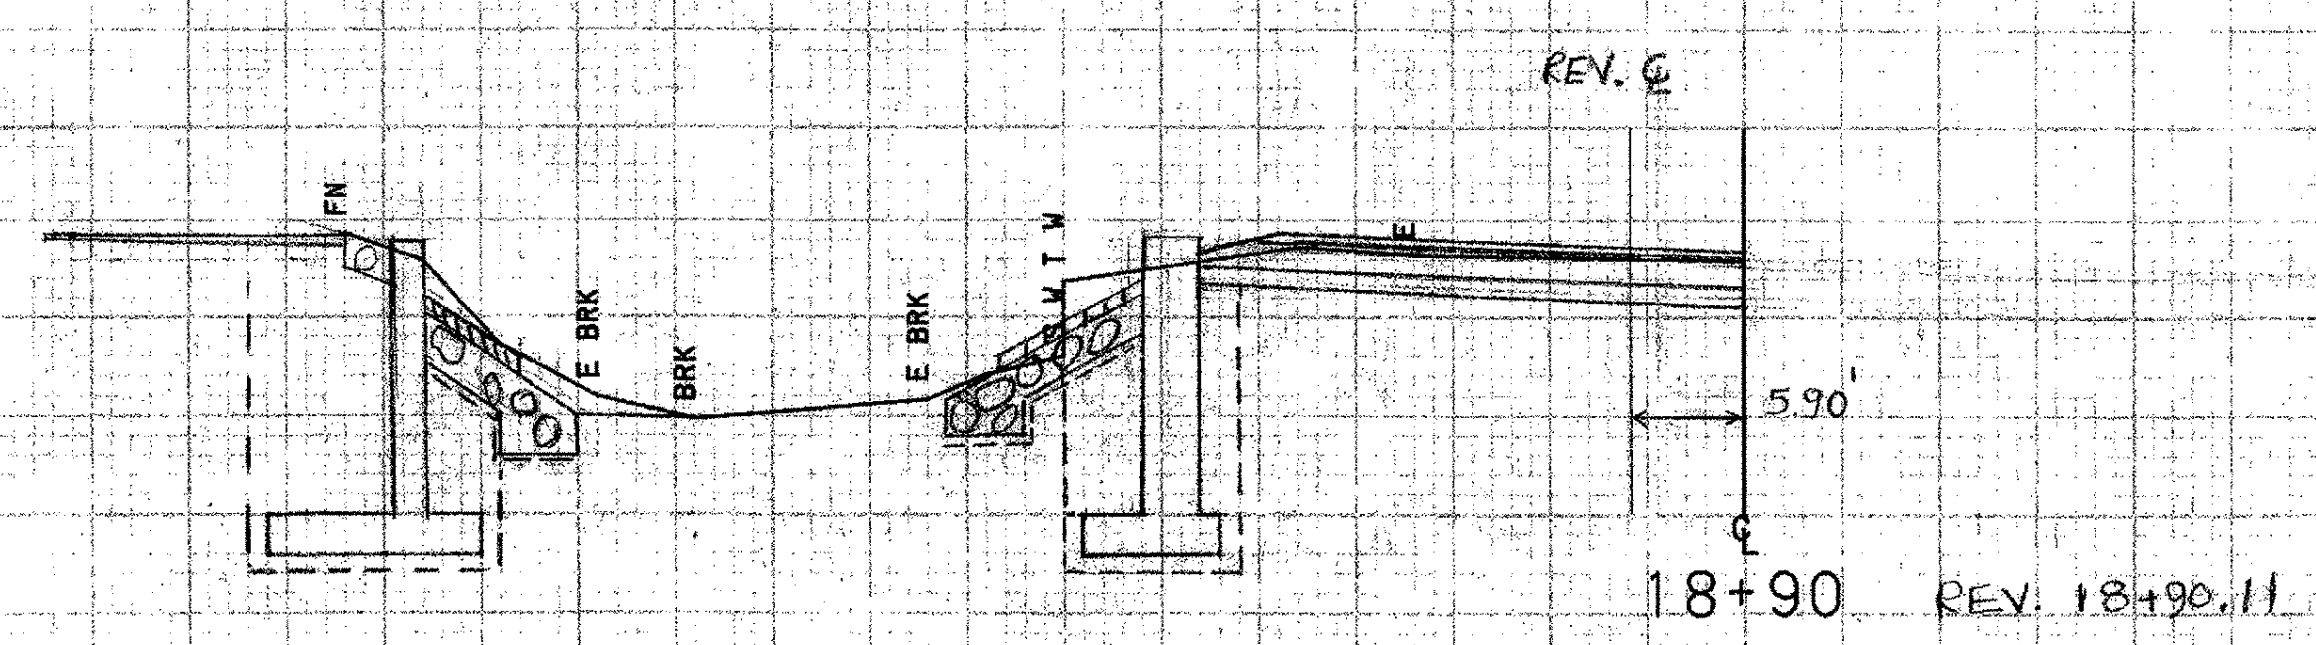

1150

FROM STA.	18+90	TO STA.	19+25
PROJECT NAME	HALIFAX MAIN2		
NO.	BR21442 (18)		
SURVEYED BY	FELTON	PLOTTED 04/24/91	
SHEET 31	OF 33	SHEETS	

SCALE 1" = 10 FEET