


SIDELINE STA. 19+59, ABUT. NO. 2
 END UNCLASSIFIED CHAN. EXCAVATION
 GEOTEXTILE UNDER STONE FILL
 STONE FILL, TYPE II
 GRUBBING MATERIAL

SIDELINE STA. 19+52, ABUT. NO. 1
 END UNCLASSIFIED CHAN. EXCAVATION
 GEOTEXTILE UNDER STONE FILL
 STONE FILL, TYPE II
 GRUBBING MATERIAL

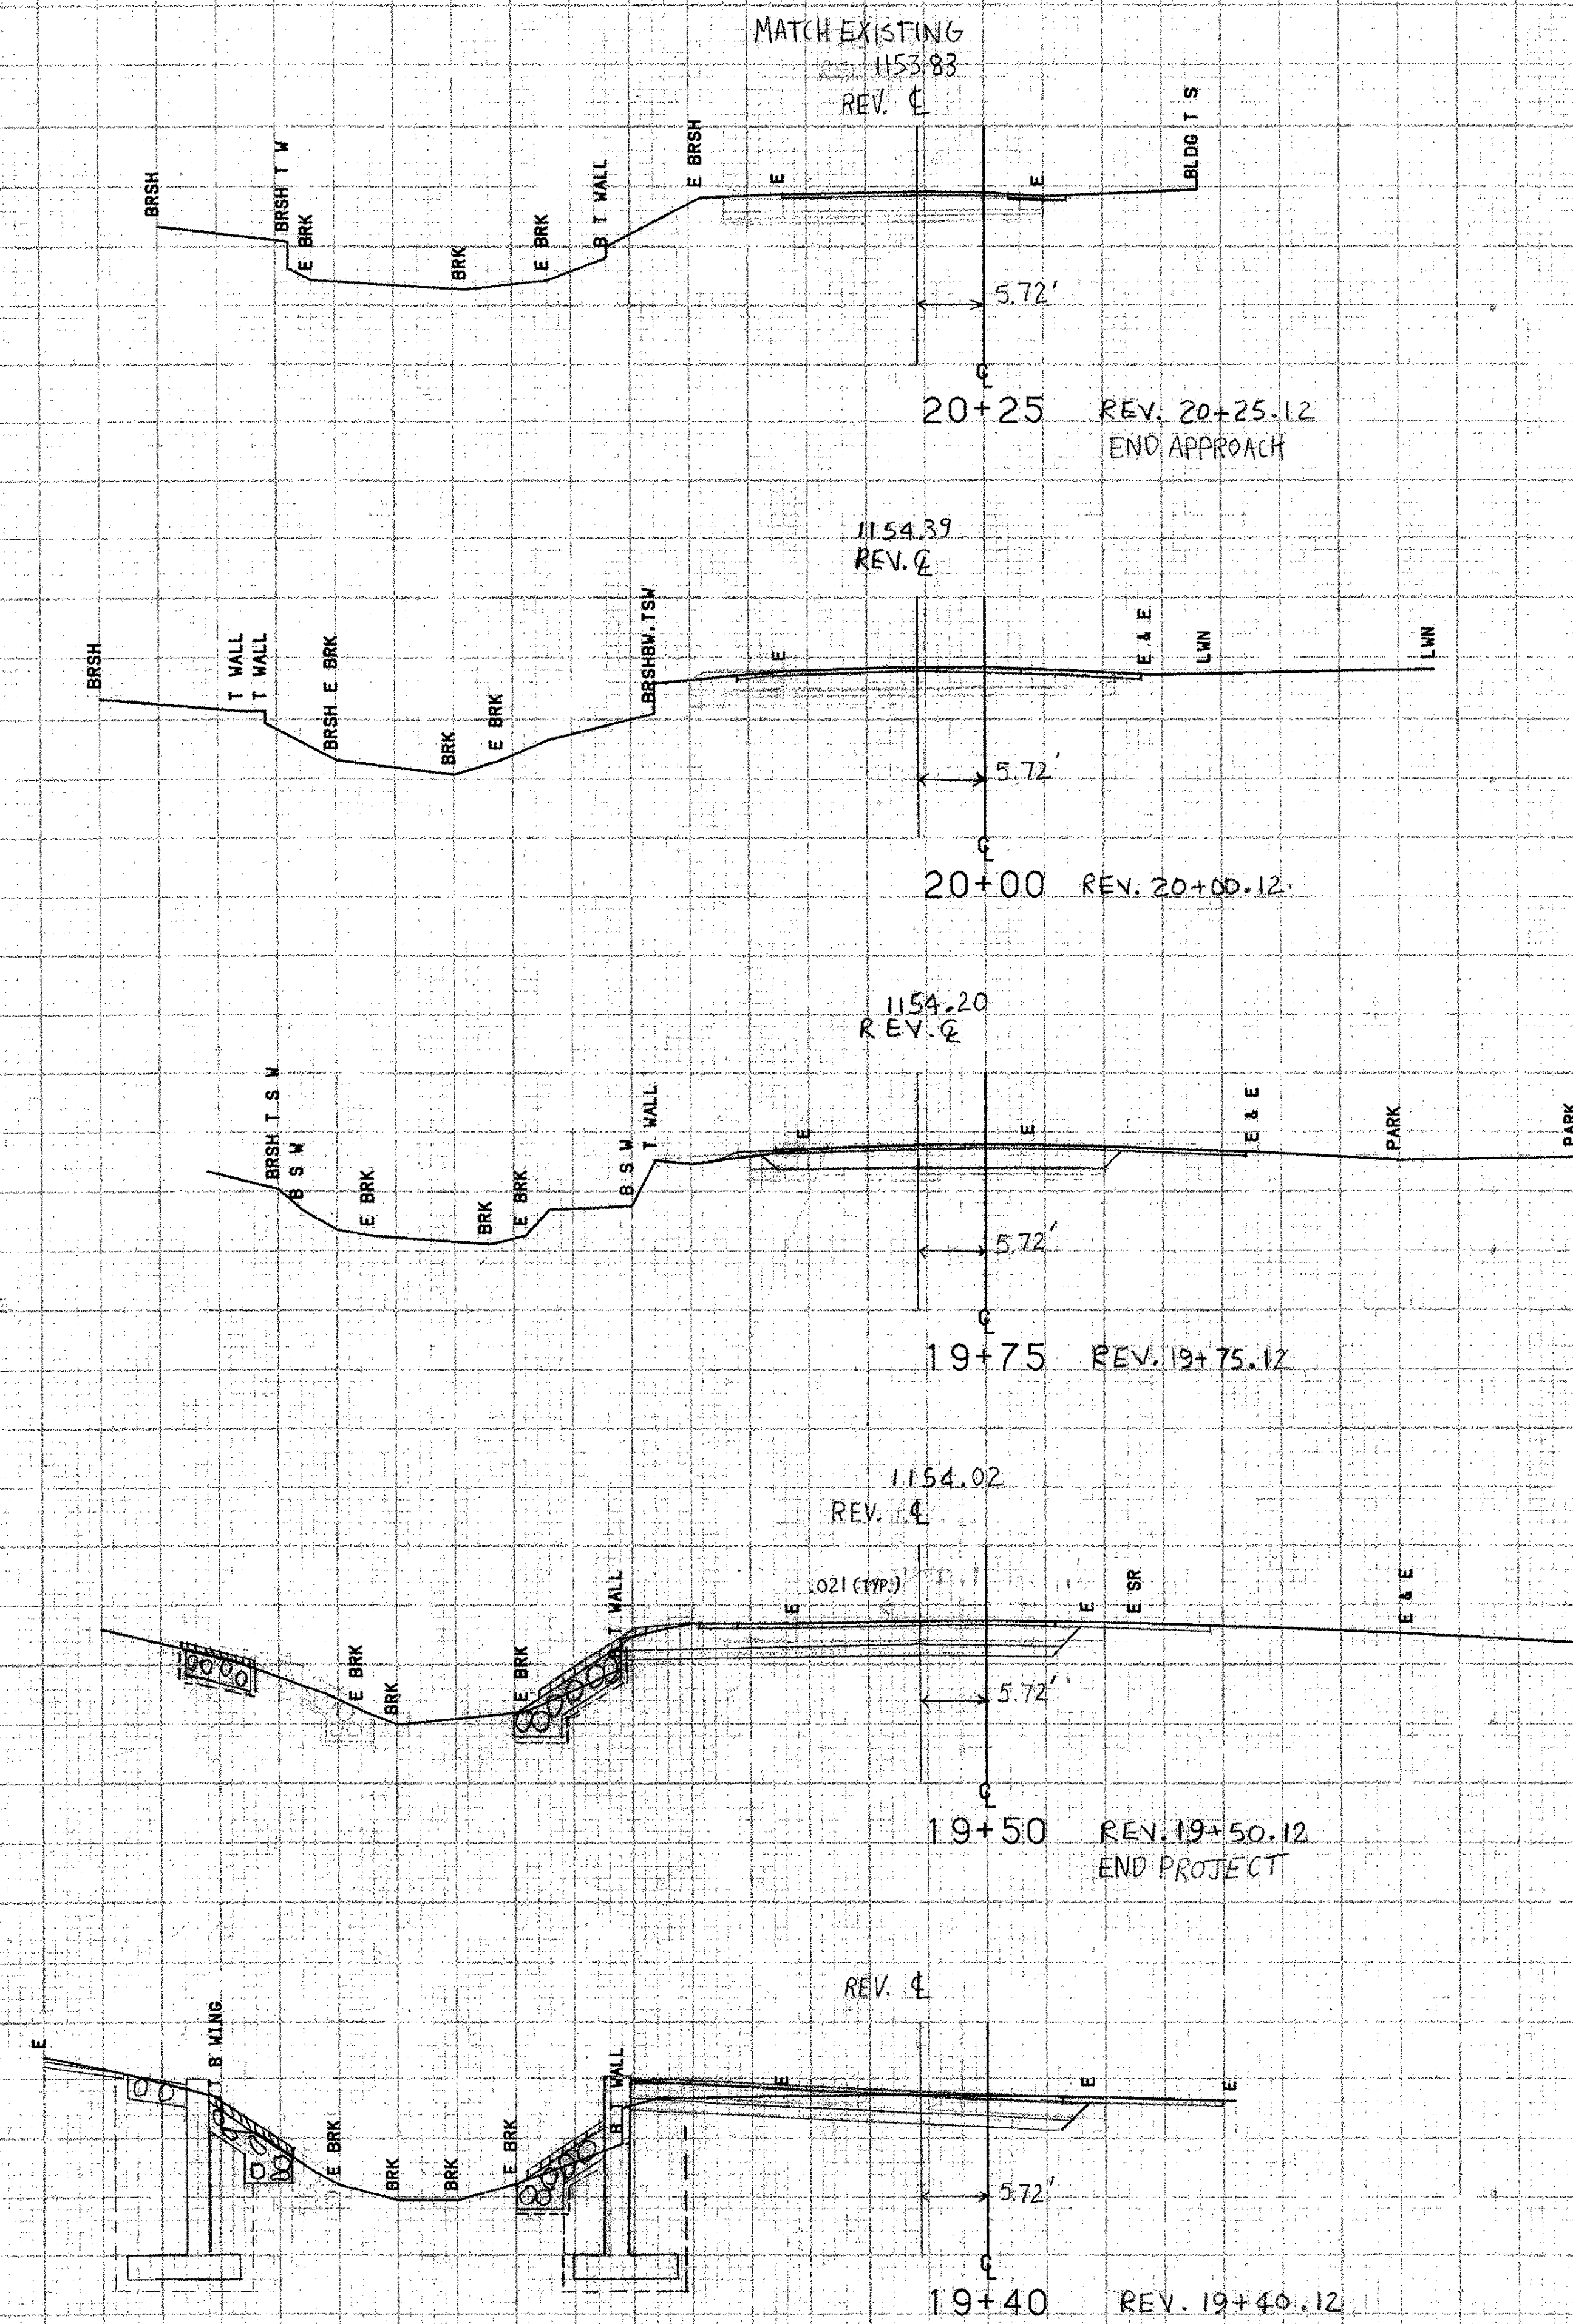

1150

1150

END APPROACH
20+25

20+00

END PROJECT
19+50

25' COLD PLACING AREA
 BIT. CONC. PAVEMENT TYPE III
 BIT. CONC. PAVEMENT TYPE II

MATCH EXISTING

SUBBASE OF GRAVEL

SAND BORROW

TRANSITION OF SUBBASE DEPTH T.H. I
 SCALE: VER. 1" = 1'-0"
 HOR. 1" = 10'-0"

FROM STA.	19+40	TO STA.	20+25
PROJECT NAME	HALIFAX MAIN2		
NO.	BRZ1442 (18)		
SURVEYED BY	FELTON	PLOTTED	04/24/91
SHEET	32	OF	33 SHEETS

SCALE 1" = 10 FEET