


# PROFILE TH 1

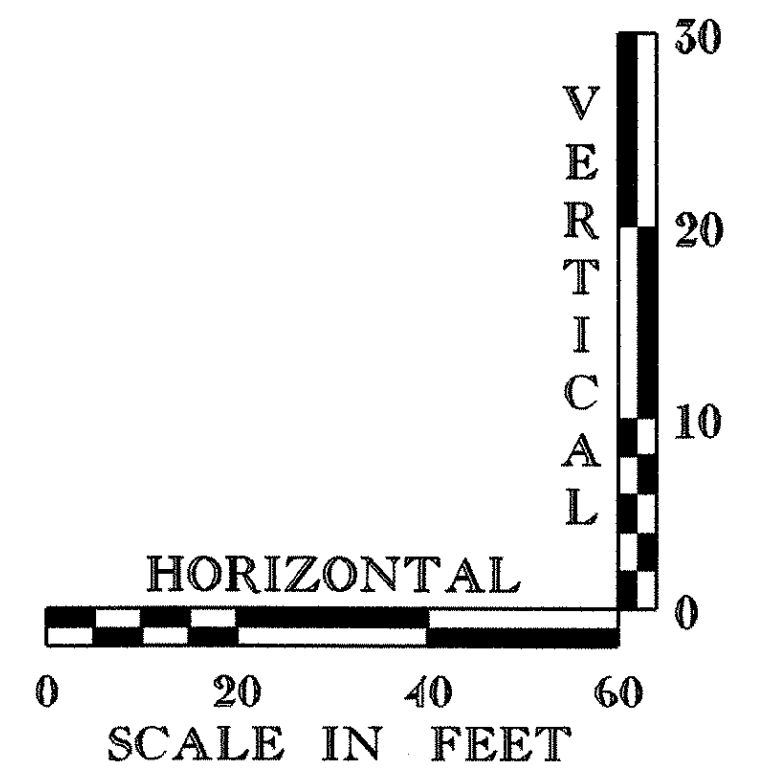

NOTE: EXISTING CENTERLINE ELEVATIONS ARE SHOWN TO THE TENTH.  
 PROPOSED CENTERLINE ELEVATIONS ARE SHOWN TO THE HUNDREDTH.  
 STATION 101+50 MATCH ELEVATION TO EXISTING.  
 THE PROPOSED ELEVATION SHOWN ON PROFILE @ STATION  
 101+50 IS FOR MATHEMATICAL ACCURACY ONLY.

PROJECT: <b>ROYALTON</b>	PROJECT NO.: <b>BRZ 1444(22)</b>
DESIGN FILE NAME: 89j099/structures/sj099pr1.dgn	PLOT DATE: 25-SEP-2000
IPARM FILE NAME: sj099pr1.i	SURVEY DATE: 9/91
SURVEYED BY: R. GILMAN	DRAWN BY: W.B. SYMONDS
SQUAD LEADER: C. P. WILLIAMS	SHEET: 12 OF 118
TH 1 PROFILE SHEET A	