




PROFILE TH 1

NOTE: EXISTING CENTERLINE ELEVATIONS ARE SHOWN TO THE TENTH.
 PROPOSED CENTERLINE ELEVATIONS ARE SHOWN TO THE HUNDREDTH.

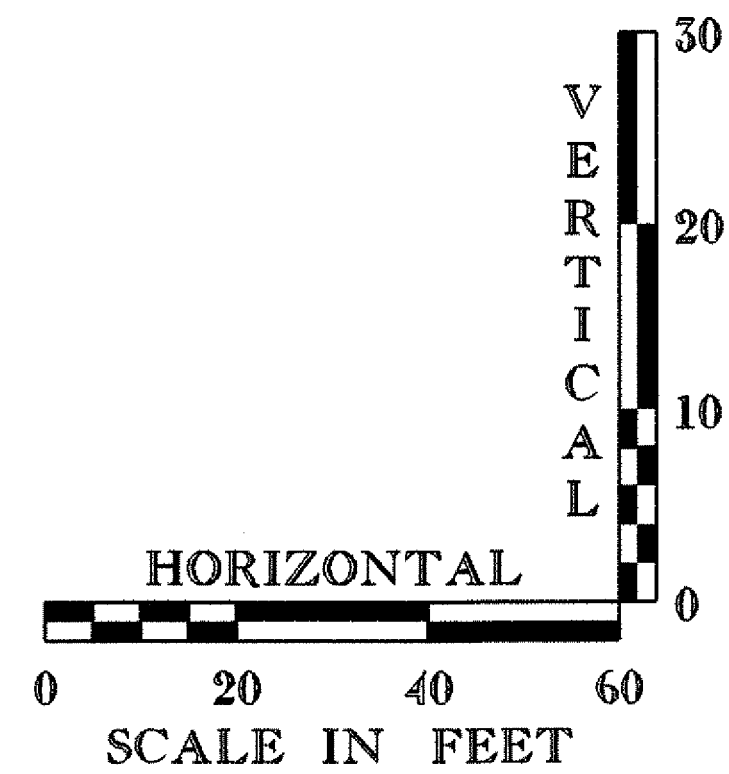

PROJECT: ROYALTON	PROJECT NO.: BRZ 1444(22)
DESIGN FILE NAME: 89j099/structures/sj099pr1.dgn	PLOT DATE: 25-SEP-2000
IPARM FILE NAME: sj099pr2.i	SURVEY DATE: 9/91
SURVEYED BY: R. GILMAN	DRAWN BY: W.B. SYMONDS
SQUAD LEADER: C.P. WILLIAMS	SHEET: 13 OF 118
TH 1 PROFILE SHEET B	