



NOTE:
THE SIGN PACKAGE SHOWN AS EXISTING IS TO BE CONSTRUCTED AS PART OF THE ADJACENT ROYALTON BRS 0147 (5) S PROJECT.

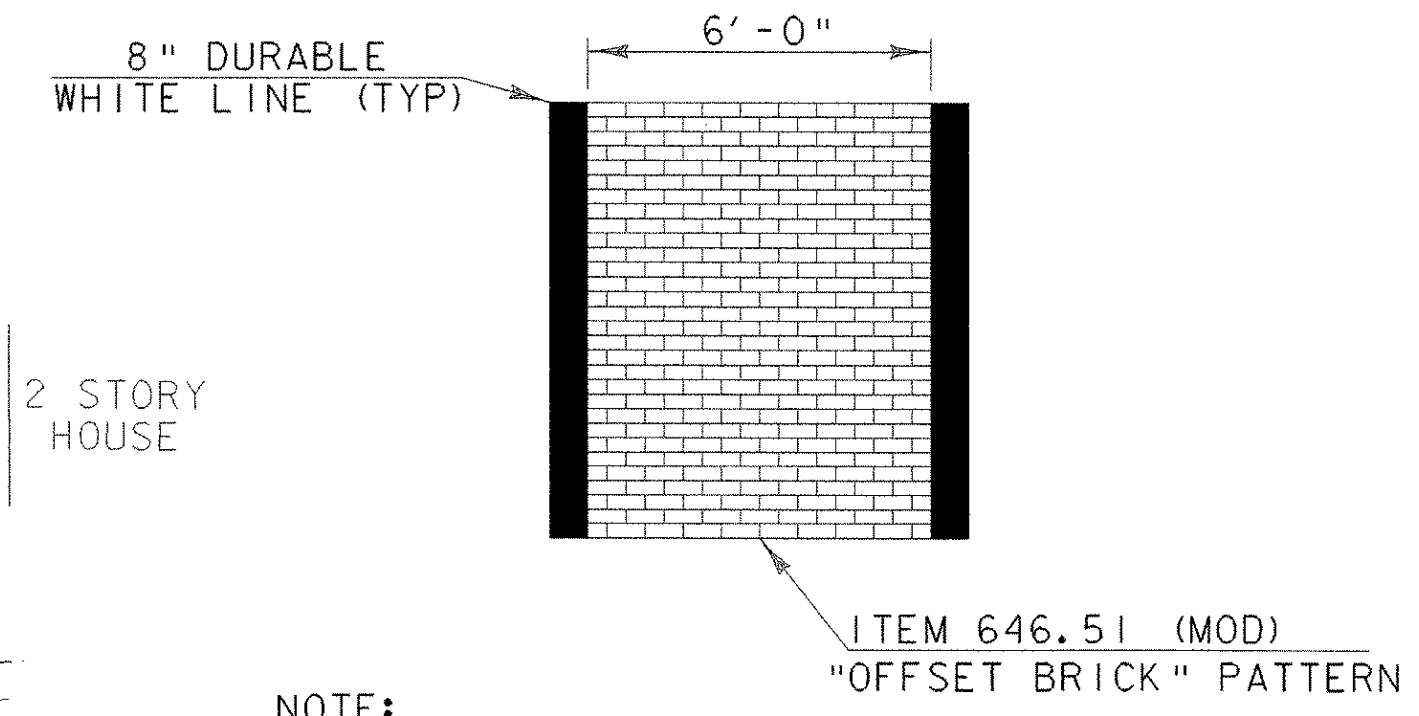

NOTE:
THE "OFFSET BRICK" DETAIL SHOWN ABOVE SHALL BE IMPRINTED AS SPECIFIED IN THE SPECIAL PROVISIONS. THE "OFFSET BRICK" PATTERN SHALL BE PAINTED A GRANITE COLOR.

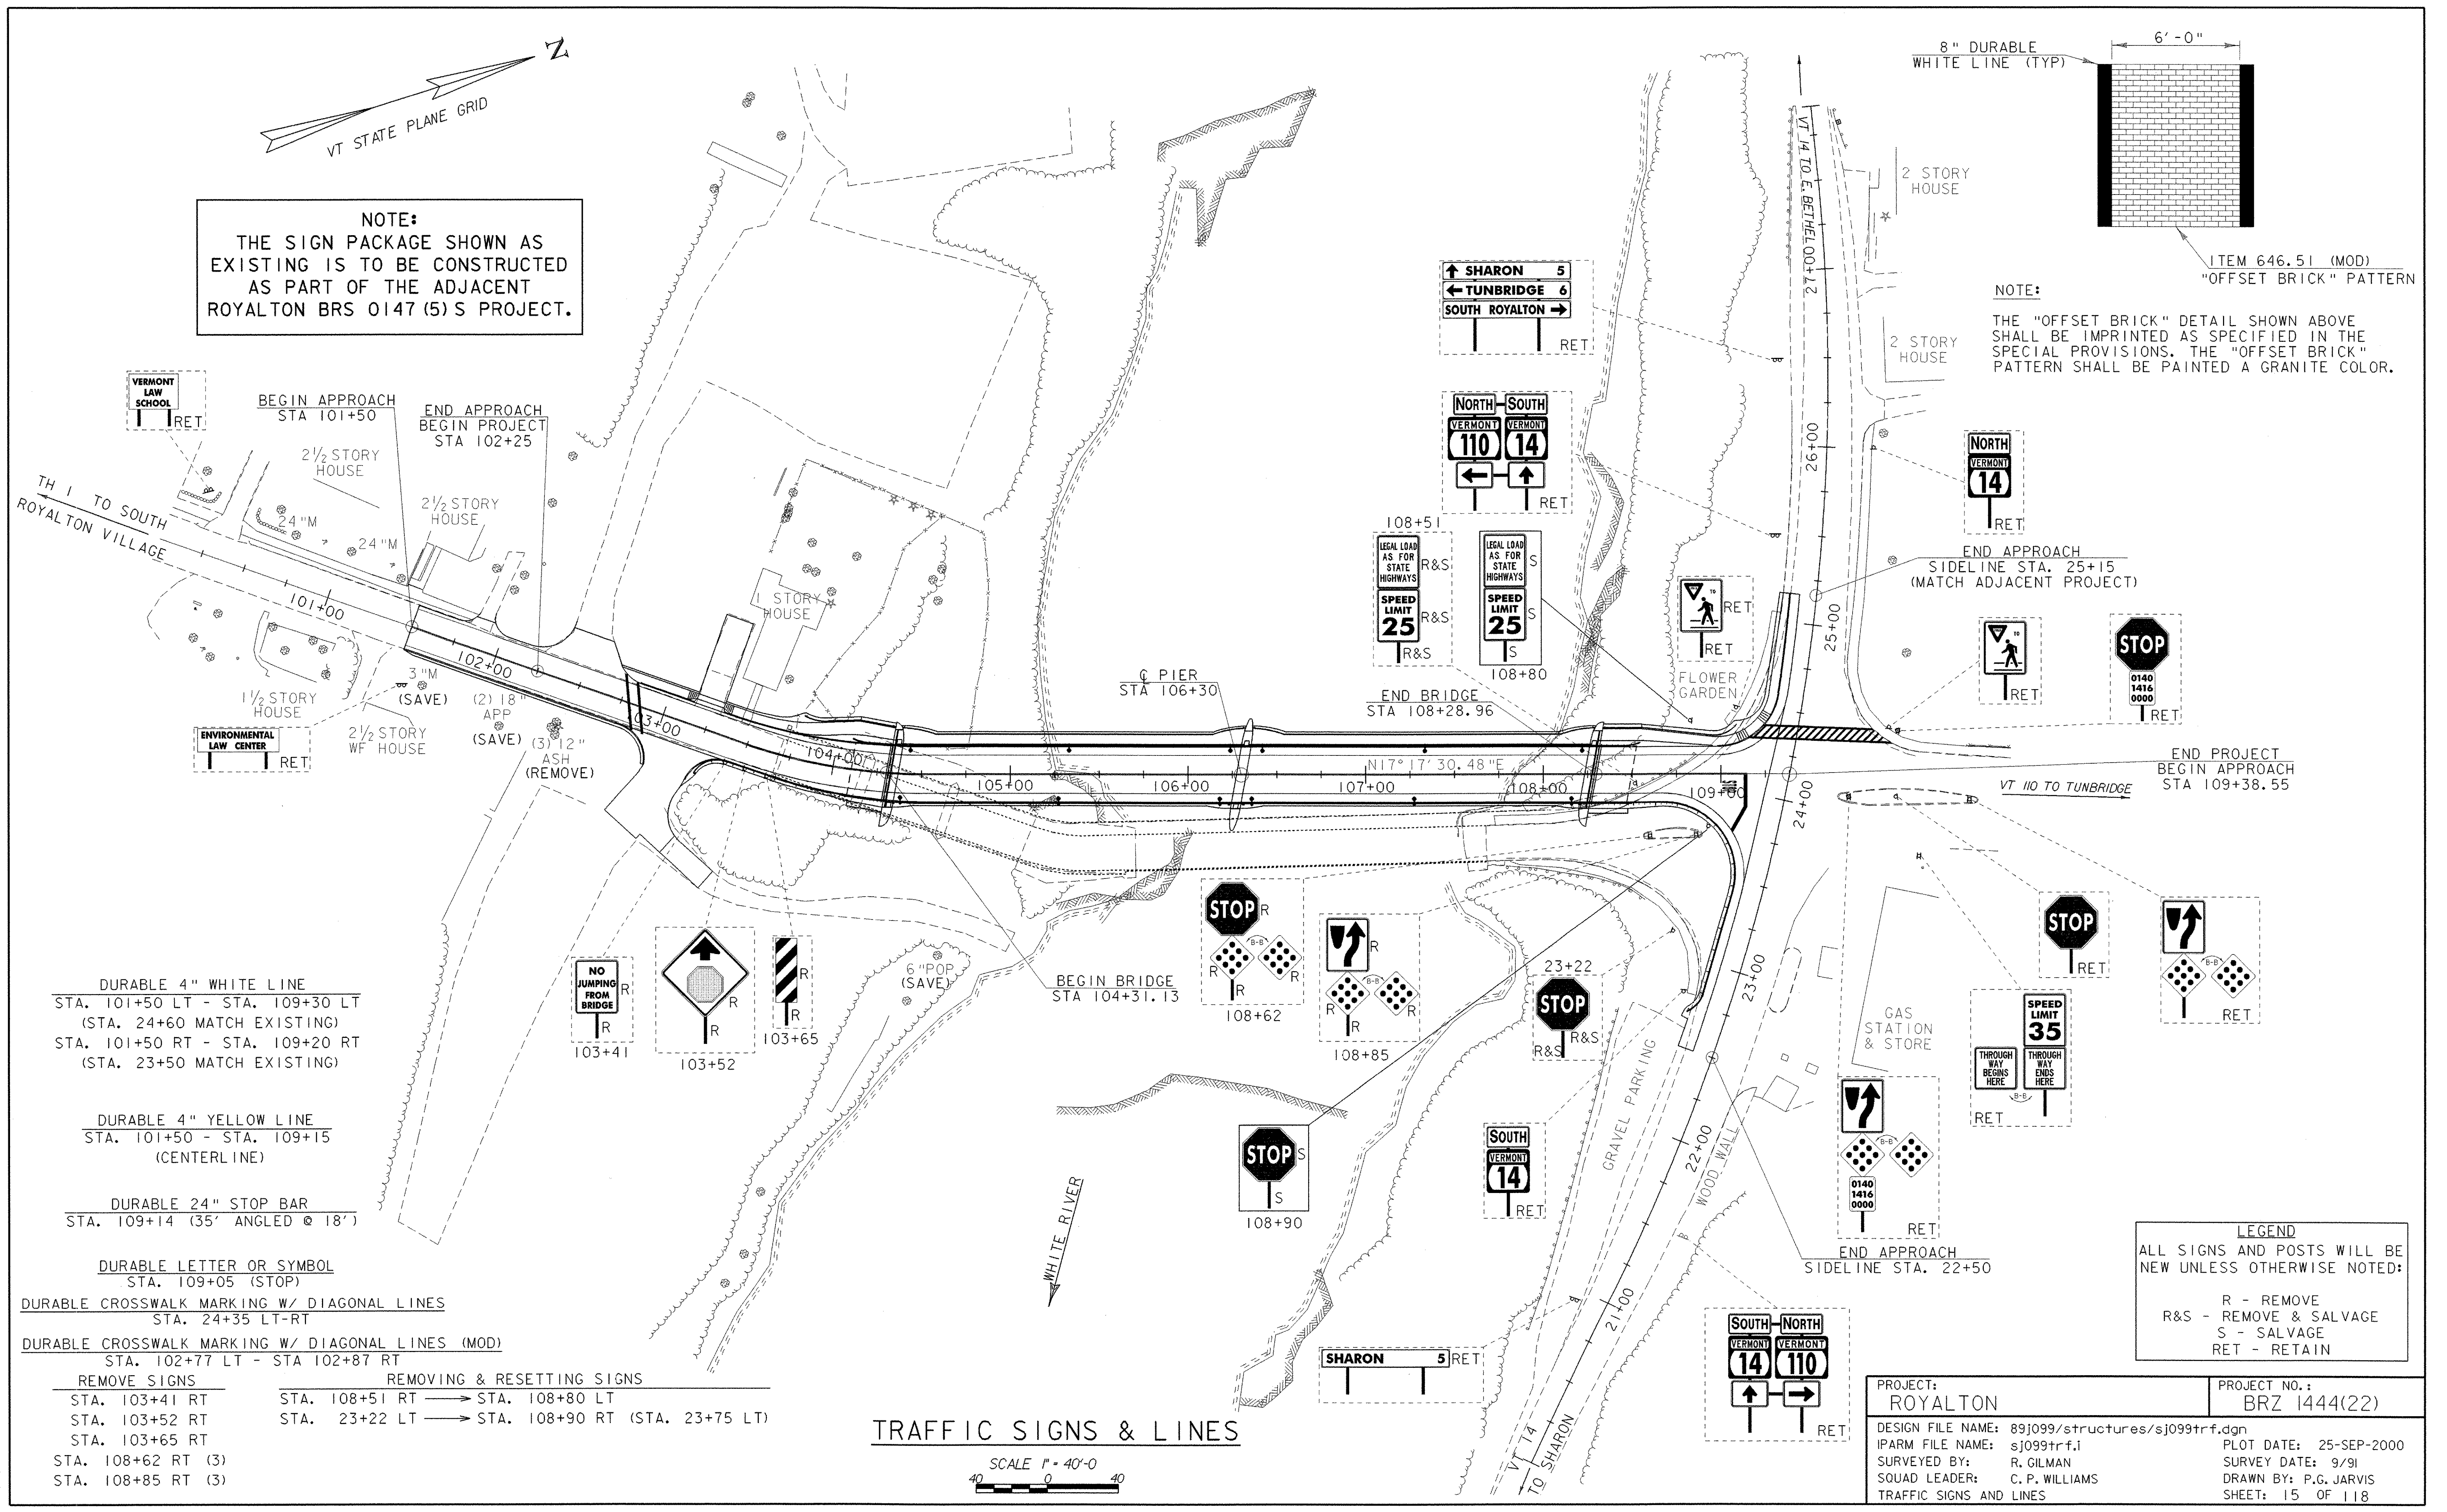

DURABLE 4" WHITE LINE
STA. 101+50 LT - STA. 109+30 LT
(STA. 24+60 MATCH EXISTING)
STA. 101+50 RT - STA. 109+20 RT
(STA. 23+50 MATCH EXISTING)

DURABLE 4" YELLOW LINE
STA. 101+50 - STA. 109+15
(CENTERLINE)


DURABLE 24" STOP BAR
STA. 109+14 (35' ANGLED @ 18')

DURABLE LETTER OR SYMBOL
STA. 109+05 (STOP)
DURABLE CROSSWALK MARKING W/ DIAGONAL LINES
STA. 24+35 LT-RT

DURABLE CROSSWALK MARKING W/ DIAGONAL LINES (MOD)
STA. 102+77 LT - STA 102+87 RT

REMOVE SIGNS	REMOVING & RESETTING SIGNS
STA. 103+41 RT	STA. 108+51 RT → STA. 108+80 LT
STA. 103+52 RT	STA. 23+22 LT → STA. 108+90 RT (STA. 23+75 LT)
STA. 103+65 RT	
STA. 108+62 RT (3)	
STA. 108+85 RT (3)	

TRAFFIC SIGNS & LINES

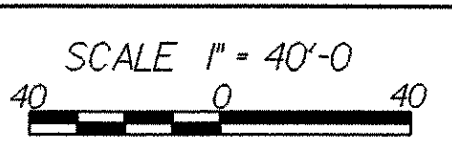

LEGEND
ALL SIGNS AND POSTS WILL BE NEW UNLESS OTHERWISE NOTED:
R - REMOVE
R&S - REMOVE & SALVAGE
S - SALVAGE
RET - RETAIN

PROJECT: ROYALTON	PROJECT NO.: BRZ 1444(22)
DESIGN FILE NAME: 89j099/structures/sj099trf.dgn	PLOT DATE: 25-SEP-2000
IPARM FILE NAME: sj099trf.i	SURVEY DATE: 9/91
SURVEYED BY: R. GILMAN	DRAWN BY: P.G. JARVIS
SQUAD LEADER: C. P. WILLIAMS	SHEET: 15 OF 118
TRAFFIC SIGNS AND LINES	