


**PLAN**

SCALE 1" = 20'-0"  
 20 0 20

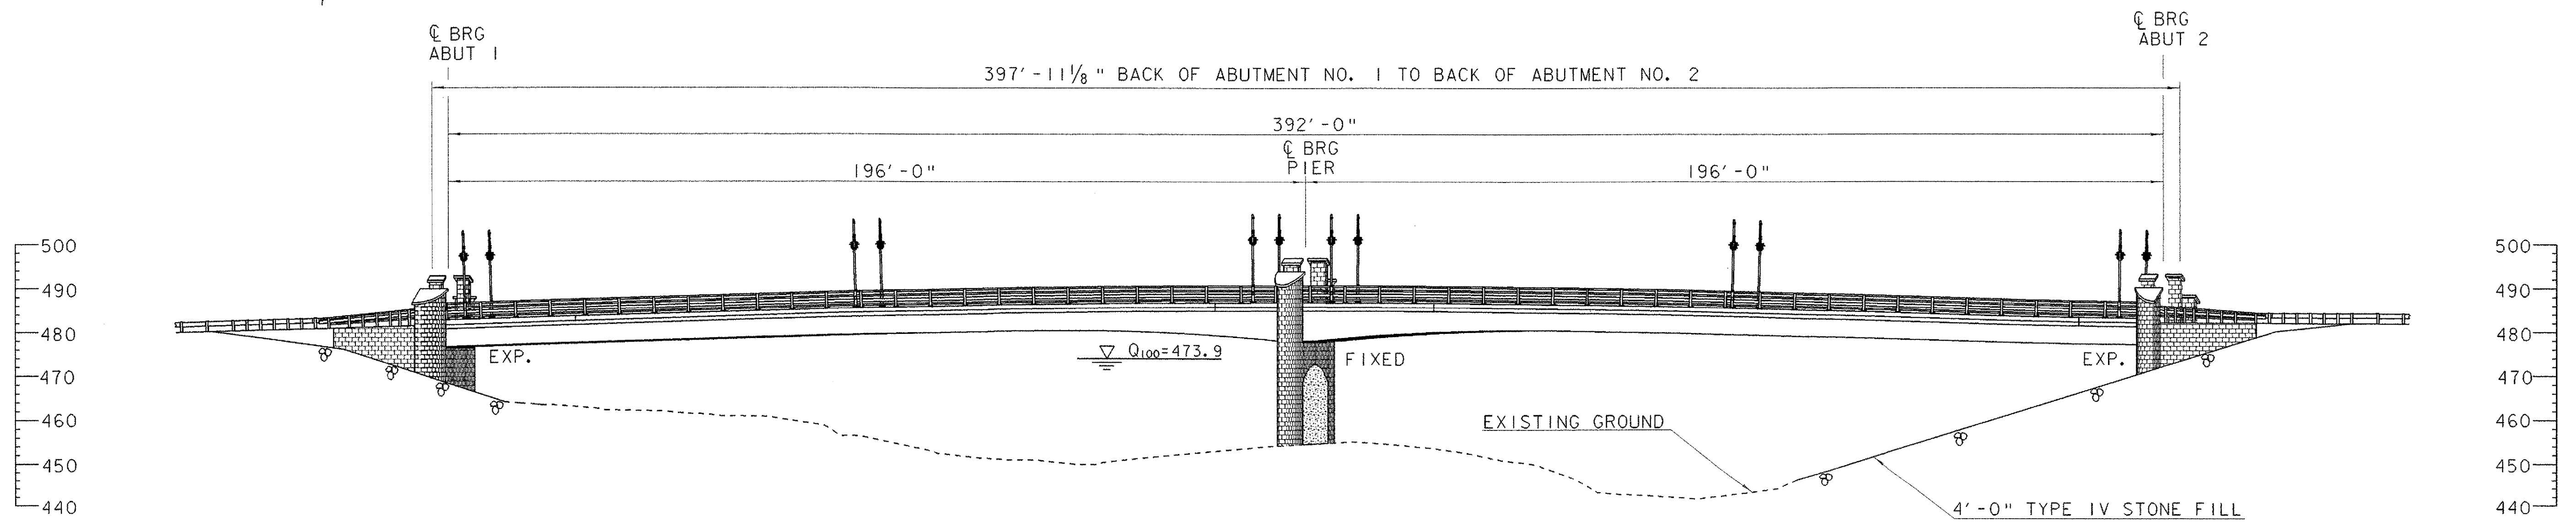

**ELEVATION @ DOWNSTREAM FASCIA**

SCALE 1" = 20'-0"  
 20 0 20

PROJECT: ROYALTON	PROJECT NO.: BRZ 1444(22)
DESIGN FILE NAME: 89j099/structures/sj099pe.dgn	PLOT DATE: 25-SEP-2000
IPARM FILE NAME: sj099pe.i	
TH 1 OVER THE WHITE RIVER	
PLAN AND ELEVATION	SHEET: 23 OF 118