



TYPICAL BRIDGE SECTION

SCALE 3/4" = 1'-0"

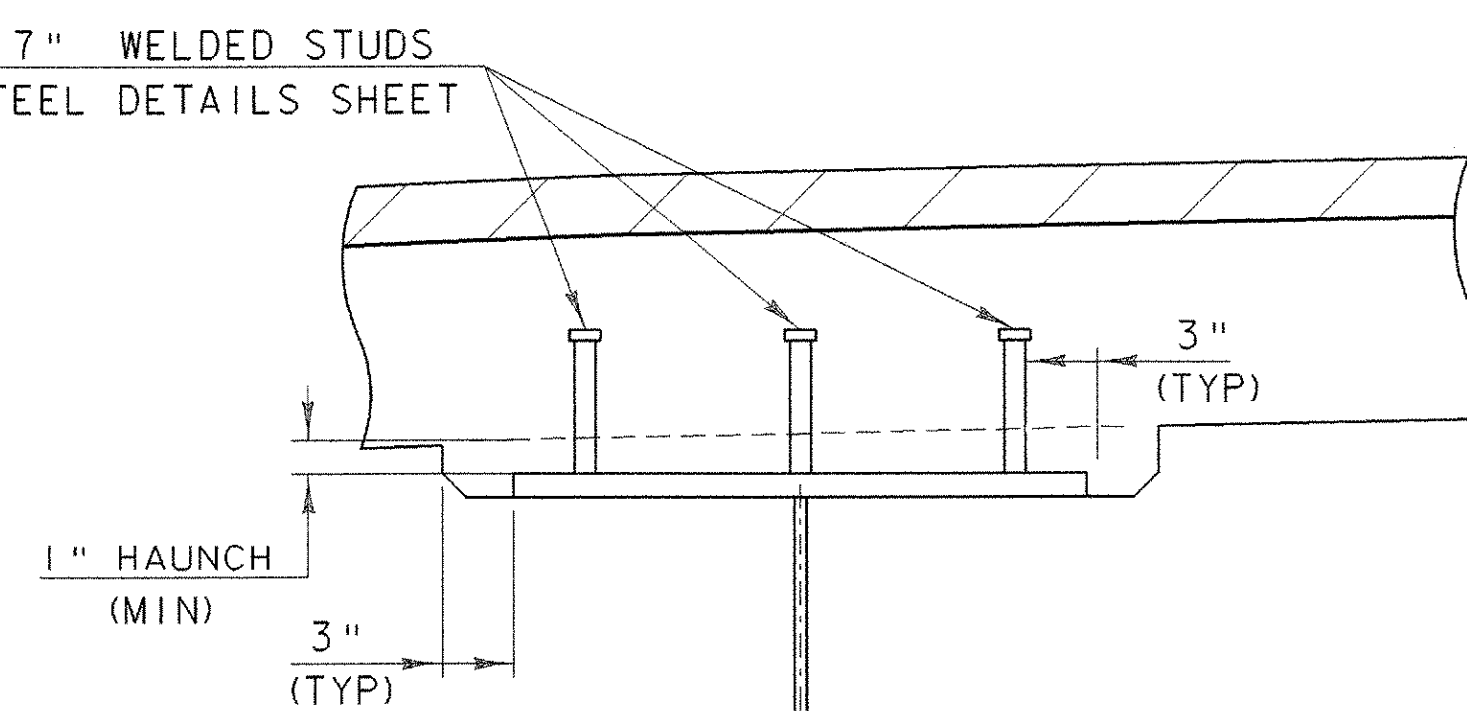

GIRDER HAUNCH & SHEAR CONNECTOR DETAILS

SCALE 1 1/2" = 1'-0"

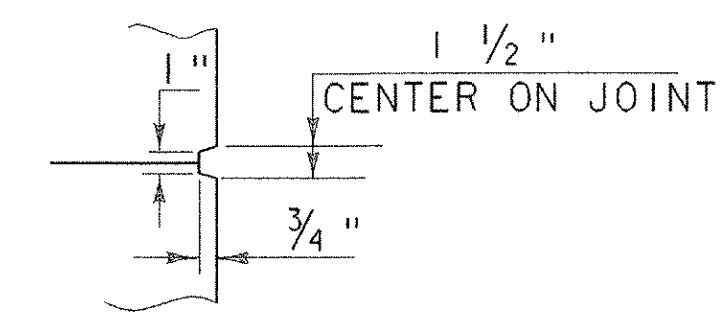

SCORE MARK DETAIL

PROJECT NAME: ROYALTON BRZ 1444 (22)

PROJECT NUMBER: 89j099/structures/sj099sup2.dgn

FILE NAME: sj099typbrsec.i

IPARM NAME: C.P. WILLIAMS

PROJECT LEADER: W.B. SYMONDS

DESIGNED BY: W.B. SYMONDS

TYPICAL BRIDGE SECTION

PLOT DATE: 25-SEP-2000

DRAWN BY: K. M. HIGGINS

CHECKED BY: W.B. SYMONDS

SHEET 26 OF 118