



APPROACH SLAB NO. 1 PLAN

SCALE 1/4" = 1'-0"
0 2 4 6

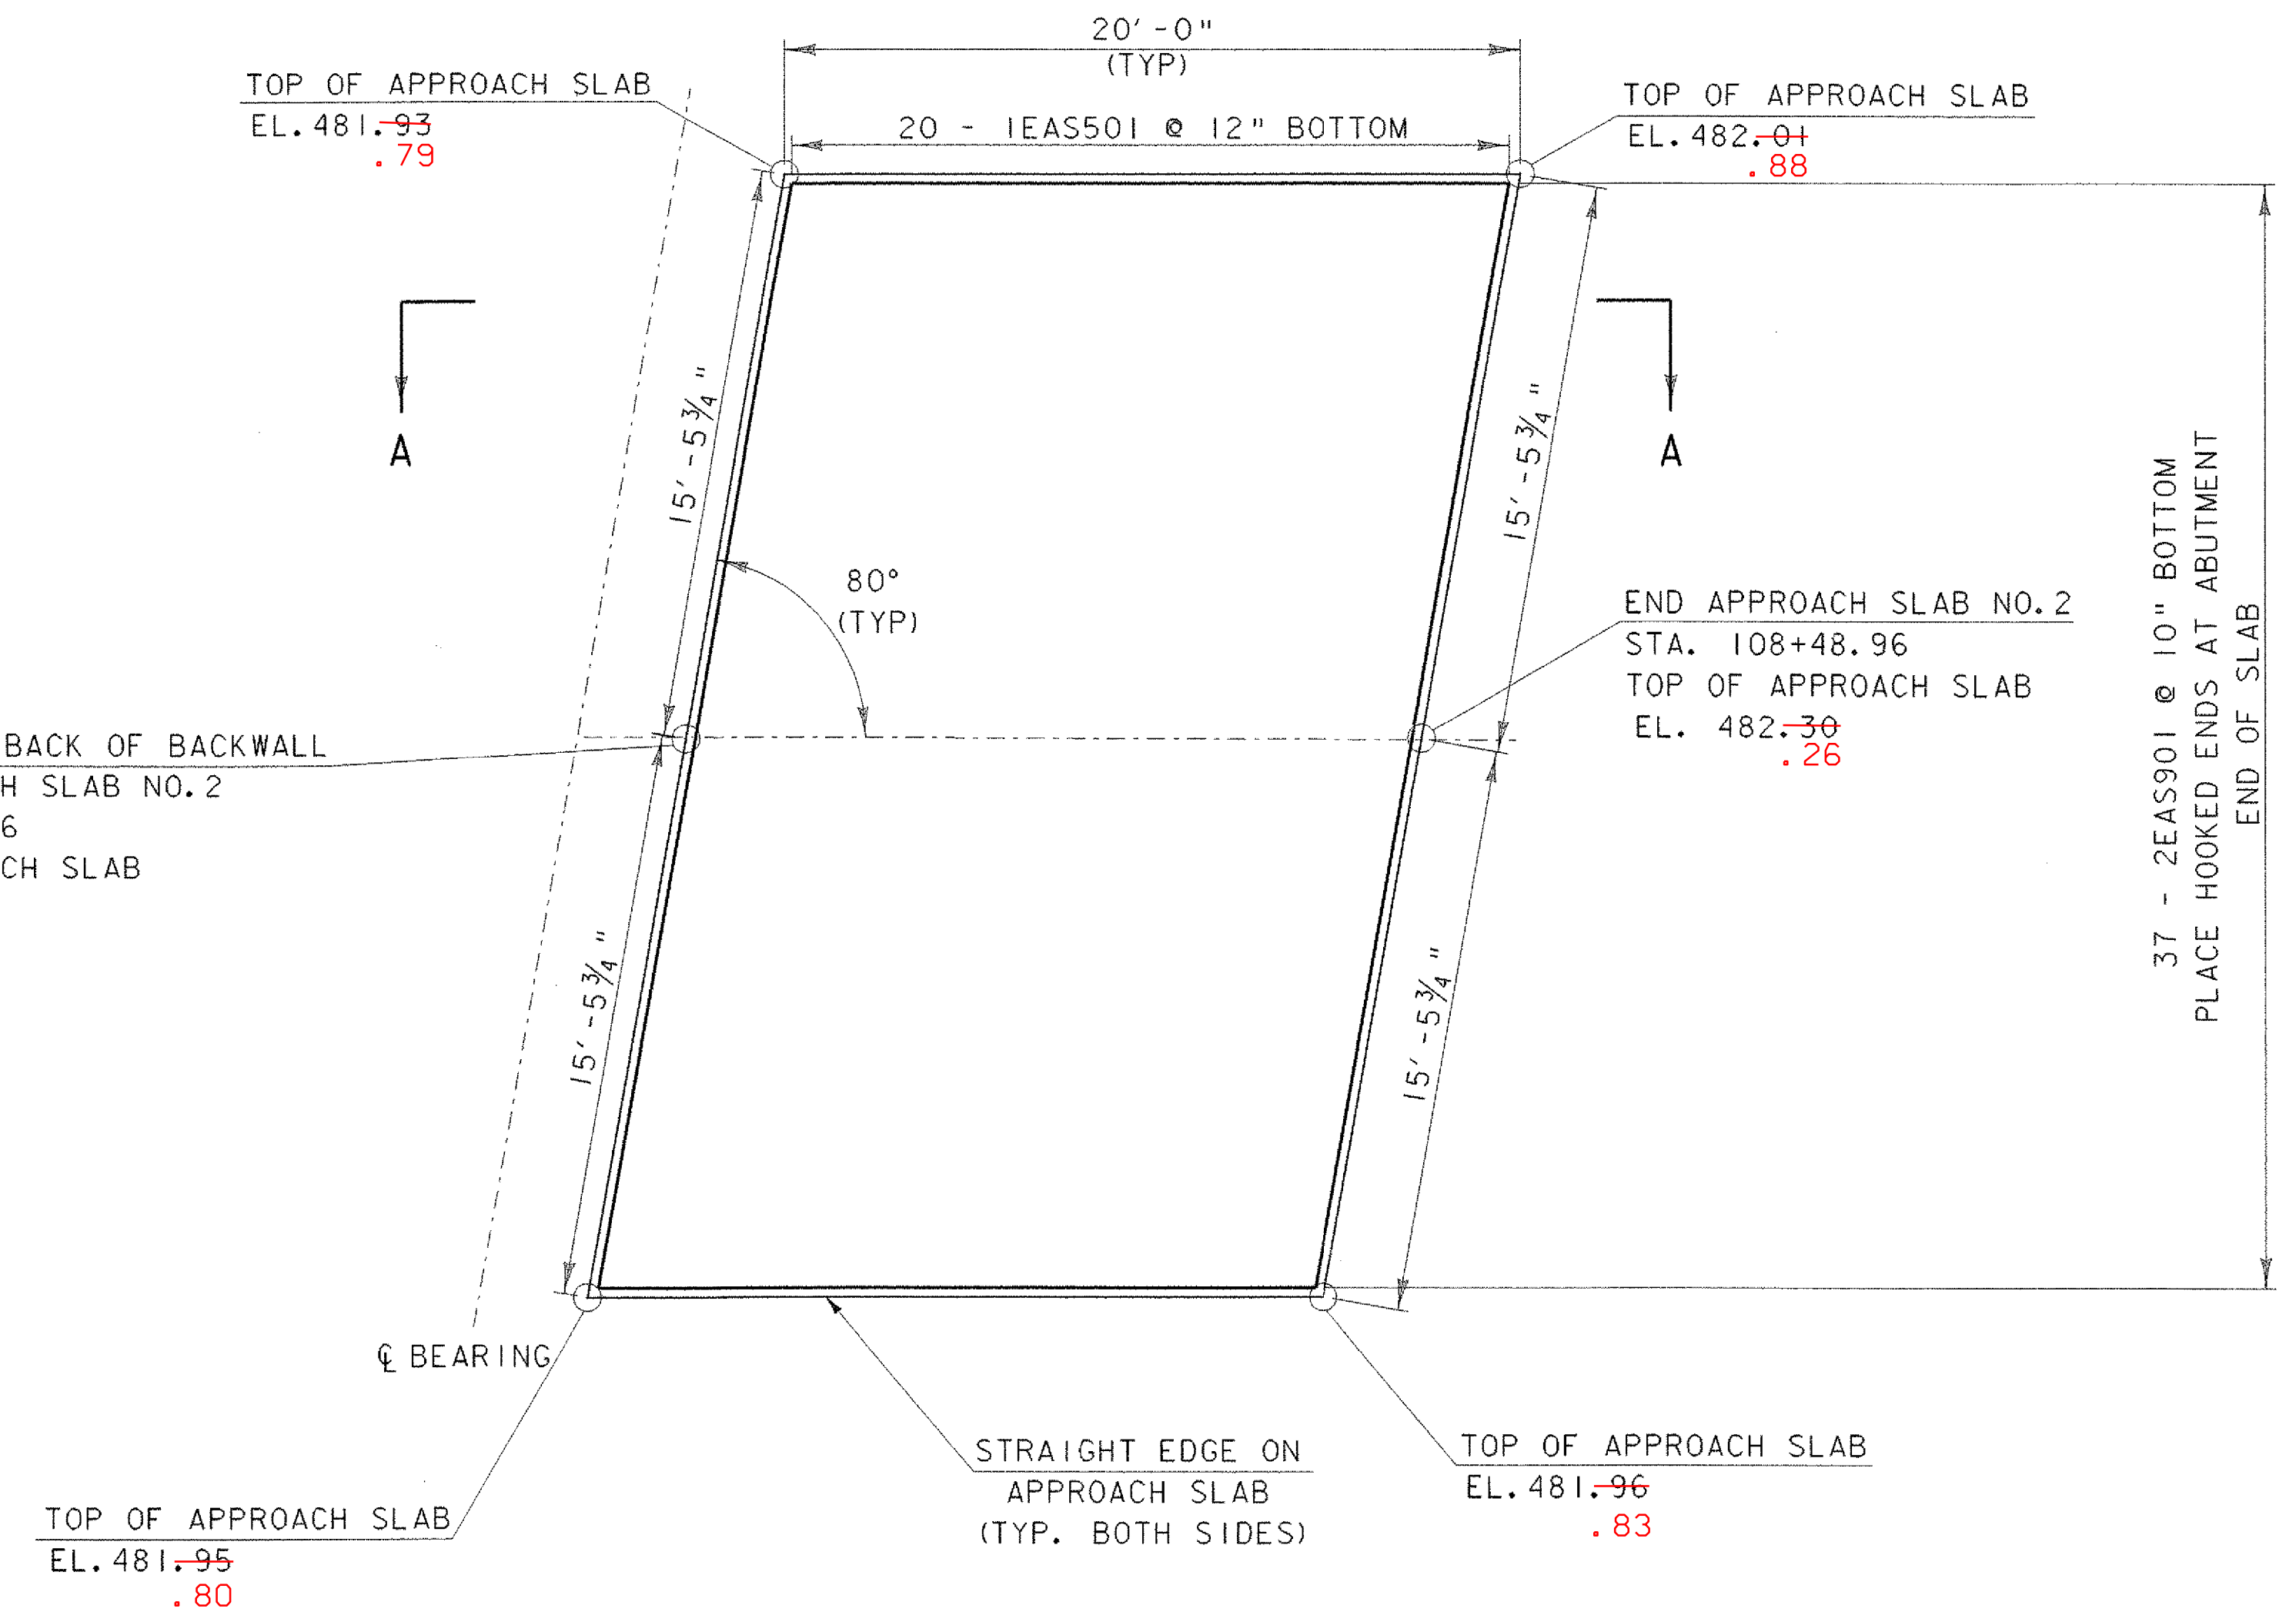


APPROACH SLAB NO. 2 PLAN

SCALE 1/4" = 1'-0"
0 2 4 6

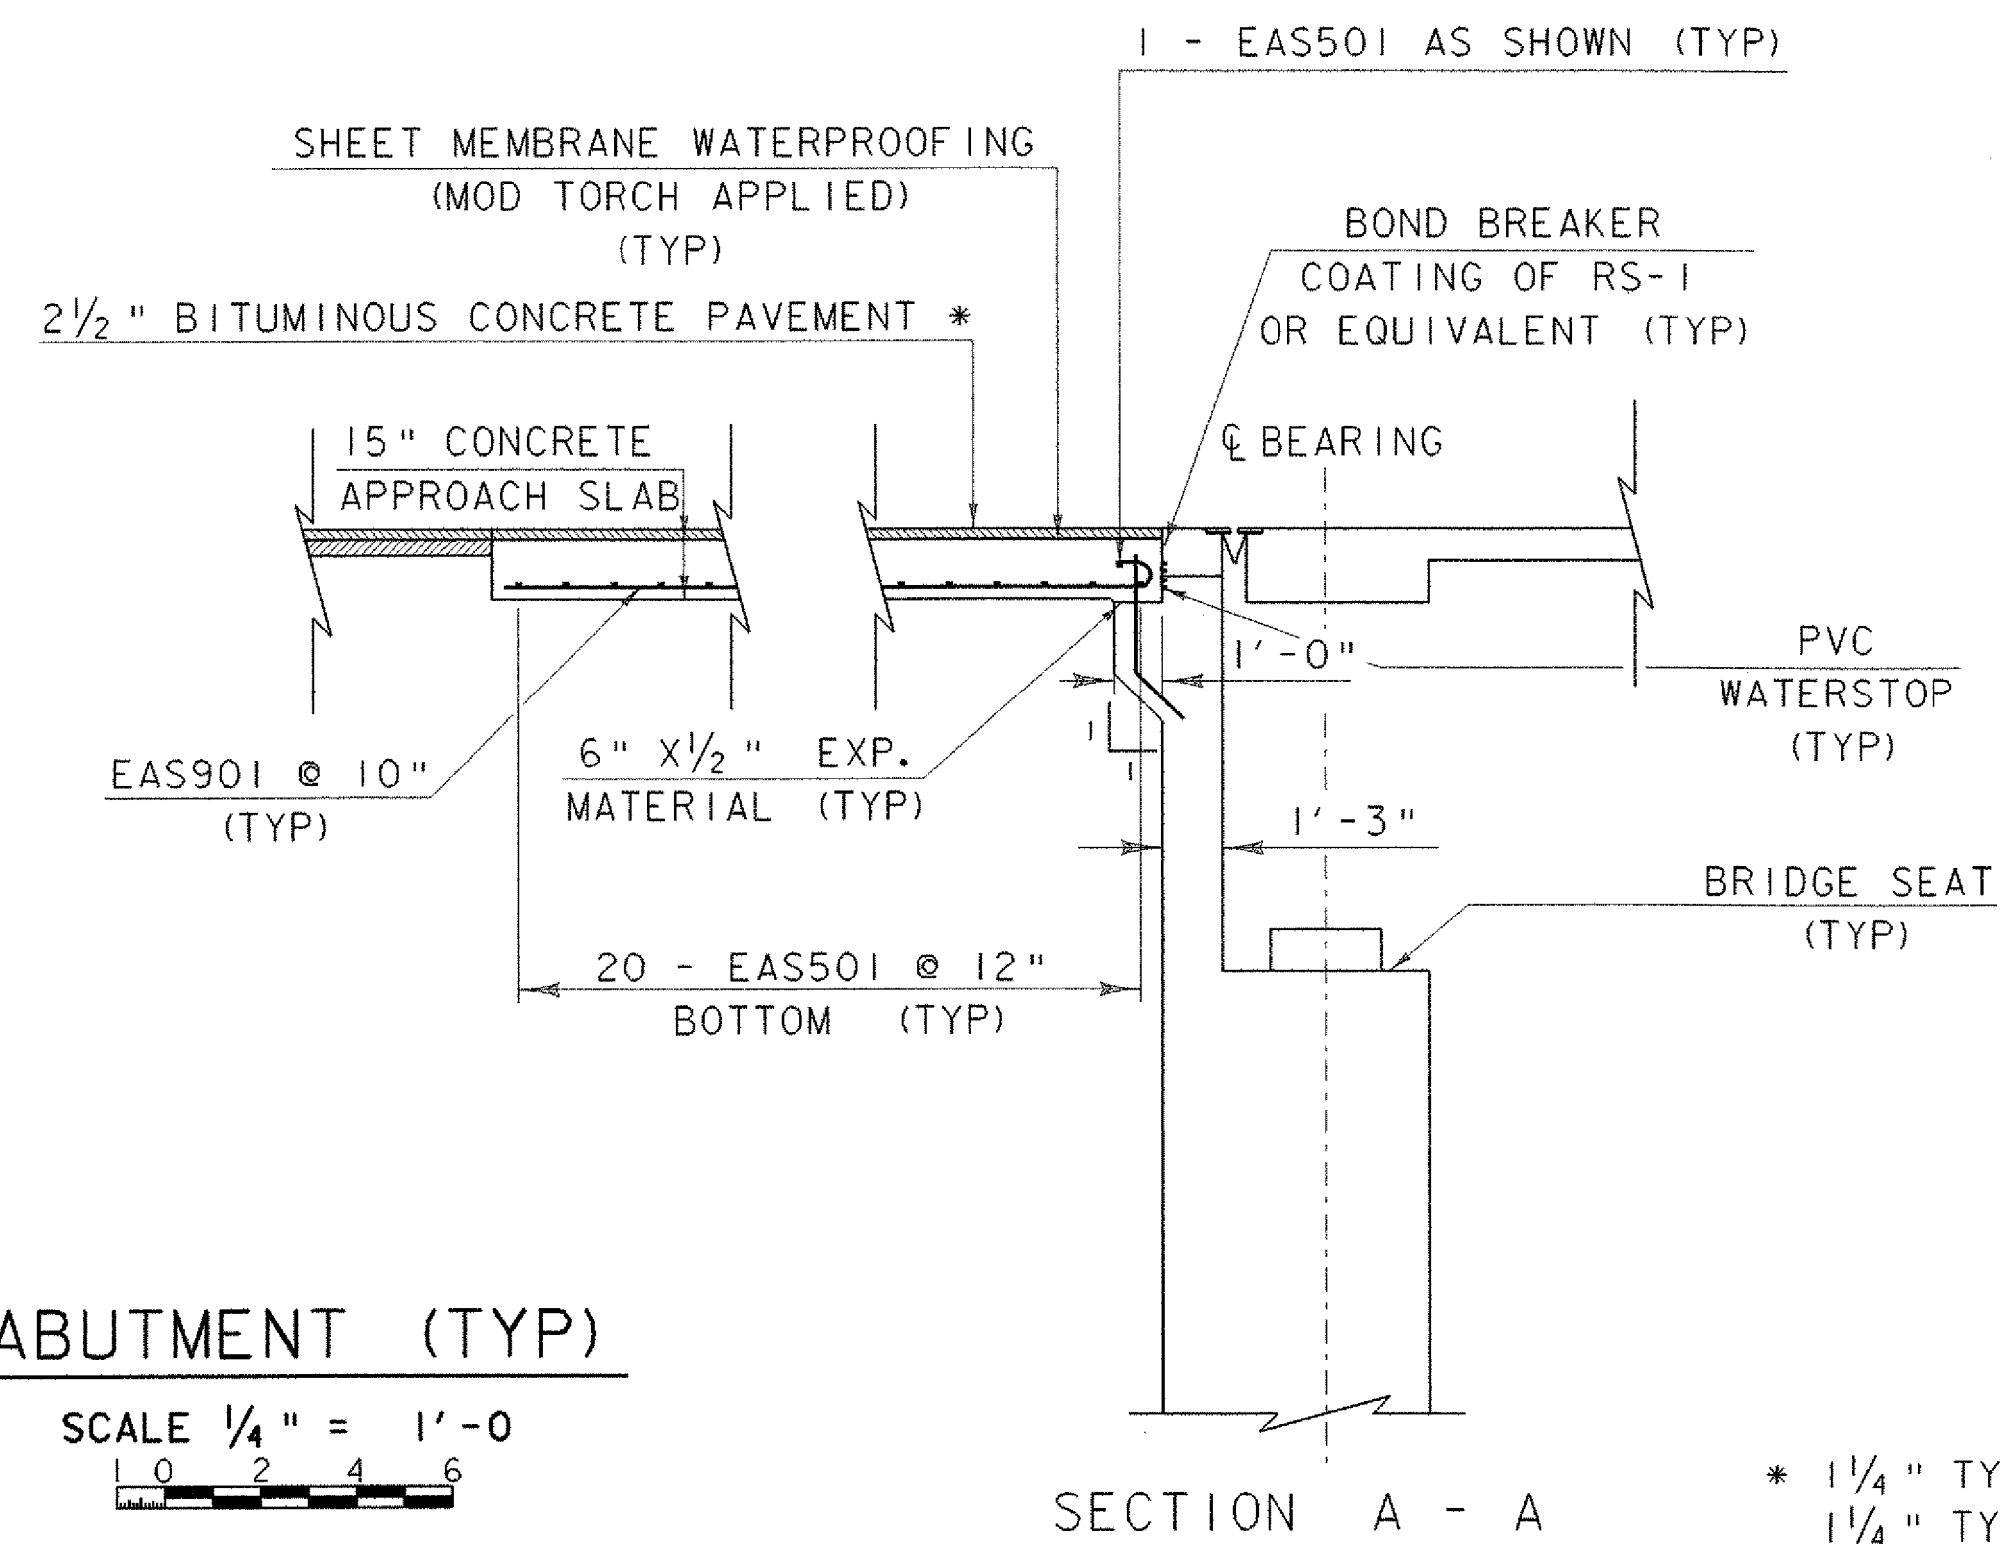

P.V.C. WATERSTOP FOR CONSTRUCTION JOINTS

THE COSTS FOR P.V.C. WATERSTOP SHALL BE INCLUDED IN THE UNIT PRICE BID FOR CONCRETE. OTHER CONFIGURATIONS MAY BE USED UPON APPROVAL OF THE STRUCTURES ENGINEER.

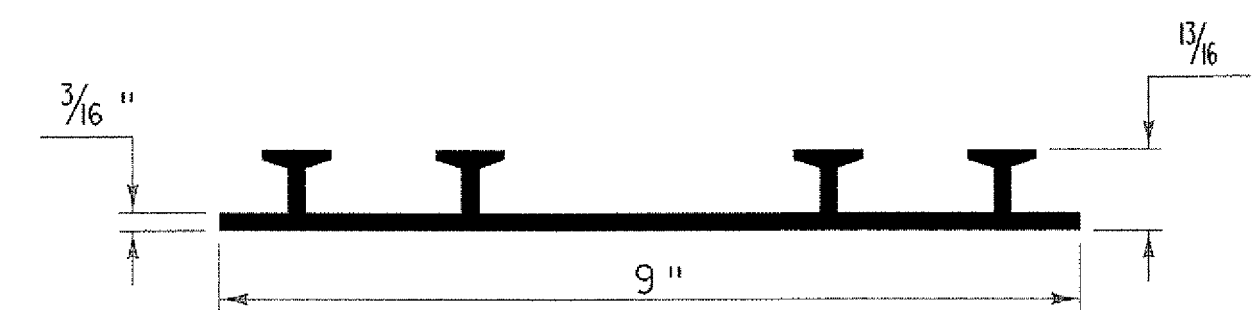


NOTE:

- NF = NEAR FACE
- FF = FAR FACE
- EF = EACH FACE
- ▲ = CUT TO FIT IN FIELD

ALL LAP SPLICES NOT DETAILED SHALL BE 2'-2"

ALL CLEAR COVER SHALL BE 3" UNLESS NOTED OTHERWISE.

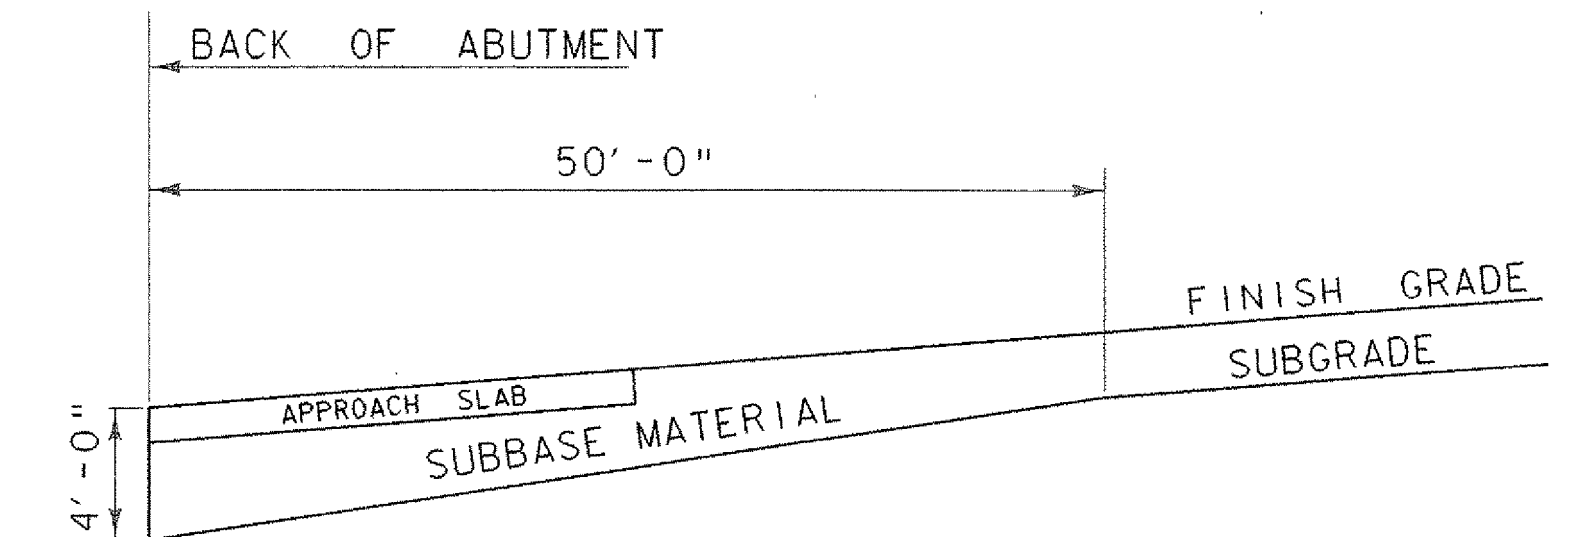

SUBBASE DETAIL AT ABUTMENTS

(ELEVATION IN CUT AND FILL)
NOT TO SCALE

PROJECT NAME:	ROYALTON BRZ 1444 (22)
PROJECT NUMBER:	
FILE NAME: 89j099/structures/sj099apps1ab.dgn	PLOT DATE: 25-SEP-2000
IPARM NAME: sj099apps1ab.i	DRAWN BY: P.R. ROWE
PROJECT LEADER: C.P. WILLIAMS	CHECKED BY: W.B. SYMONDS
DESIGNED BY: W.B. SYMONDS	SHEET 47 OF 118
APPROACH SLAB DETAILS	