


ABUTMENT #2 PLAN

SCALE 1/4" = 1'-0"

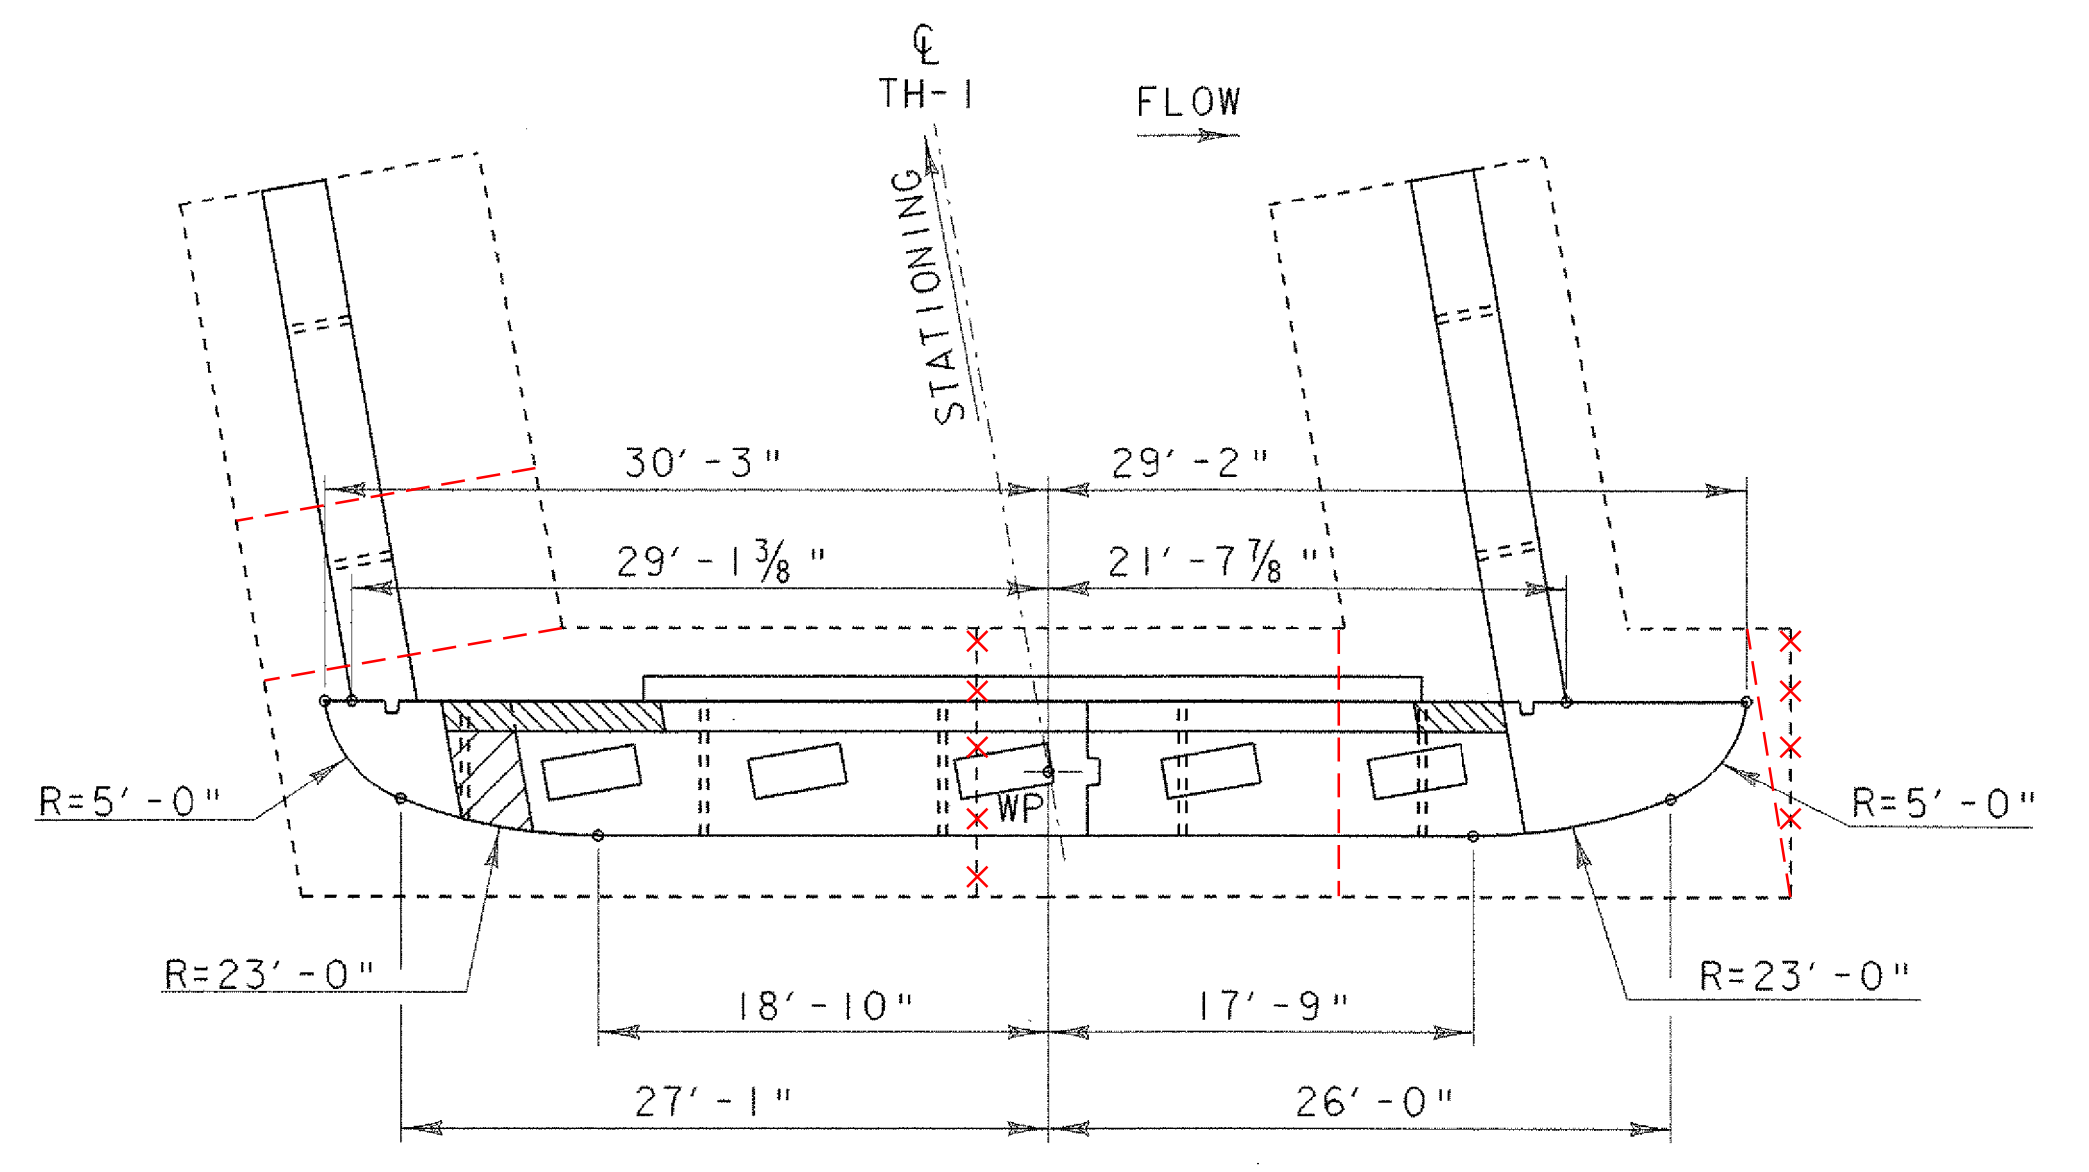

ABUTMENT #2 PLAN  
ADDITIONAL DIMENSIONS

SCALE 1/8" = 1'-0"

- NOTE:
- NF = NEAR FACE
  - FF = FAR FACE
  - EF = EACH FACE
  - ▲ = CUT TO FIT IN FIELD
  - PC = POINT OF CURVATURE
  - C.J. = CONSTRUCTION JOINT
  - ALL LAP SPLICES NOT DETAILED SHALL BE 2'-2"

PROJECT NAME:	ROYALTON BRZ 1444 (22)
PROJECT NUMBER:	
FILE NAME: 89j099/structures/sj099ab2.dgn	PLOT DATE: 25-SEP-2000
IPARM NAME: sj099abut2a.i	DRAWN BY: D.G. BASSETT
PROJECT LEADER: C.P. WILLIAMS	CHECKED BY: C.P. WILLIAMS
DESIGNED BY: K.M. HIGGINS	SHEET 56 OF 118
ABUTMENT #2 PLAN	

FOR GRANITE FACING DETAILS AND NOTES SEE SHEET 66.