
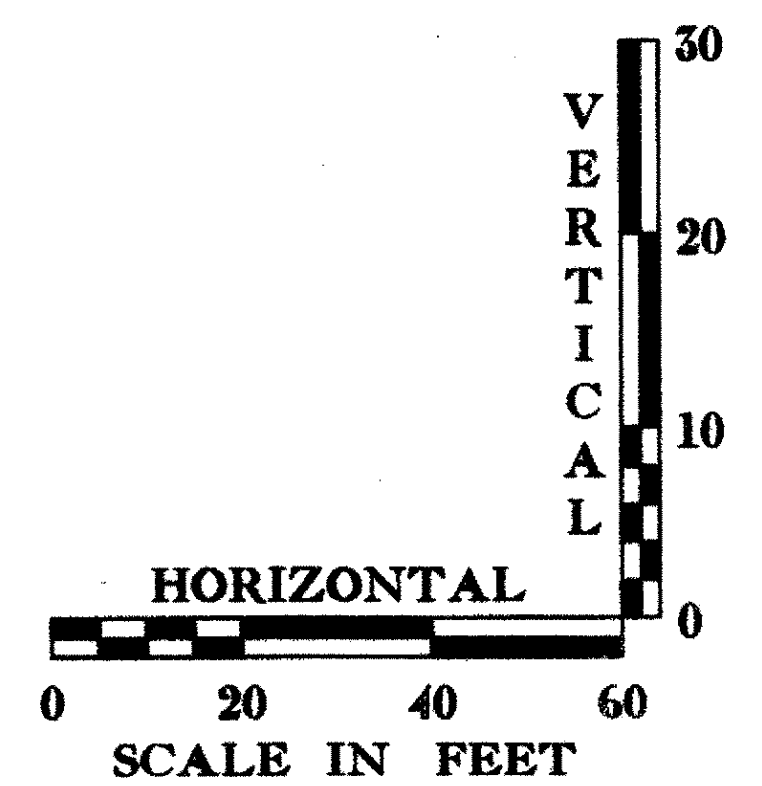
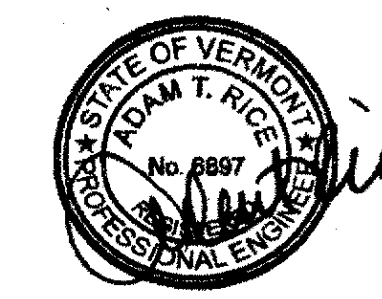


PAY LIMITS: STATION 5+70 AND ROAD STATI


ITEM 629.60
12" WATER MAIN
ON BRIDGE (MOD 1)

ITEM 629.24
12" D.I.P., CLASS 52 (MOD)

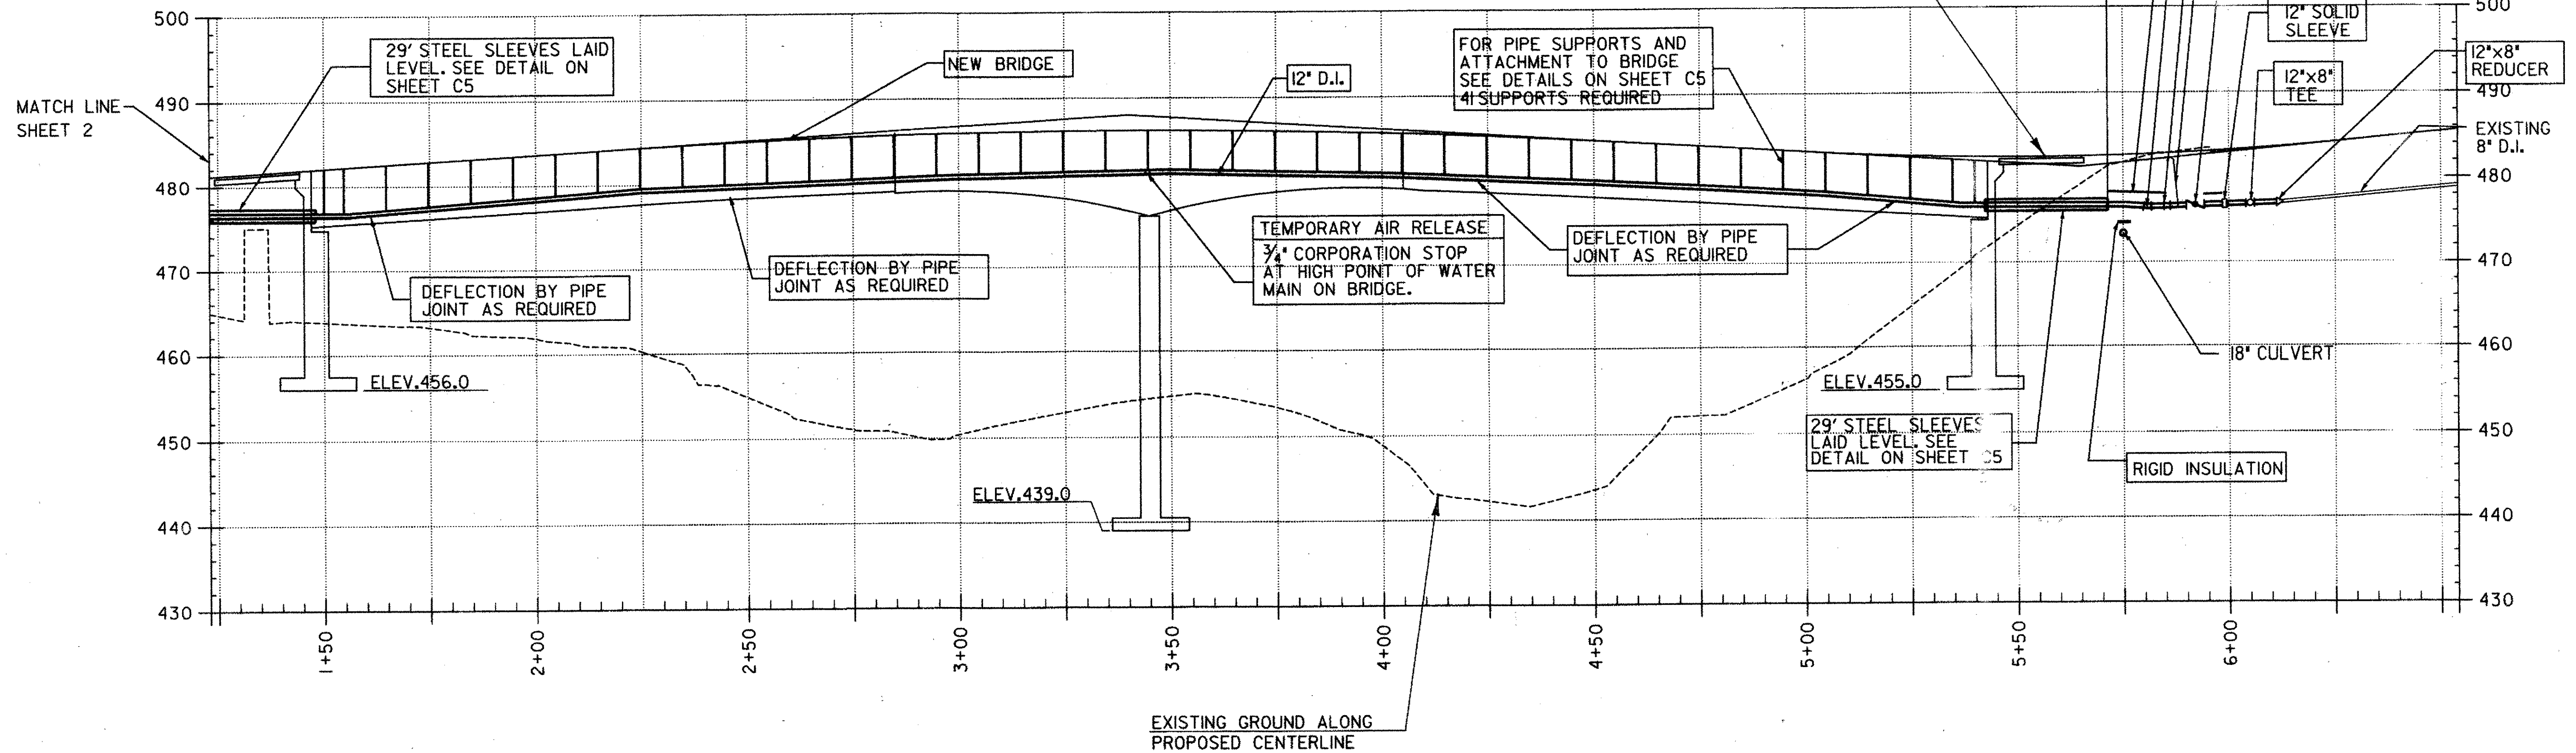

NOTE:
INFORMATION ON THIS SHEET SHOULD ONLY BE
CONSIDERED TO REPRESENT WATER MAIN, PRESSURE
SEWER AND APPURTENANCES. OTHER INFORMATION
SHOWING STRUCTURAL ITEMS, STORM SEWER, AND
SANITARY SEWER IS SHOWN ONLY FOR RELATIVE
RELATIONSHIPS ONLY. THIS INFORMATION SHOULD BE
OBTAINED FROM OTHER DRAWINGS.

PROJECT: ROYALTON	PROJECT NO. : BRZ 1444(22)
DESIGN FILE NAME: <i>zusc/sic4/891099/s1099bdc.dwg</i>	PLOT DATE: 01 JULY 98
IPARM FILE NAME: <i>zusc4/891099/s1099bdc.dwg</i>	SURVEY DATE: 9/29/91
SURVEYED BY: B. GILMAN	DRAWN BY: JLB
SQUAD LEADER: C.P. WILLIAMS	SHEET: 79 OF 118
UTILITY PROFILE	

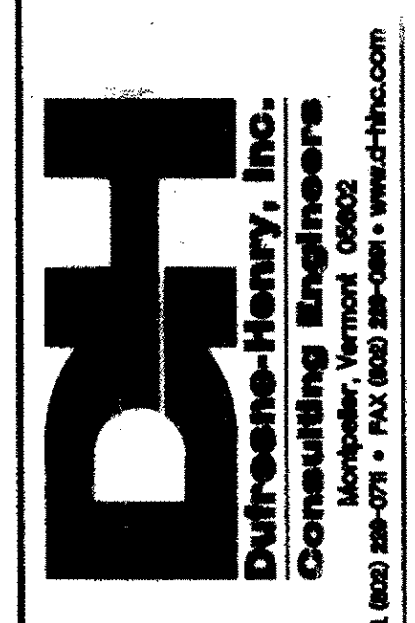

REV.	DESCRIPTION	BY	DATE
6-8-00	BLB	BLB	6-8-00
5-26-00	EET	EET	5-26-00
5-2-00	BLB	BLB	5-2-00

TOWN OF ROYALTON AND ROYALTON FIRE DISTRICT No. 1
WHITE RIVER BRIDGE UTILITY CROSSINGS
UTILITY PROFILE
STA. 1+23 TO 6+25

Project No. 6170051
Proj. Manager A. T. RICE
Proj. Designer R. N. GOODWIN
Drawn By M. A. M./L. A. W.
Checked By A. T. RICE
Scale AS SHOWN
Approved <i>A. T. Rice</i>
Date APRIL 2000

Sheet 3 of 5
D 6170051