



WORK ORDER

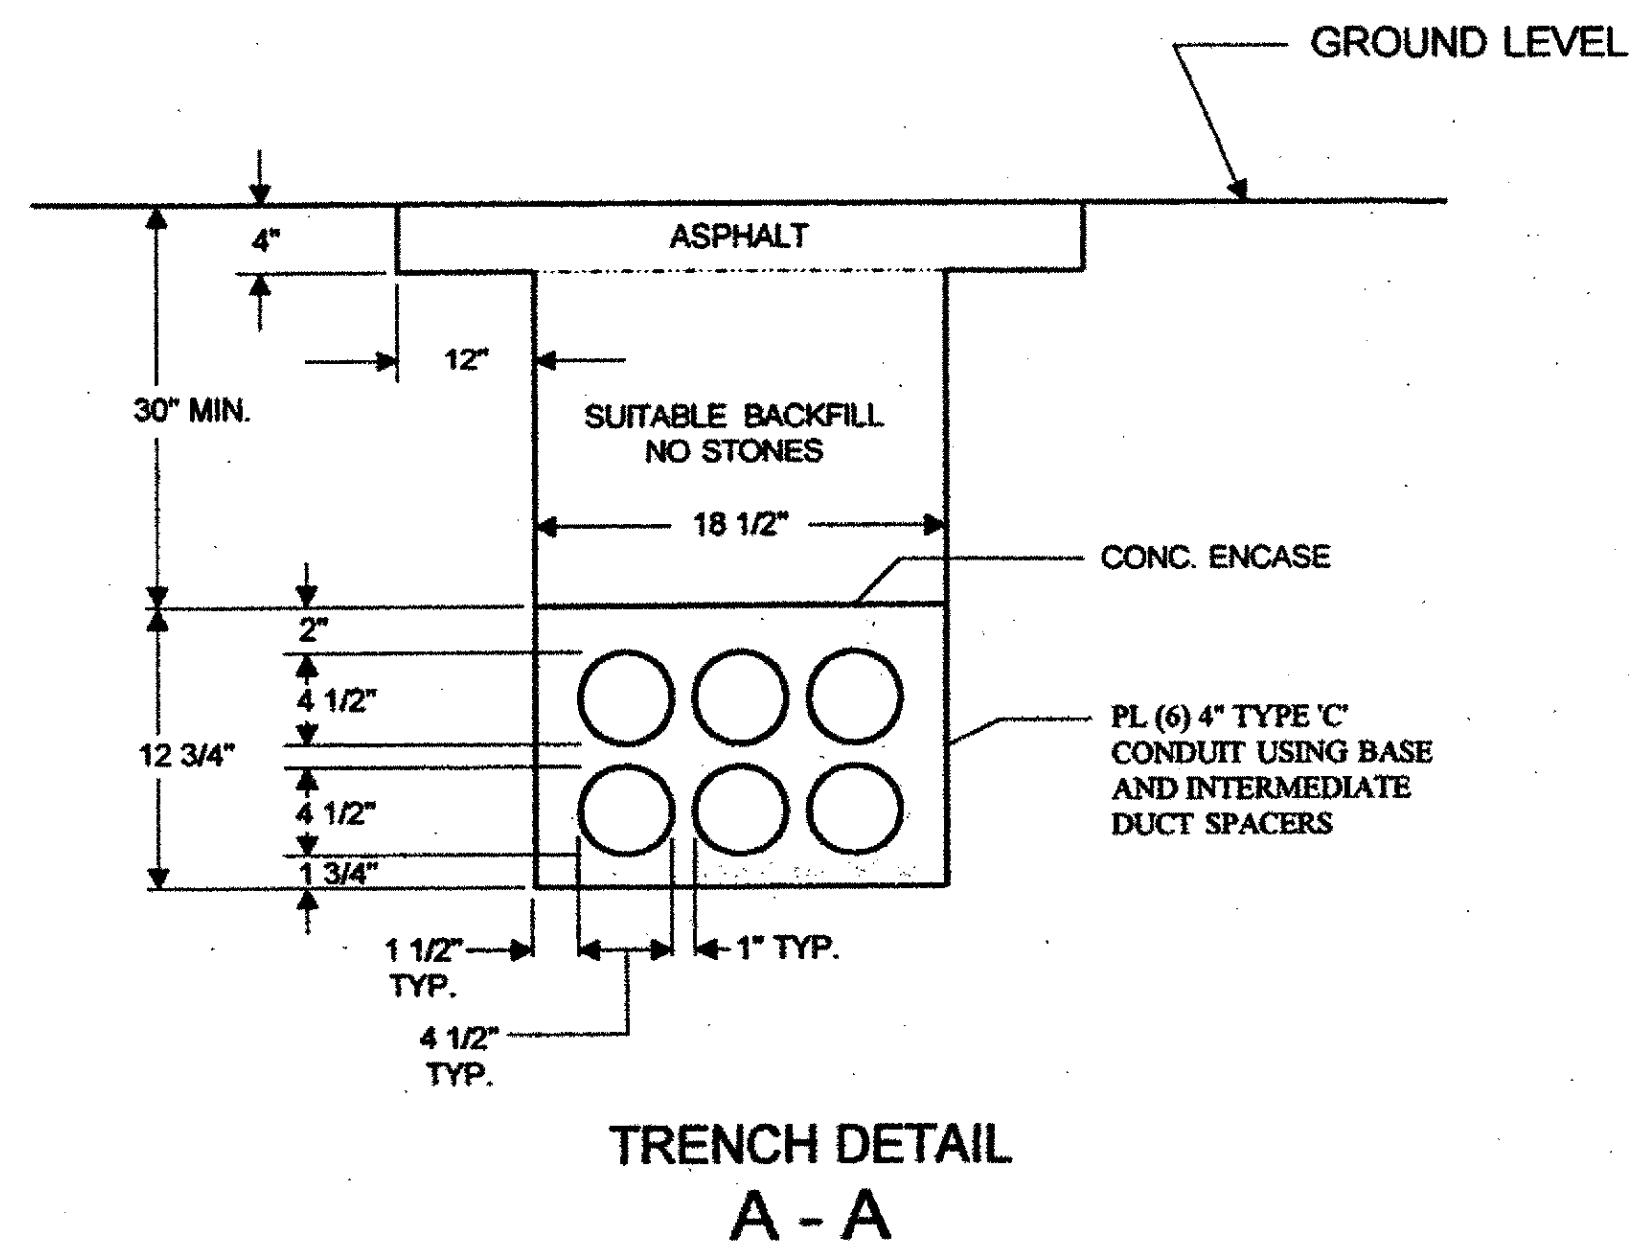

Note :
Existing vacant duct terminators are under the existing ductbank

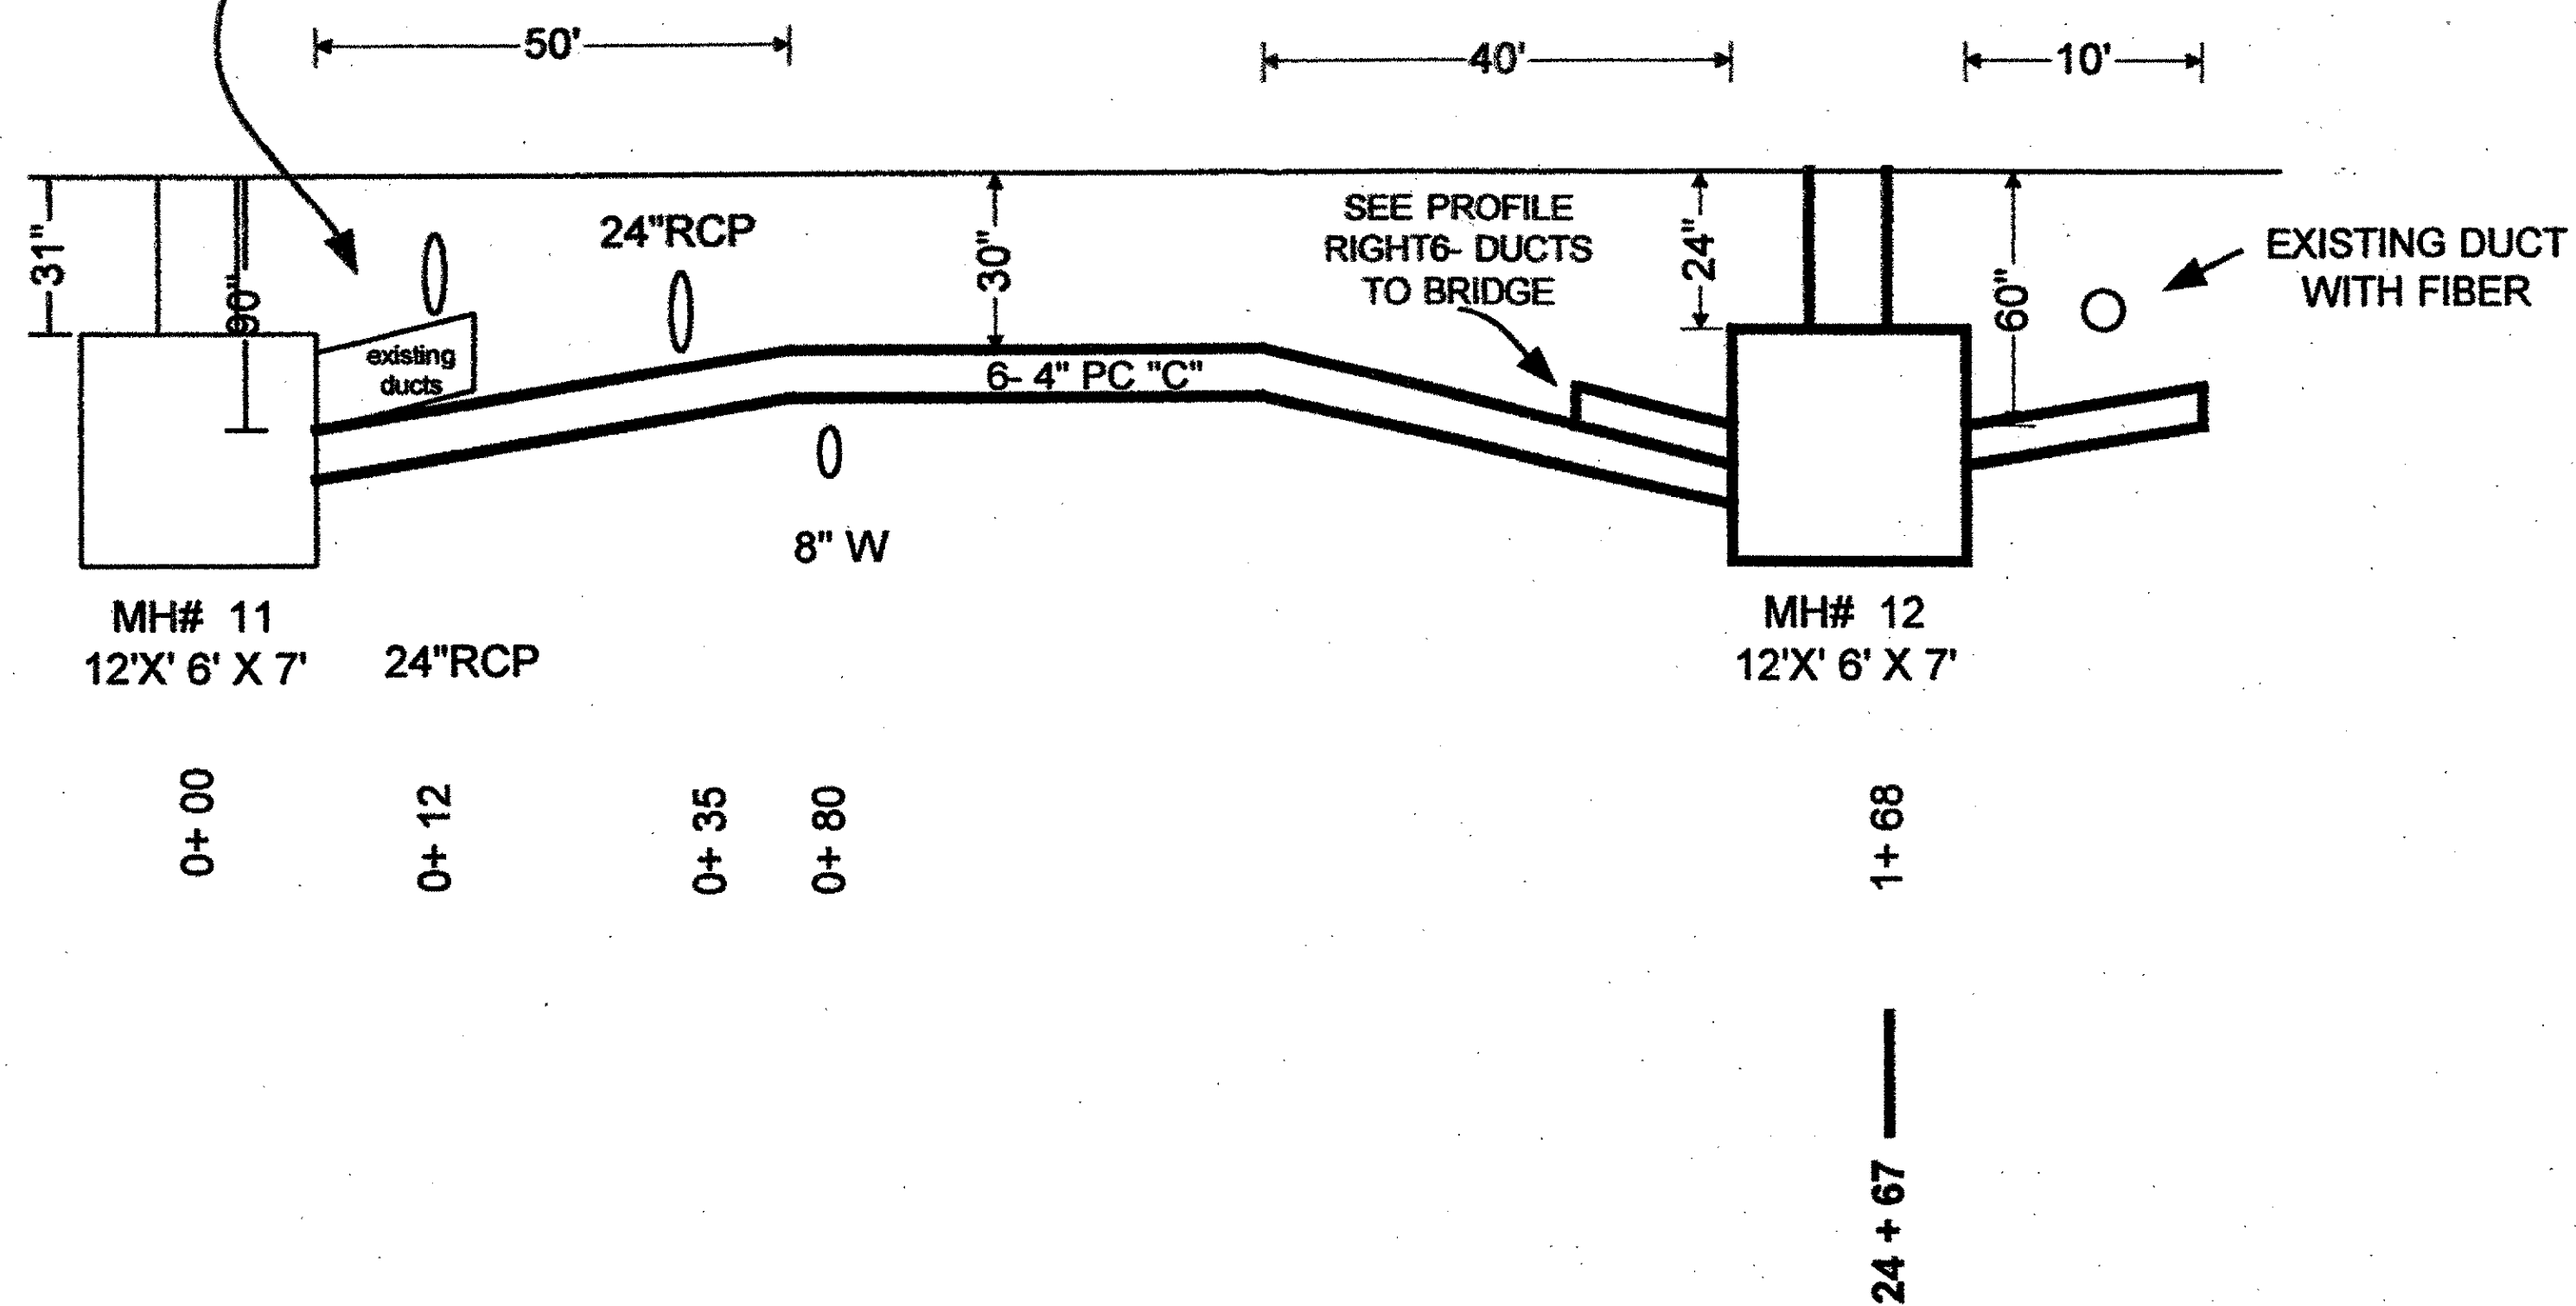


PROFILE FOR PLAN 1

Notice: Not for Use/disclosure outside of BELL ATLANTIC without written agreement

BELL ATLANTIC

	SAFETY NOTES: TRAFFIC , BRIDGE CONSTRUCTION		MOD/REV NO.	DATE	EWO NO.
	SIGNATURE				PRINT 5 OF
	DATE 5/18/2000				PREPARED BY: J. BRIAN GRESL
	TYPE				C.O. /EXCHANGE NAME: S. ROYALTON
PRE CT YES <input type="checkbox"/> NO <input checked="" type="checkbox"/>	UNDERGROUND		RECORD REF: 5	C.O. /EXCHANGE CODE: 4875	
PRIMARY VOLTAGE TO GROUND 7.2 KV MGN SYSTEM	BLOCK (NYT)			MUNICIPALITY: ROYALTON	
CABLE PRESS. TRANSMISSION	UNDER PRESS. YES <input type="checkbox"/> NO <input checked="" type="checkbox"/>	26GA LIMIT YES <input type="checkbox"/> NO <input checked="" type="checkbox"/>	CONDUIT	4	MANHOLE LOCATION MH# NA
			AMT. BRIDGE TAP	INPUT	KF

PROJECT - 131154

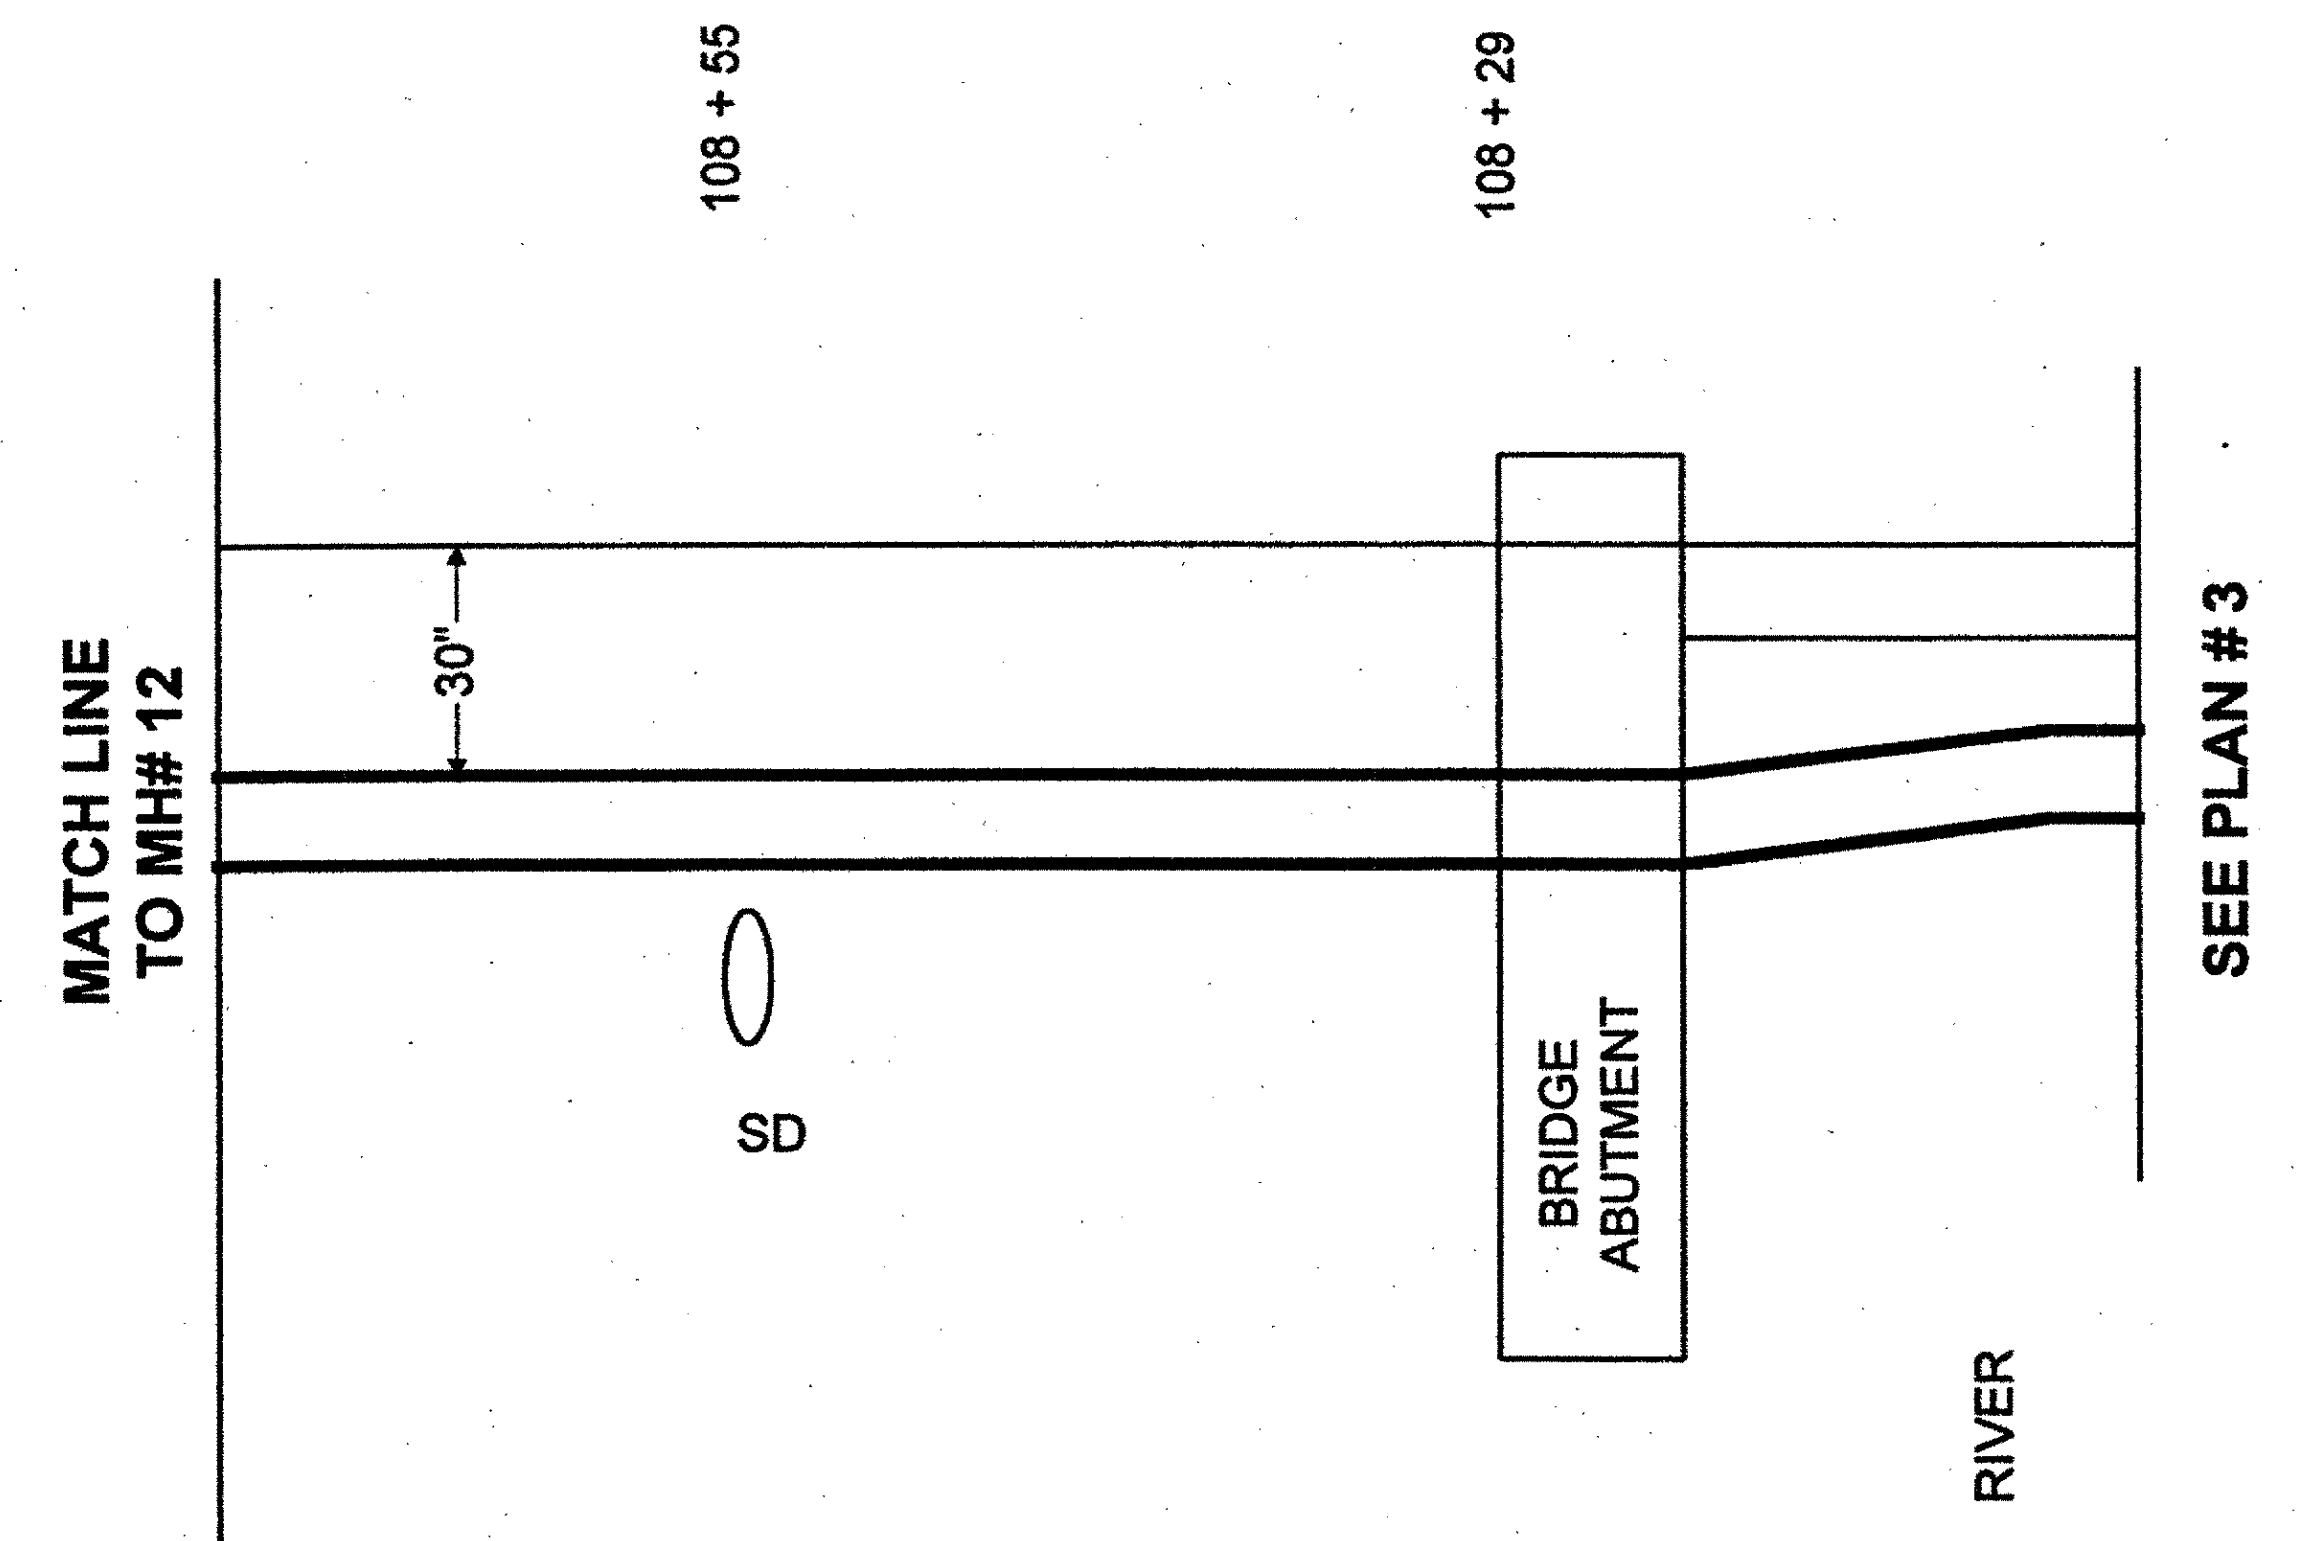

SEE PLAN #3

6/23/00

RECEIVED
JUN 26 2000
UTILITIES
Sheet 87 of 118