



Deck Towers - DOWNSTREAM

3-01-02

ROYALTON  
AC BRZ 1444 L22,  
BREQ & BELLOC I,  
ESTY CNST

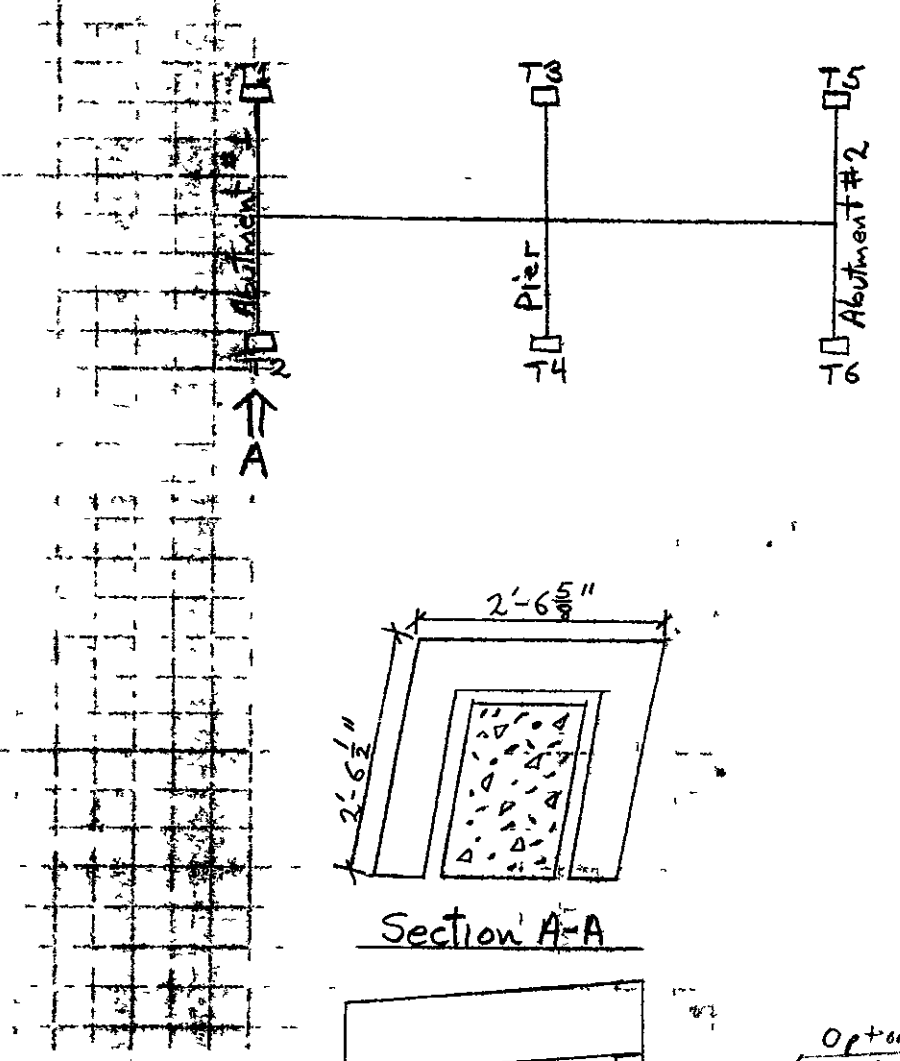

Section A-A

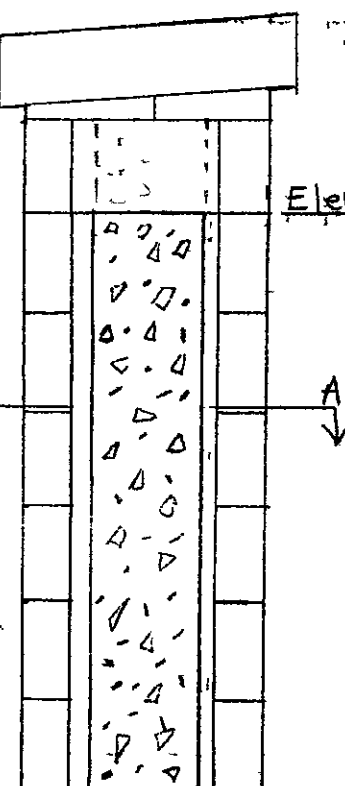

Optional Construction Joint  
Joint shall be Filled With  
Concrete After Top Course  
is in place

Elev. T2 = ~~4.000~~  
T4 = ~~4.000~~  
T6 = ~~4.000~~

RECEIVED  
ORD BY: *KS*    ORD BY:  
APR 23 2002  
RESUBMIT    APPROVED: *[Signature]*  
BY    DATE: 4/13/02

Elevation View A  
T4 and T6 Similar