


RECEIVED  
CROBY, K.S. ON BEHALF OF  
APR 23 2002

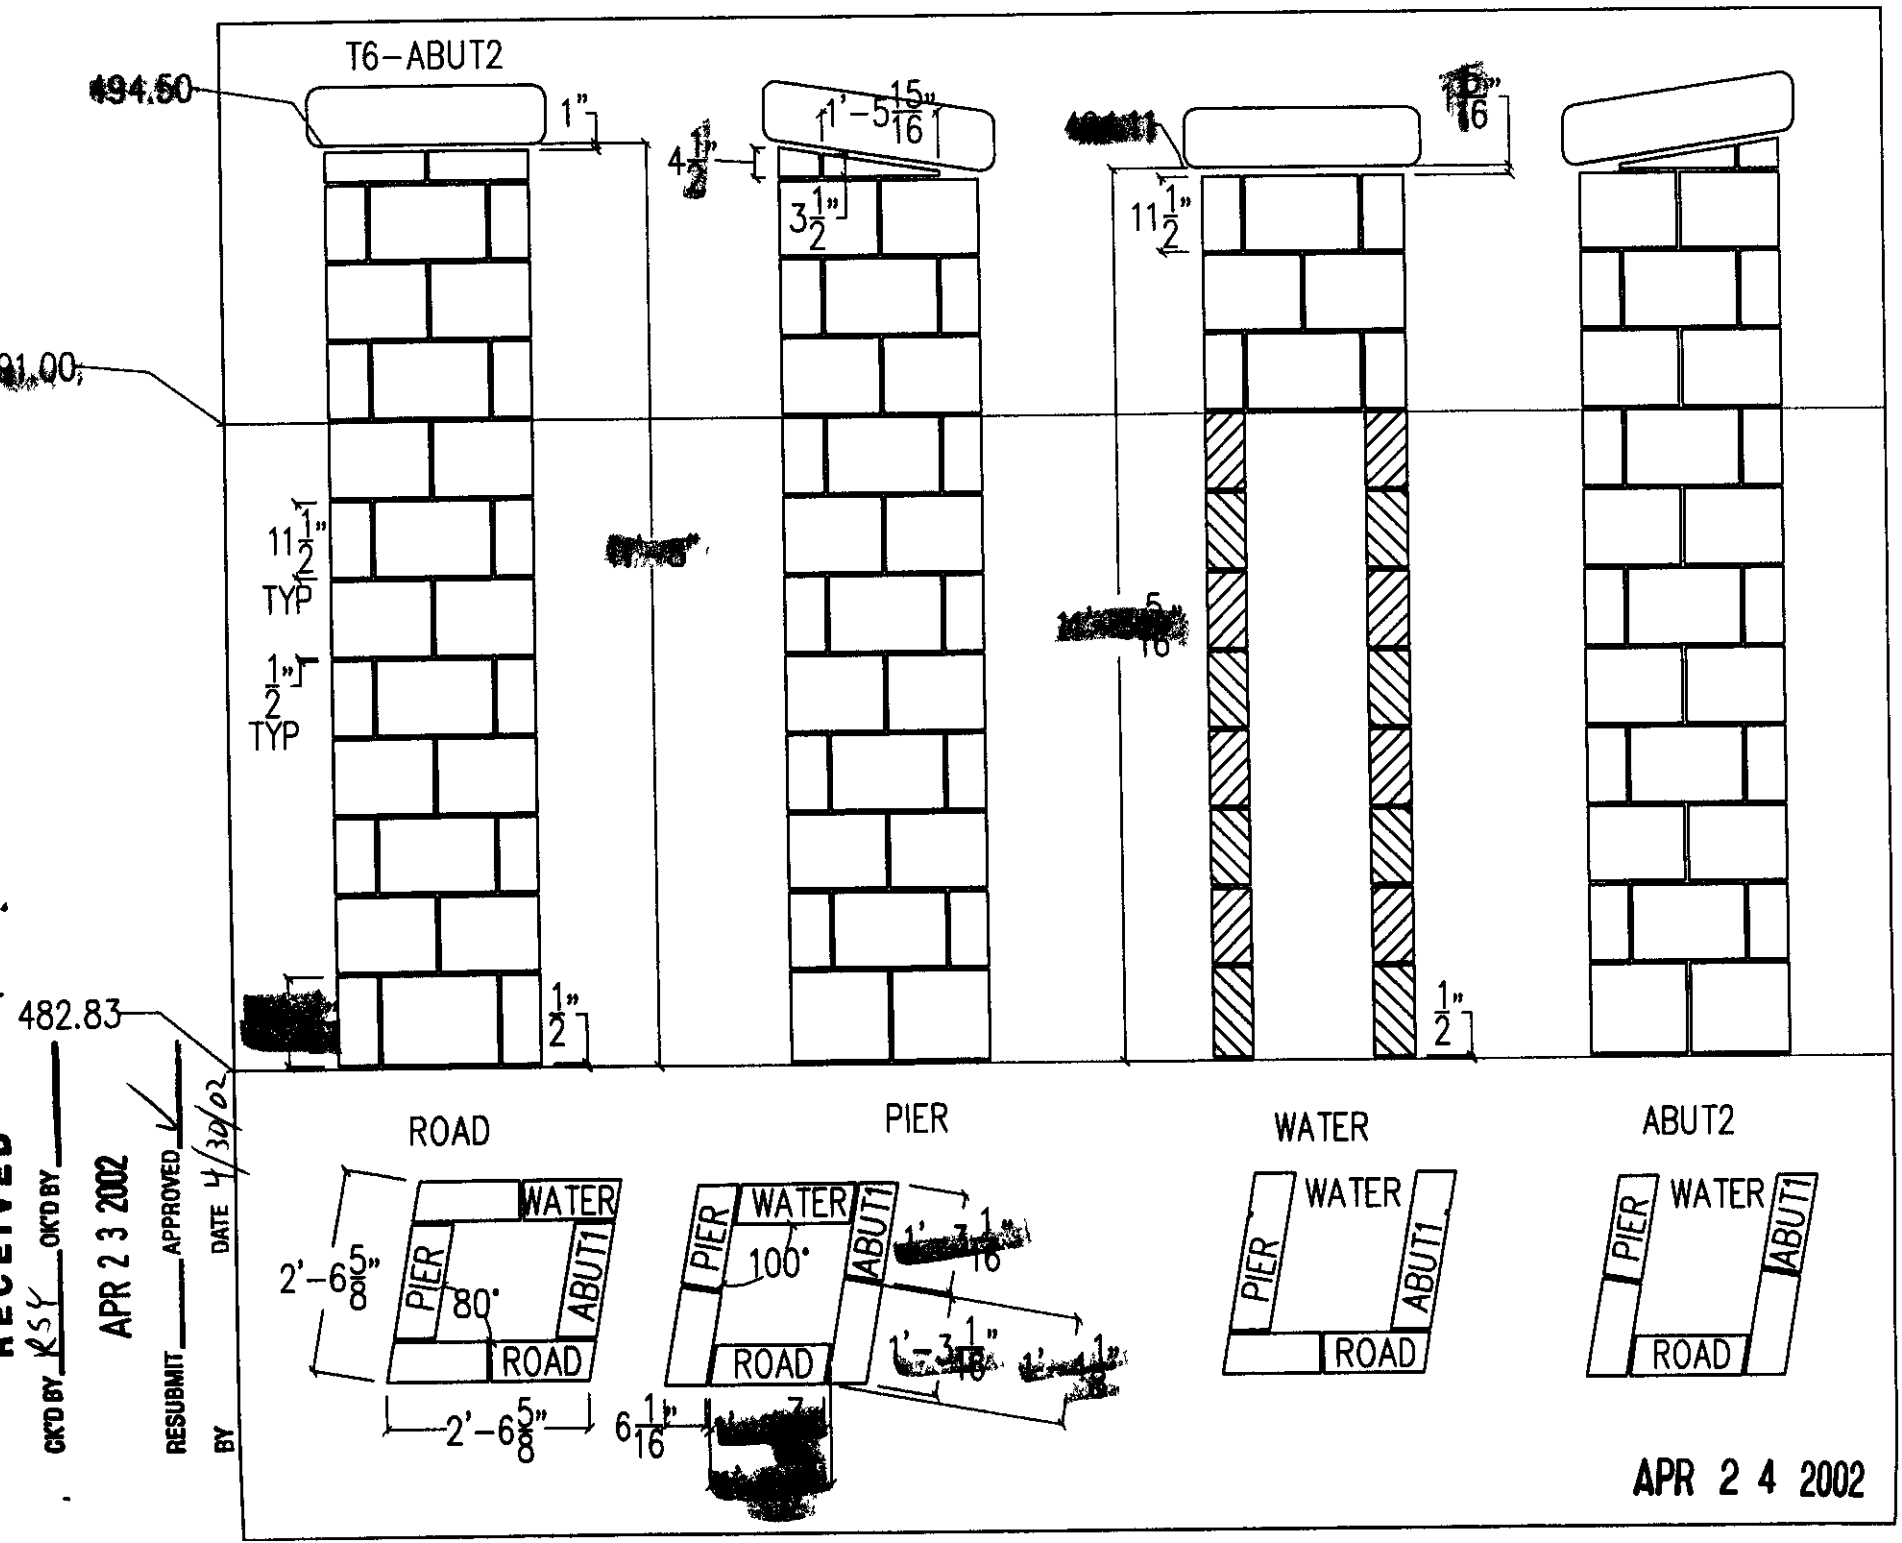

APR 24 2002