


SHOP NOTE :  
 ⊗ - INDICATES LOCATION OF SHIPPING PIECE MARK

5 - SOLE PLATE ASSEMBLY - 1A

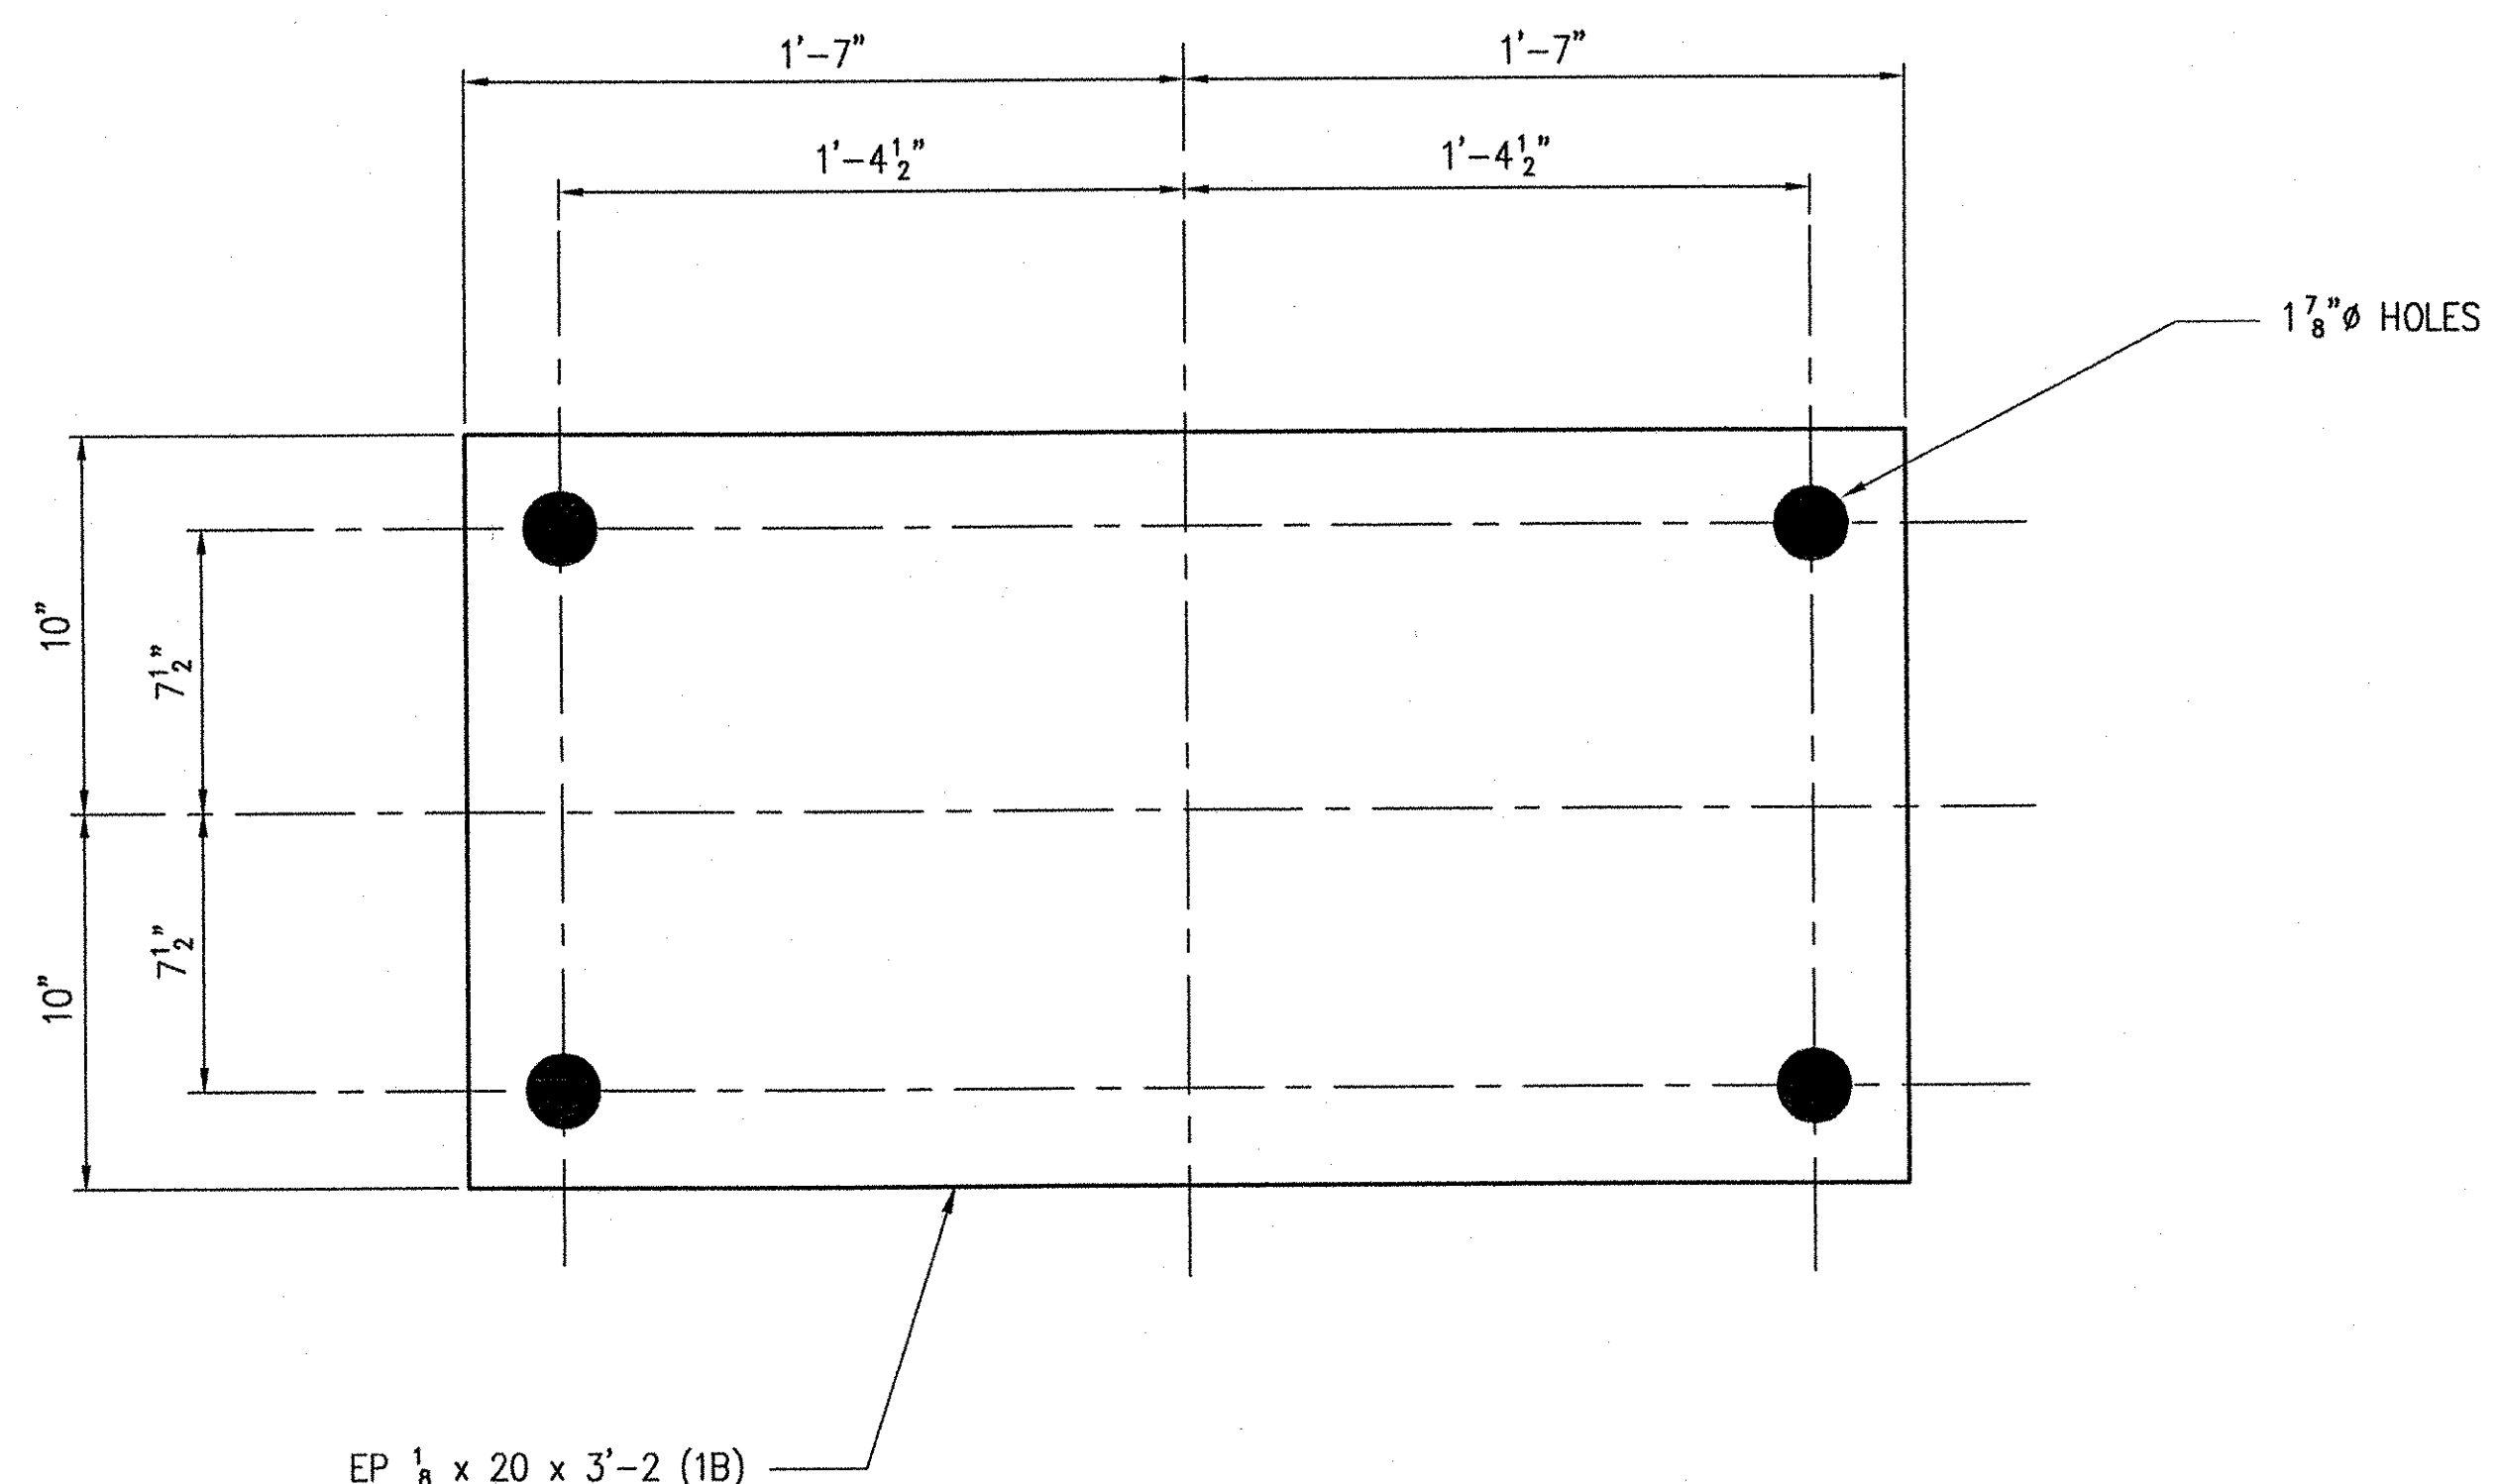

5 - BEARING PADS - 1B

RECEIVED  
 DWD BY WJS CRD BY RSY  
 MAR 12 2001  
 REQUEST APPROVED BY Noted  
 BY OPW DATE 3/27/01

LINE NO.	NO. REQ'D	DESCRIPTION	LENGTH	MK	REMARKS	PART NO.
1	5	SOLE PLATE ASSEMBLY		1A	METALIZE/PAINT	
2	5	PL 3 1/4 x 14 A709 GR. 50	2'-2 1/2	pa1	MACH./ ADD MAT'L. FOR MACH.	
3	5	PL 1 x 2 1/2 A709 GR. 50	0'-5	ba1		19-60
4						
5						
6	5	BEARING PADS		1B	B	
7	5	EP 1/8 x 20	3'-2	1B	SEE NOTE 4	
8						
9						
REV.	DESCRIPTION	DATE	INT.
	ANY AND ALL BACKCHARGES WILL BE REJECTED UNLESS WRITTEN CONSENT IS GIVEN BY LEWIS ENGINEERING COMPANY PRIOR TO ANY WORK PERFORMED FOR OUR ACCOUNT. SUCH REJECTION MEANS THAT INVOICES WILL NOT BE HONORED OR DEDUCTIONS FROM PAYMENT WILL BE CHARGED BACK.		
<b>LEWIS ENGINEERING COMPANY</b> 4201 NOREA DRIVE - CHASKA, MINNESOTA 55318 - (612) 368-3000			
PROJECT	ROYALTON/ RTE. NO. TH 1, CL 1 BRIDGE NO. 3		
STATE PROJECT	AC BRZ 1444(22)		
FEDERAL PROJECT	-		
CUSTOMER	BECK & BELLUCCI, INC.		
LOCATION	WINDSOR COUNTY, VT		
DESCRIPTION	PIER FIXED BEARING DETAILS		
FOR PRINTS ISSUED	DATE		

W.P. ch'k'd JDK  
 Drawn By TSF  
 Ch'k'd. By NY  
 Date: 2/01

GENERAL NOTES: SEE SHT. G01.