



1 - SUB-ASSEMBLY - 9A
(SOME HIDDEN LINES REMOVED FOR CLARITY)

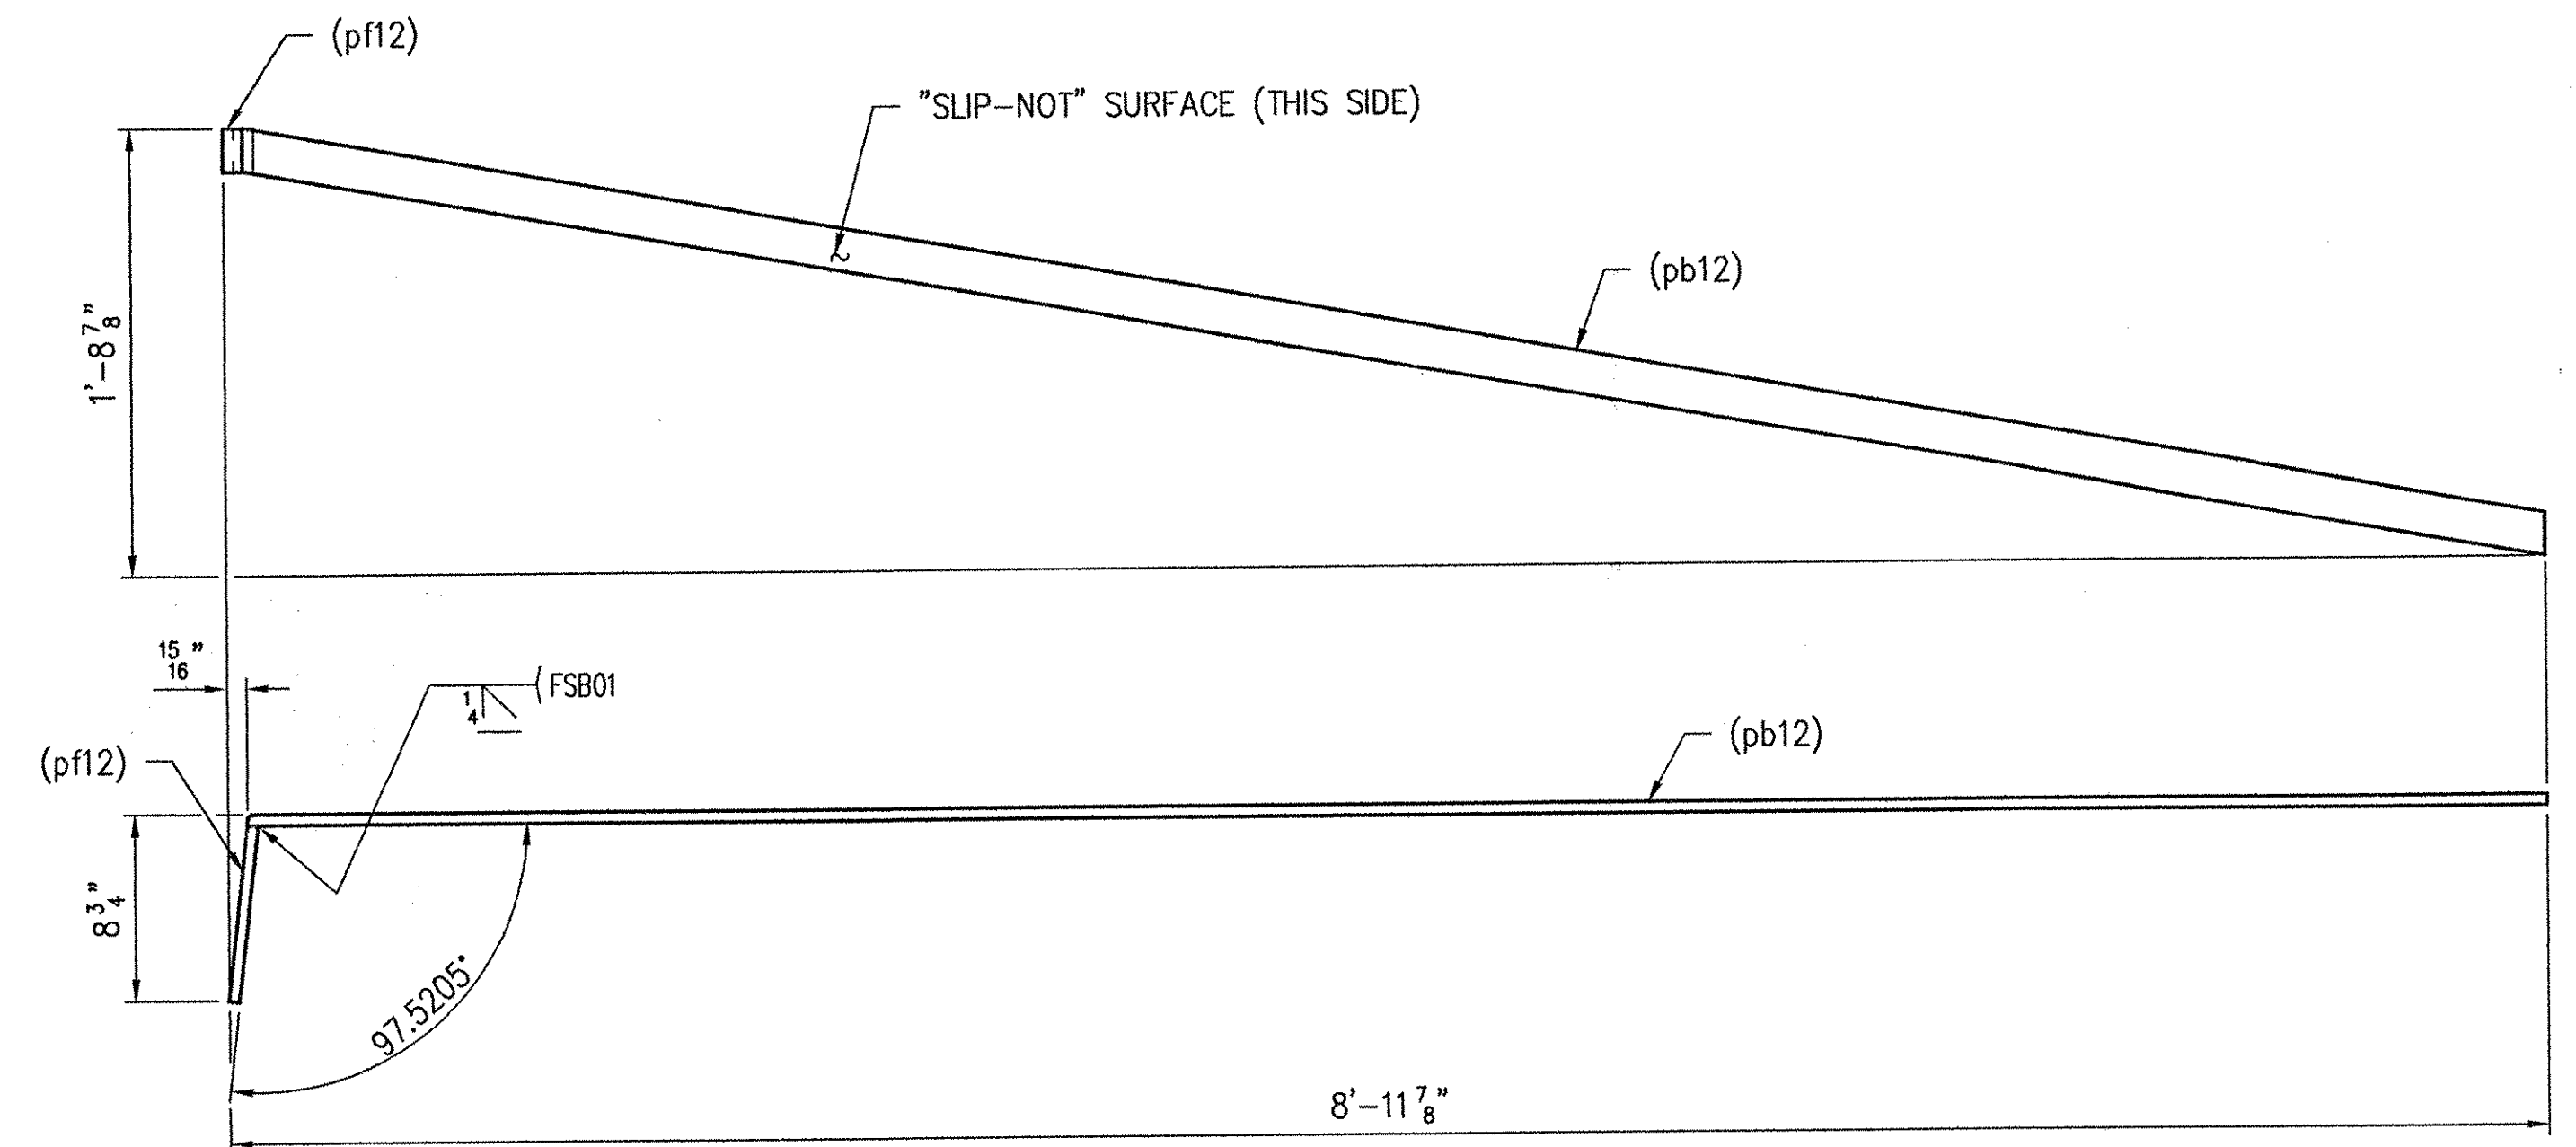

1 - SUB-ASSEMBLY - 9C

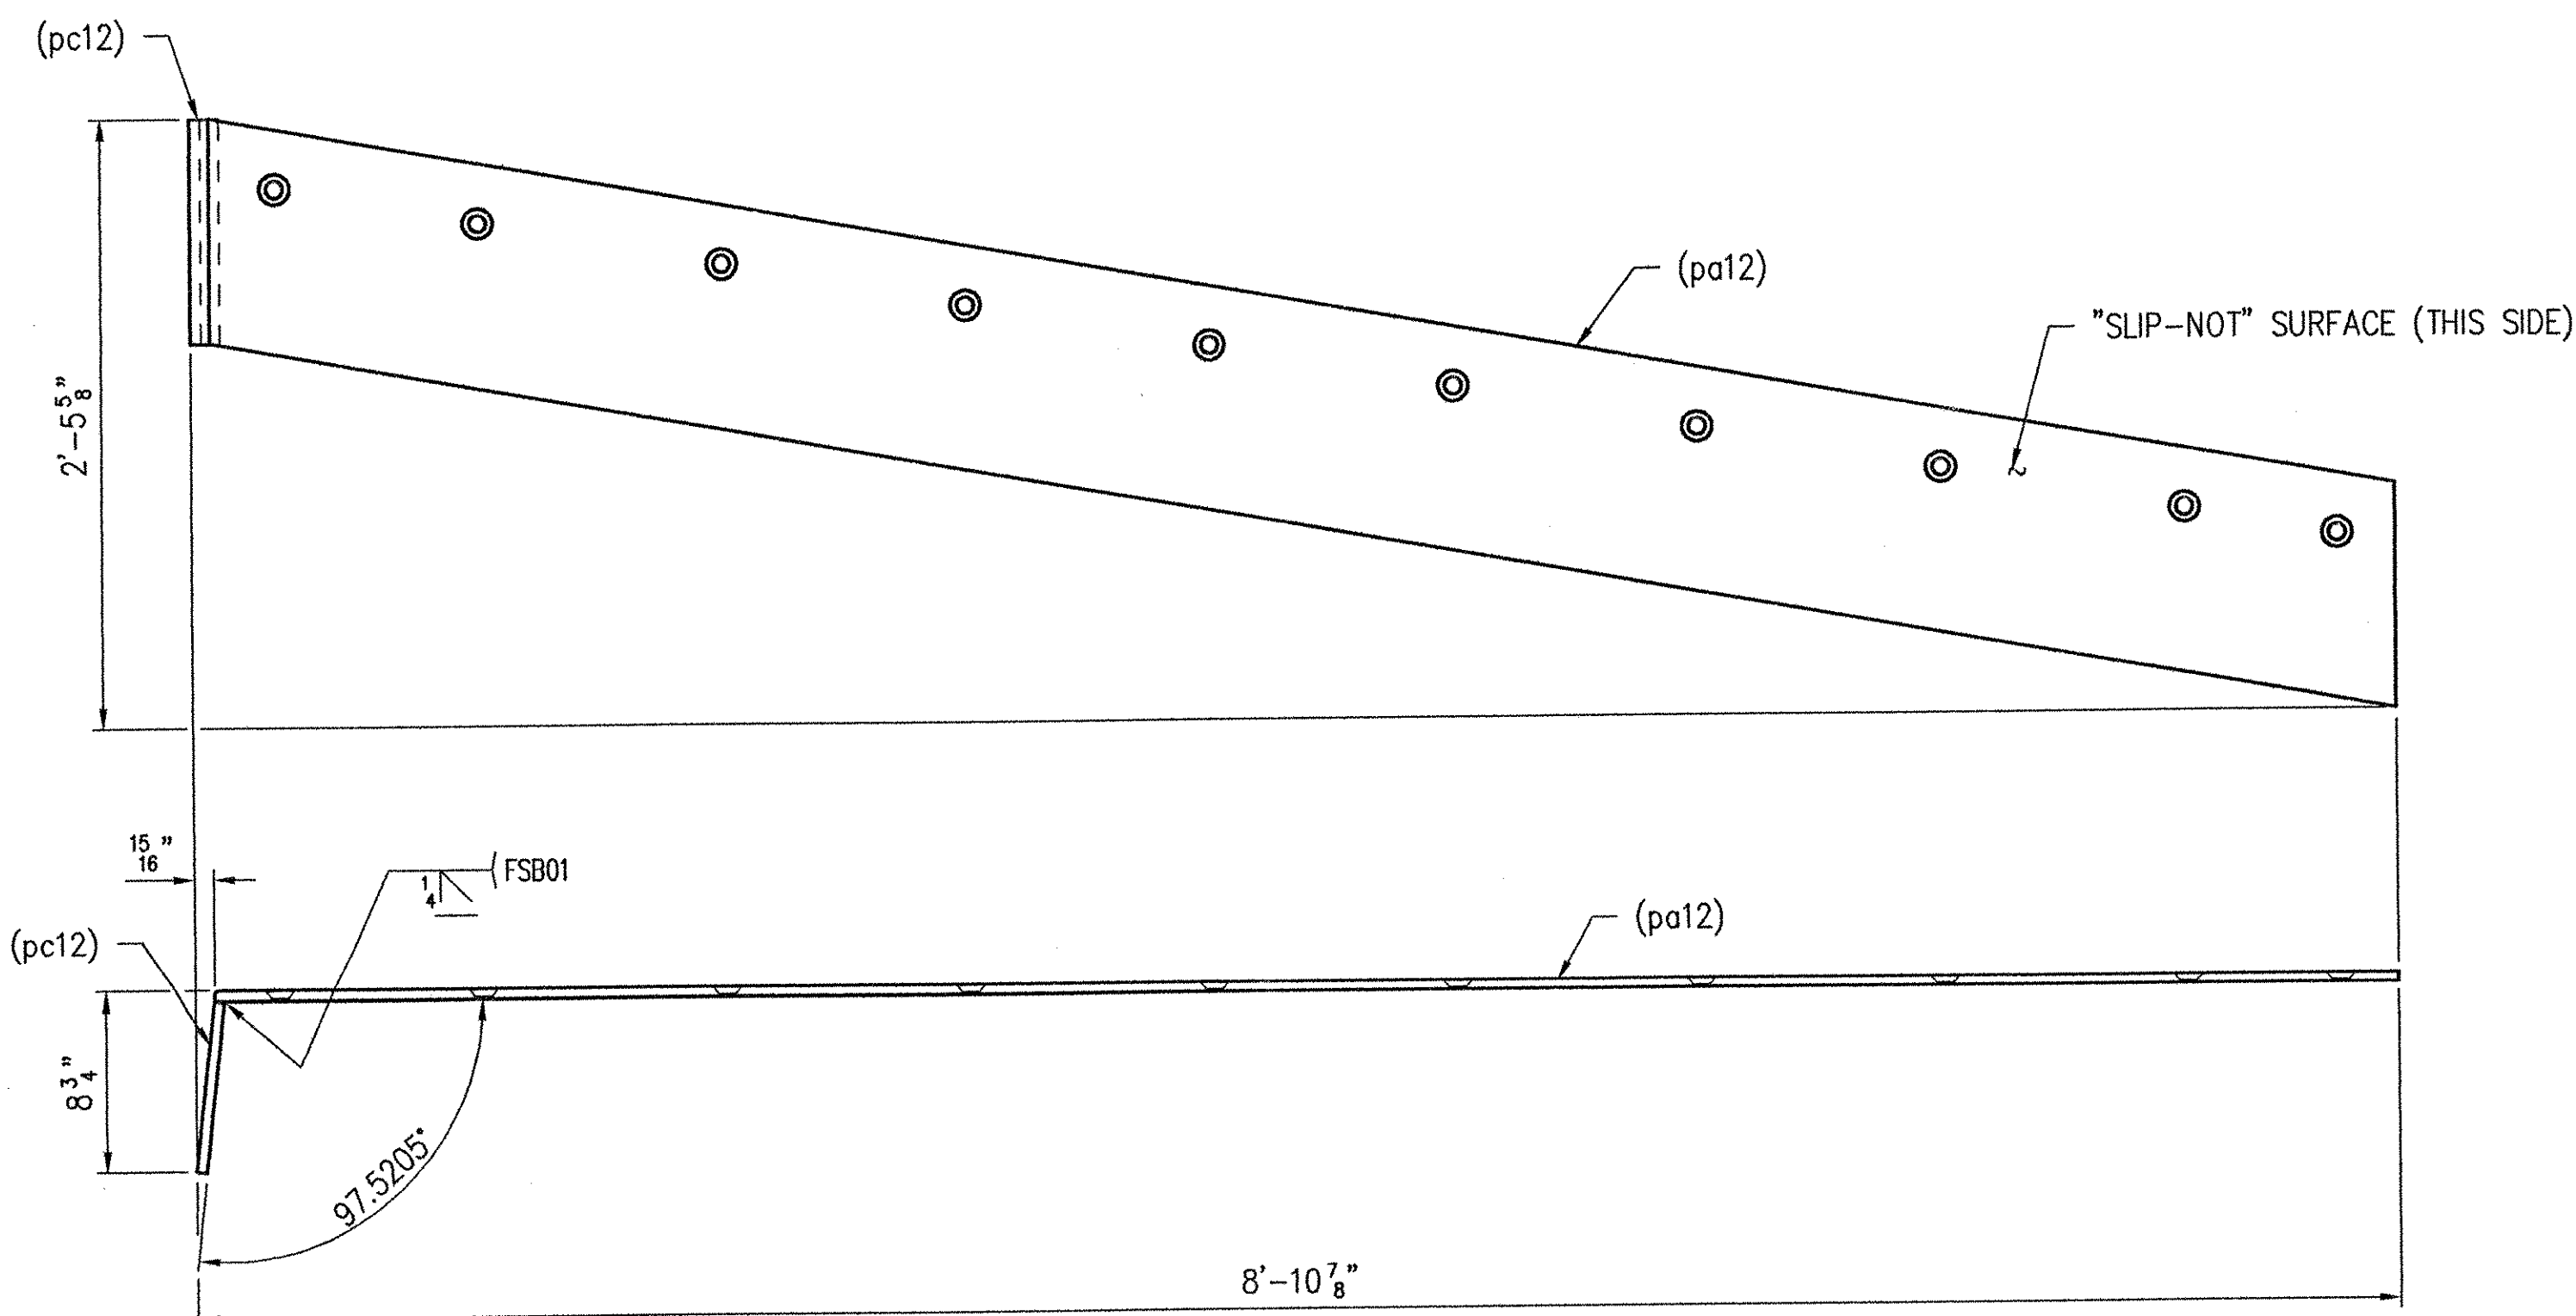

1 - SUB-ASSEMBLY - 9B

SEE SHEET NO. 15 FOR GENERAL NOTES.
WORK THIS SHEET WITH SHEET NO. 8, 10, 11 & 12.

REV.	DESCRIPTION	DATE	INT.
1	GENERAL REVISION PER APPROVAL.	1/3/02	JMB

ANY AND ALL BACKCHARGES WILL BE REJECTED UNLESS WRITTEN CONSENT IS GIVEN BY LEWIS ENGINEERING COMPANY PRIOR TO ANY WORK PERFORMED FOR OUR ACCOUNT. SUCH REJECTION MEANS THAT INVOICES WILL NOT BE HONORED OR DEDUCTIONS FROM PAYMENT WILL BE CHARGED BACK.

LEWIS ENGINEERING COMPANY
4201 NOREX DRIVE - CHASKA, MINNESOTA 55318 - (952) 368-3000

SHOP	PROJECT	ROYALTON / RTE. NO. TH 1, CL 1 BRIDGE NO. 3
	STATE PROJECT	AC BRZ 1444(22)
	FEDERAL PROJECT	
APPROVAL	CUSTOMER	BECK & BELLUCCI, INC.
	LOCATION	WINDSOR COUNTY, VT
DIST.	DESCRIPTION	EXPANSION JOINT DETAILS ABUTMENT NO. 2
CUST.		
FOR DATE	L.E.C. 9 OF 30	SHEET NO. 9 OF 15
PRINTS ISSUED		Job. No. : 2034.1042.1

RECEIVED
CR'D BY *WJS* OK'D BY _____
JAN 11 2002
RESUBMIT APPROVED
BY *CPW* DATE *1/11/02*

W.P. ch'k'd
Drawn By JMB
Chk'd. By TSF
Date: 12/5/01