

MAIN INDEX

1. TITLE SHEET
2. INDEX OF SHEETS AND STANDARDS

STATE OF VERMONT AGENCY OF TRANSPORTATION



PROPOSED IMPROVEMENT BRIDGE PROJECT


TOWN OF ROYALTON
COUNTY OF WINDSOR

ROUTE NO : TH 1, CL 1 BRIDGE NO: 3


PROJECT LOCATION : BEGINNING AT A POINT ON TH 1 APPROXIMATELY 0.149 MILES
SOUTHERLY OF THE INTERSECTION WITH VT 14 AND EXTENDING
NORTHERLY ALONG TH 1 FOR A DISTANCE OF 0.149 MILES.

PROJECT DESCRIPTION : CONSTRUCTION OF A NEW BRIDGE WITH NECESSARY ROADWAY
APPROACHES AND CHANNEL WORK.

LENGTH OF STRUCTURE :	397.83	FEET.
LENGTH OF ROADWAY :	390.72	FEET.
LENGTH OF PROJECT :	788.55	FEET.

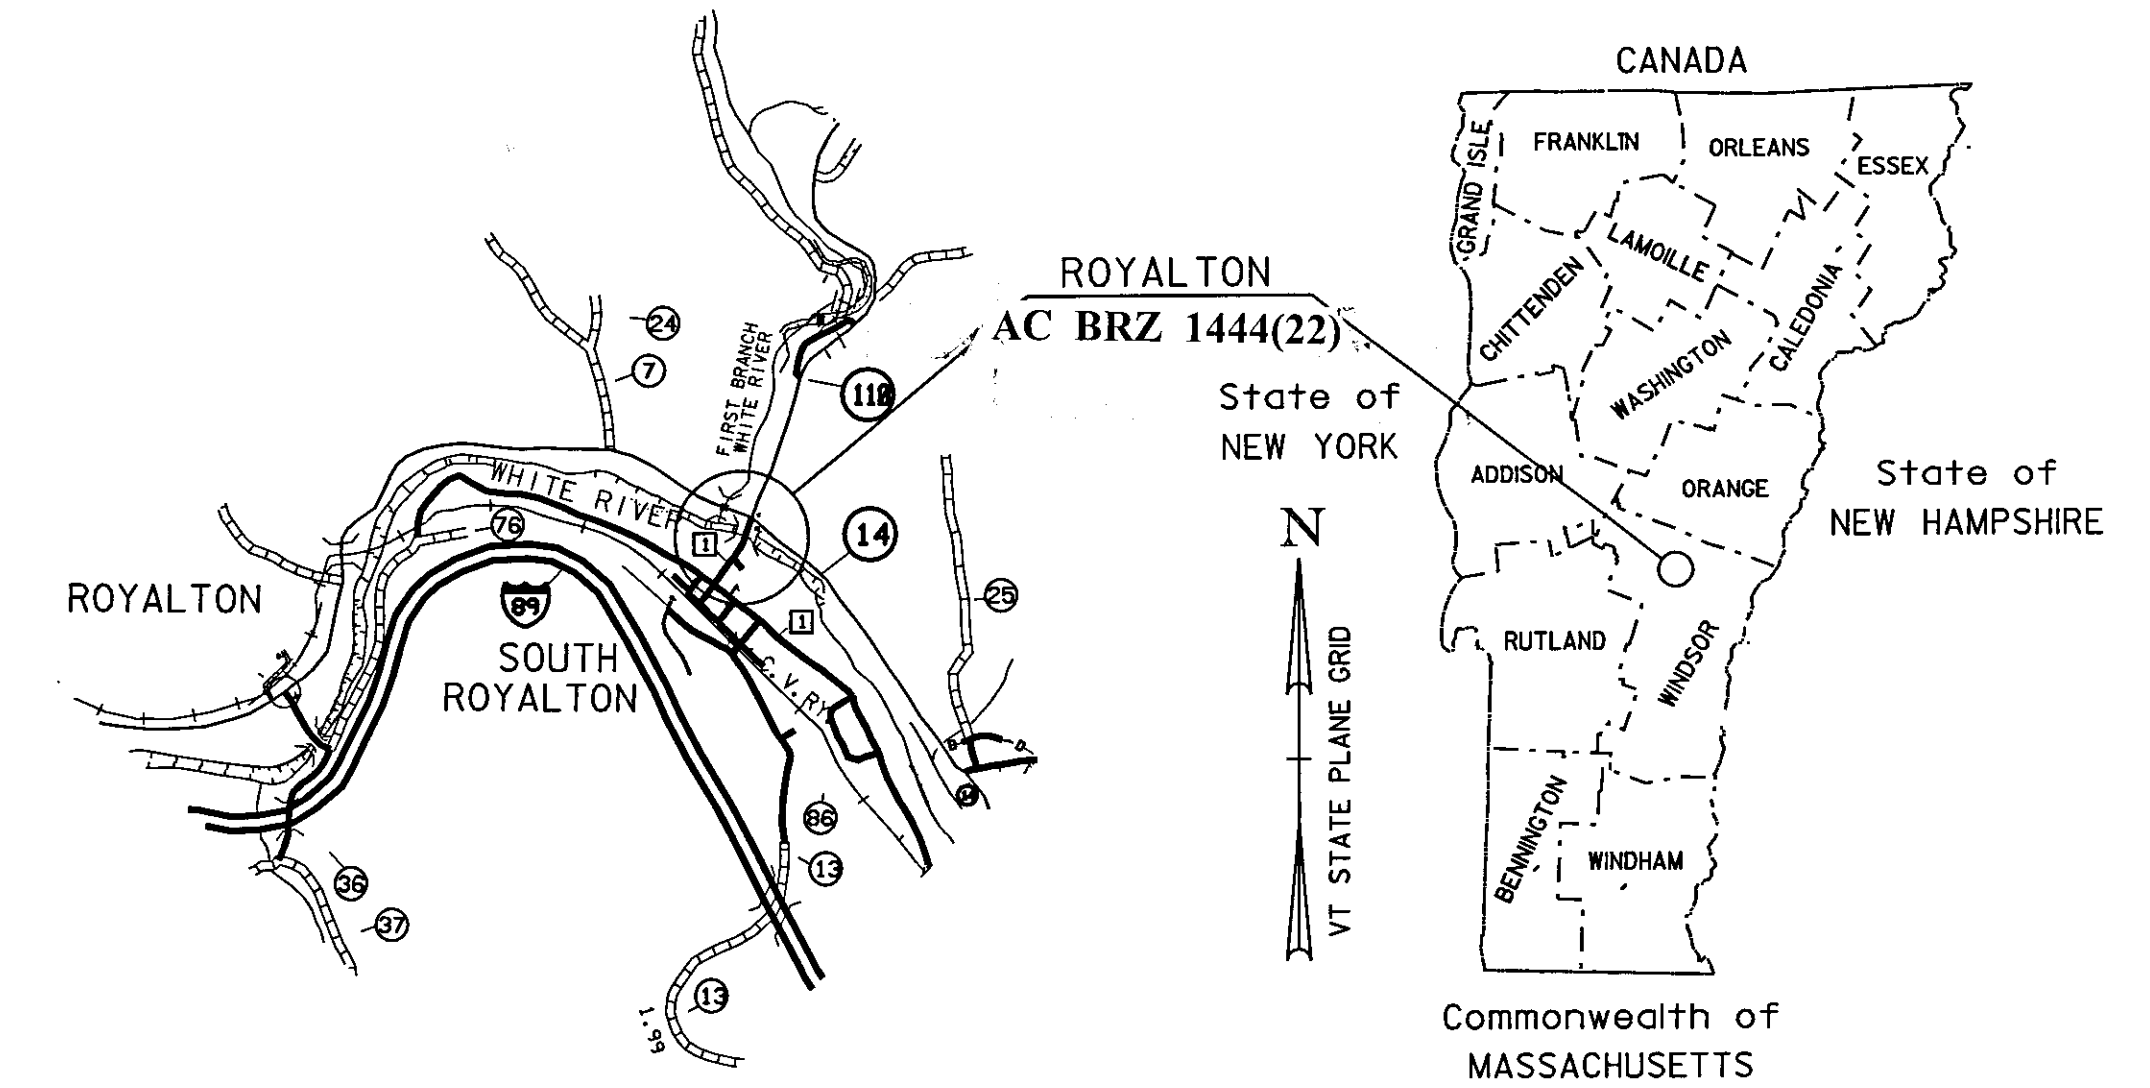

RECORD PLANS	
CONTRACTOR:	BECK & BELLUCCI INC.-FRANKLIN, NH
RESIDENT ENGINEER:	JACQUES COUTURE
CONSTRUCTION BEGAN:	APRIL 19, 2001
CONSTRUCTION COMPLETE:	JUNE 6, 2003
RECORD PLANS BY:	JACQUES COUTURE & KEVIN NORTH
I HEREBY CERTIFY THAT ALL THE CONSTRUCTION REQUIRED BY THIS SET OF DRAWINGS HAS BEEN ACCOMPLISHED AS INDICATED HEREIN.	
BY	<i>Jacques Couture</i> RESIDENT ENGINEER
DATE	7/21/2011
NOTE: Any further information concerning final quantities, amounts or other details relative to this project may be found at Central Files in the electronic archives.	

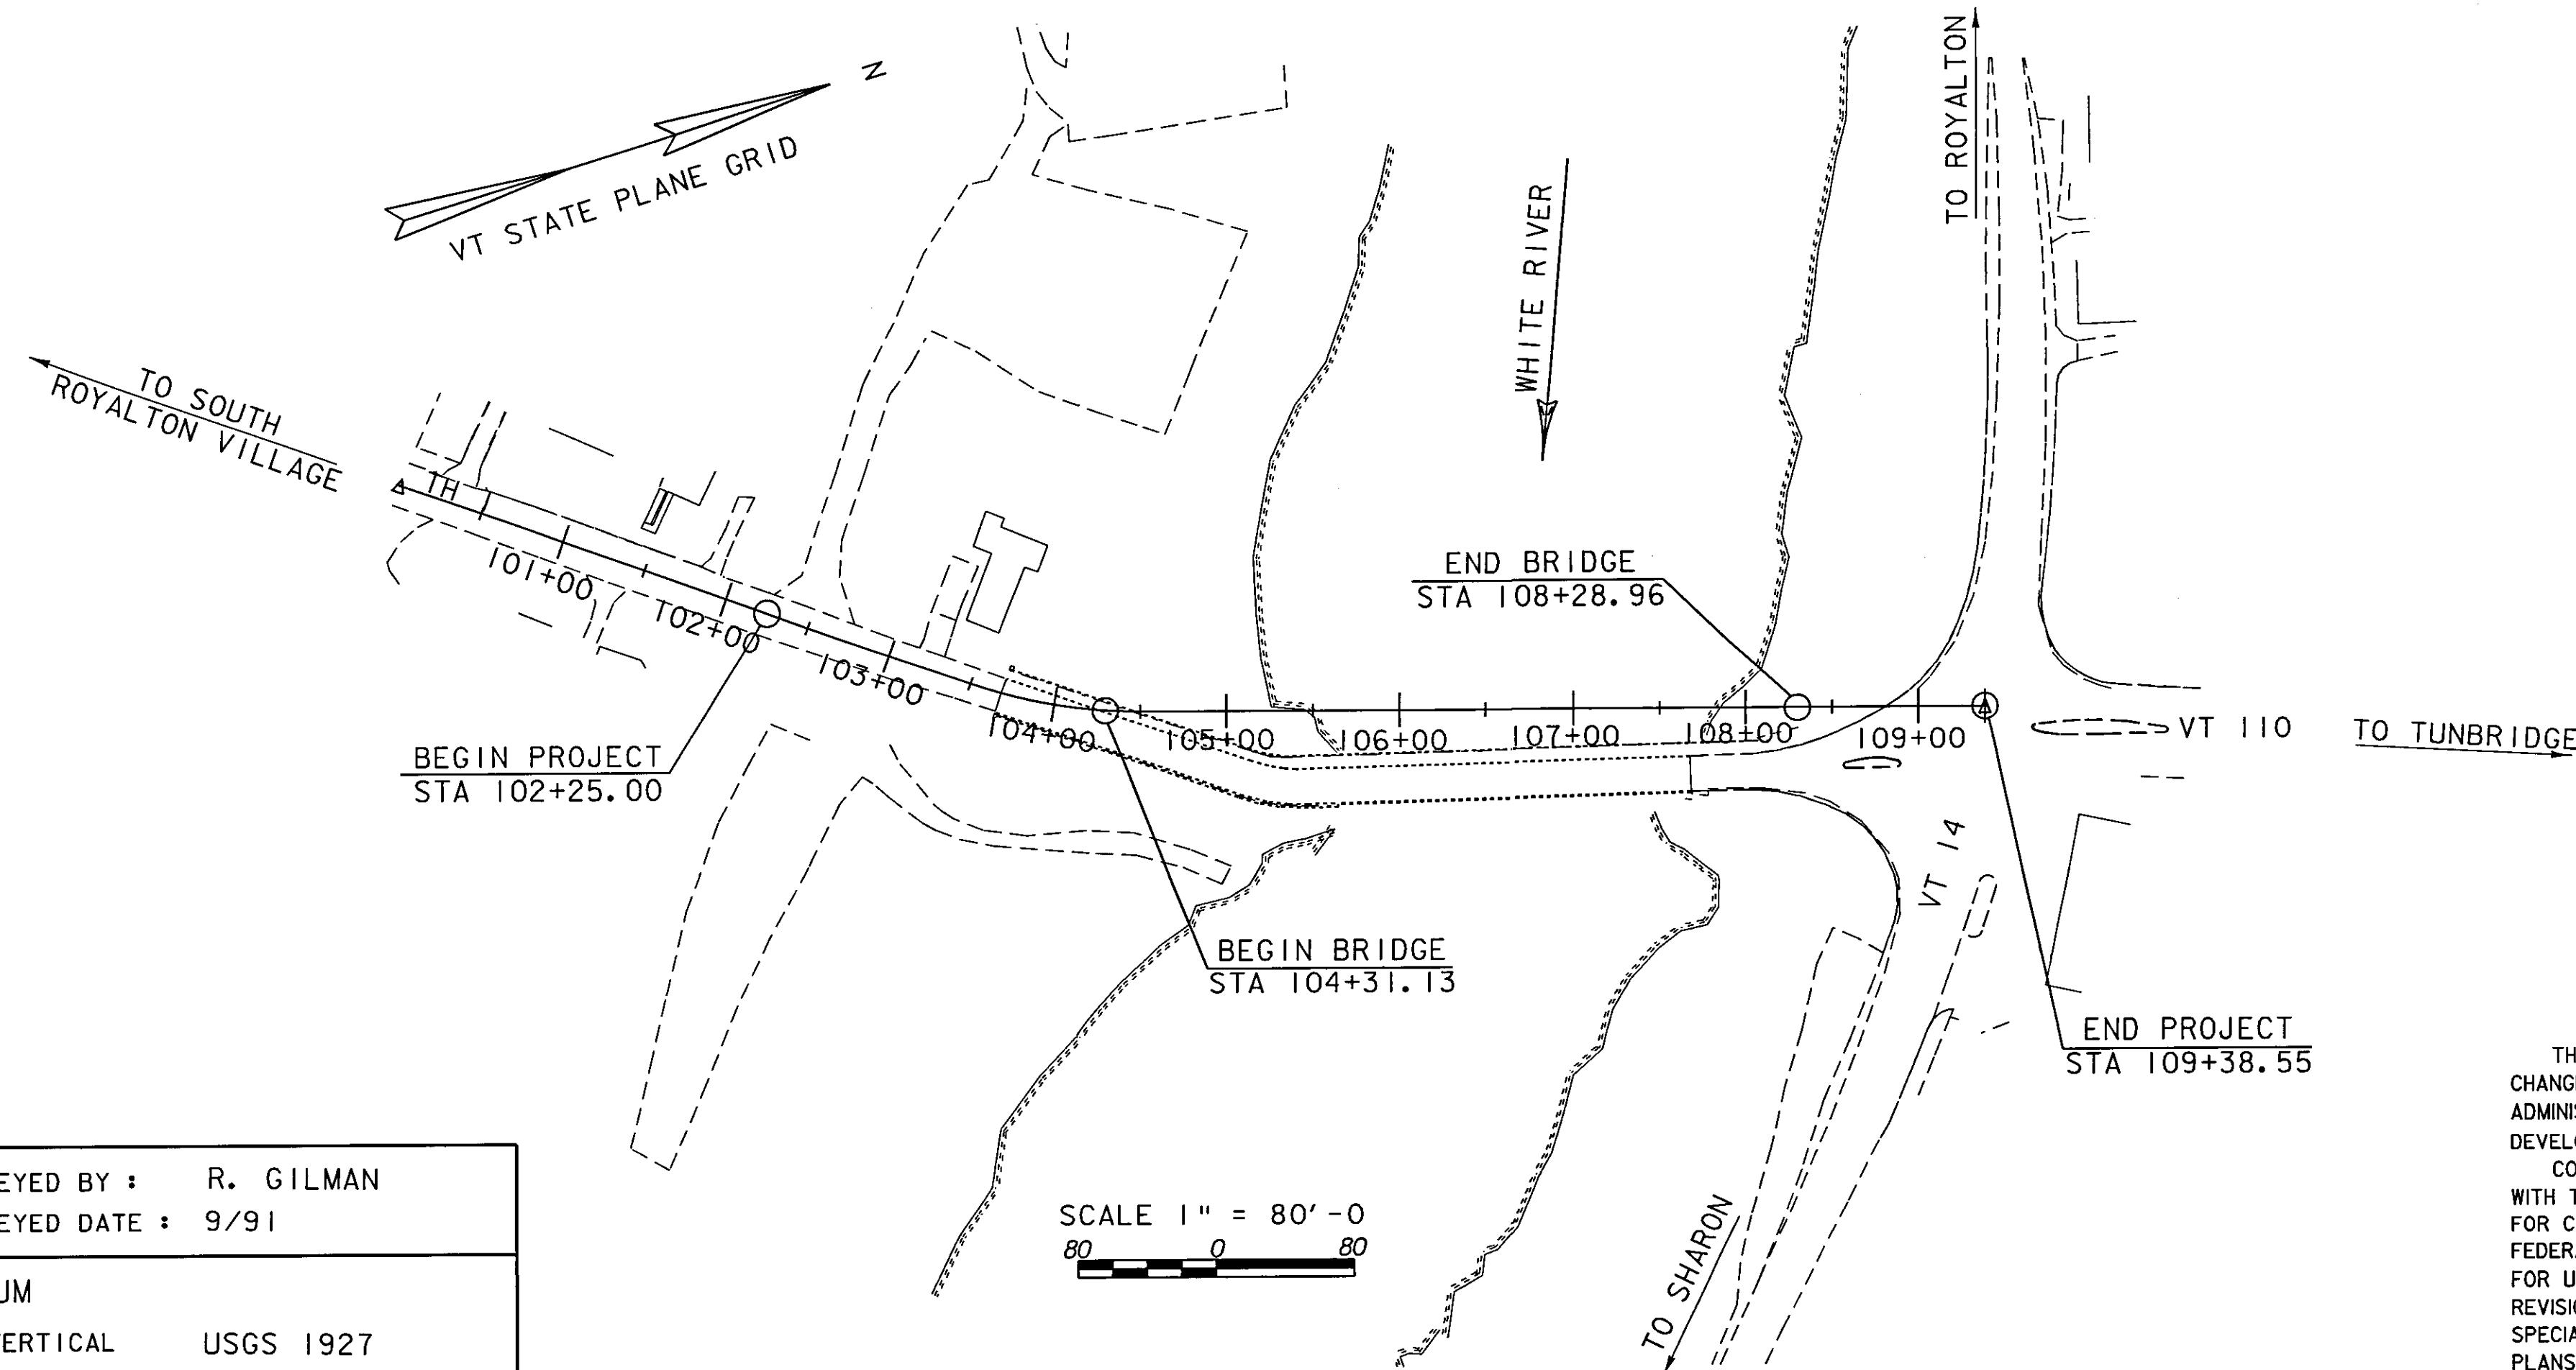

CONVENTIONAL SYMBOLS

COUNTY LINE	
TOWN LINE	
LIMITS OF ACCESS	
POINT OF ACCESS	
FENCE LINE	
STONE WALL	
TRAVELED WAY	
GUARD RAIL	
RAILROAD	
SURVEY LINE	
CULVERT	
POWER POLE	
TELEPHONE POLE	
TREES	
CONTROL OF ACCESS	
PROPERTY LINE	
R.O.W. TAKING LINE	
SLOPE RIGHTS	
TOP OF CUT	
TOE OF SLOPE	

SURVEYED BY : R. GILMAN
SURVEYED DATE : 9/91

DATUM
VERTICAL USGS 1927
HORIZONTAL ASSUMED

SCALE 1" = 80'-0"

THESE PLANS ARE SUBJECT TO SUCH ENGINEERING CHANGES AS MAY BE REQUIRED BY THE FEDERAL HIGHWAY ADMINISTRATION OR THE DIRECTOR OF PROJECT DEVELOPMENT.
CONSTRUCTION IS TO BE CARRIED ON IN ACCORDANCE WITH THESE PLANS AND THE STANDARD SPECIFICATIONS FOR CONSTRUCTION DATED 1990, AS APPROVED BY THE FEDERAL HIGHWAY ADMINISTRATION ON MARCH 15, 1990 FOR USE ON THIS PROJECT, INCLUDING ALL SUBSEQUENT REVISIONS AND SUCH REVISED SPECIFICATIONS AND SPECIAL PROVISIONS AS ARE INCORPORATED IN THESE PLANS.

DIRECTOR OF PROJECT DEVELOPMENT	
APPROVED <i>[Signature]</i>	DATE 9/20/00
PROJECT MANAGER : CHRIS WILLIAMS	
PROJECT NAME : ROYALTON	
PROJECT NUMBER : AC BRZ 1444(22)	
SHEET 1 OF 118 SHEETS	