


TYPICAL BRIDGE SECTION


SCALE 3/4" = 1'-0"

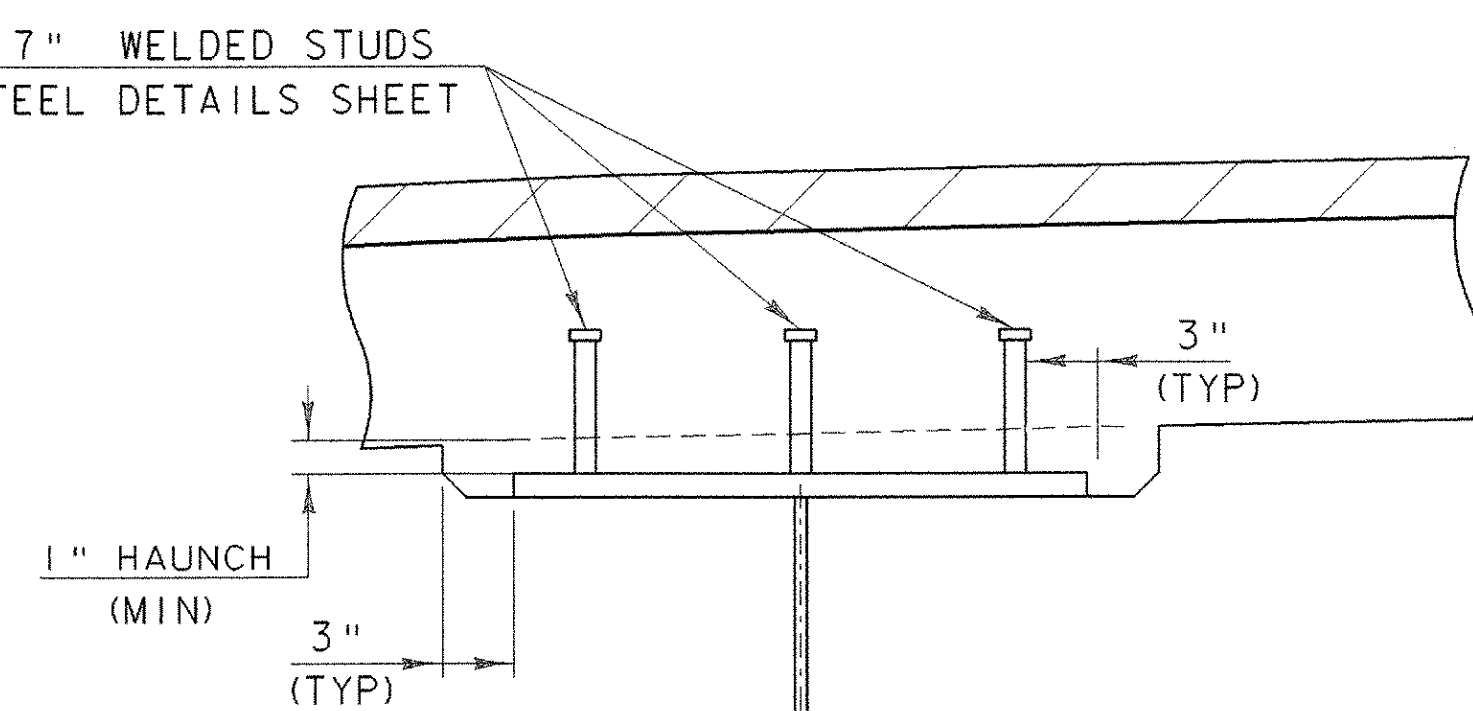

GIRDER HAUNCH & SHEAR CONNECTOR DETAILS

SCALE 1 1/2" = 1'-0"

9 6 3 0

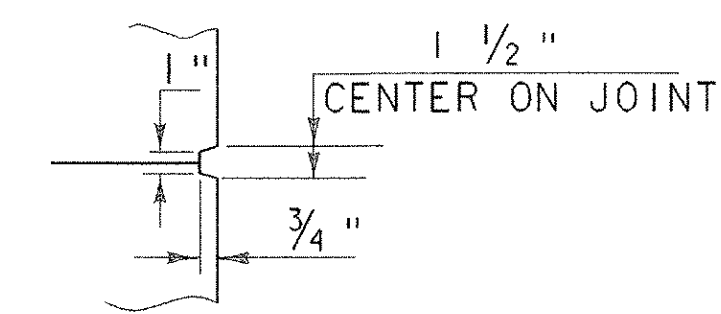

SCORE MARK DETAIL

PROJECT NAME:	ROYALTON BRZ 1444 (22)		
PROJECT NUMBER:			
FILE NAME:	89j099/structures/sj099sup2.dgn	PLOT DATE:	25-SEP-2000
IPARM NAME:	sj099typbrsec.i	DRAWN BY:	K. M. HIGGINS
PROJECT LEADER:	C. P. WILLIAMS	CHECKED BY:	W. B. SYMONDS
DESIGNED BY:	W. B. SYMONDS	SHEET	26 OF 118
TYPICAL BRIDGE SECTION			