


GIRDER ELEVATION

HORIZONTAL SCALE: 1" = 15'-0"
VERTICAL SCALE: 1" = 3'-0"

3/4" X 8" SINGLE TRANSVERSE SHEAR STIFFENERS. USE AS CONNECTION PLATES WHERE POSSIBLE (TYP)

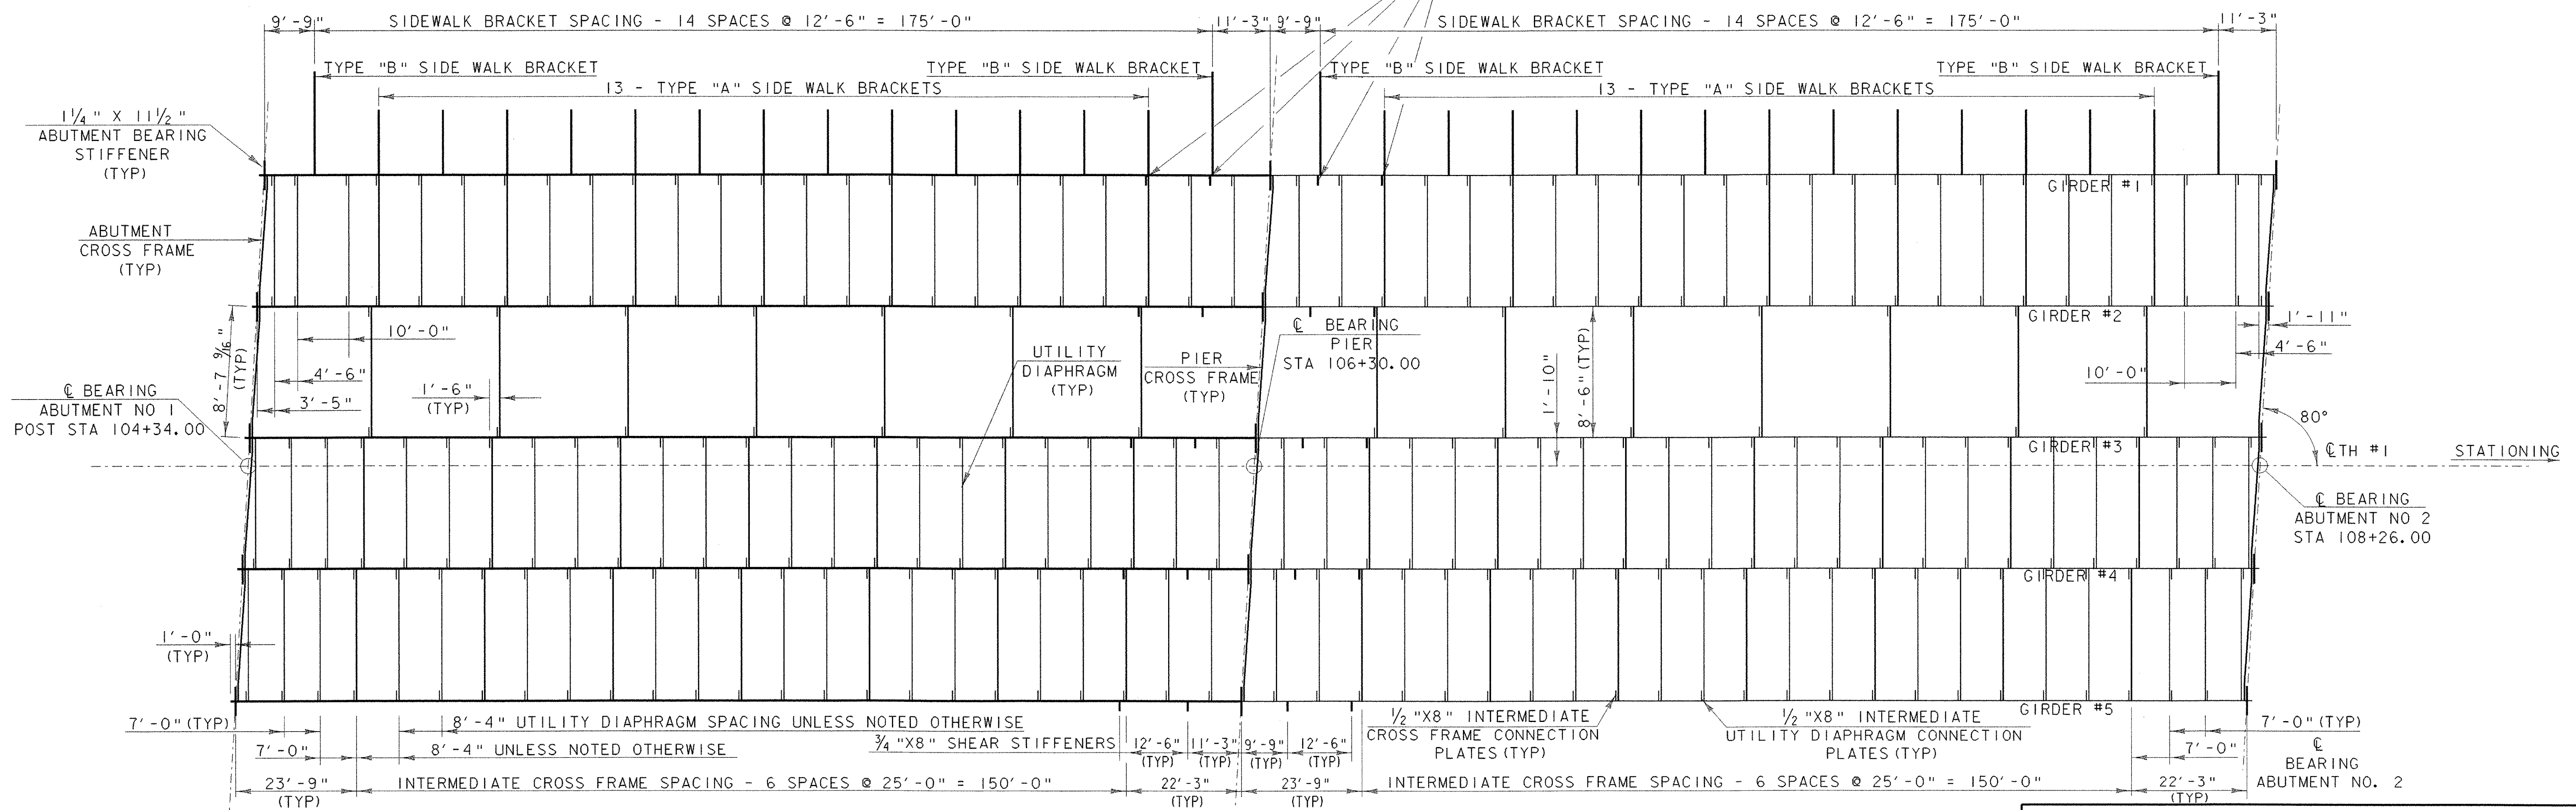

NOTE: SEE SHEETS 34 - 38 FOR ADDITIONAL STRUCTURAL STEEL DETAILS AND NOTES

FRAMING PLAN

HORIZONTAL SCALE: 1" = 15'-0"
VERTICAL SCALE: 1" = 5'-0"

PROJECT NAME: ROYALTON BRZ 1444 (22)
PROJECT NUMBER:
FILE NAME: 89j099/structures/sj099ssd.dgn PLOT DATE: 25-SEP-2000
IPARM NAME: sj099fraplan.i DRAWN BY: P.G. JARVIS
PROJECT LEADER: C.P. WILLIAMS CHECKED BY: W.B. SYMONDS
DESIGNED BY: W.B. SYMONDS FRAMING PLAN & GIRDER ELEVATION SHEET 33 OF 118