


**EXPANSION JOINT ABUTMENT NO. 2**

SCALE 1/2" = 1'-0"  
 1 0 1 2

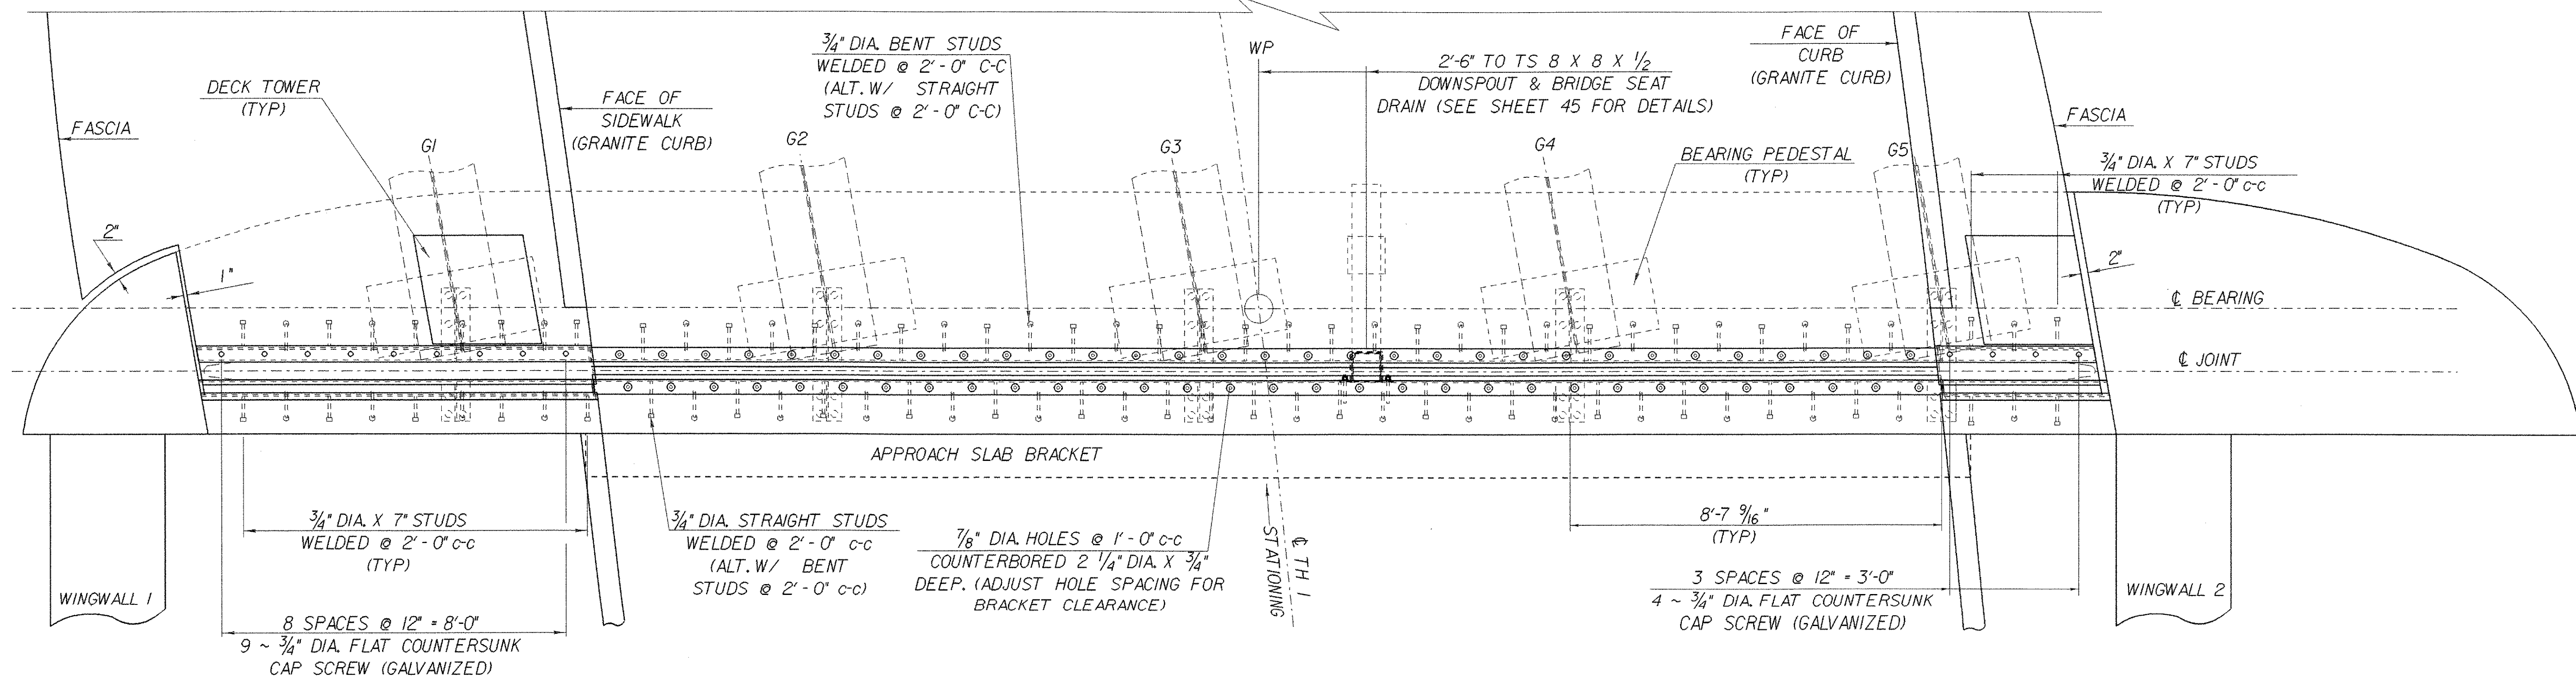

**EXPANSION JOINT ABUTMENT NO. 1**

SCALE 1/2" = 1'-0"  
 1 0 1 2

PROJECT NAME: ROYALTON BRZ 1444 (22)  
 PROJECT NUMBER:  
 FILE NAME: 89j099/structures/sj099joint.dgn PLOT DATE: 25-SEP-2000  
 IPARM NAME: sj099exp2.i DRAWN BY: K.M. HIGGINS  
 PROJECT LEADER: C.P. WILLIAMS CHECKED BY: W.B. SYMONDS  
 DESIGNED BY: W.B. SYMONDS SHEET 43 OF 118  
 EXPANSION JOINT PLAN