


SECTION A-A


SCALE 1/4" = 1'-0"
 1 0 2 4 6

GRANITE FASCIA
 CONCRETE FASCIA

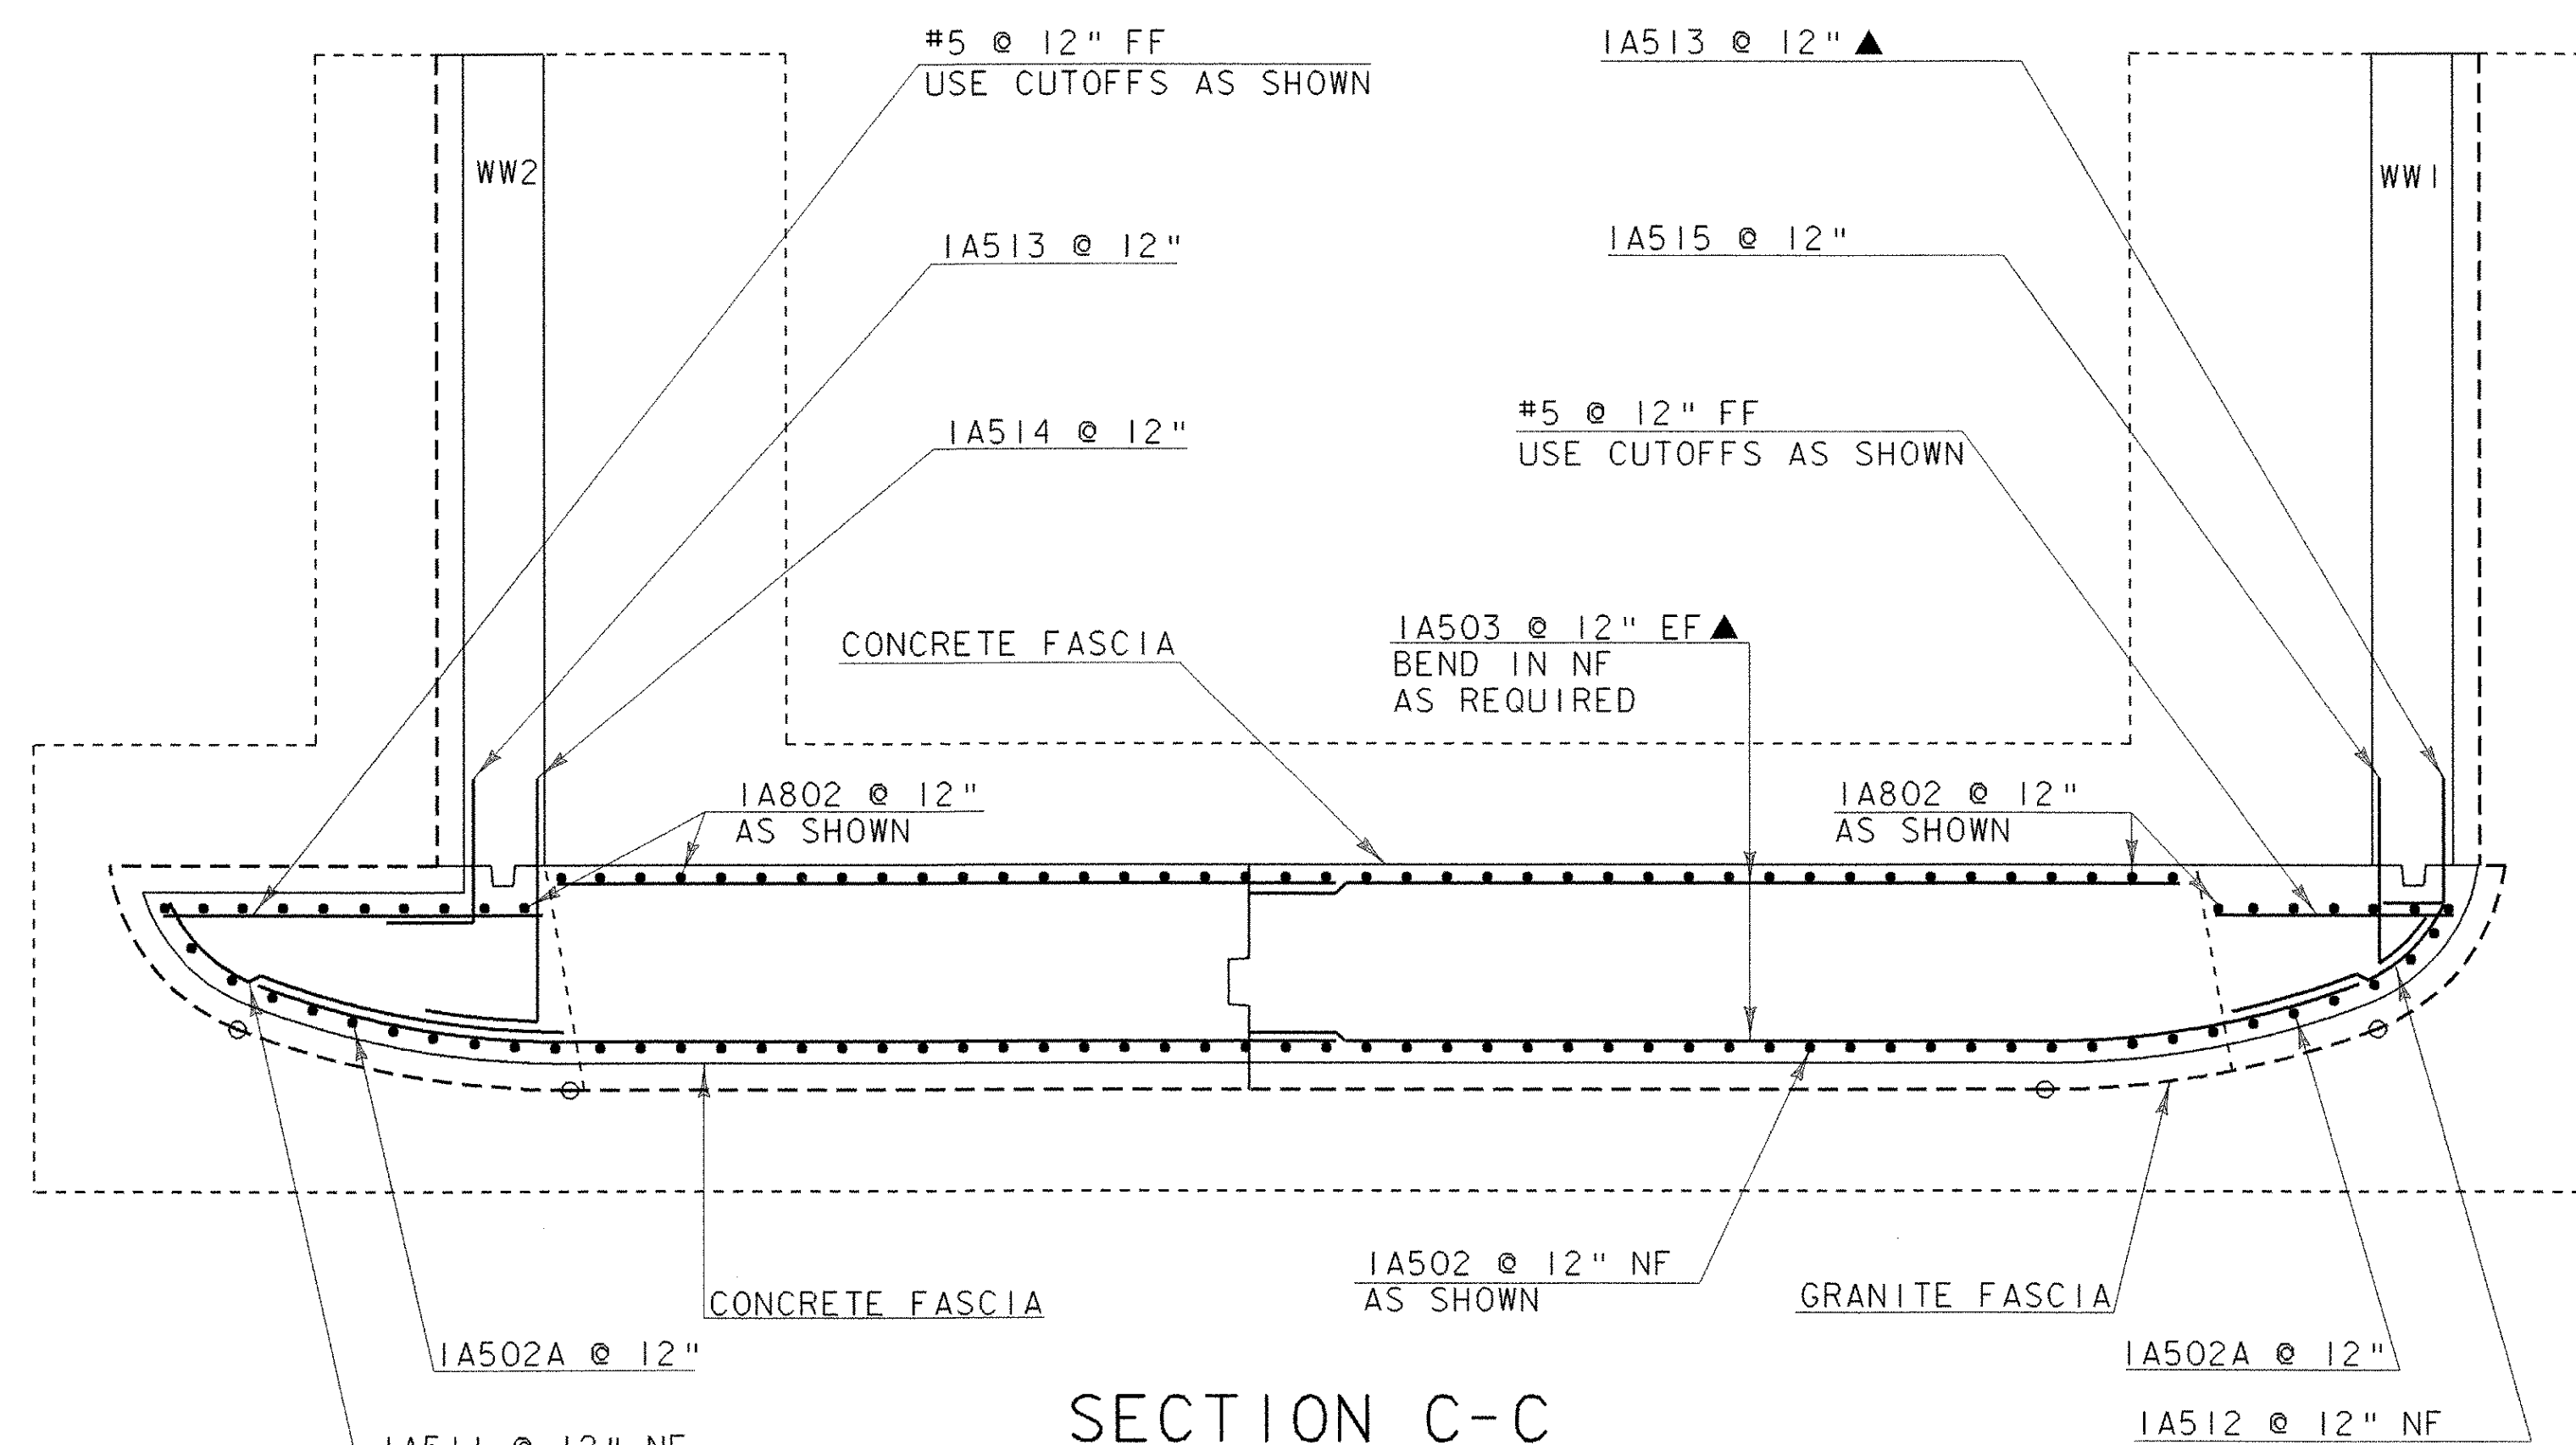

SECTION C-C

SCALE 1/4" = 1'-0"
 1 0 2 4 6

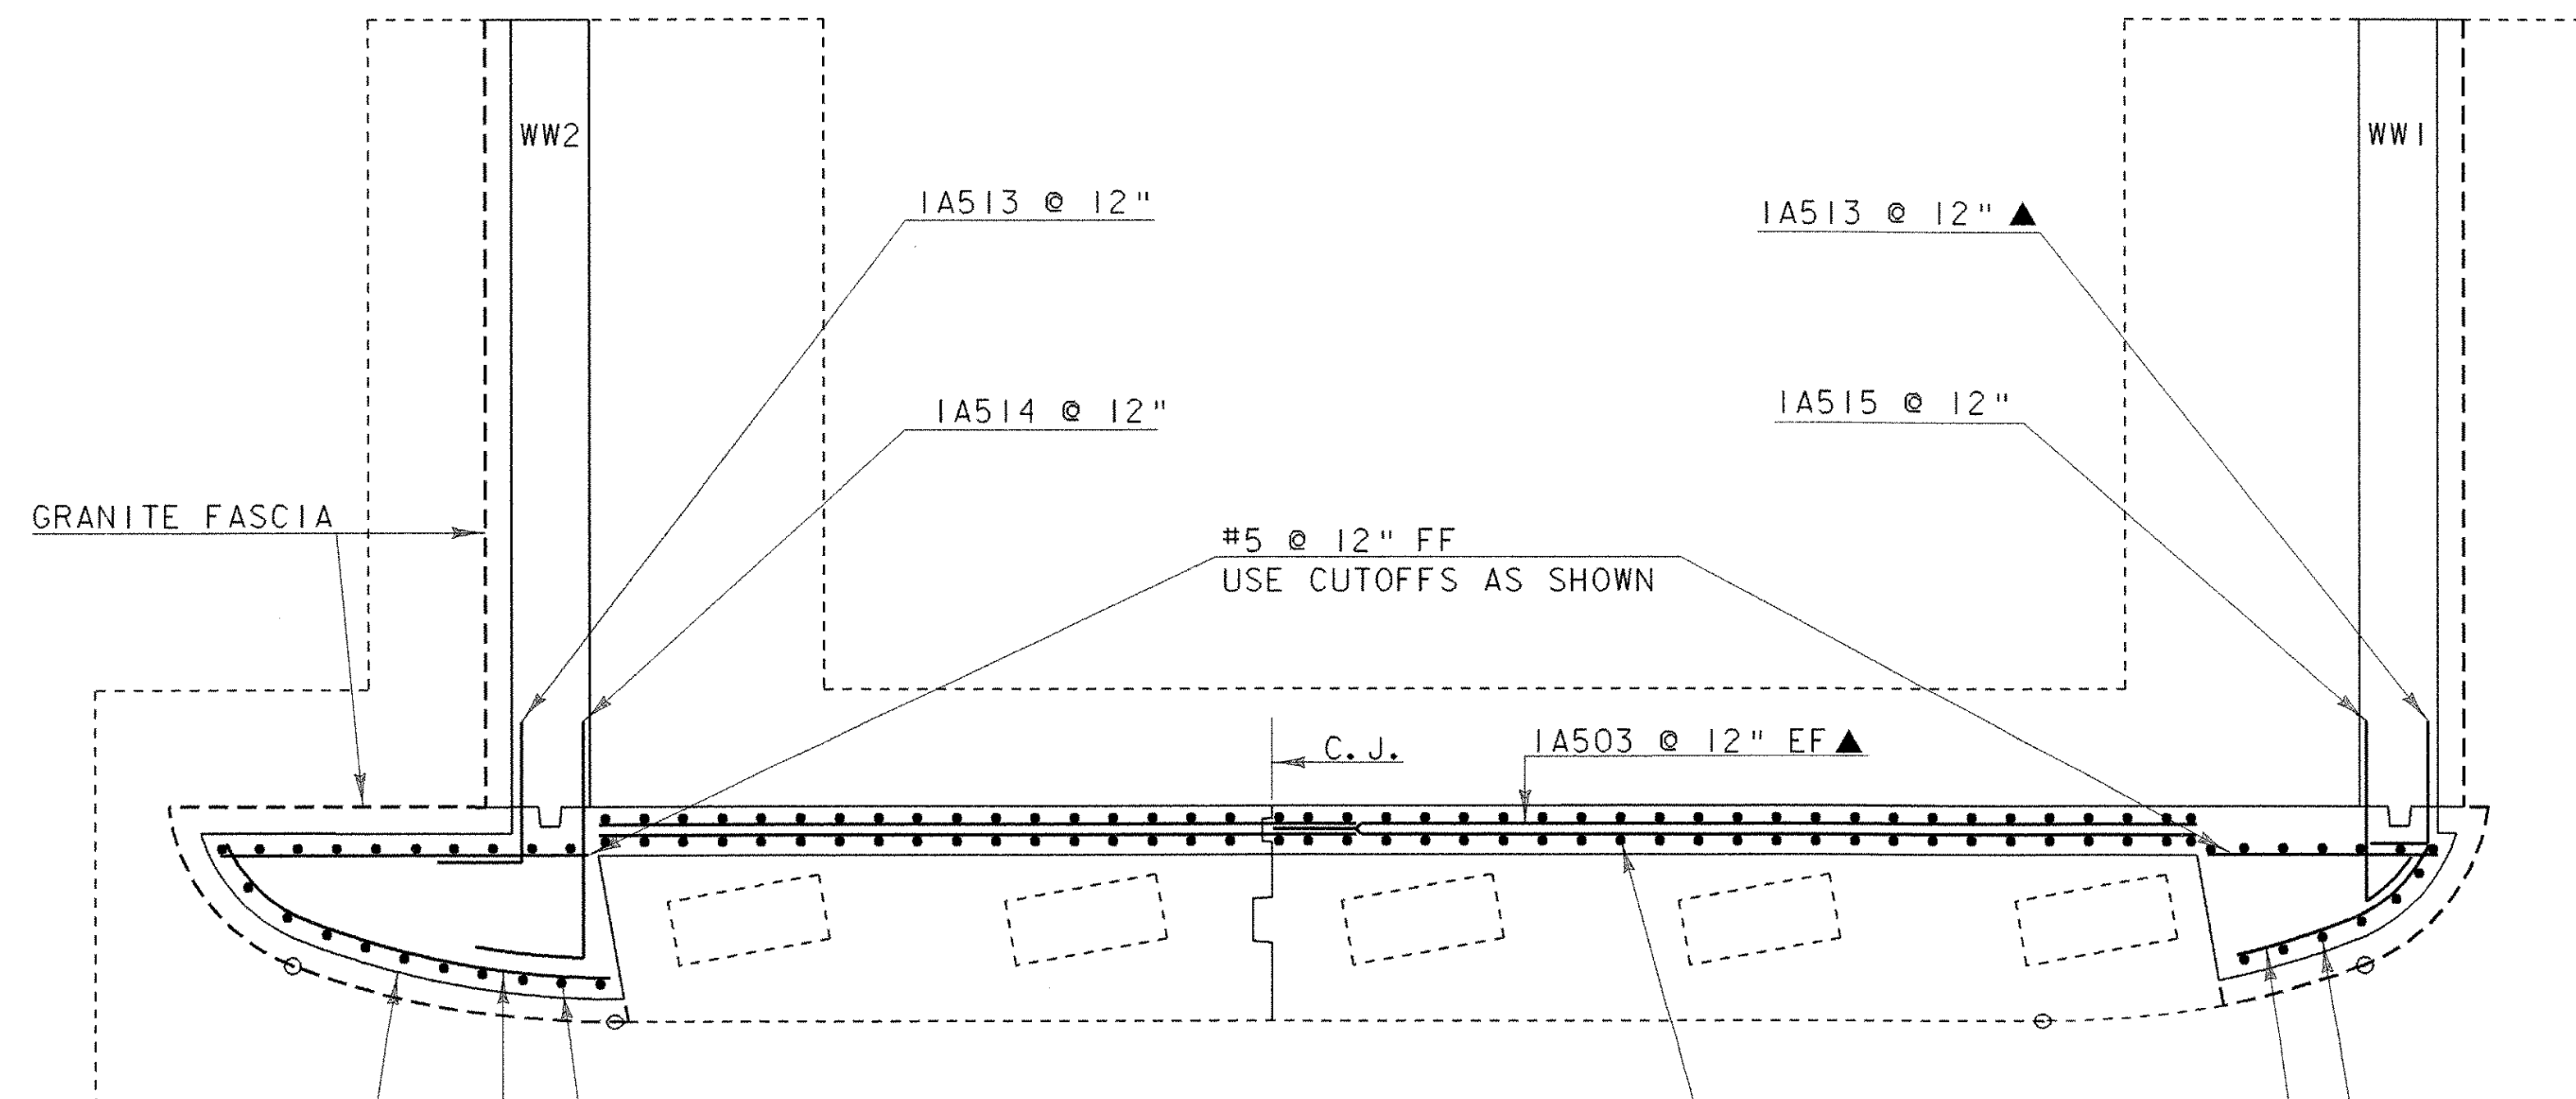

SECTION B-B

SCALE 1/4" = 1'-0"
 1 0 2 4 6

GRANITE FASCIA
 CONCRETE FASCIA

NOTE:

- NF = NEAR FACE
- FF = FAR FACE
- EF = EACH FACE
- ▲ = CUT TO FIT IN FIELD
- PC = POINT OF CURVATURE
- C. J. = CONSTRUCTION JOINT
- ALL LAP SPLICES NOT DETAILED SHALL BE 2'-2"

PROJECT NAME: ROYALTON BRZ 1444 (22)
 PROJECT NUMBER:

FILE NAME: 89j099/structures/sj099abl.dgn PLOT DATE: 25-SEP-2000
 IPARM NAME: sj099ablsections.i DRAWN BY: D.G. BASSETT
 PROJECT LEADER: C.P. WILLIAMS CHECKED BY: C.P. WILLIAMS
 DESIGNED BY: C.P. WILLIAMS SHEET 51 OF 118
 ABUTMENT #1 SECTIONS