


WINGWALL # 3 TYPICAL SECTION

SCALE 3/8" = 1'-0"
 1 0 1 2 3 4

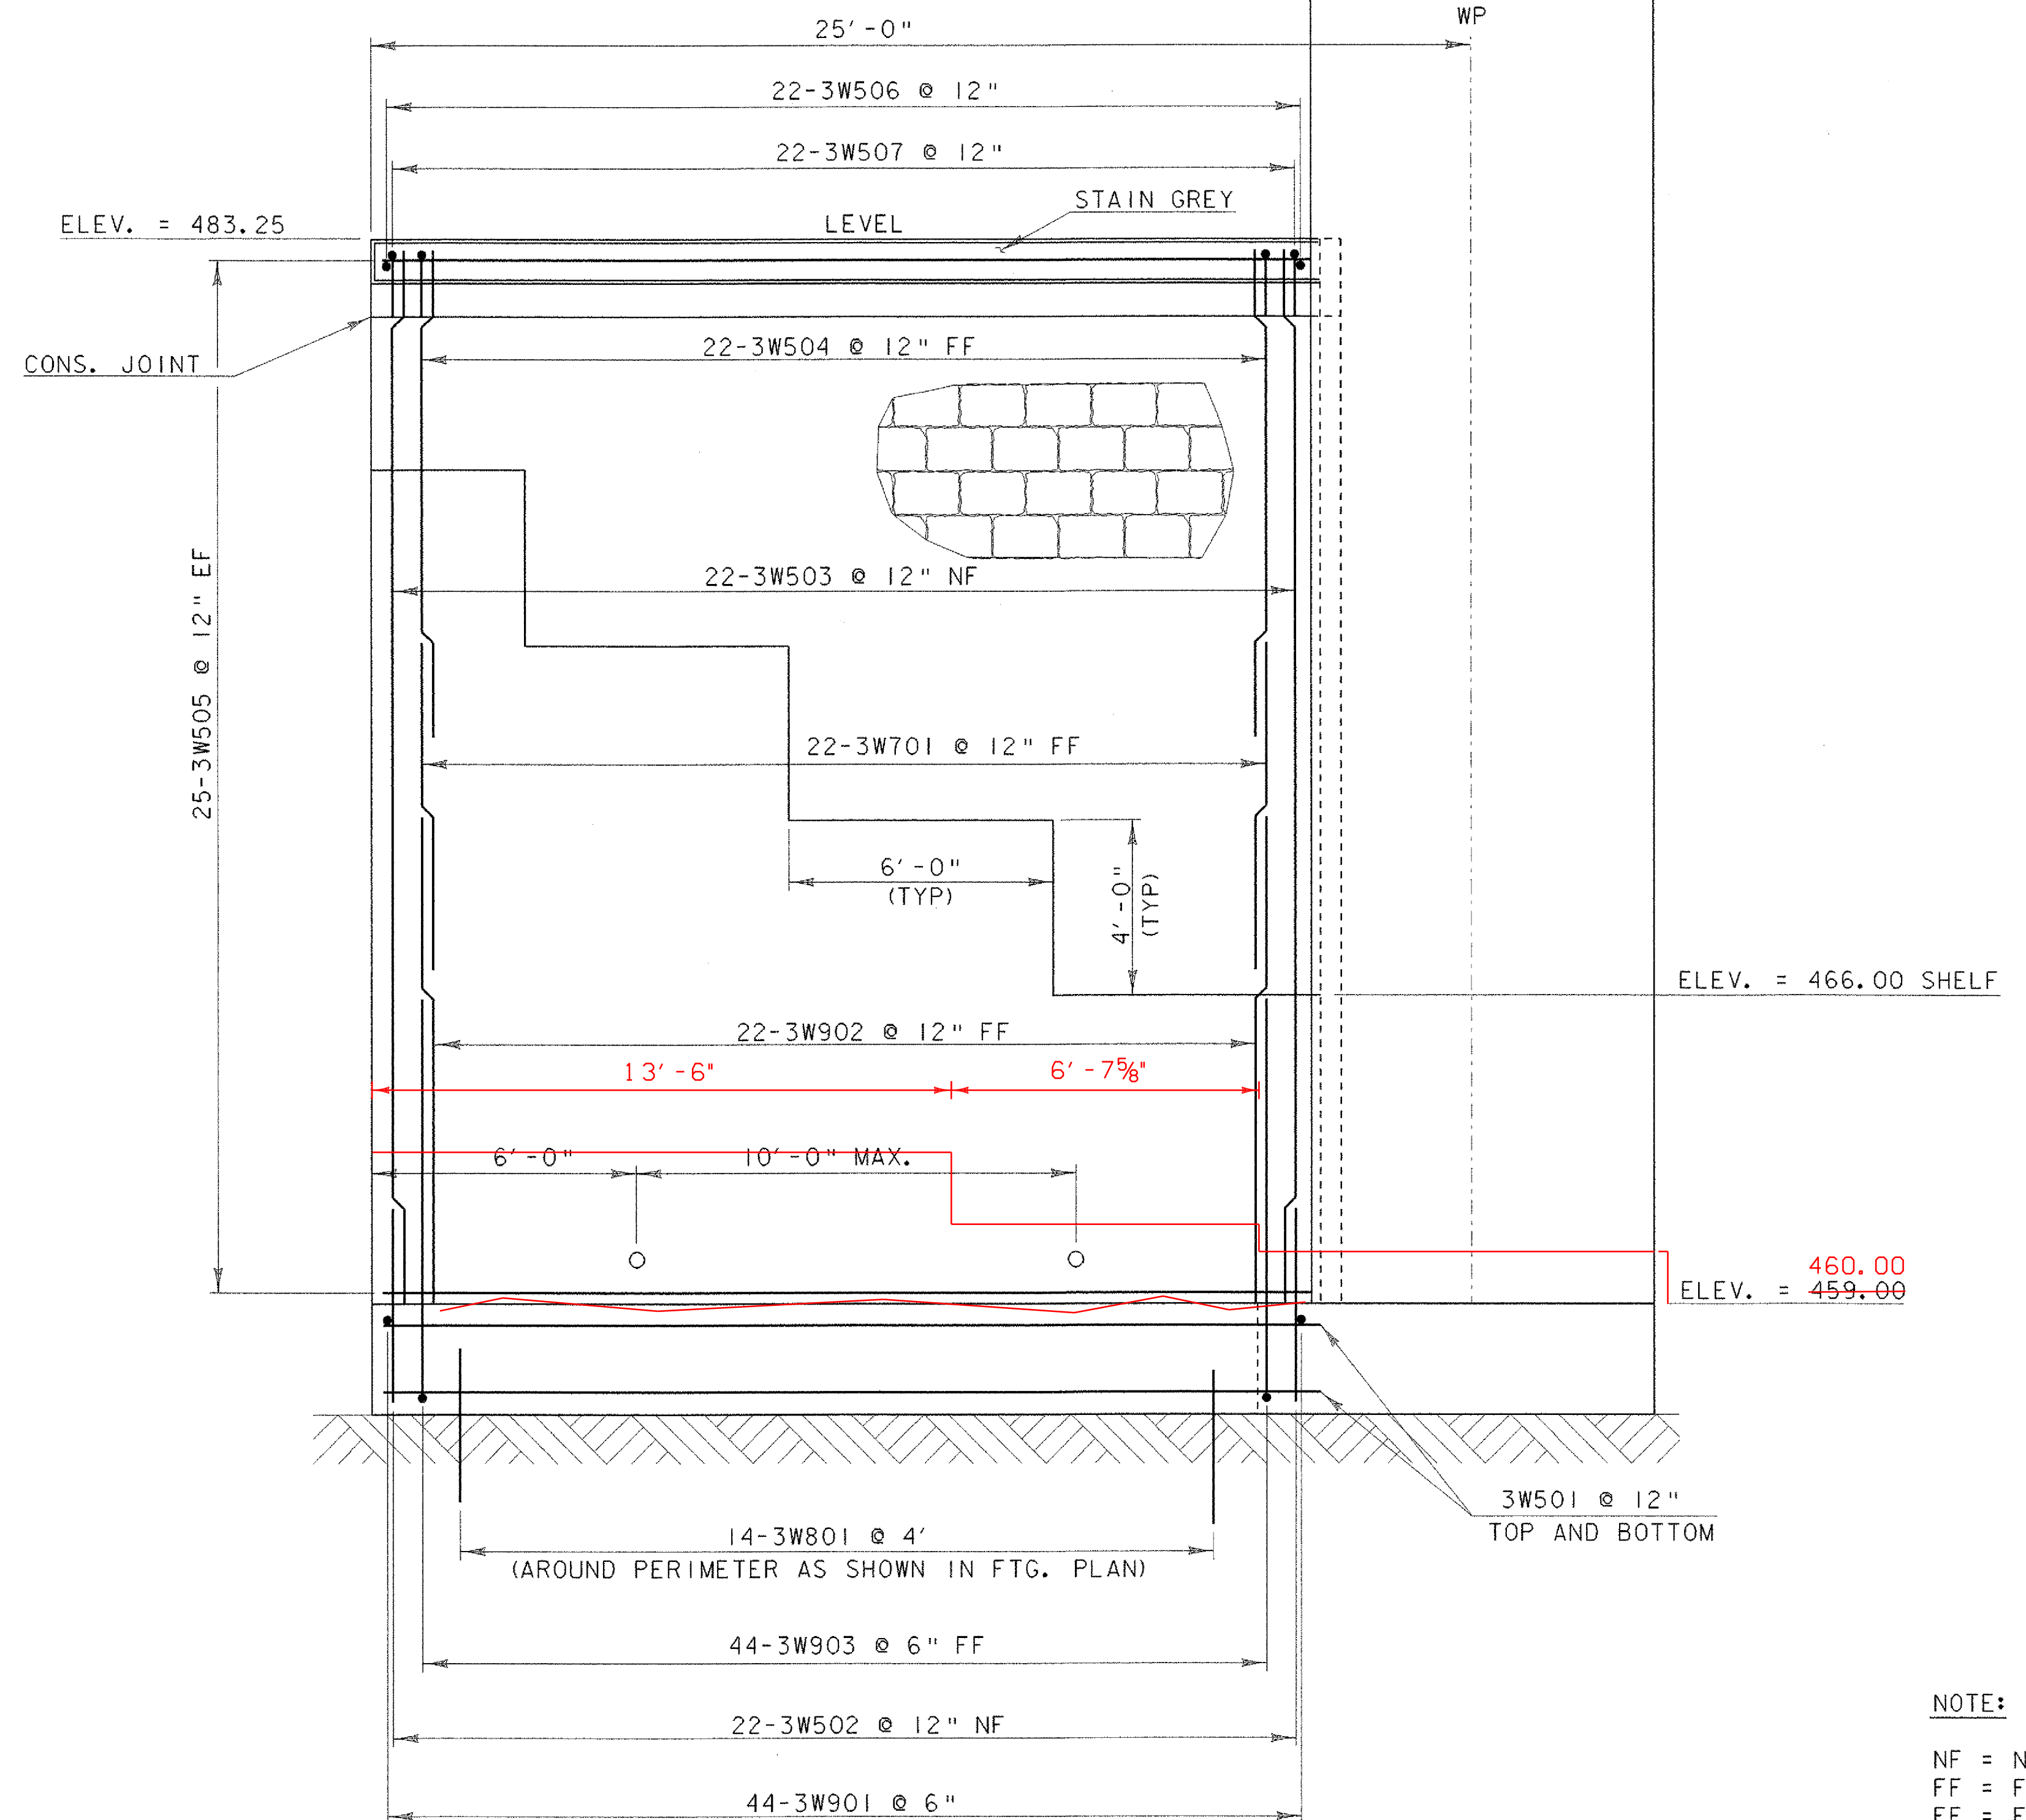

WINGWALL # 3 ELEVATION

SCALE 3/8" = 1'-0"
 1 0 1 2 3 4

NOTE:
 NF = NEAR FACE
 FF = FAR FACE
 EF = EACH FACE
 ▲ = CUT TO FIT IN FIELD
 C.J. = CONSTRUCTION JOINT
 ALL LAP SPLICES NOT
 DETAILED SHALL BE 2'-2"

PROJECT NAME: ROYALTON BRZ 1444 (22)
 PROJECT NUMBER:
 FILE NAME: 89j099/structures/sj099ab2.dgn PLOT DATE: 25-SEP-2000
 IPARM NAME: sj099ww3.i DRAWN BY: D.G. BASSETT
 PROJECT LEADER: C.P. WILLIAMS CHECKED BY: C.P. WILLIAMS
 DESIGNED BY: K.M. HIGGINS SHEET 60 OF 118
 WINGWALL #3 DETAILS