



BRIDGE RAILING - NETC 2 RAIL (MOD)
 STA 105+10.00 LT - STA 107+60.00 LT
 BRIDGE RAILING - GALV. BOX BEAM / PEDESTRIAN (MOD)
 STA 105+10.00 LT - STA 107+60.00 LT
 BRIDGE RAILING - NETC 4 RAIL
 STA 105+10.00 RT - STA 107+60.00 RT

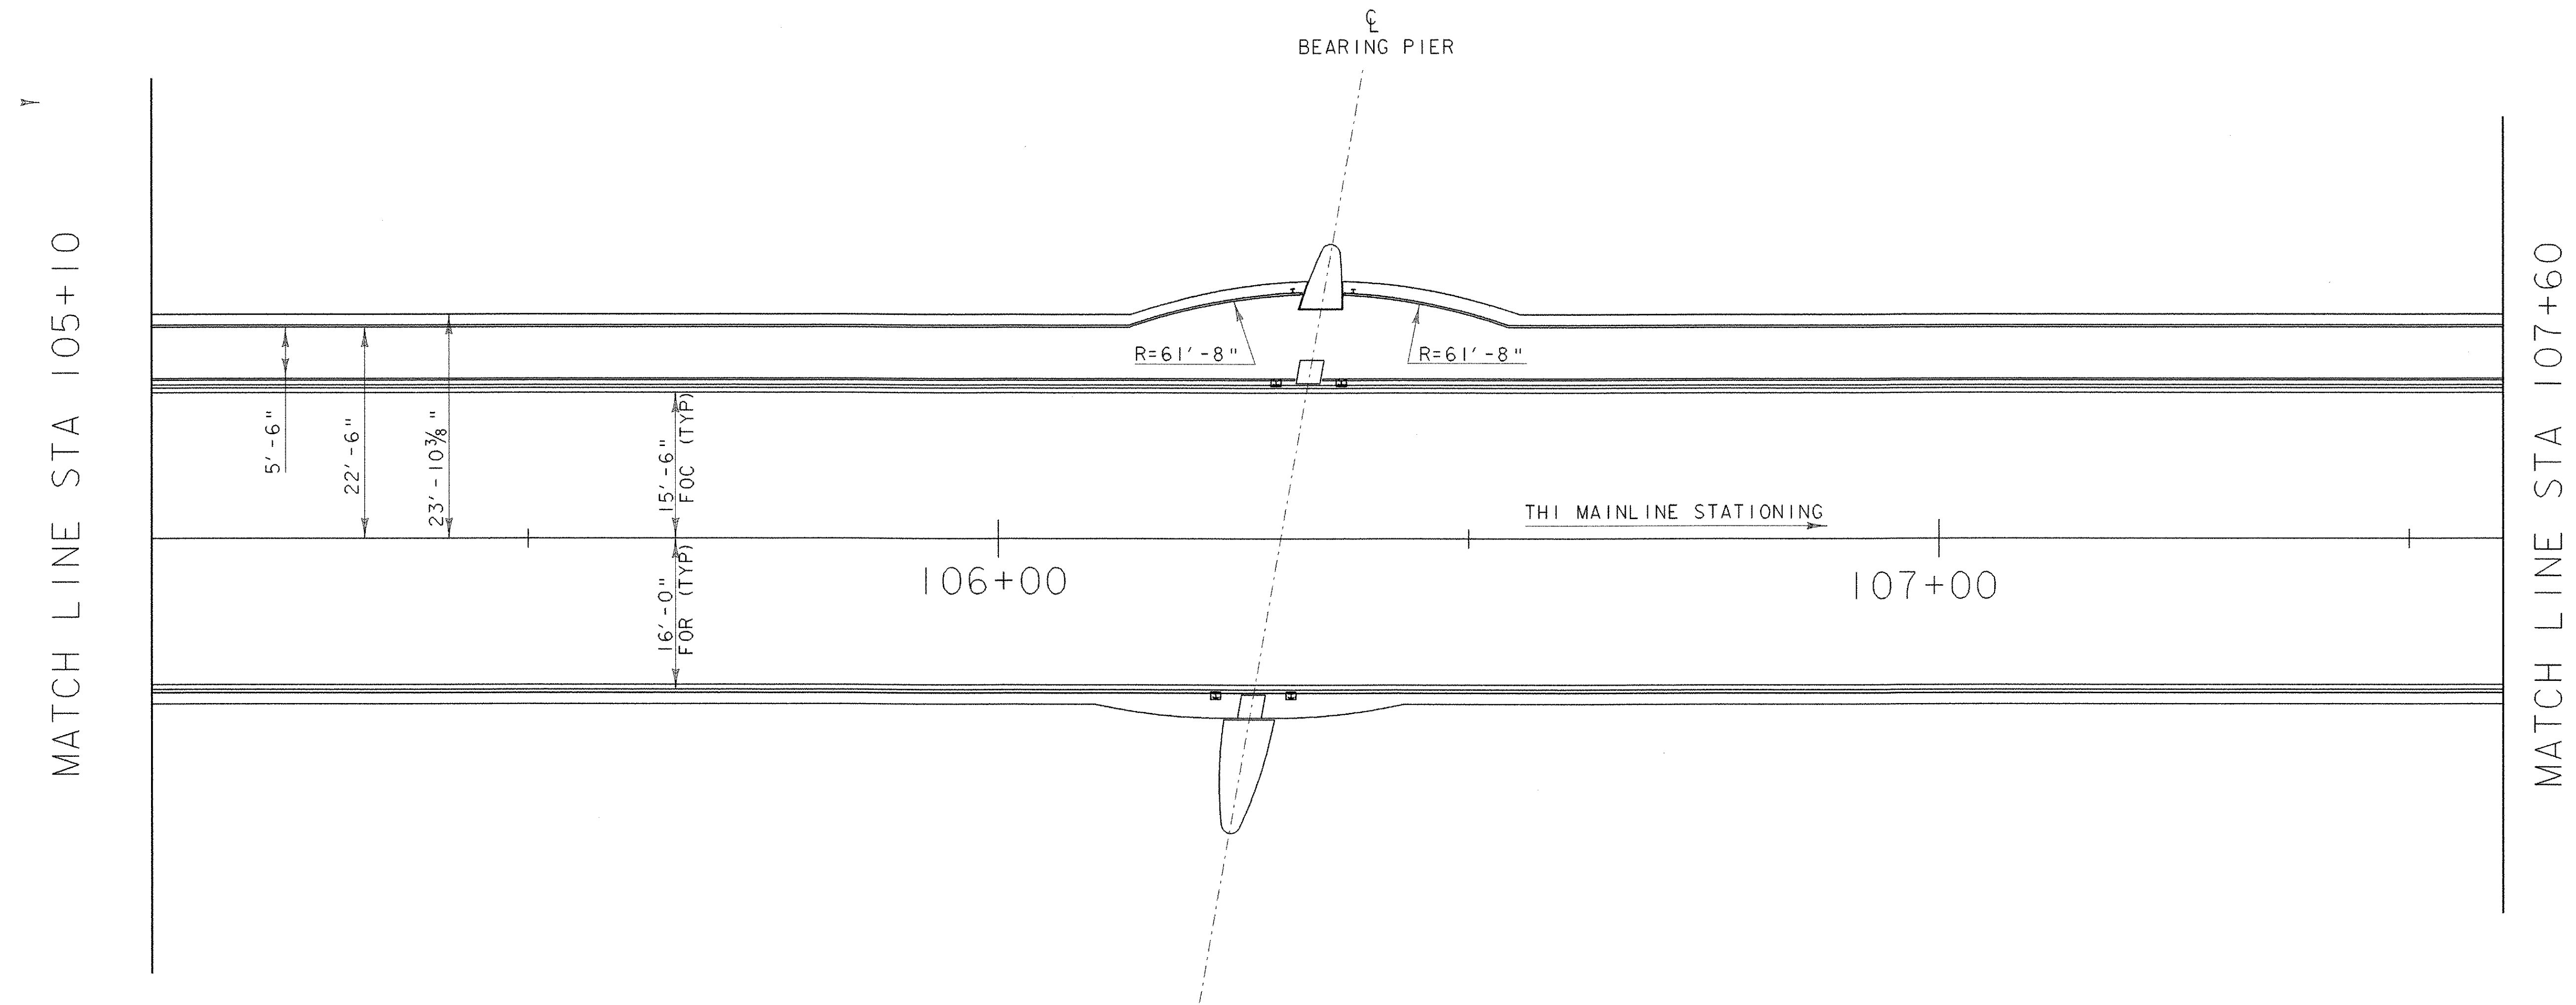

CURB AND RAILING LAYOUT

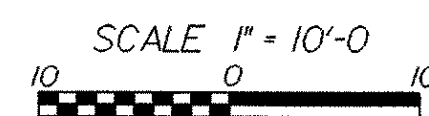

FOR = FACE OF RAIL
 FOC = FACE OF CURB

PROJECT NAME:	ROYALTON BRZ 1444 (22)		
PROJECT NUMBER:			
FILE NAME: 89j099/structures/sj099rail.dgn	PLOT DATE: 25-SEP-2000		
IPARM NAME: sj099railay2.i	DRAWN BY: P.R. ROWE		
PROJECT LEADER: C.P. WILLIAMS	CHECKED BY: W.B. SYMONDS		
DESIGNED BY: W.B. SYMONDS	SHEET 68 OF 118		
CURB AND RAILING LAYOUT 2			