
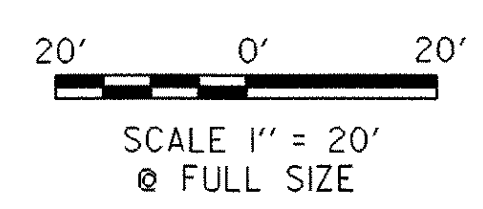
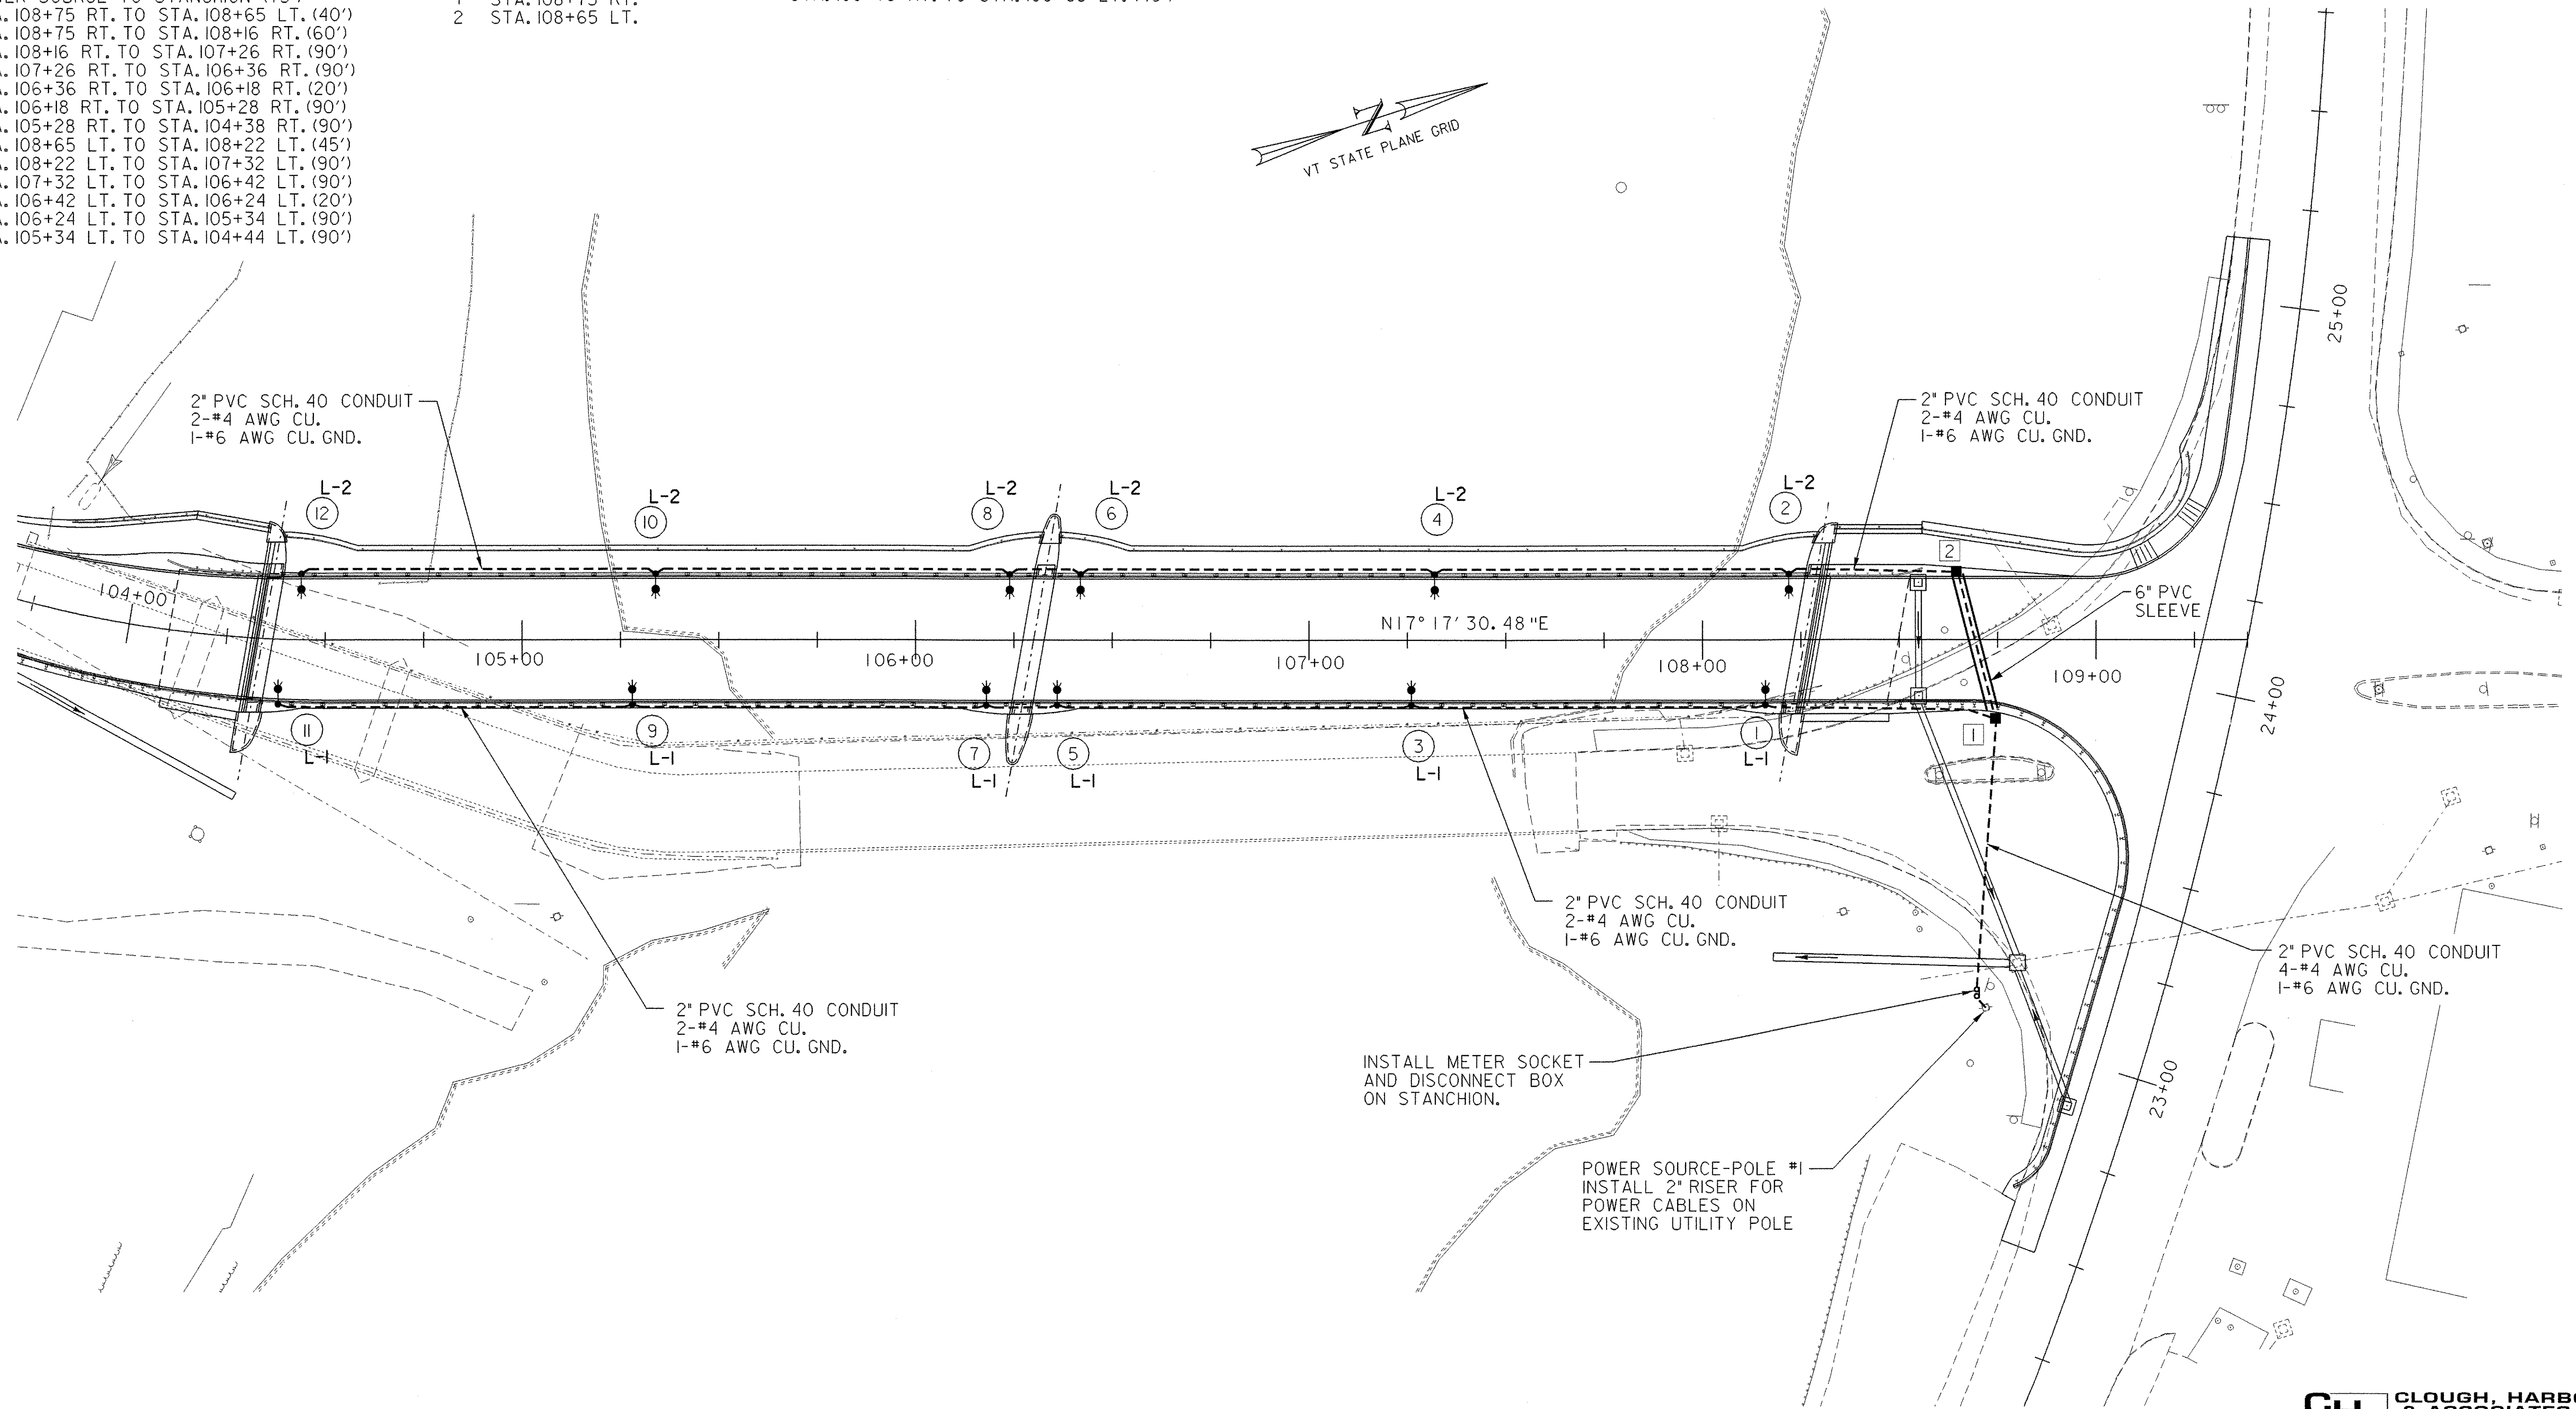


678.23 WIRED CONDUIT (2')  
 POWER SOURCE TO STANCHION (75')  
 STA. 108+75 RT. TO STA. 108+65 LT. (40')  
 STA. 108+75 RT. TO STA. 108+16 RT. (60')  
 STA. 108+16 RT. TO STA. 107+26 RT. (90')  
 STA. 107+26 RT. TO STA. 106+36 RT. (90')  
 STA. 106+36 RT. TO STA. 106+18 RT. (20')  
 STA. 106+18 RT. TO STA. 105+28 RT. (90')  
 STA. 105+28 RT. TO STA. 104+38 RT. (90')  
 STA. 108+65 LT. TO STA. 108+22 LT. (45')  
 STA. 108+22 LT. TO STA. 107+32 LT. (90')  
 STA. 107+32 LT. TO STA. 106+42 LT. (90')  
 STA. 106+42 LT. TO STA. 106+24 LT. (20')  
 STA. 106+24 LT. TO STA. 105+34 LT. (90')  
 STA. 105+34 LT. TO STA. 104+44 LT. (90')

678.26 JUNCTION BOX  
 1 STA. 108+75 RT.  
 2 STA. 108+65 LT.

678.30 ELECTRICAL CONDUIT SLEEVE (6')  
 STA. 108+75 RT. TO STA. 108+65 LT. (40')

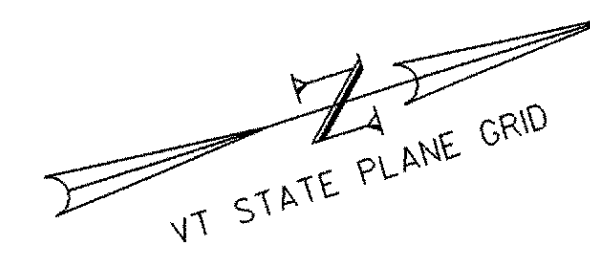

NOTE:  
 POWER SERVICE SHALL BE 100 AMP (MIN.)  
 SINGLE PHASE 120 VOLT.  
 L-1 AND L-2 SHALL HAVE SEPARATE 30 AMP CIRCUIT  
 BREAKERS IN ADDITION TO A 100 AMP MAIN DISCONNECT.

**CHA** CLOUGH, HARBOUR & ASSOCIATES LLP  
 ENGINEERS, SURVEYORS, PLANNERS & LANDSCAPE ARCHITECTS  
 111 BANKERS CIRCLE ALBANY, NEW YORK 12205

PROJECT NAME:	ROYALTON BRZ 1444(22)
PROJECT NUMBER:	
FILE NAME: U:\9425\MSTN\SLP-LDGN	PLOT DATE: 08/01/00
IPARM NAME:	DRAWN BY: M. WIESZCHOWSKI
PROJECT LEADER: P. FAITH	CHECKED BY: T. JOHNSON
DESIGNED BY: M. WIESZCHOWSKI	SHEET 75 OF 118