





PAY LIMITS: STATION 5+70 AND ROAD STATI

ITEM 629.60
12" WATER MAIN
ON BRIDGE (MOD 1)

ITEM 629.24
12" D.I.P., CLASS 52 (MOD)

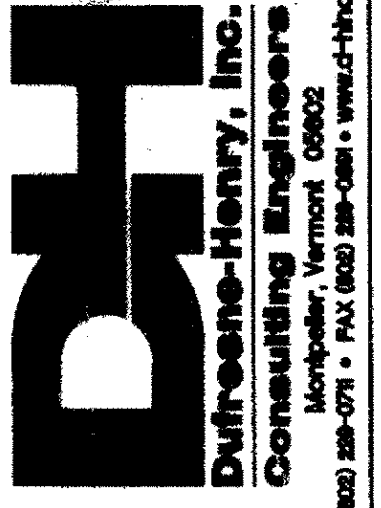

| REV. | DESCRIPTION | BY | DATE |
|---------|-------------|----|------|
| 6-8-00 | BLB | | |
| 5-26-00 | EET | | |
| 5-2-00 | BLB | | |

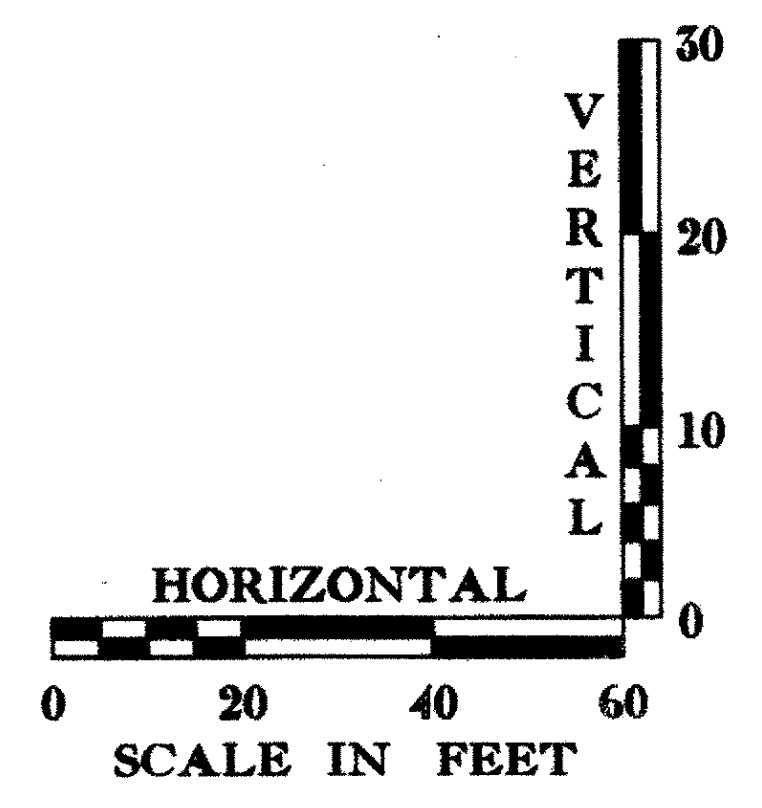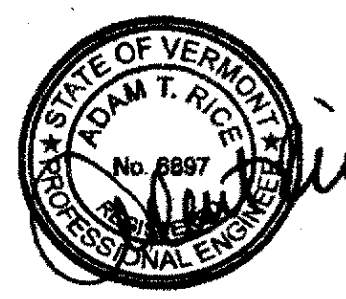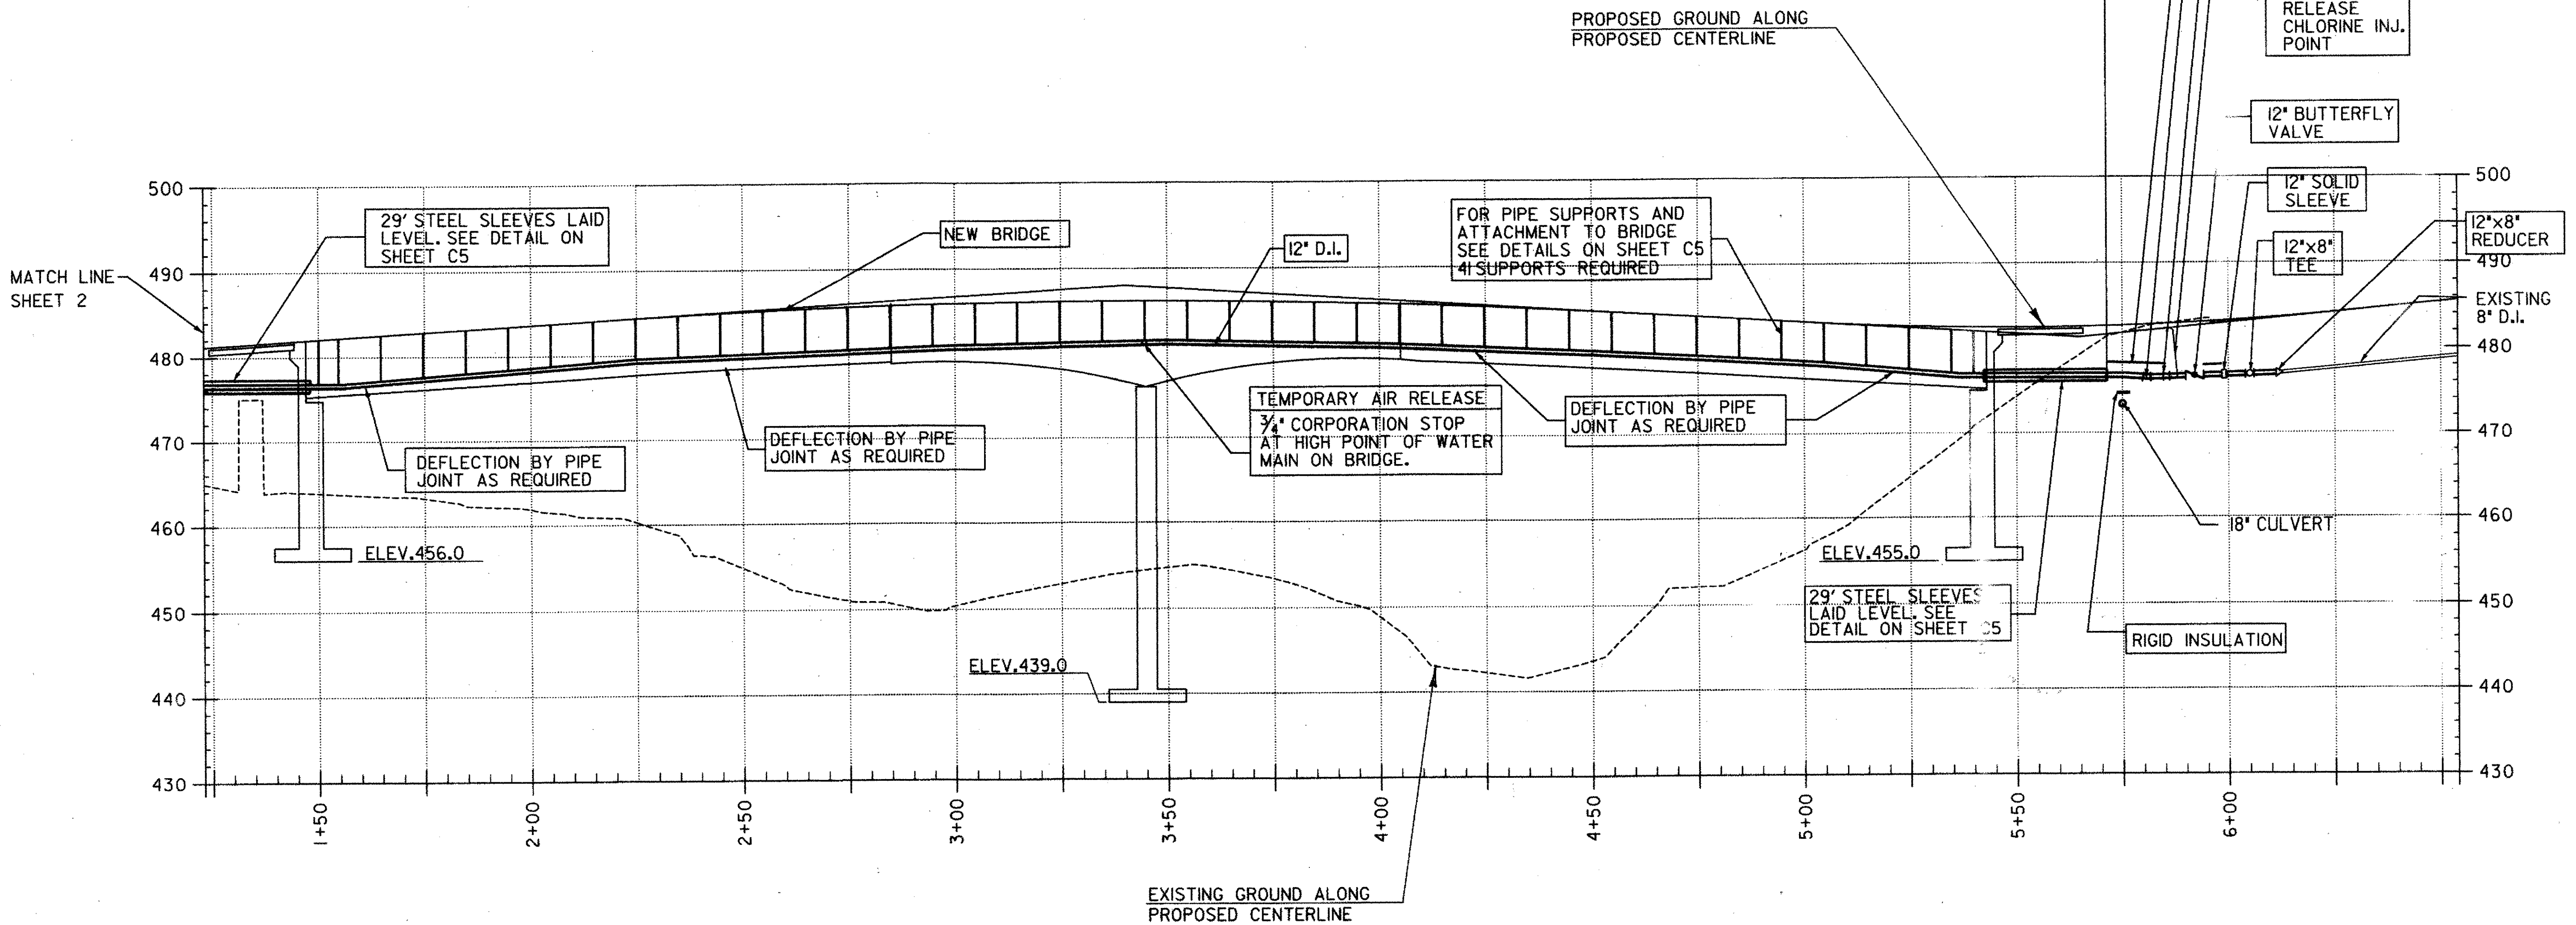

NOTE:
INFORMATION ON THIS SHEET SHOULD ONLY BE
CONSIDERED TO REPRESENT WATER MAIN, PRESSURE
SEWER AND APPURTENANCES. OTHER INFORMATION
SHOWING STRUCTURAL ITEMS, STORM SEWER, AND
SANITARY SEWER IS SHOWN ONLY FOR RELATIVE
RELATIONSHIPS ONLY. THIS INFORMATION SHOULD BE
OBTAINED FROM OTHER DRAWINGS.

| | |
|--|--------------------------------------|
| PROJECT: ROYALTON | PROJECT NO. : BRZ 1444(22) |
| DESIGN FILE NAME: <i>zusc/sic4/891099/s1099bdc.dwg</i> | PLOT DATE: 01 JULY 98 |
| IPARM FILE NAME: <i>zusc/sic4/891099/s1099bdc.dwg</i> | SURVEY DATE: 9/29/91 |
| SURVEYED BY: B. GILMAN | DRAWN BY: JLB |
| SQUAD LEADER: C.P. WILLIAMS | SHEET: 79 OF 118 |
| UTILITY PROFILE | |

TOWN OF ROYALTON AND ROYALTON FIRE DISTRICT No. 1
WHITE RIVER BRIDGE UTILITY CROSSINGS

UTILITY PROFILE
STA. 1+23 TO 6+25

| |
|------------------------------|
| Project No. 6170051 |
| Proj. Manager A. T. RICE |
| Proj. Designer R. N. GOODWIN |
| Drawn By M. A. M./L. A. W. |
| Checked By A. T. RICE |
| Scale AS SHOWN |
| Approved <i>A. T. Rice</i> |
| Date APRIL 2000 |

Sheet 3 of 5
D 6170051