




100+25

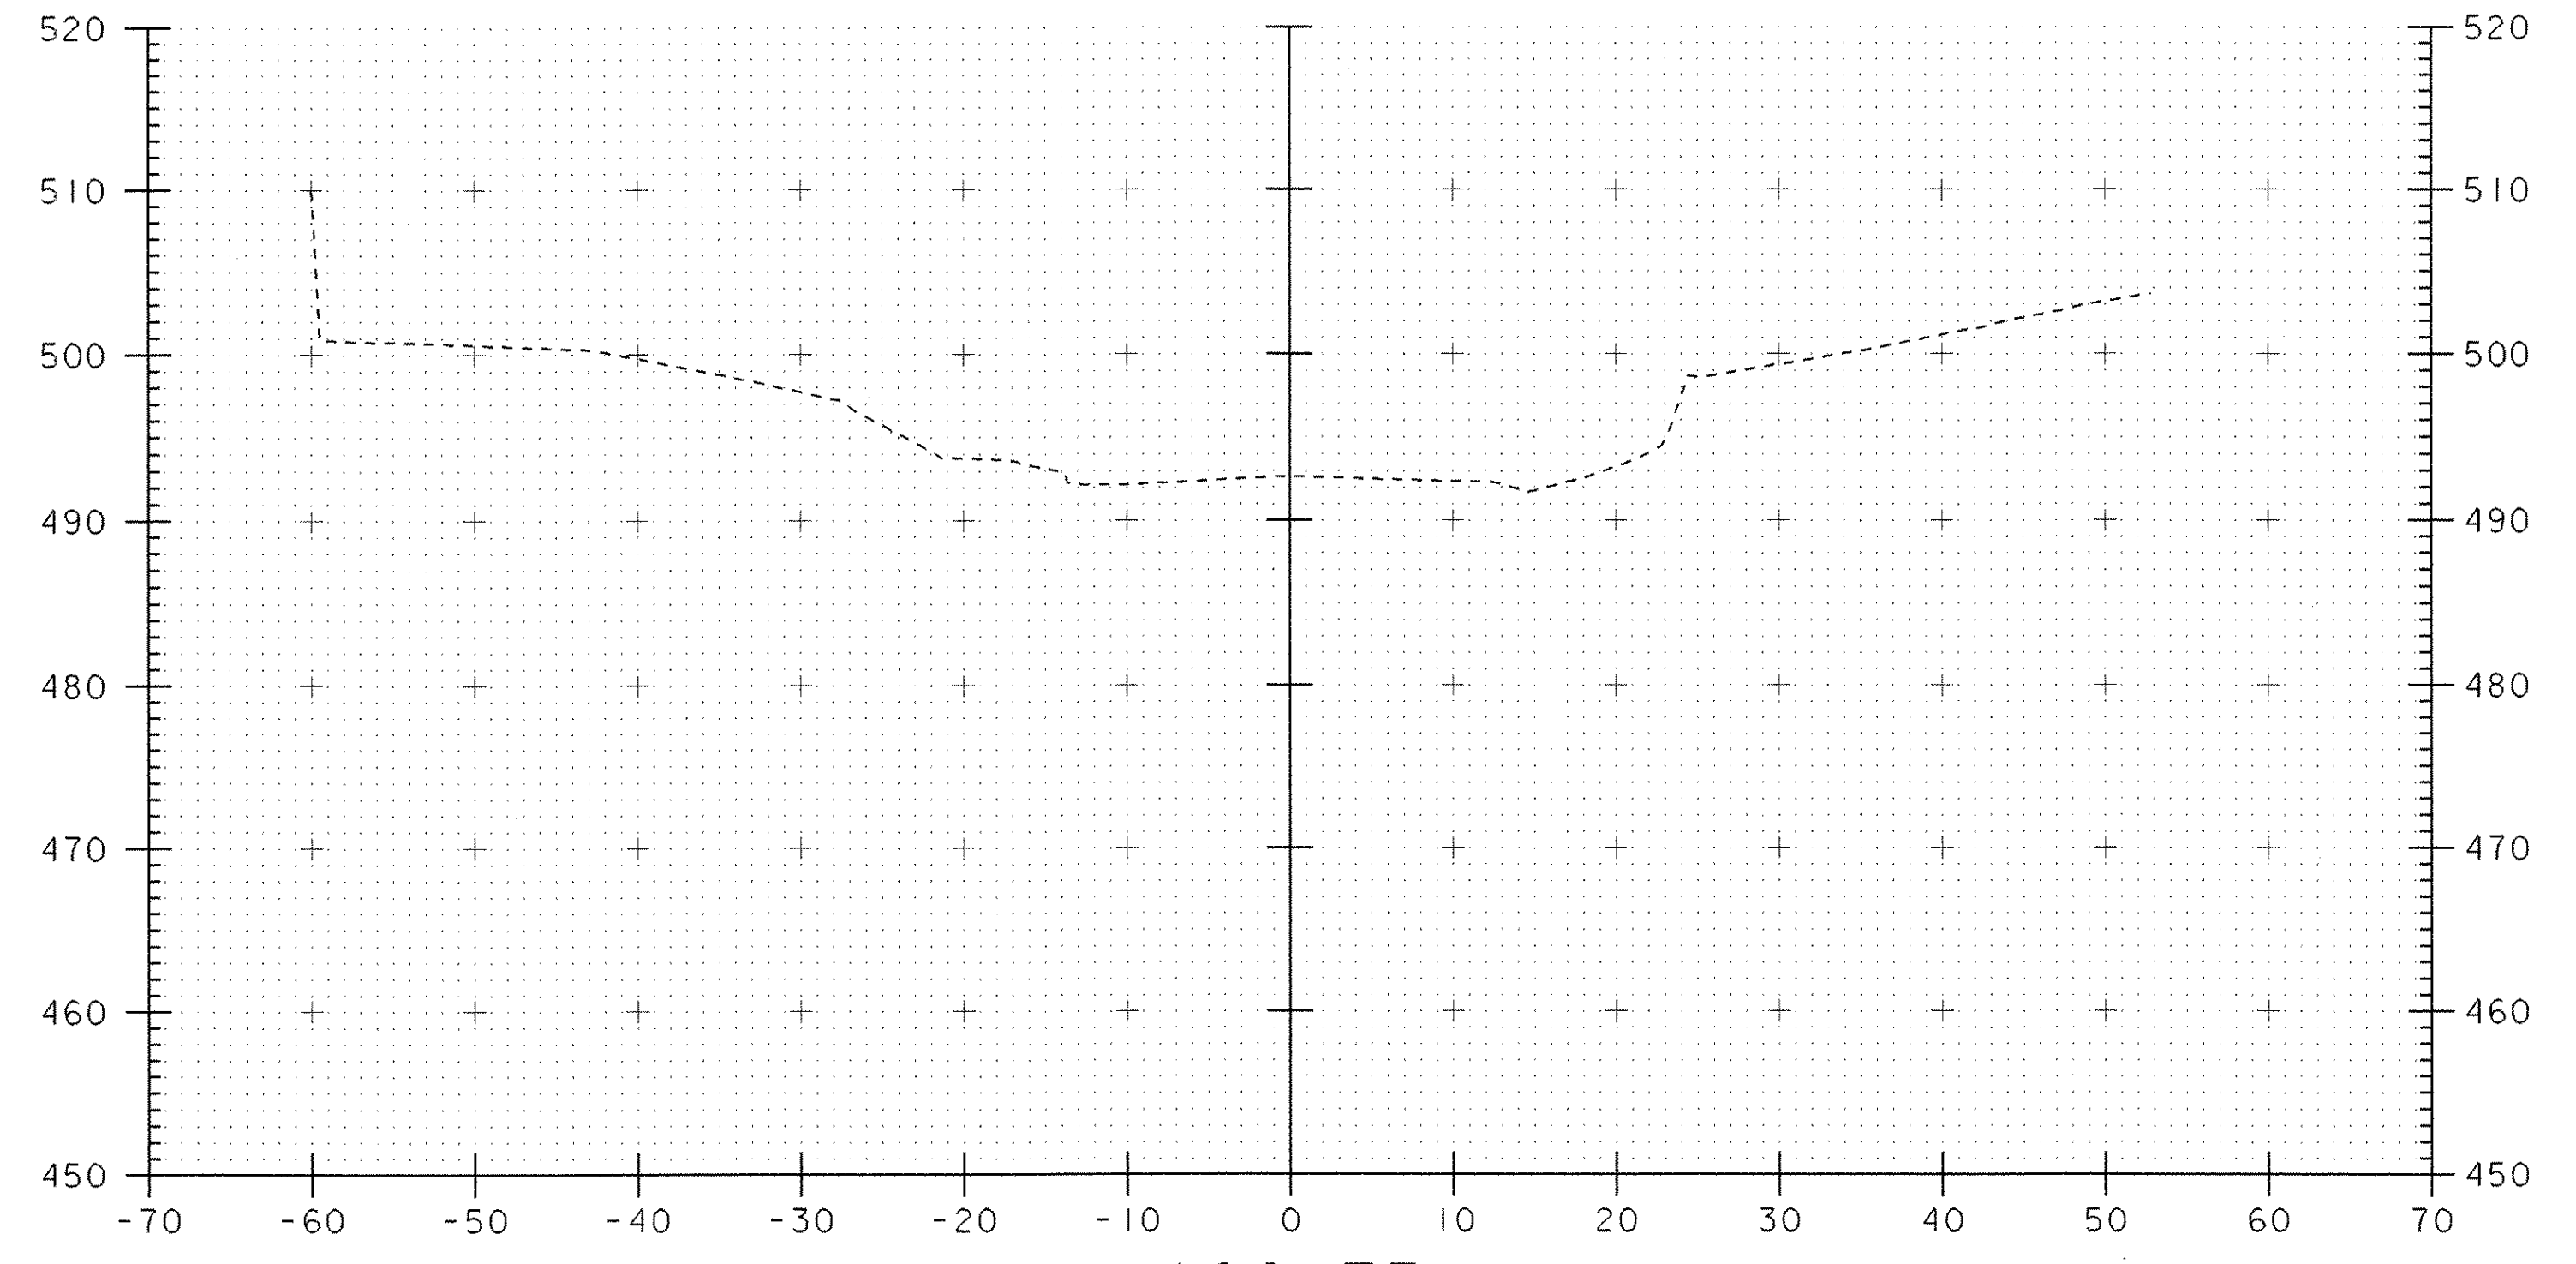

100+75

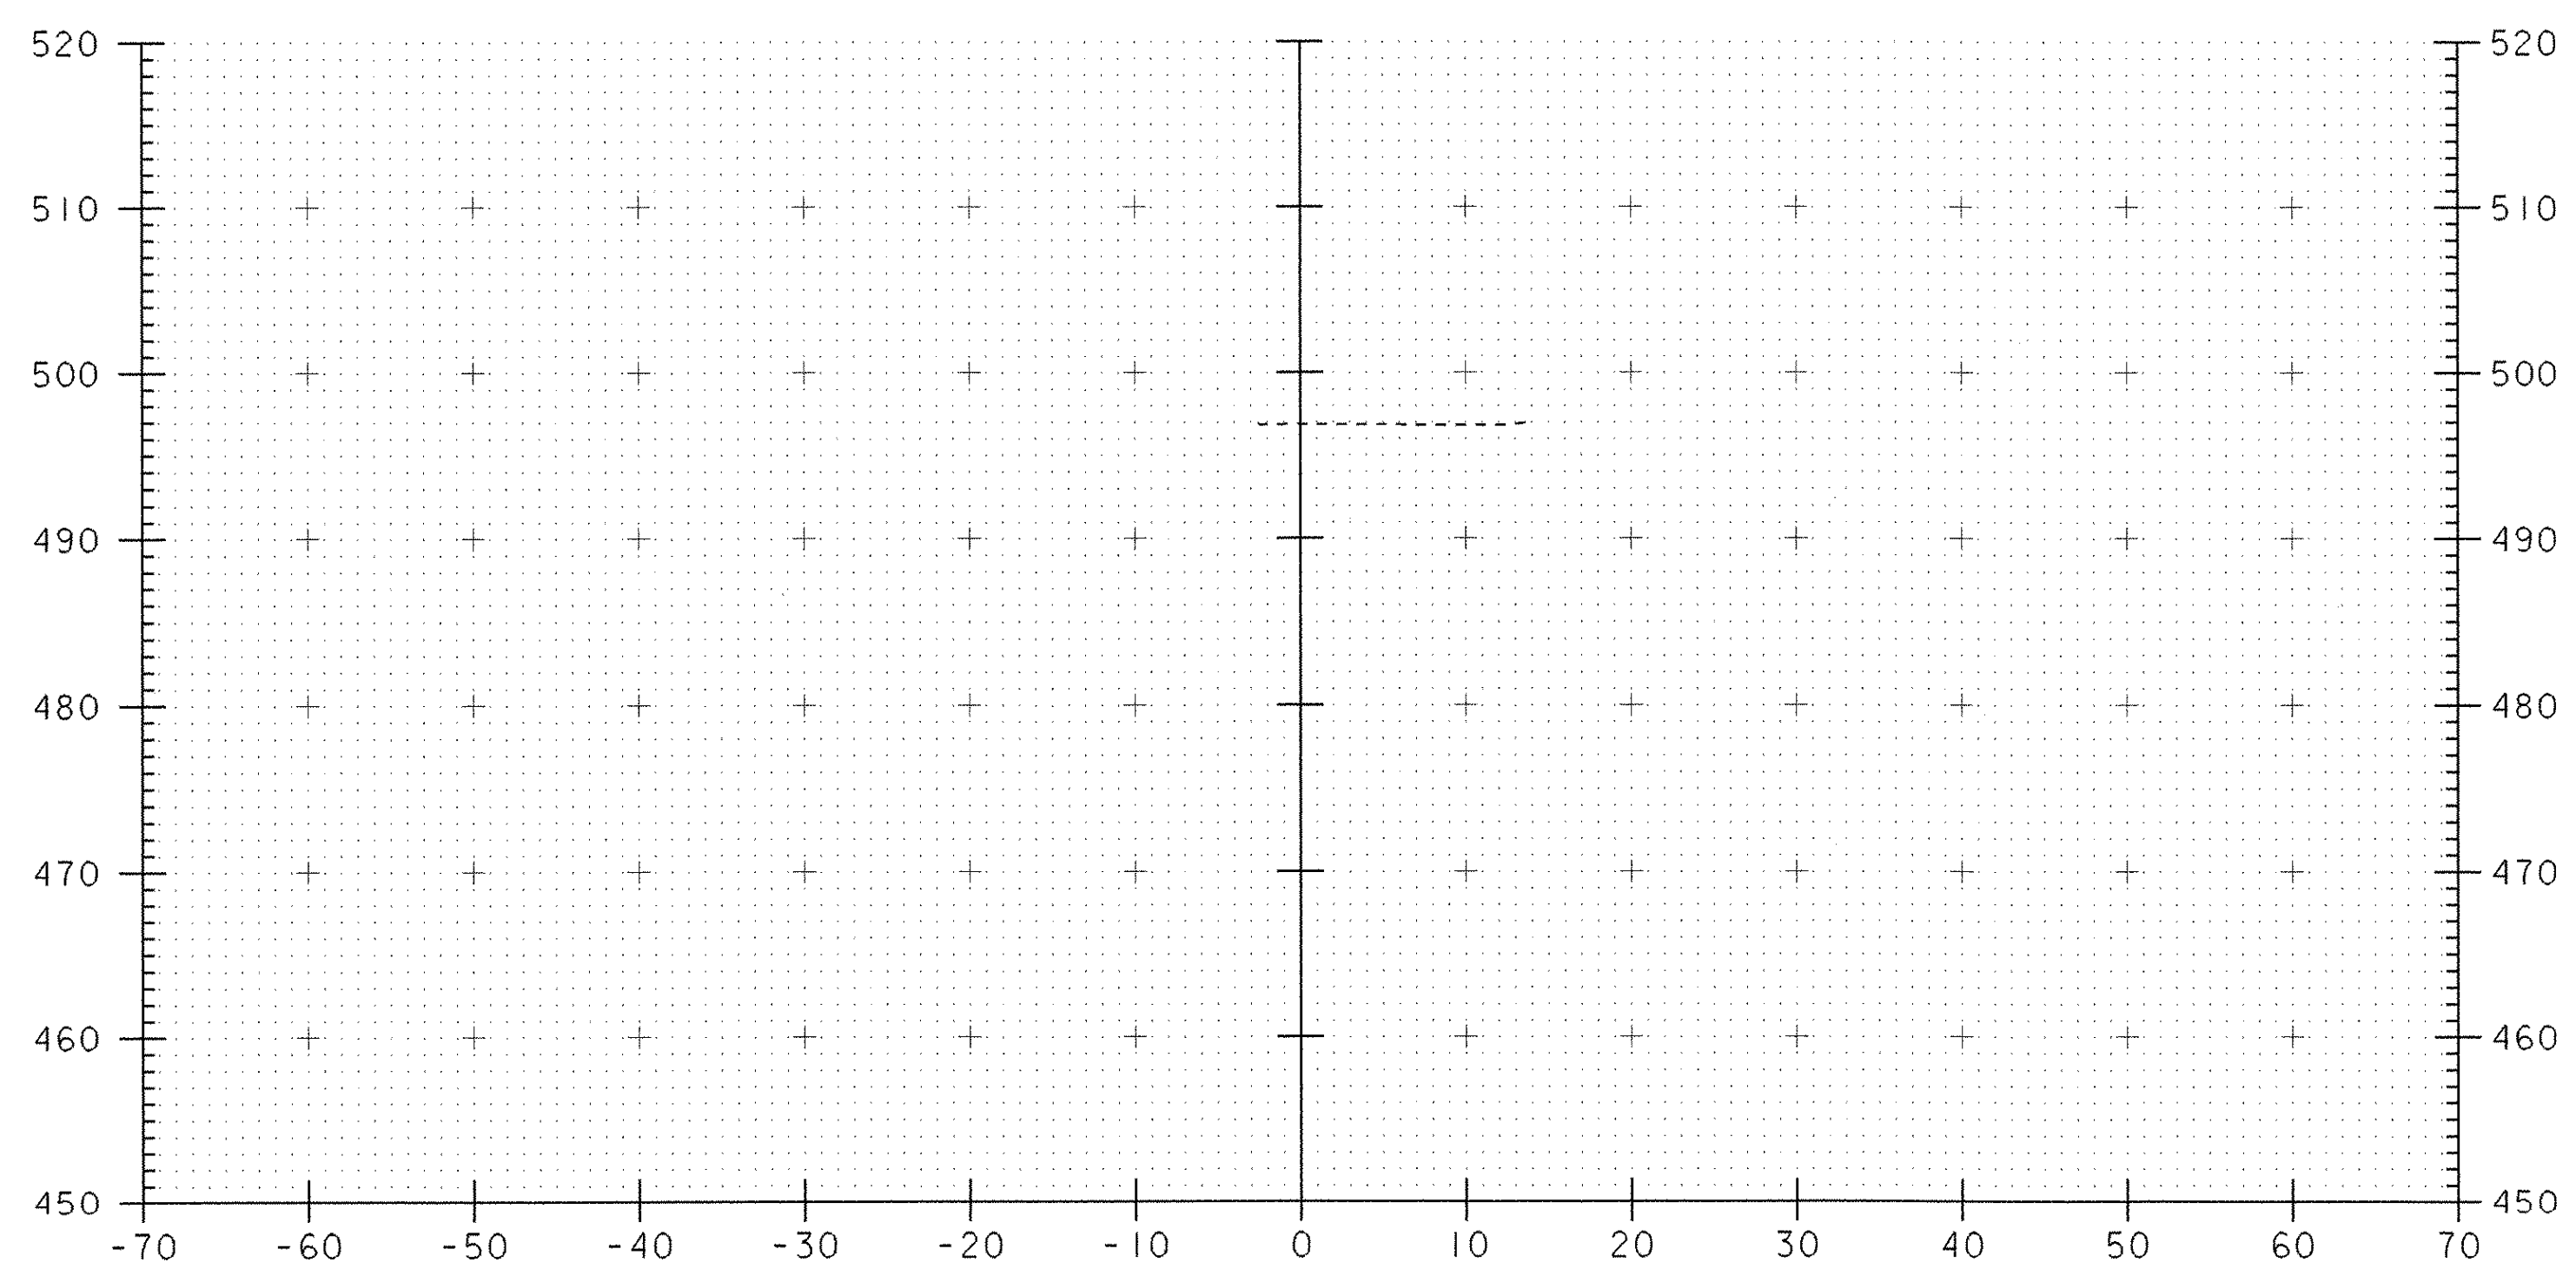

100+00

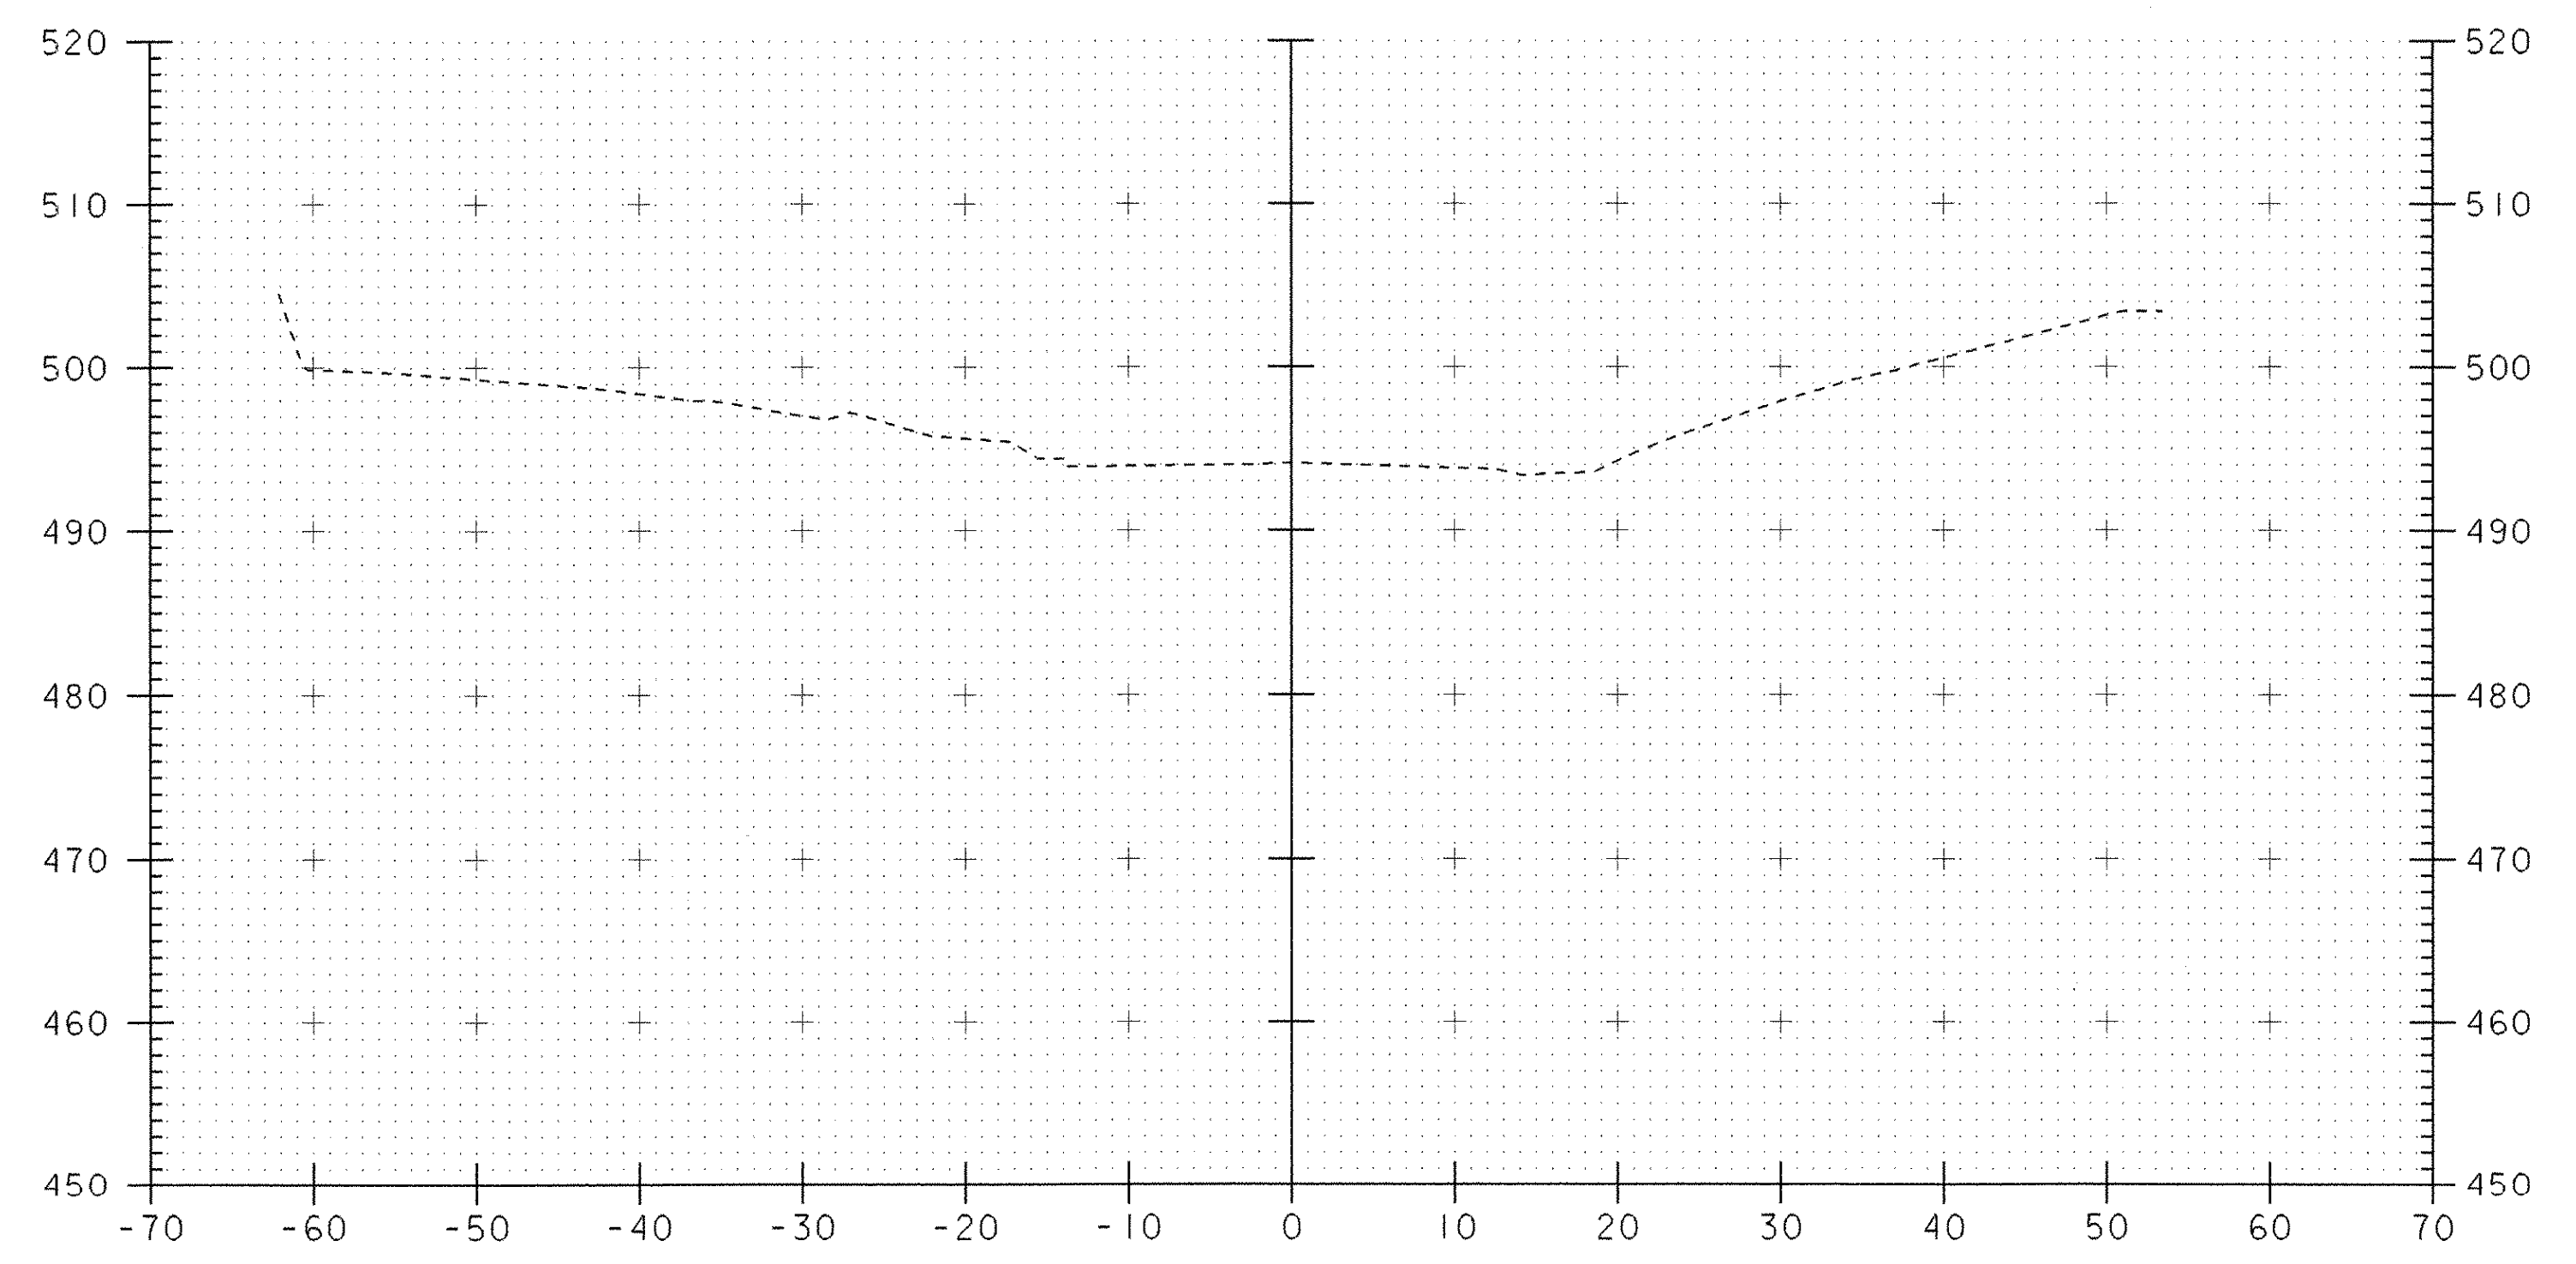

100+50

PROJECT: ROYALTON	PROJECT NO. : BRZ 1444(22)
DESIGN FILE NAME: 89j099/structures/sj099mix.dgn	PLOT DATE: 25-SEP-2000
IPARM FILE NAME: sj099m01.i	
MAINLINE CROSS SECTIONS 100+00 TO 100+75	
SHEET: 95 OF 118	

