

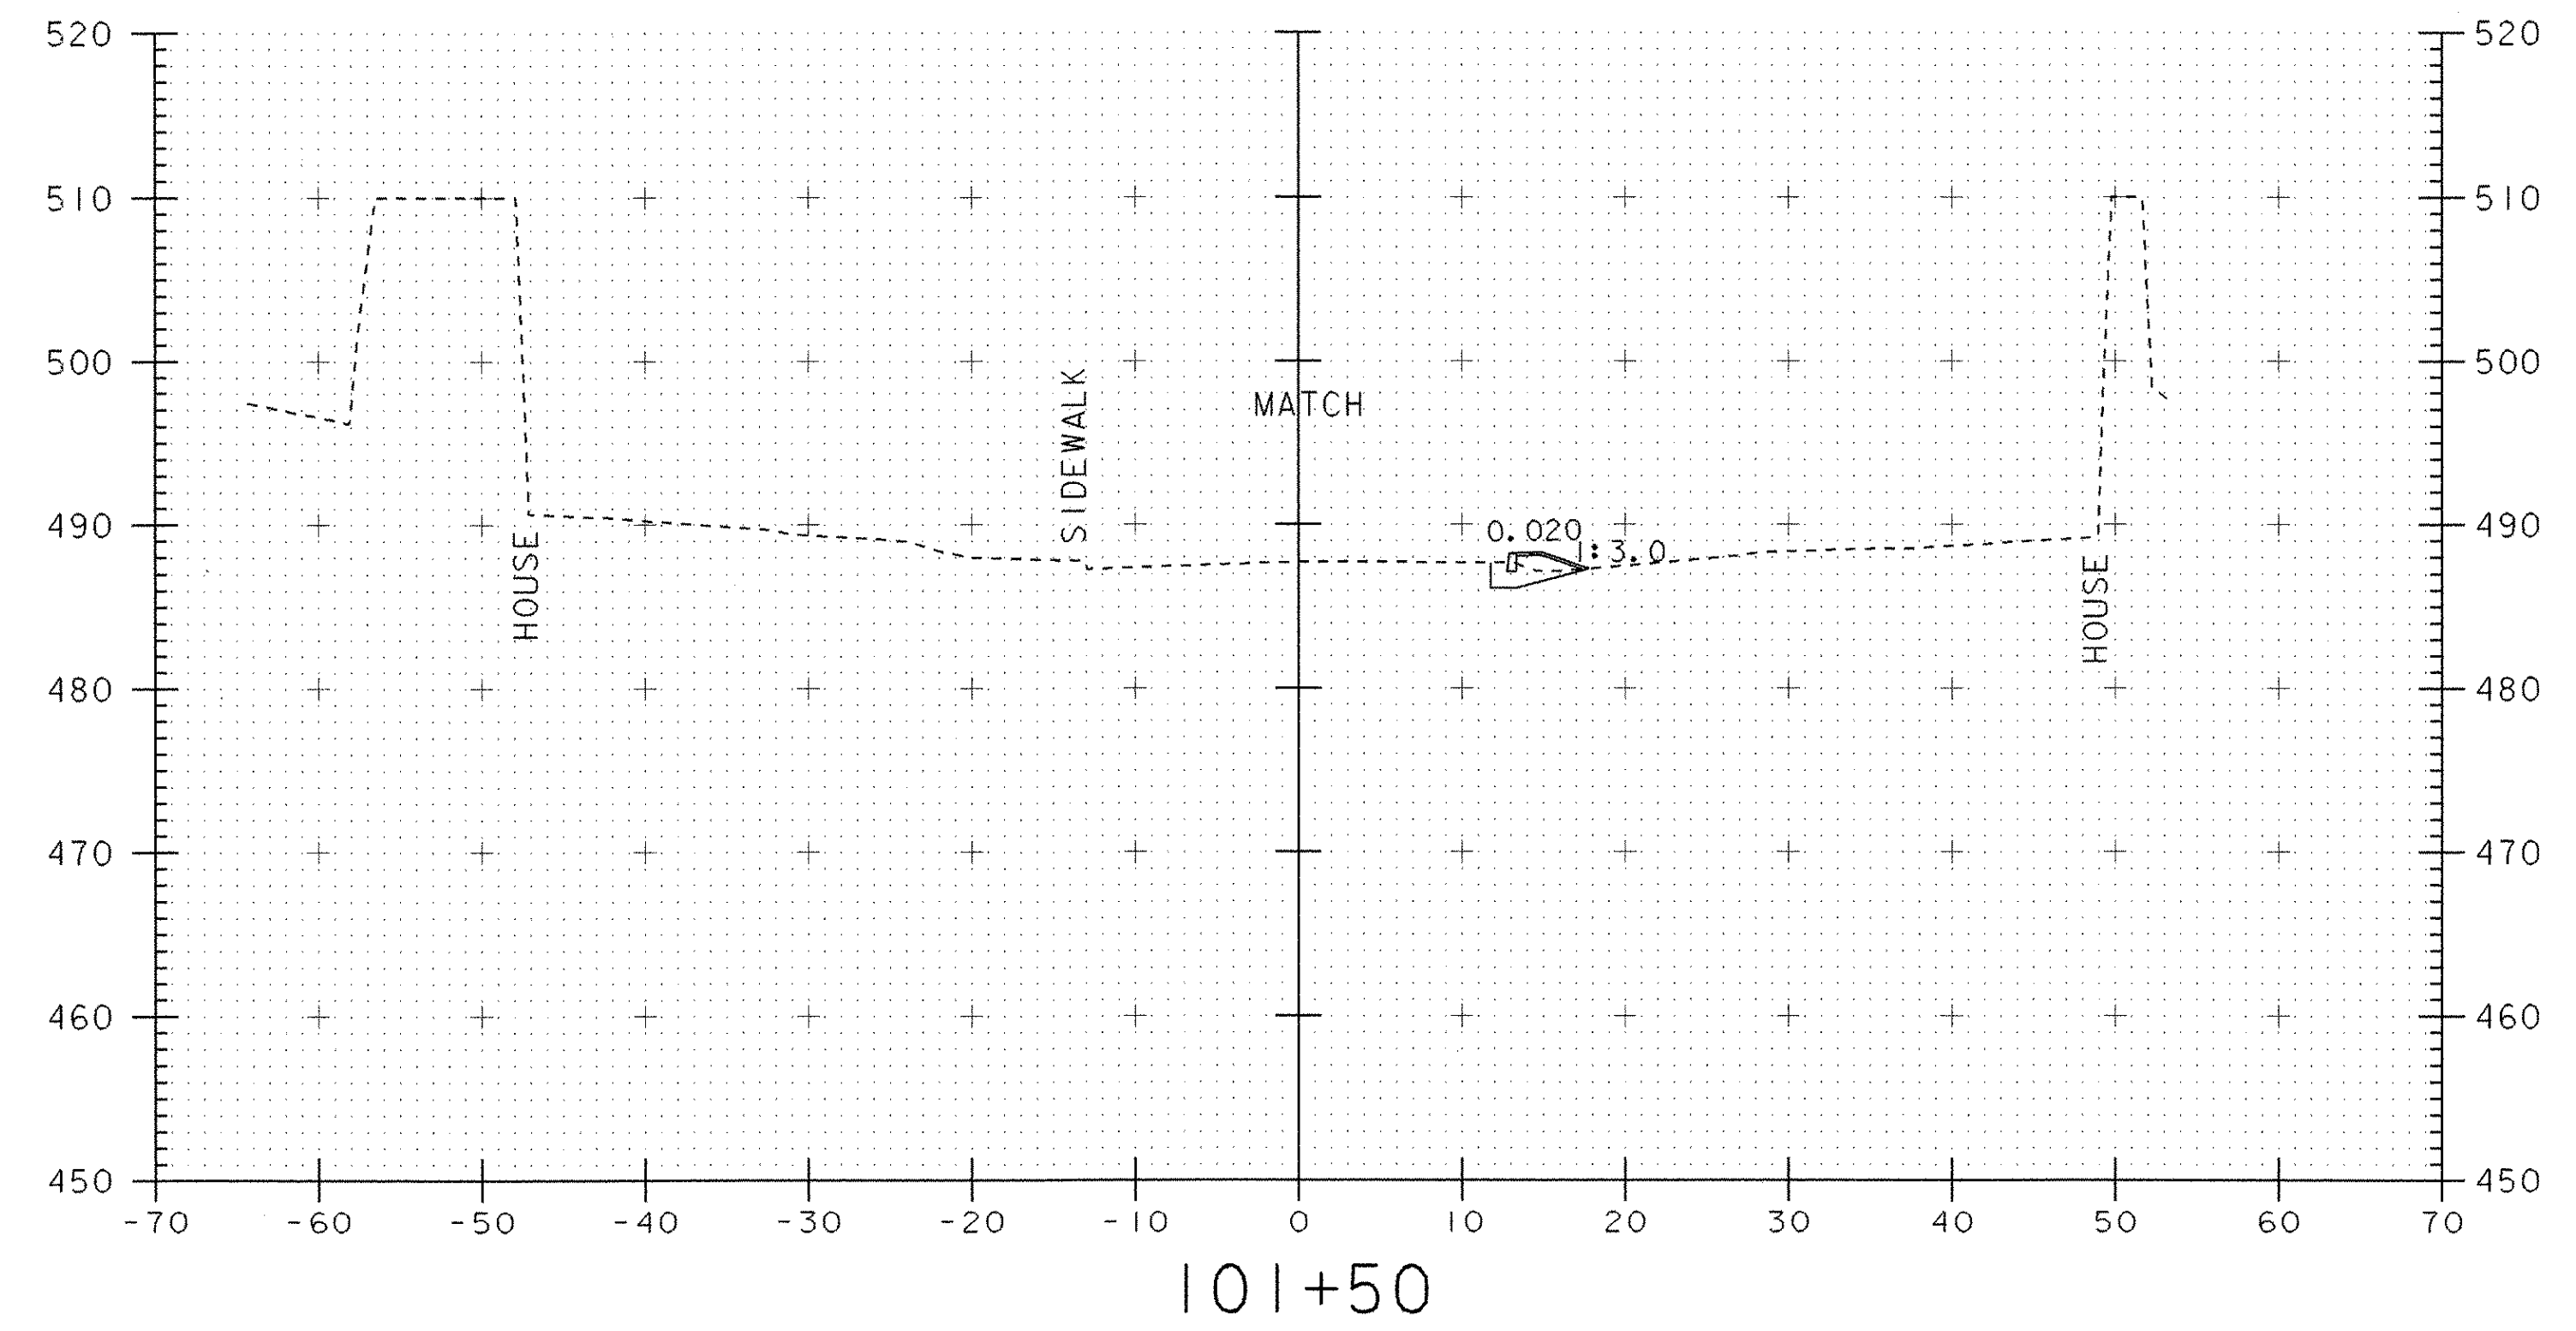


STA 101+75
 TRANSITION SUBBASE FROM EXISTING TO
 PROPOSED TYPICAL IN 50' (6" MINIMUM)
 END COLD PLANING

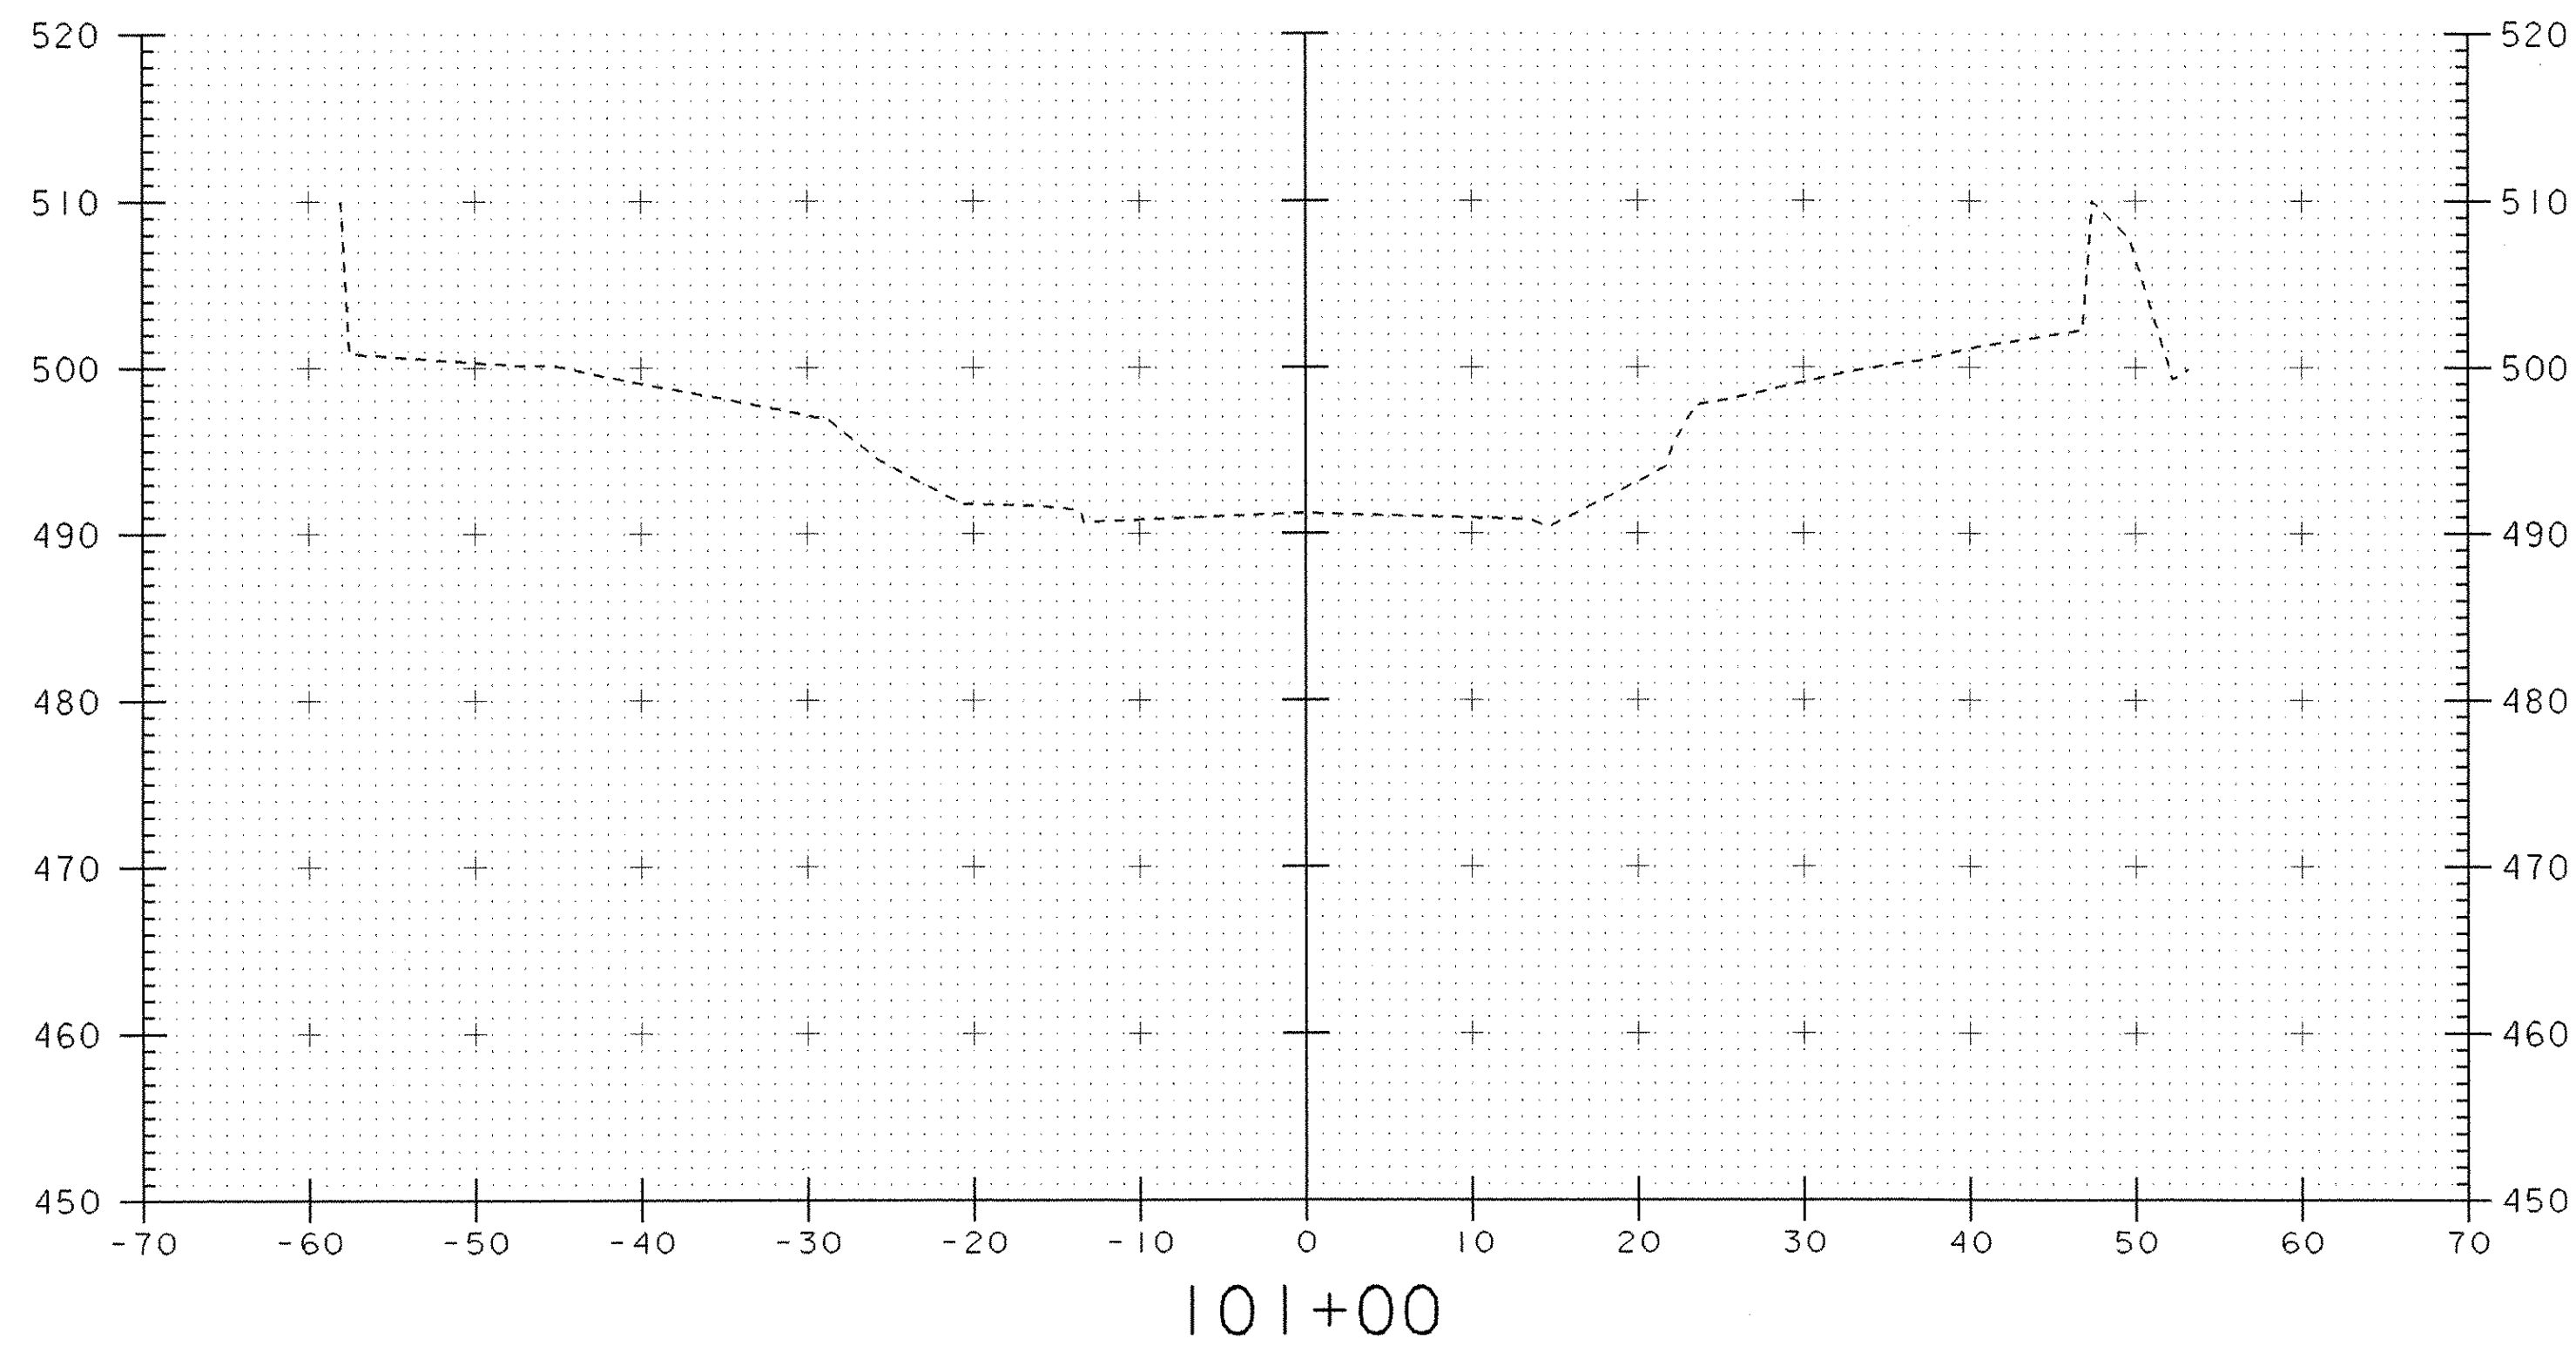

STA 101+50
 BEGIN APPROACH
 BEGIN COLD PLANING TO TRANSITION
 PAVEMENT

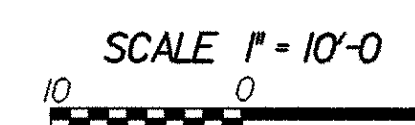

PROJECT: ROYALTON	PROJECT NO.: BRZ 1444(22)
DESIGN FILE NAME: 89j099/structures/sj099mix.dgn	IPARM FILE NAME: sj099m02.i
PLOT DATE: 25-SEP-2000	
MAINLINE CROSS SECTIONS 101+00 TO 101+75	
SHEET: 96 OF 118	