


STA 102+25
 END APPROACH / BEGIN PROJECT
 END SUBBASE TAPER
 BEGIN SAND BORROW - BOX CUT SAND TO FULL DEPTH

STATION 102+07 LT
 BEGIN NEW 18" OPTION PIPE
 CONSTRUCT NEW 4' X 4' CONC. DI
 REMOVE EXISTING DI

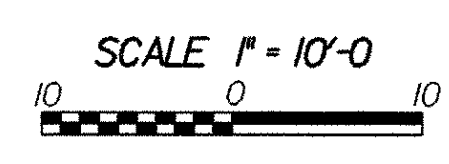

PROJECT: ROYALTON	PROJECT NO.: BRZ 1444(22)
DESIGN FILE NAME: 89j099/structures/sj099mix.dgn	PLOT DATE: 25-SEP-2000
IPARM FILE NAME: sj099m03.i	MAINLINE CROSS SECTIONS 101+88 TO 102+25
SHEET: 97 OF 118	