



102+85


STATION 102+85 RT
 BEGIN NEW 18" OPTION PIPE
 CONSTRUCT NEW 4' X4' CONC. DI

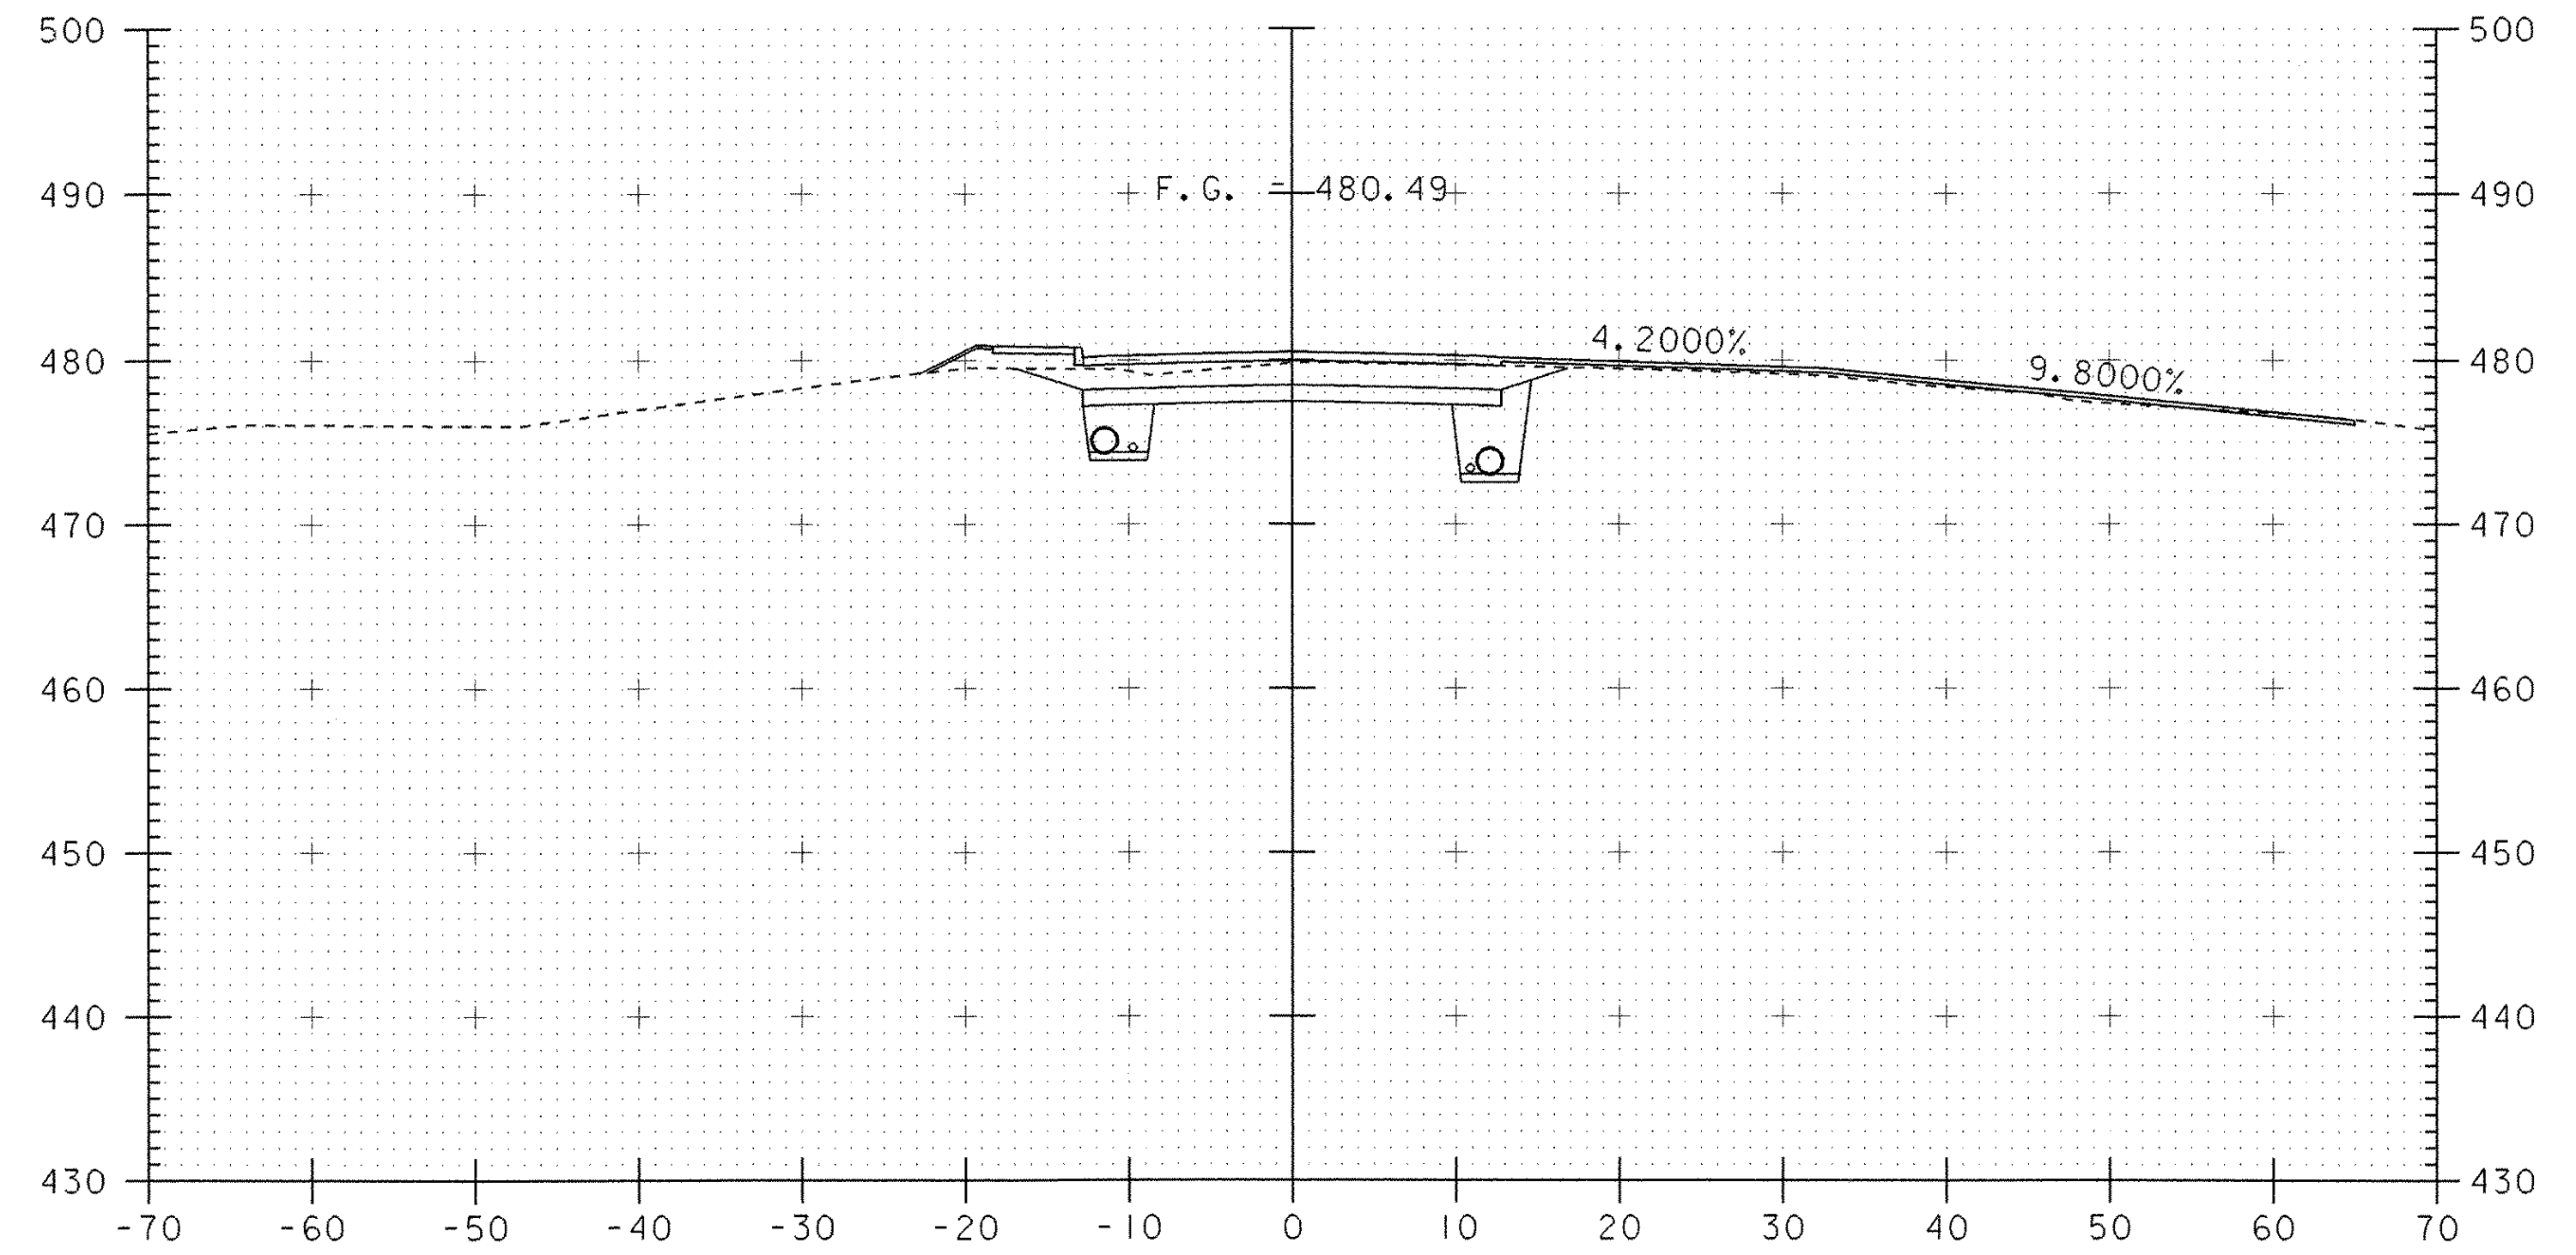

103+10

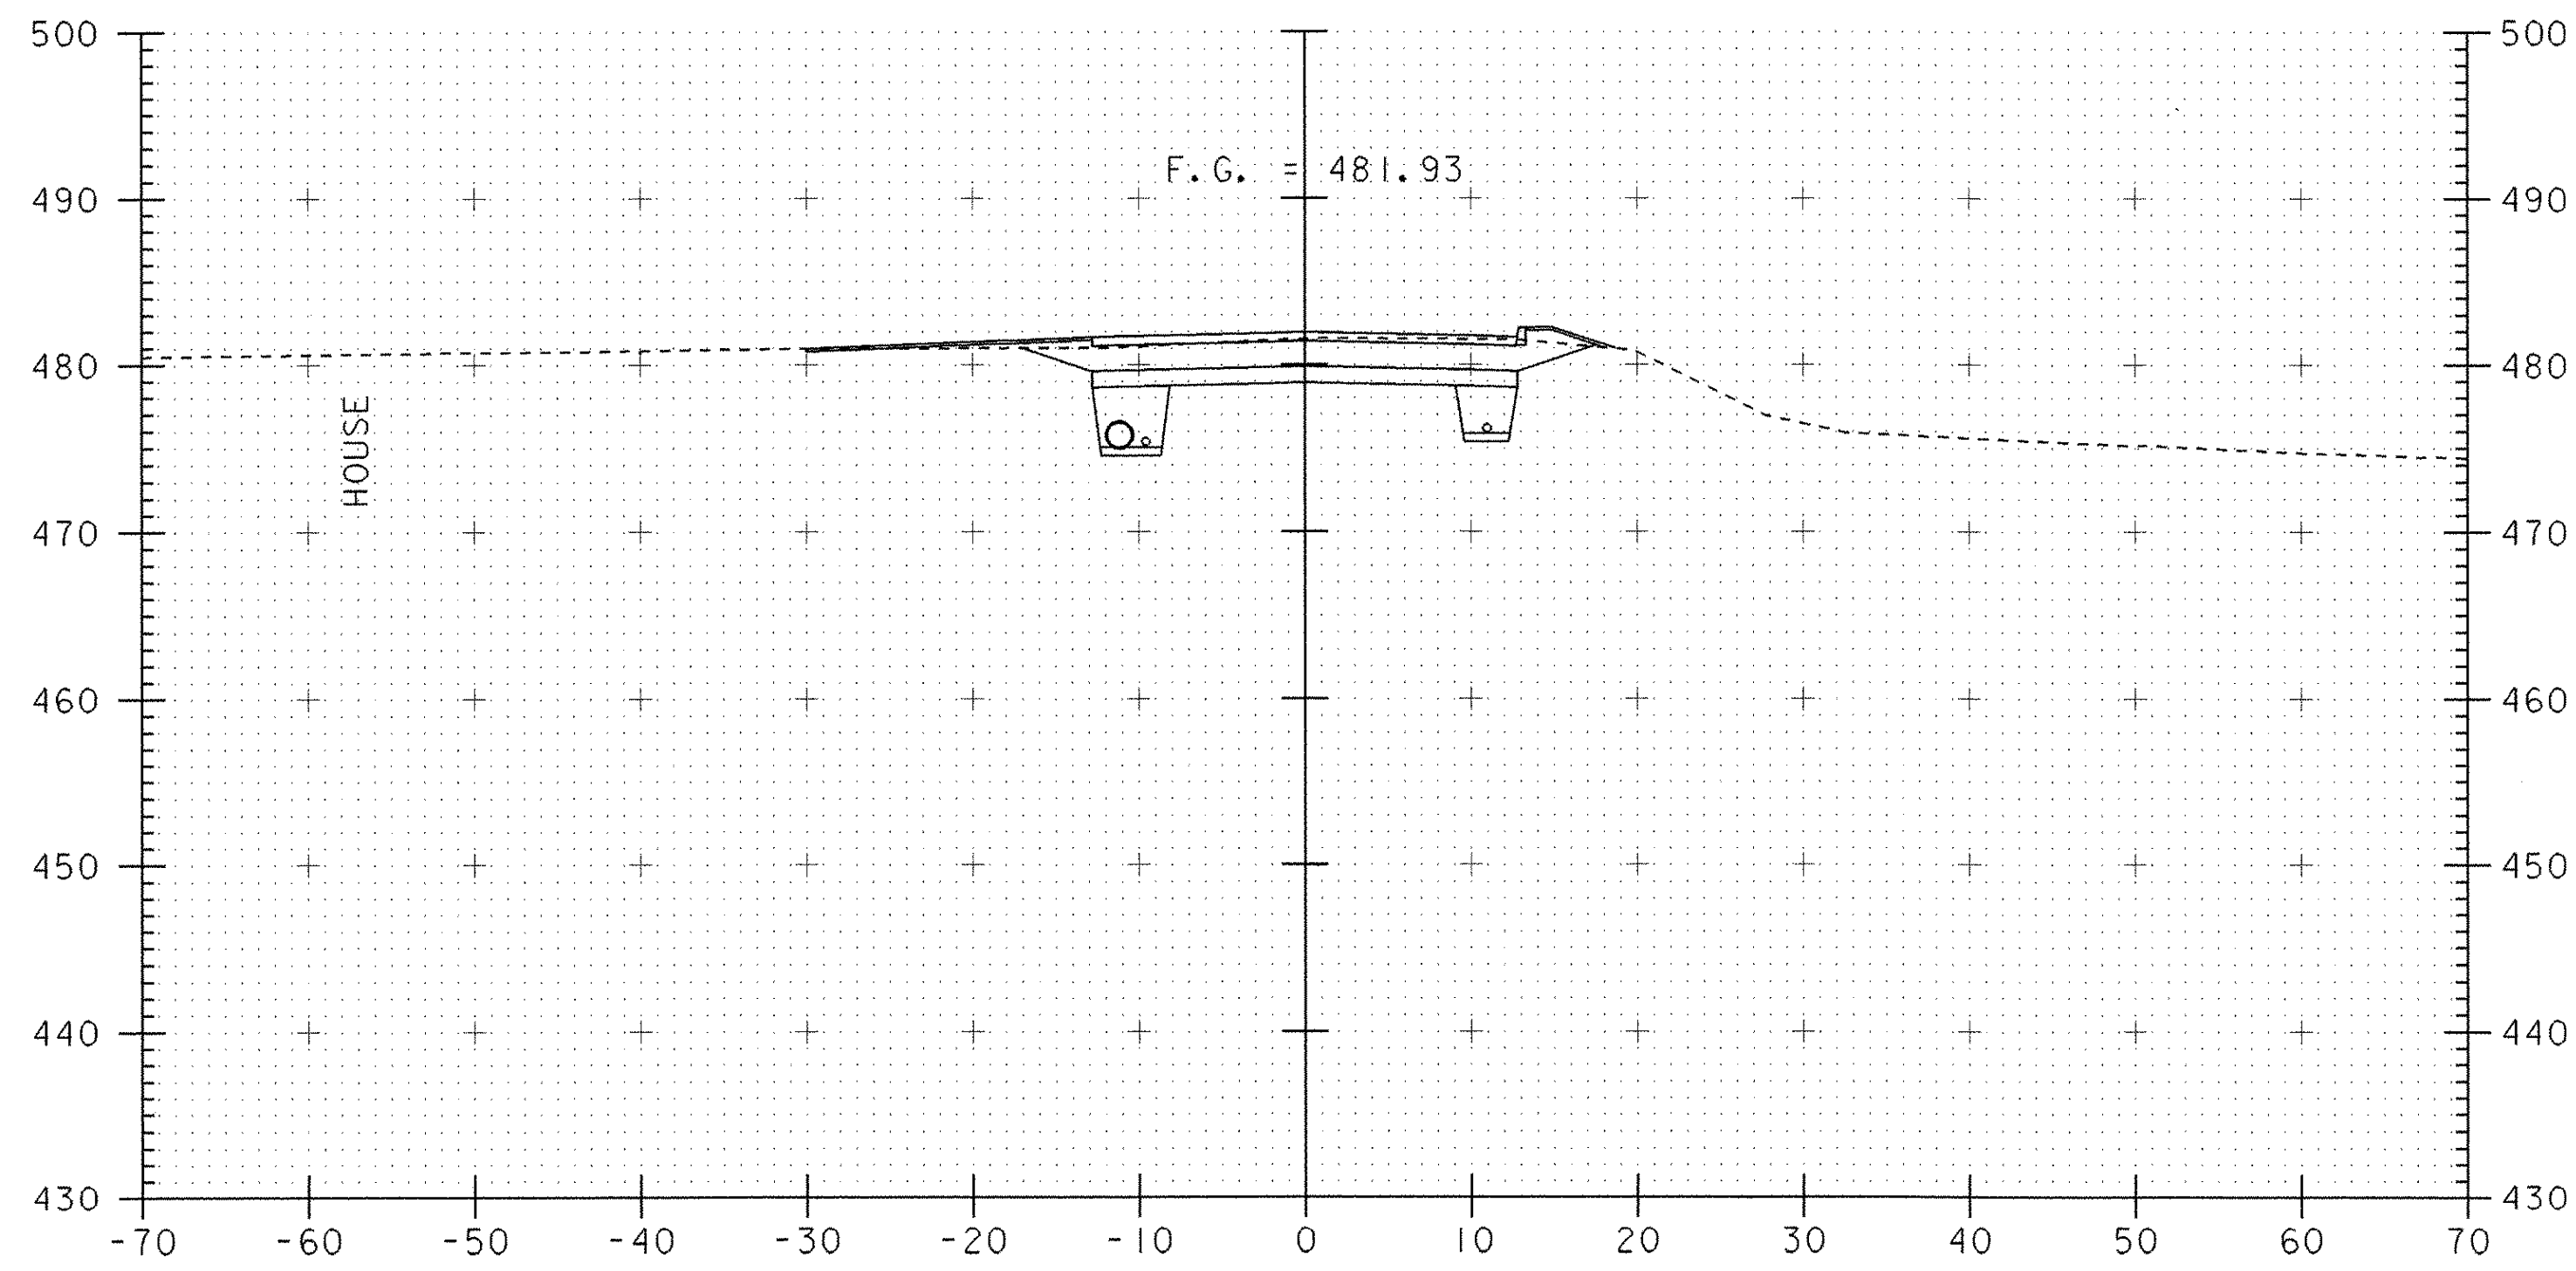

102+50

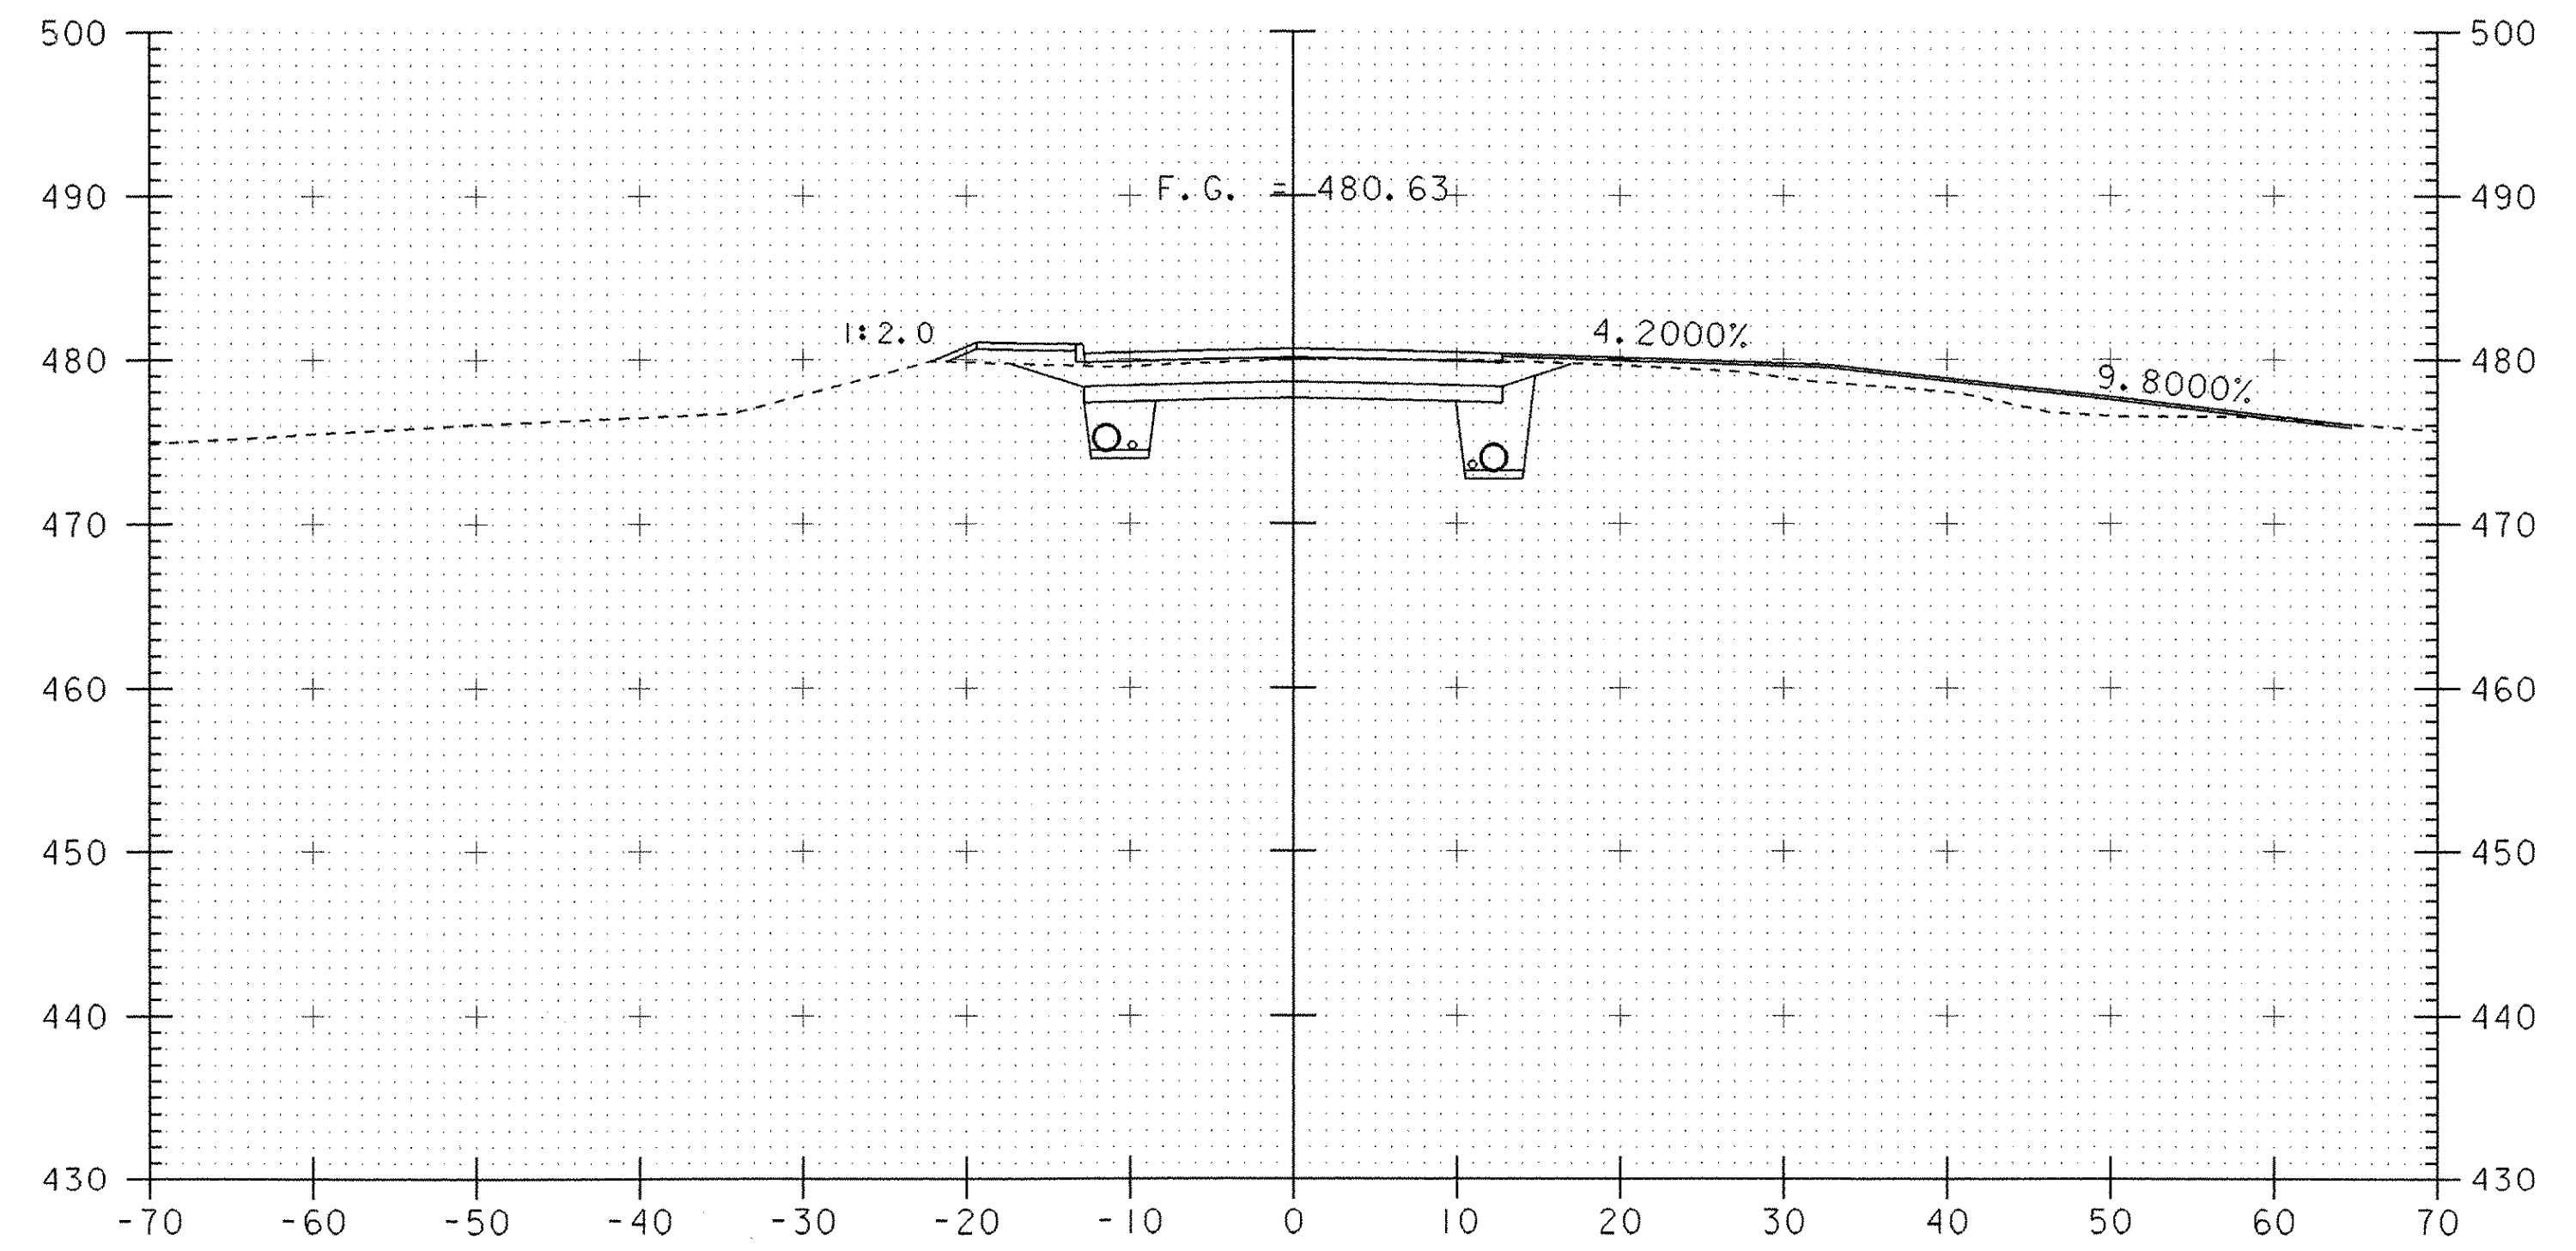

103+00

SCALE 1" = 10'-0"

PROJECT: ROYALTON	PROJECT NO. : BRZ 1444(22)
DESIGN FILE NAME: 89j099/structures/sj099mx.dgn	PLOT DATE: 25-SEP-2000
IPARM FILE NAME: sj099m04.i	
MAINLINE CROSS SECTIONS 102+50 TO 103+10	
SHEET: 98 OF 118	