


STATION 103+40 LT  
 END NEW 18" OPTION PIPE / BEGIN NEW 18" OPTION PIPE  
 CONSTRUCT NEW 4'X4' CONC. D1


**103+40**

STATION 103+40 RT  
 END NEW 18" OPTION PIPE (2) / BEGIN NEW 24" OPTION PIPE  
 CONSTRUCT NEW 4'X4' CONC. D1

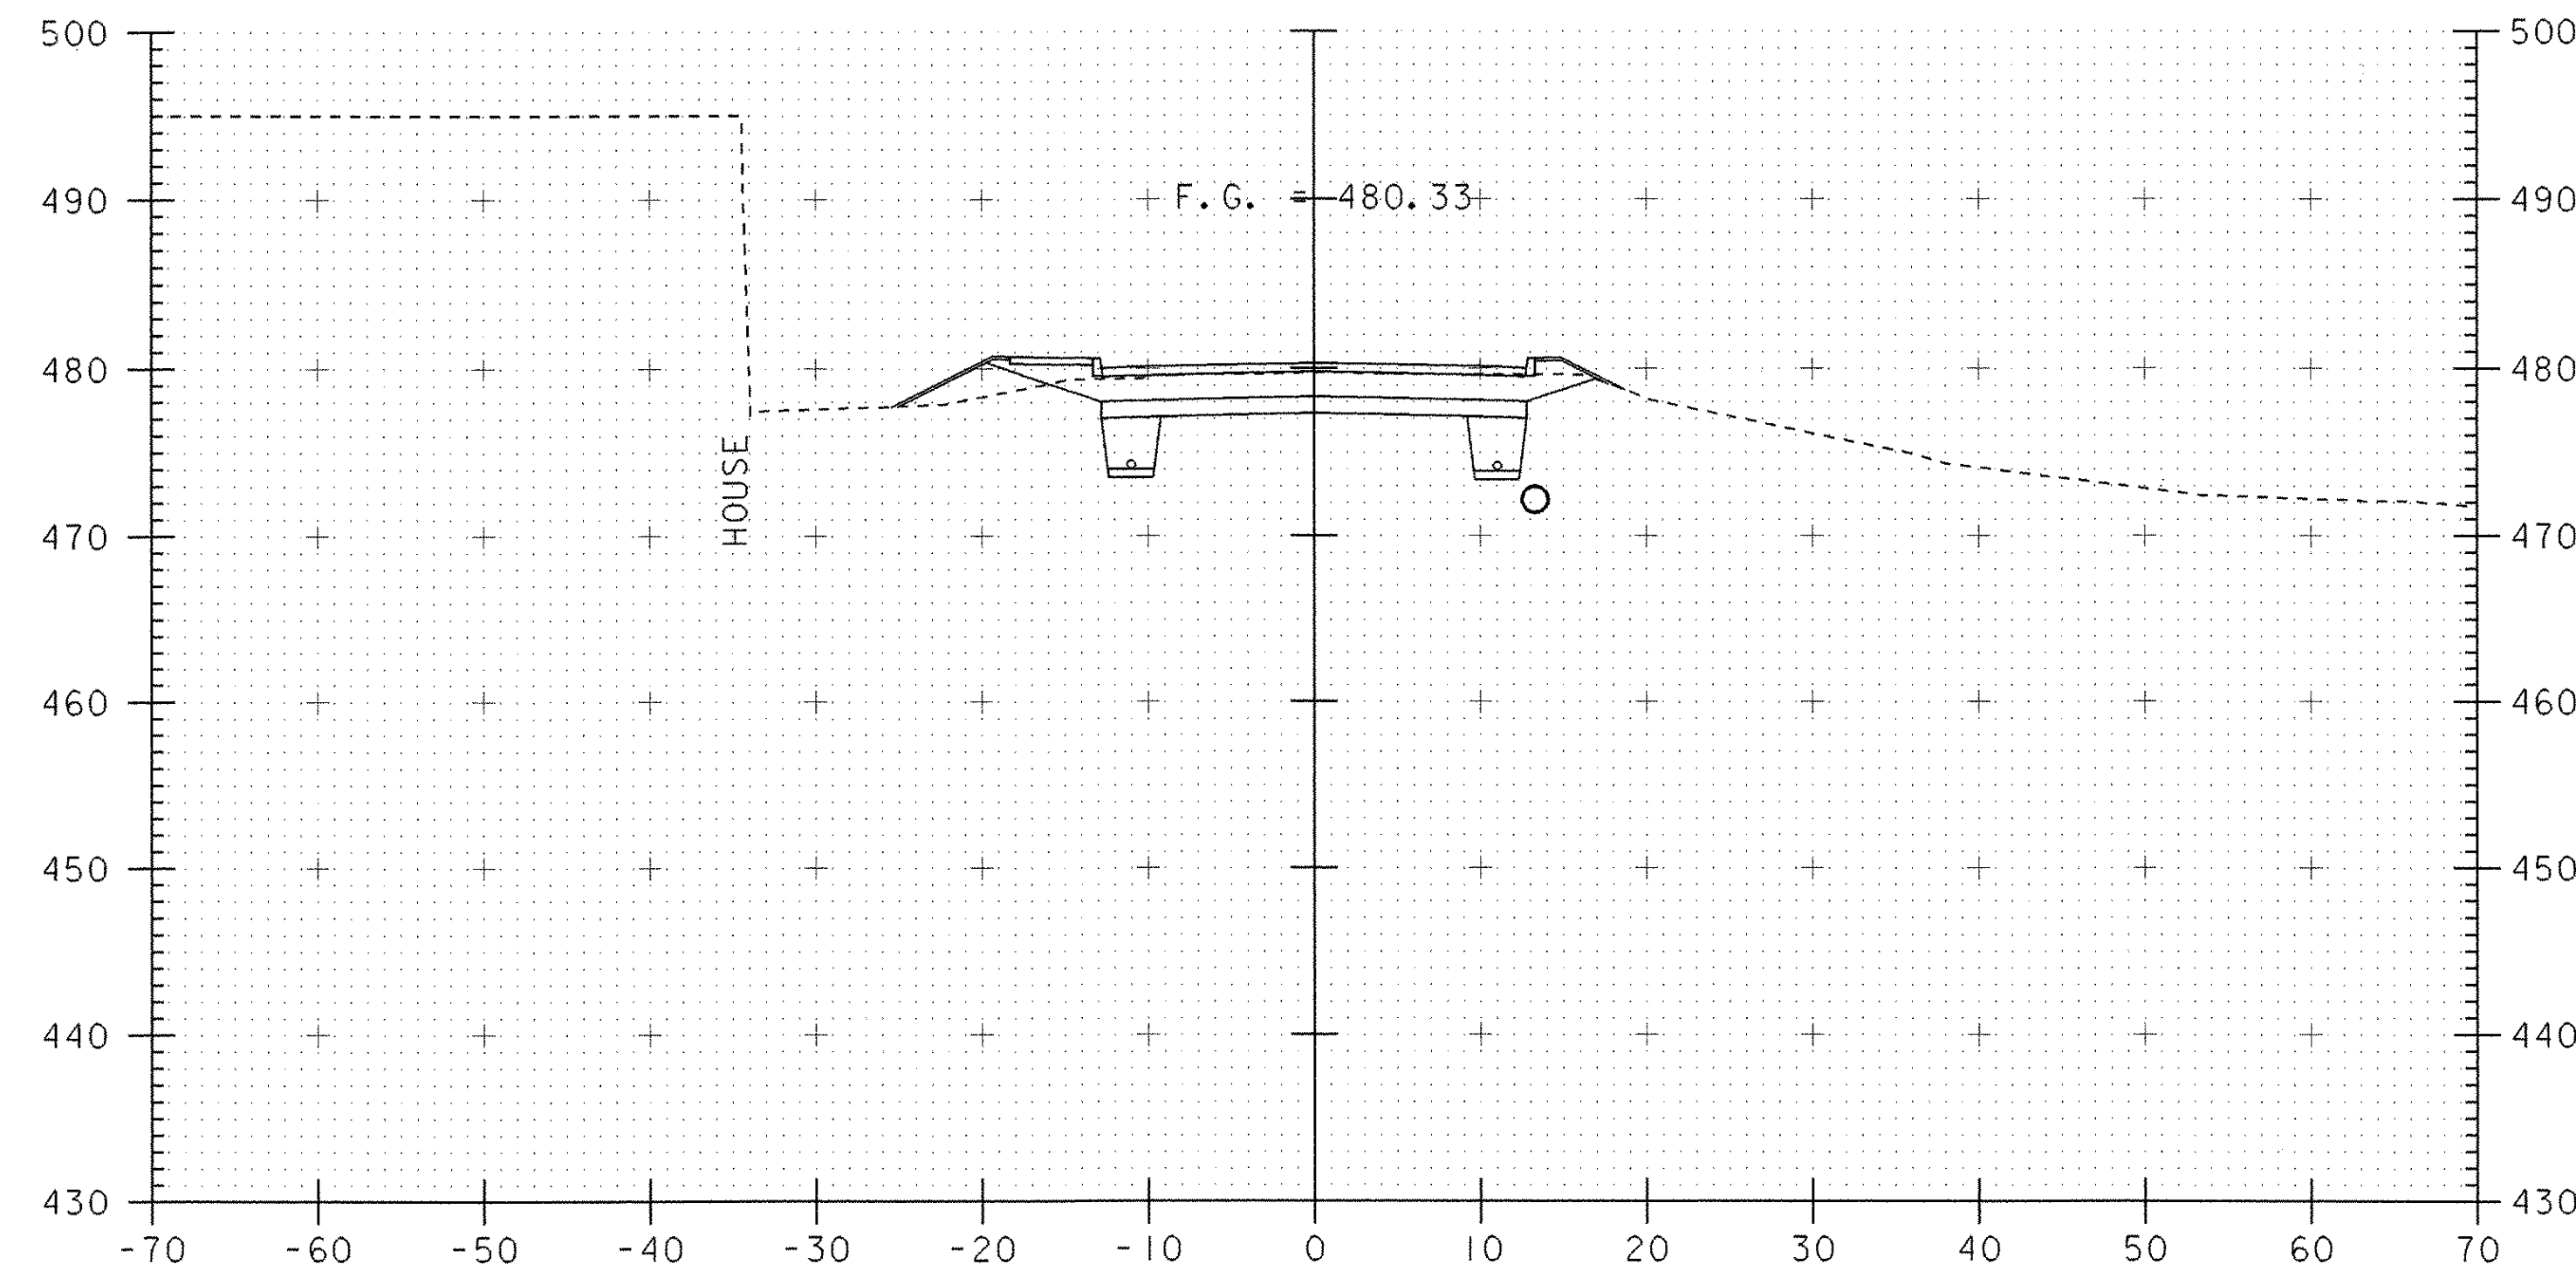


**103+50**

STATION 103+50  
 LINEAR TRANSITION SHOULDER WIDTH FROM 2'-0" TO 5'-0" @ STA 104+25  
 LINEAR TRANSITION FACE OF RAIL FROM 12'-9 1/2" TO 15'-9 1/2" @ STA 104+25  
 LINEAR TRANSITION GRASS STRIP FROM 0' TO 4'-0" @ STA 104+25

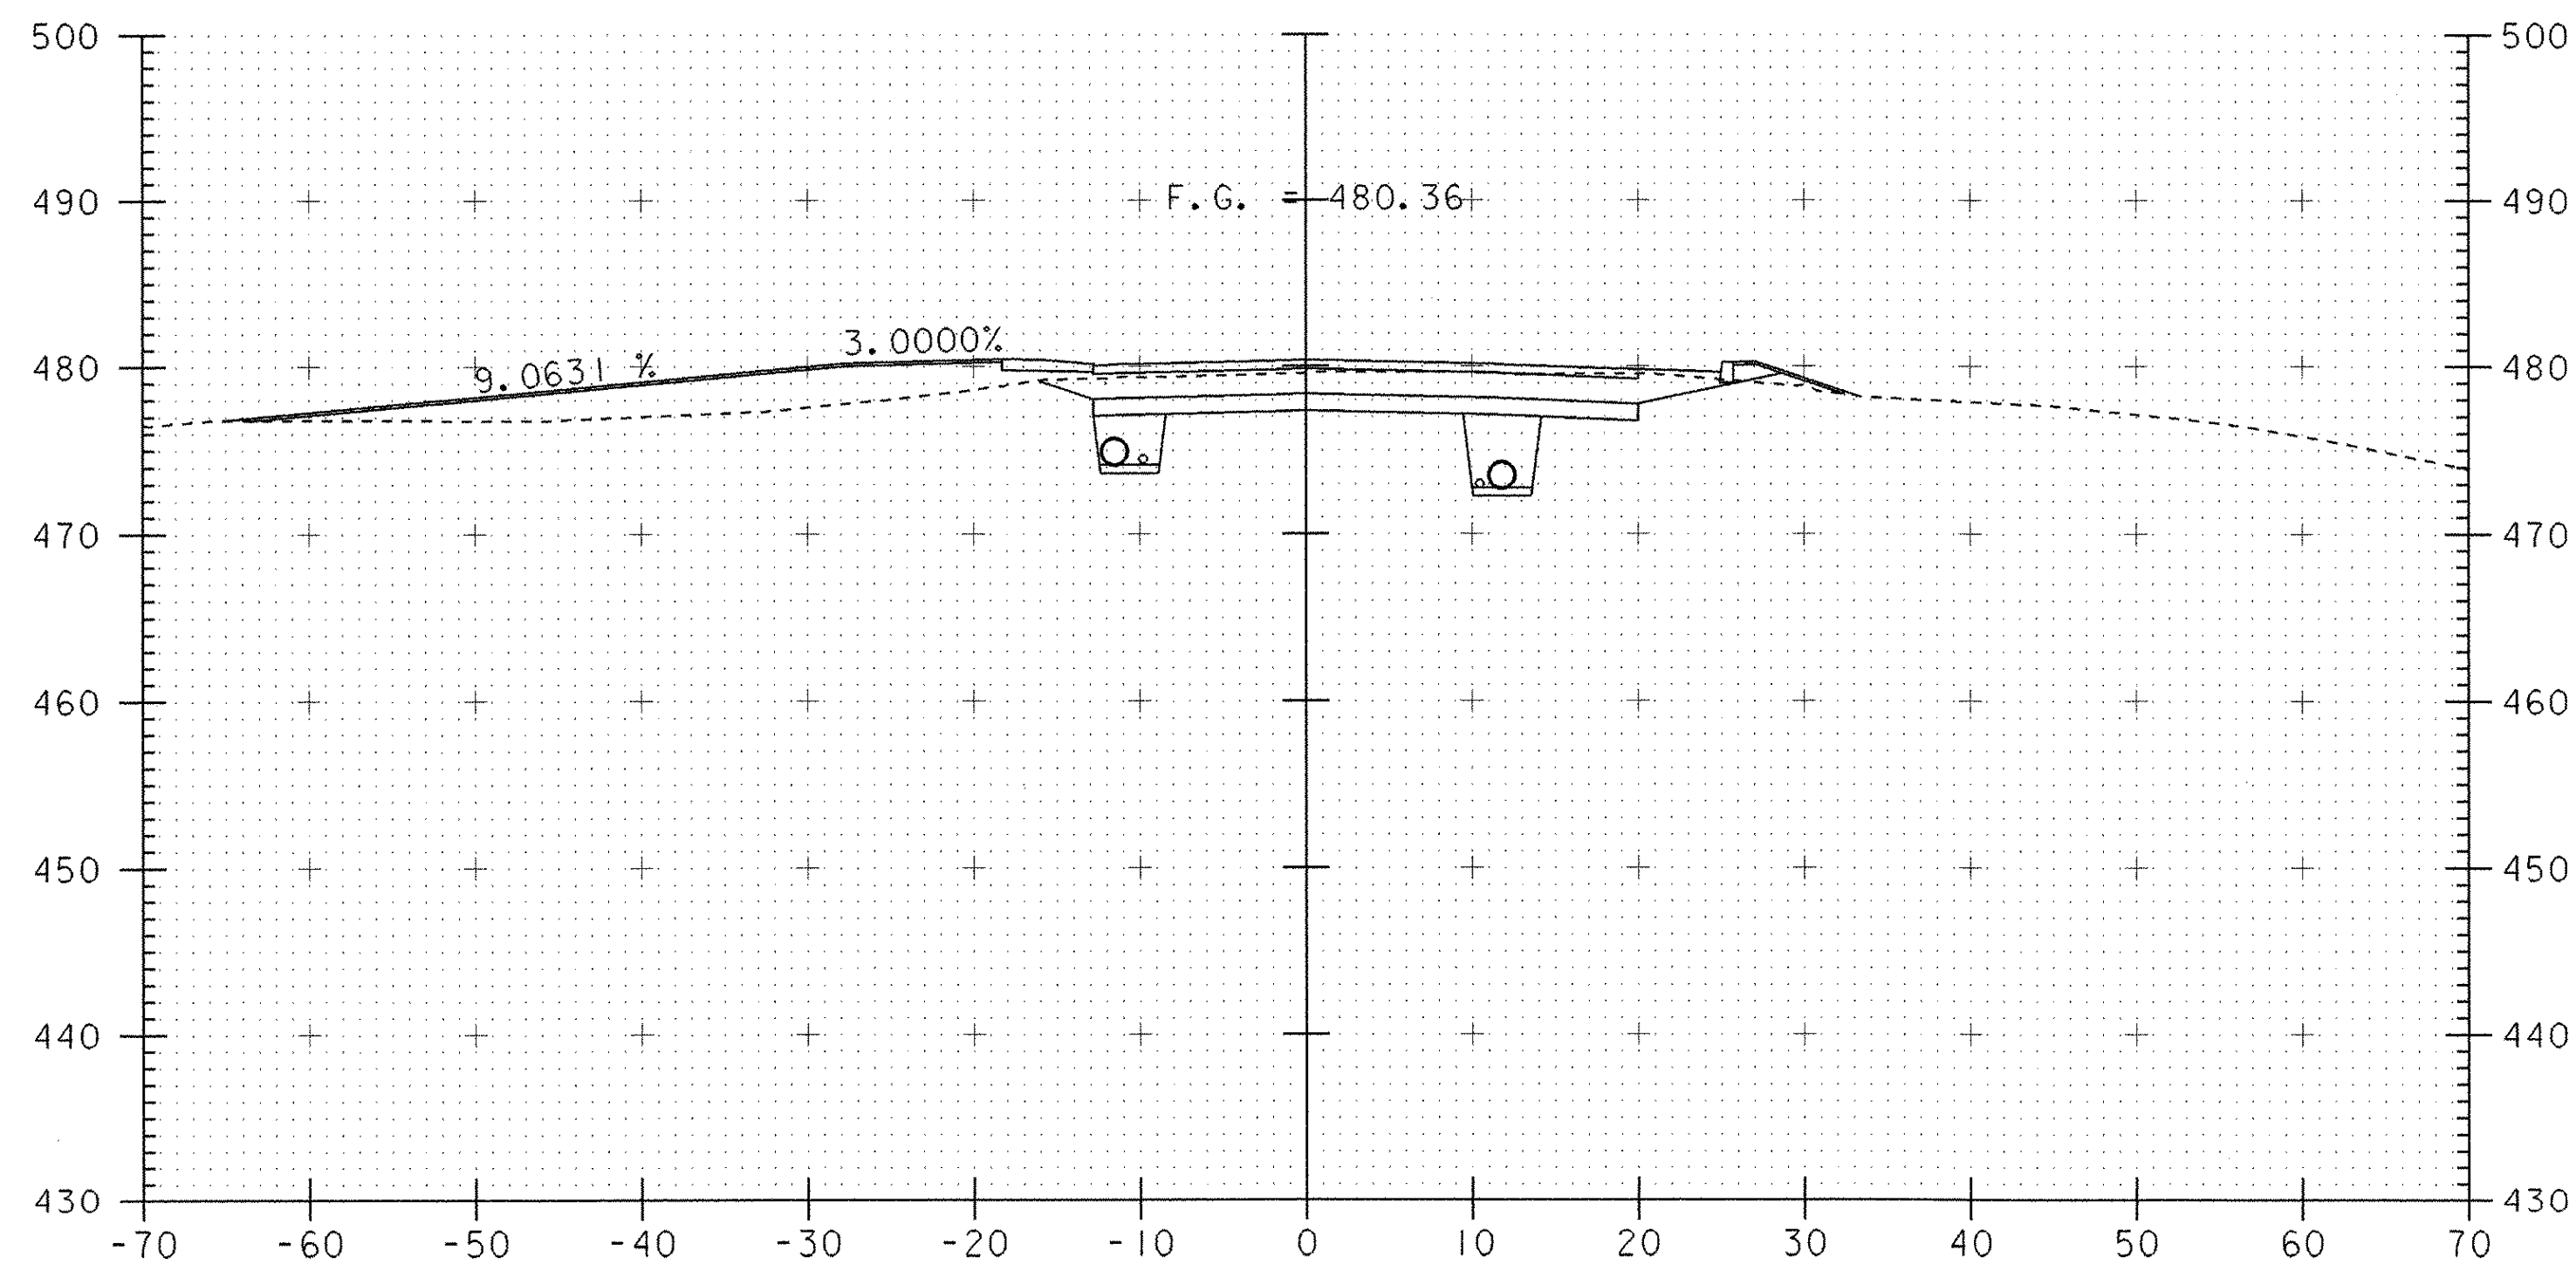

**103+25**

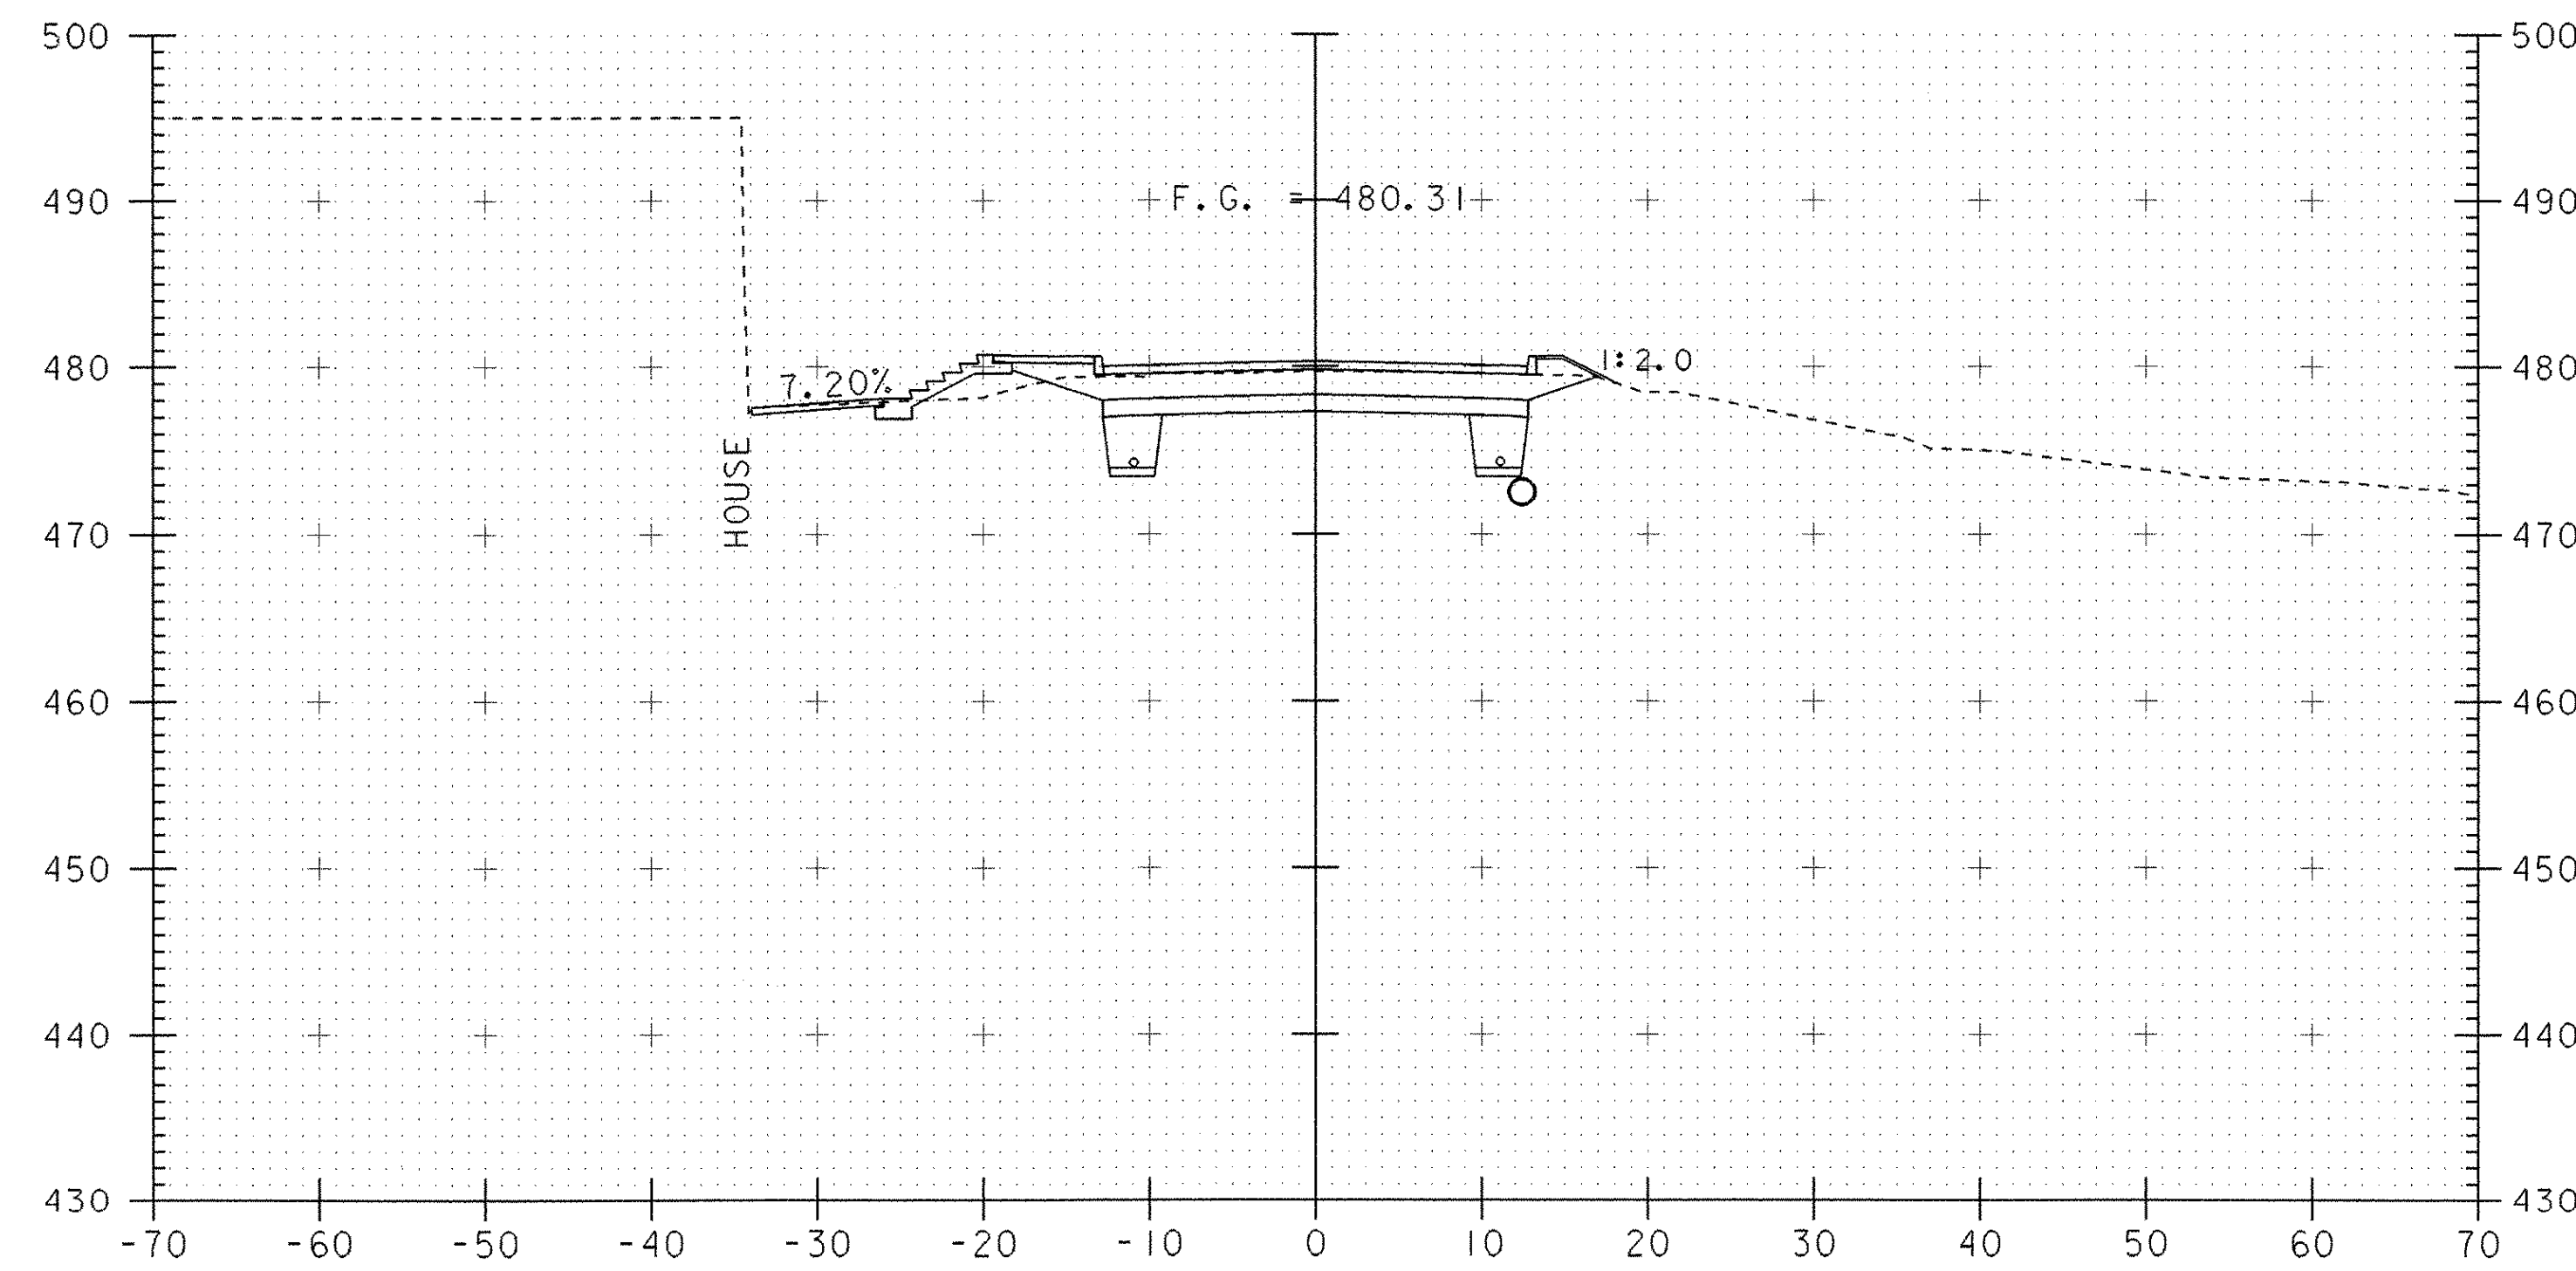

**103+45**

SCALE 1" = 10'-0"

PROJECT: ROYALTON	PROJECT NO.: BRZ 1444(22)
DESIGN FILE NAME: 89j099/structures/sj099mx.dgn	PLOT DATE: 25-SEP-2000
IPARM FILE NAME: sj099m05.i	
MAINLINE CROSS SECTIONS 103+25 TO 103+50	
SHEET: 99 OF 118	