



SKewed PIPE SECTION STA. 103+40 RT - 104+30 RT

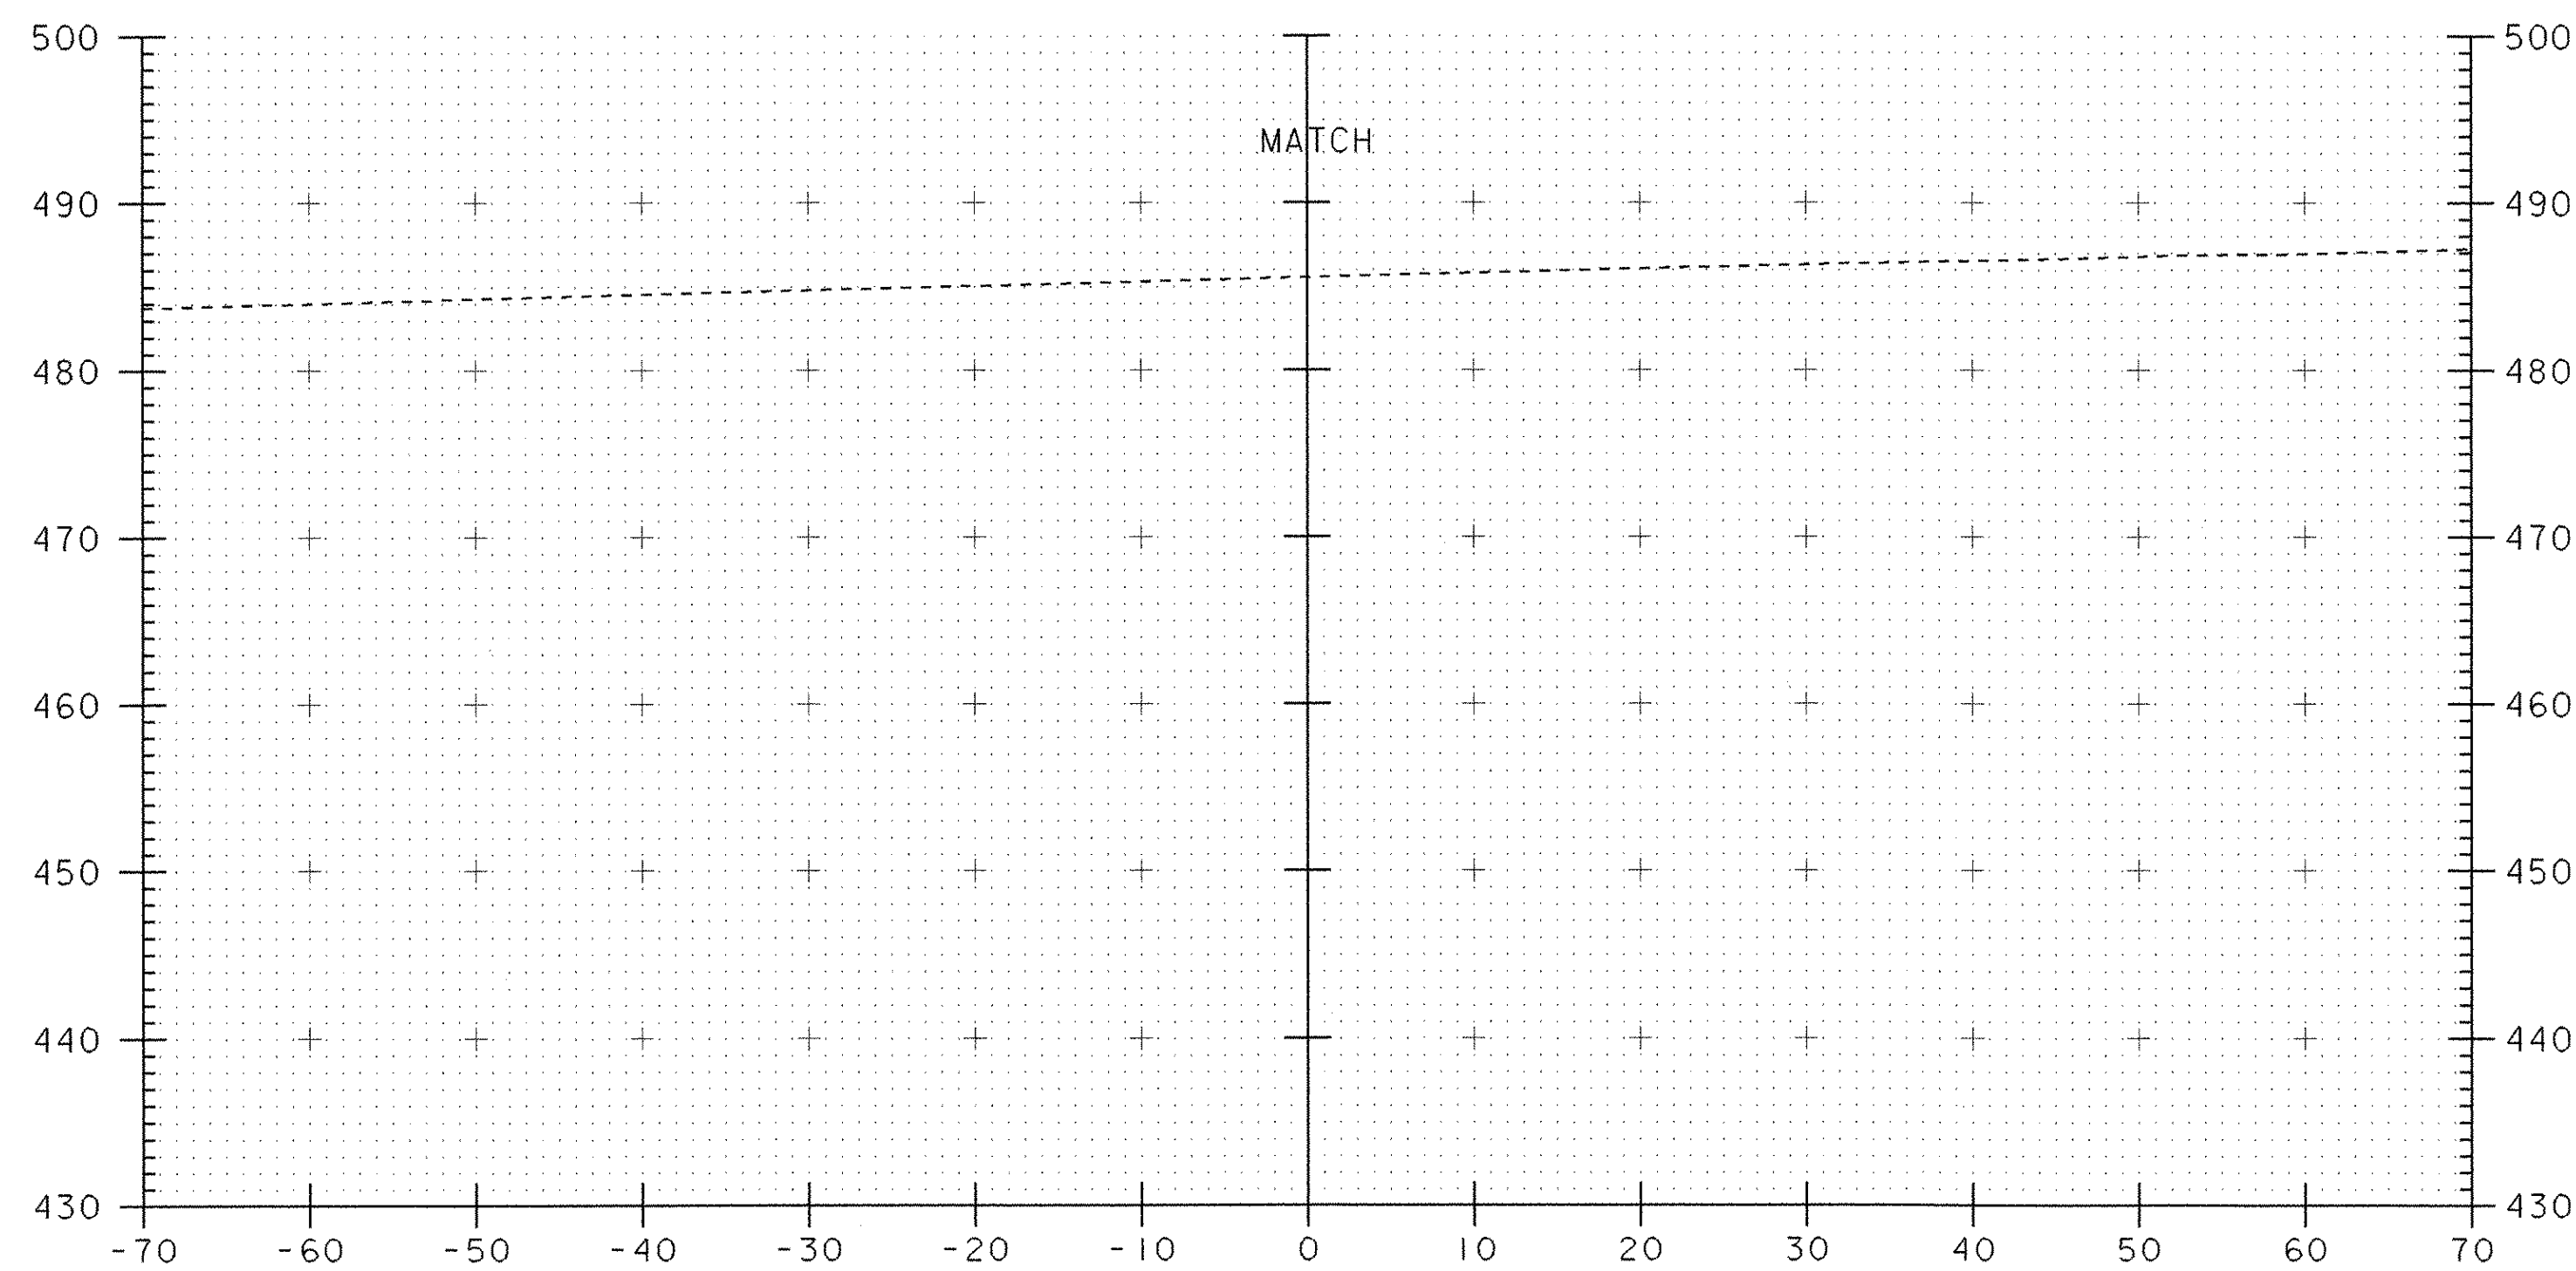


109+39

STATION 109+38.55
 END PROJECT
 BEGIN APPROACH

 STATION 109+25
 BEGIN COLD PLANING TO TRANSITION PAVEMENT

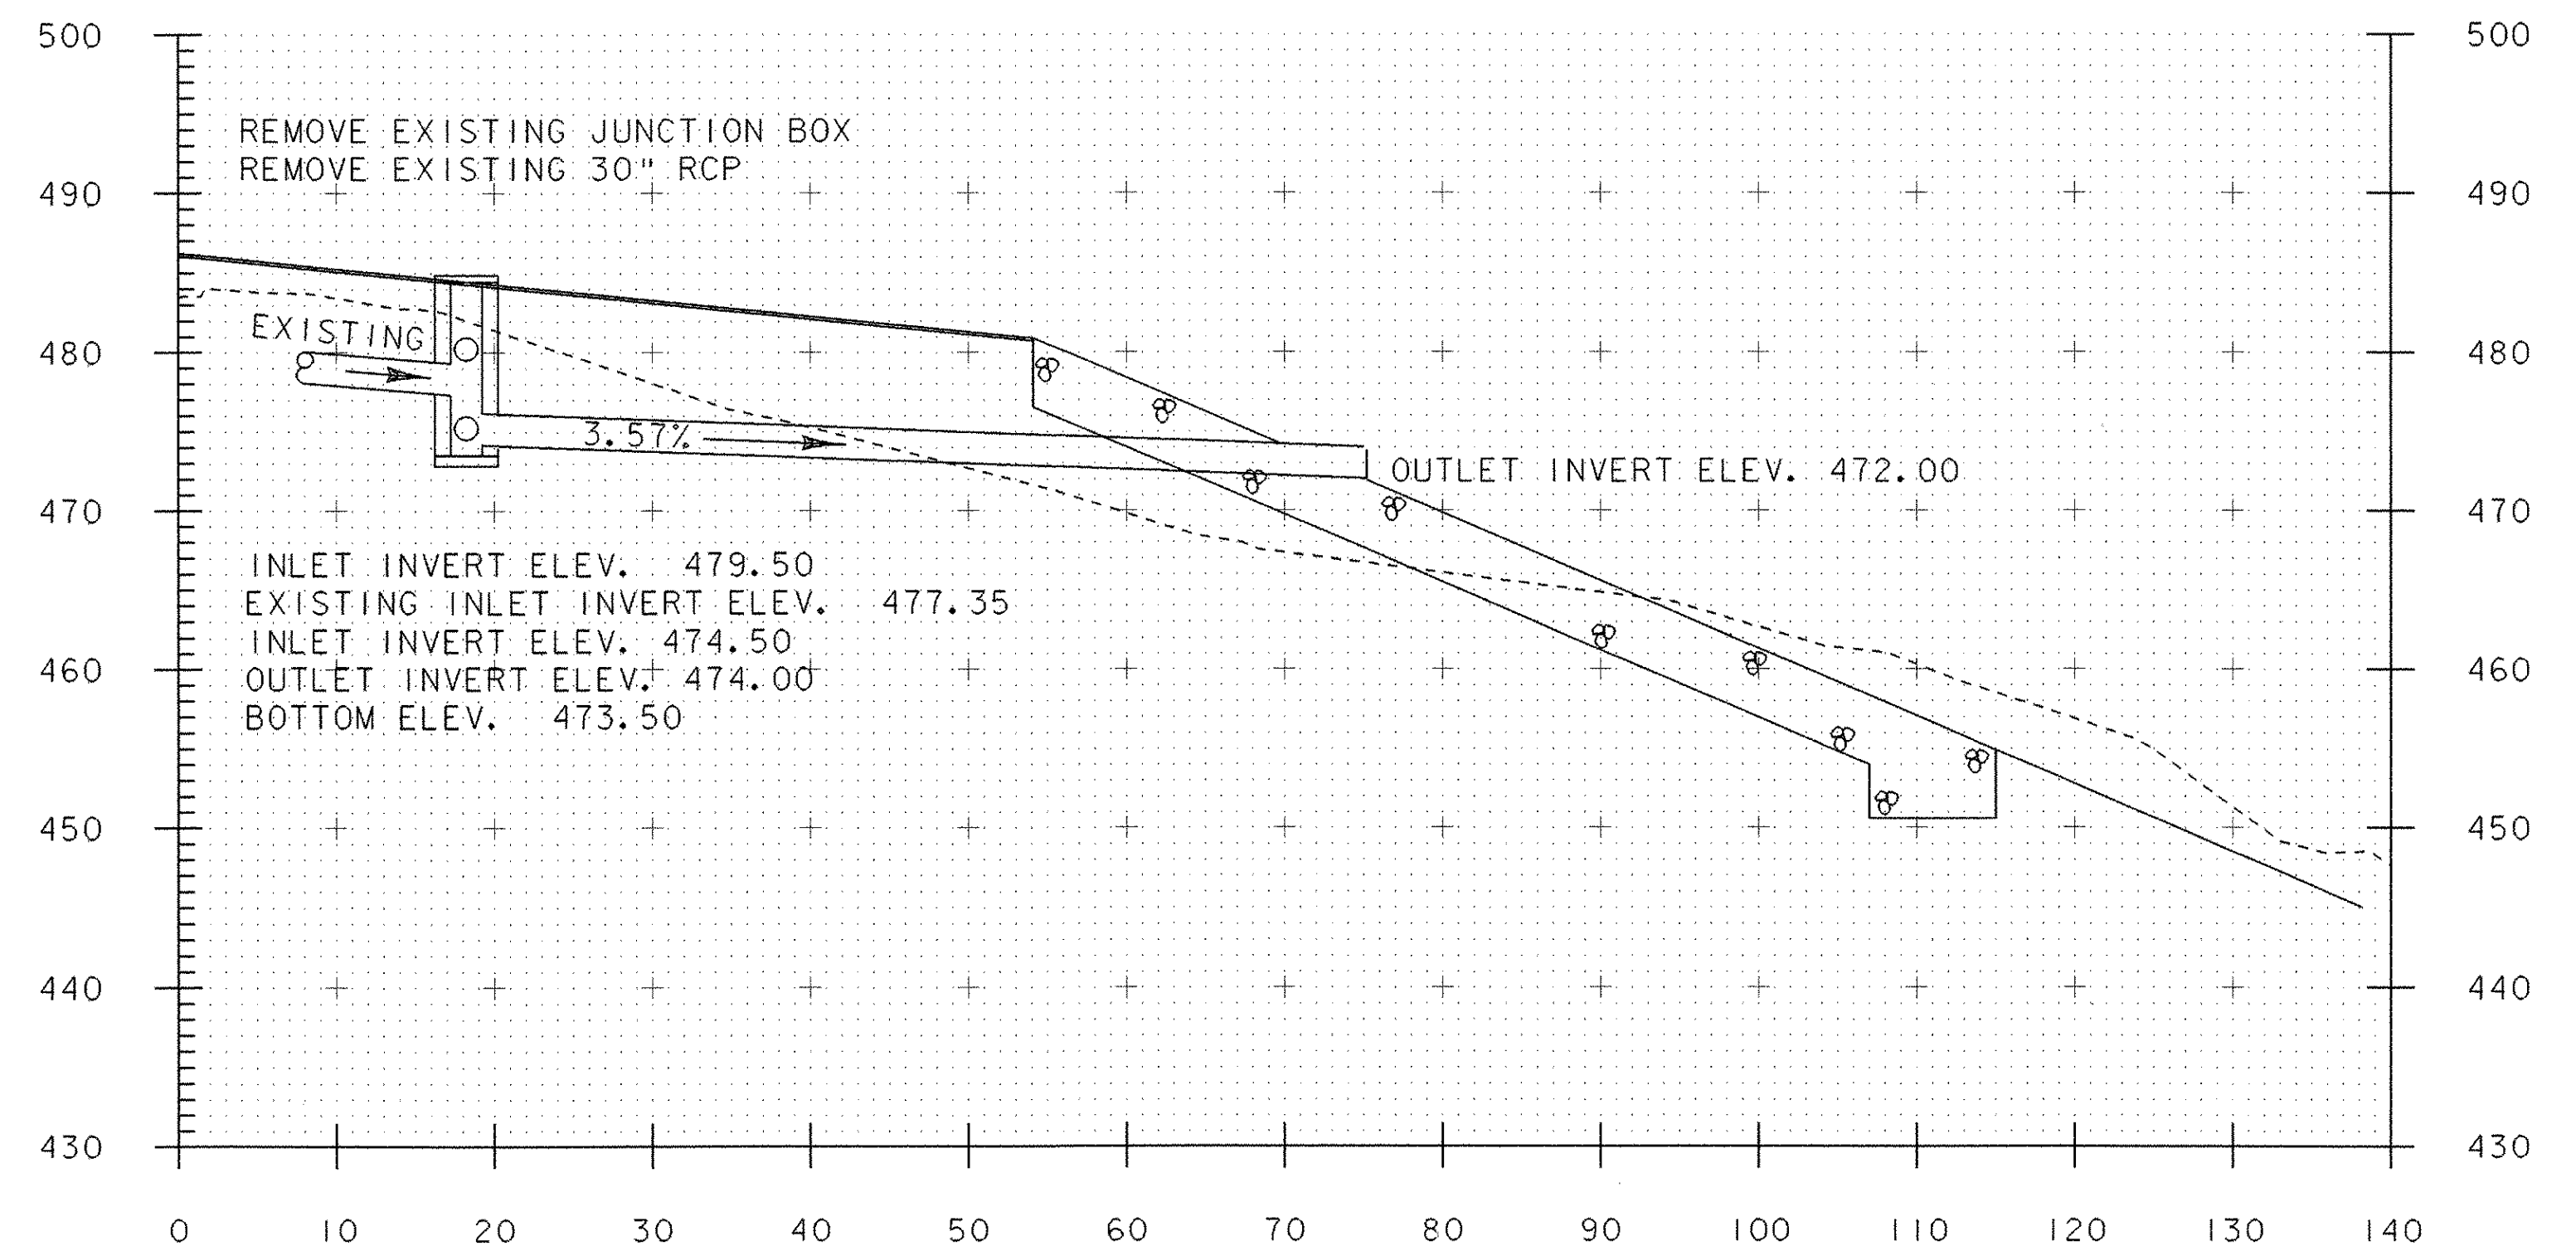

SKewed PIPE SECTION SIDELINE STA. 23+20 LT - 108+00 RT

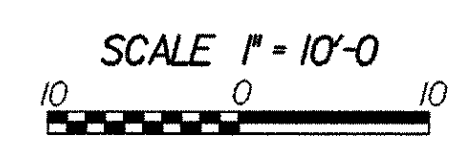

PROJECT: ROYALTON	PROJECT NO.: BRZ 1444(22)
DESIGN FILE NAME: 89j099/structures/sj099mix.dgn	PLOT DATE: 25-SEP-2000
IPARM FILE NAME: sj099m10.i	
MAINLINE CROSS SECTIONS 109+38.55 AND SKEWED SECTIONS	
SHEET: 104 OF 118	