



STA 22+50  
END APPROACH


22+50

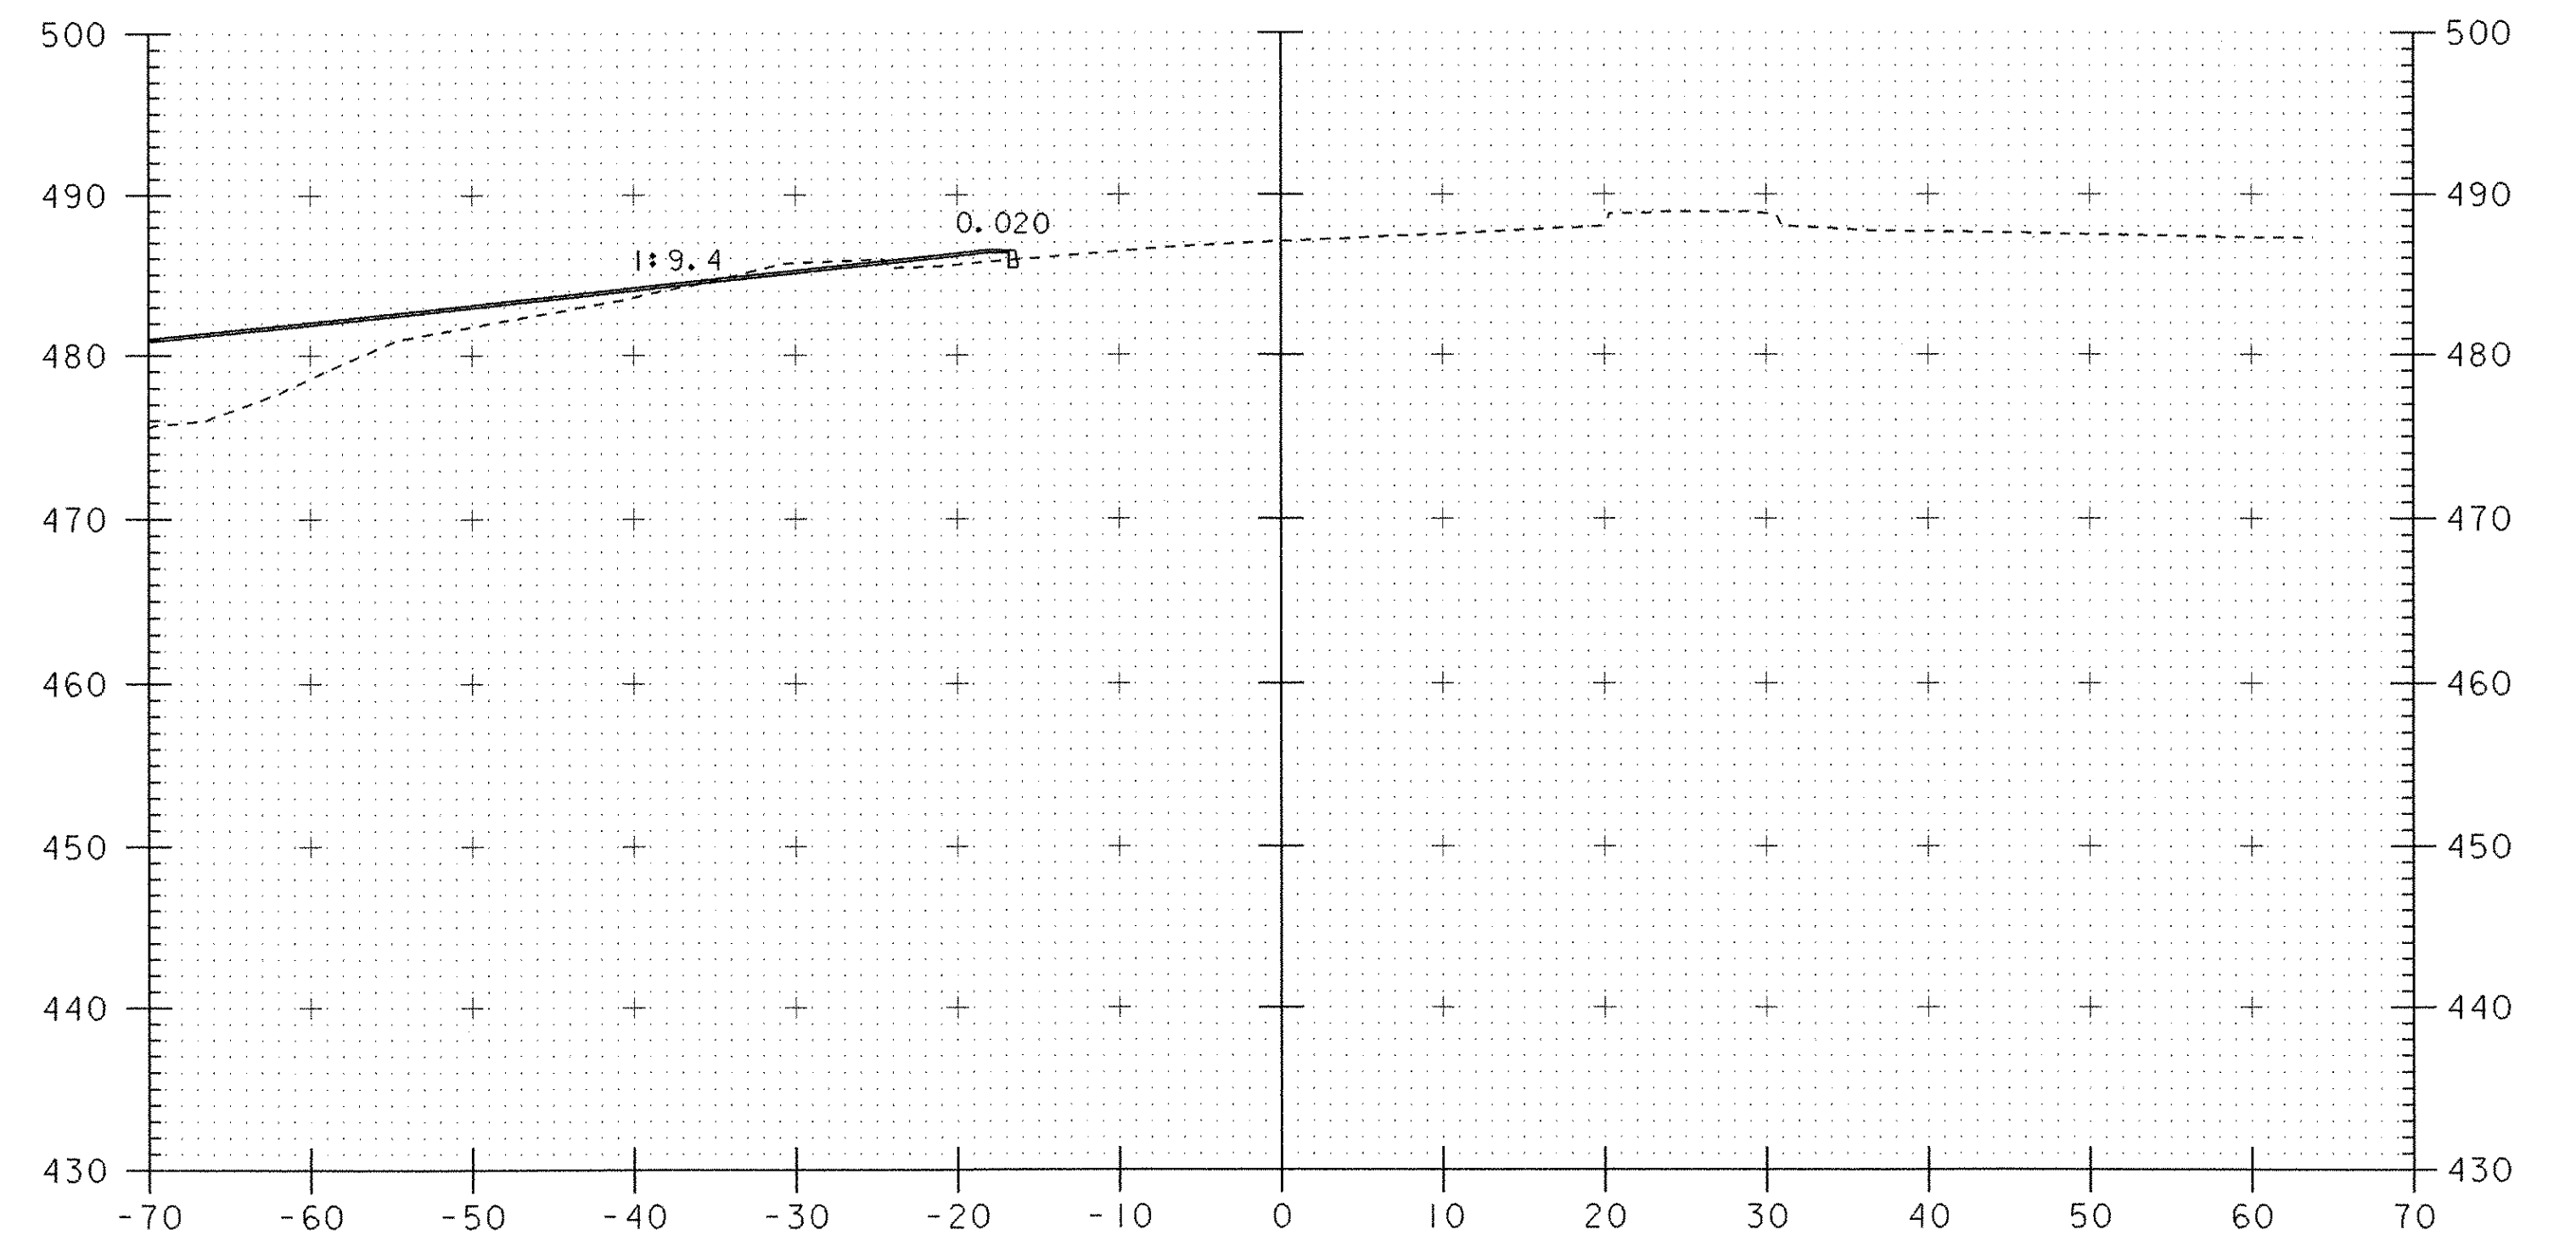

23+00

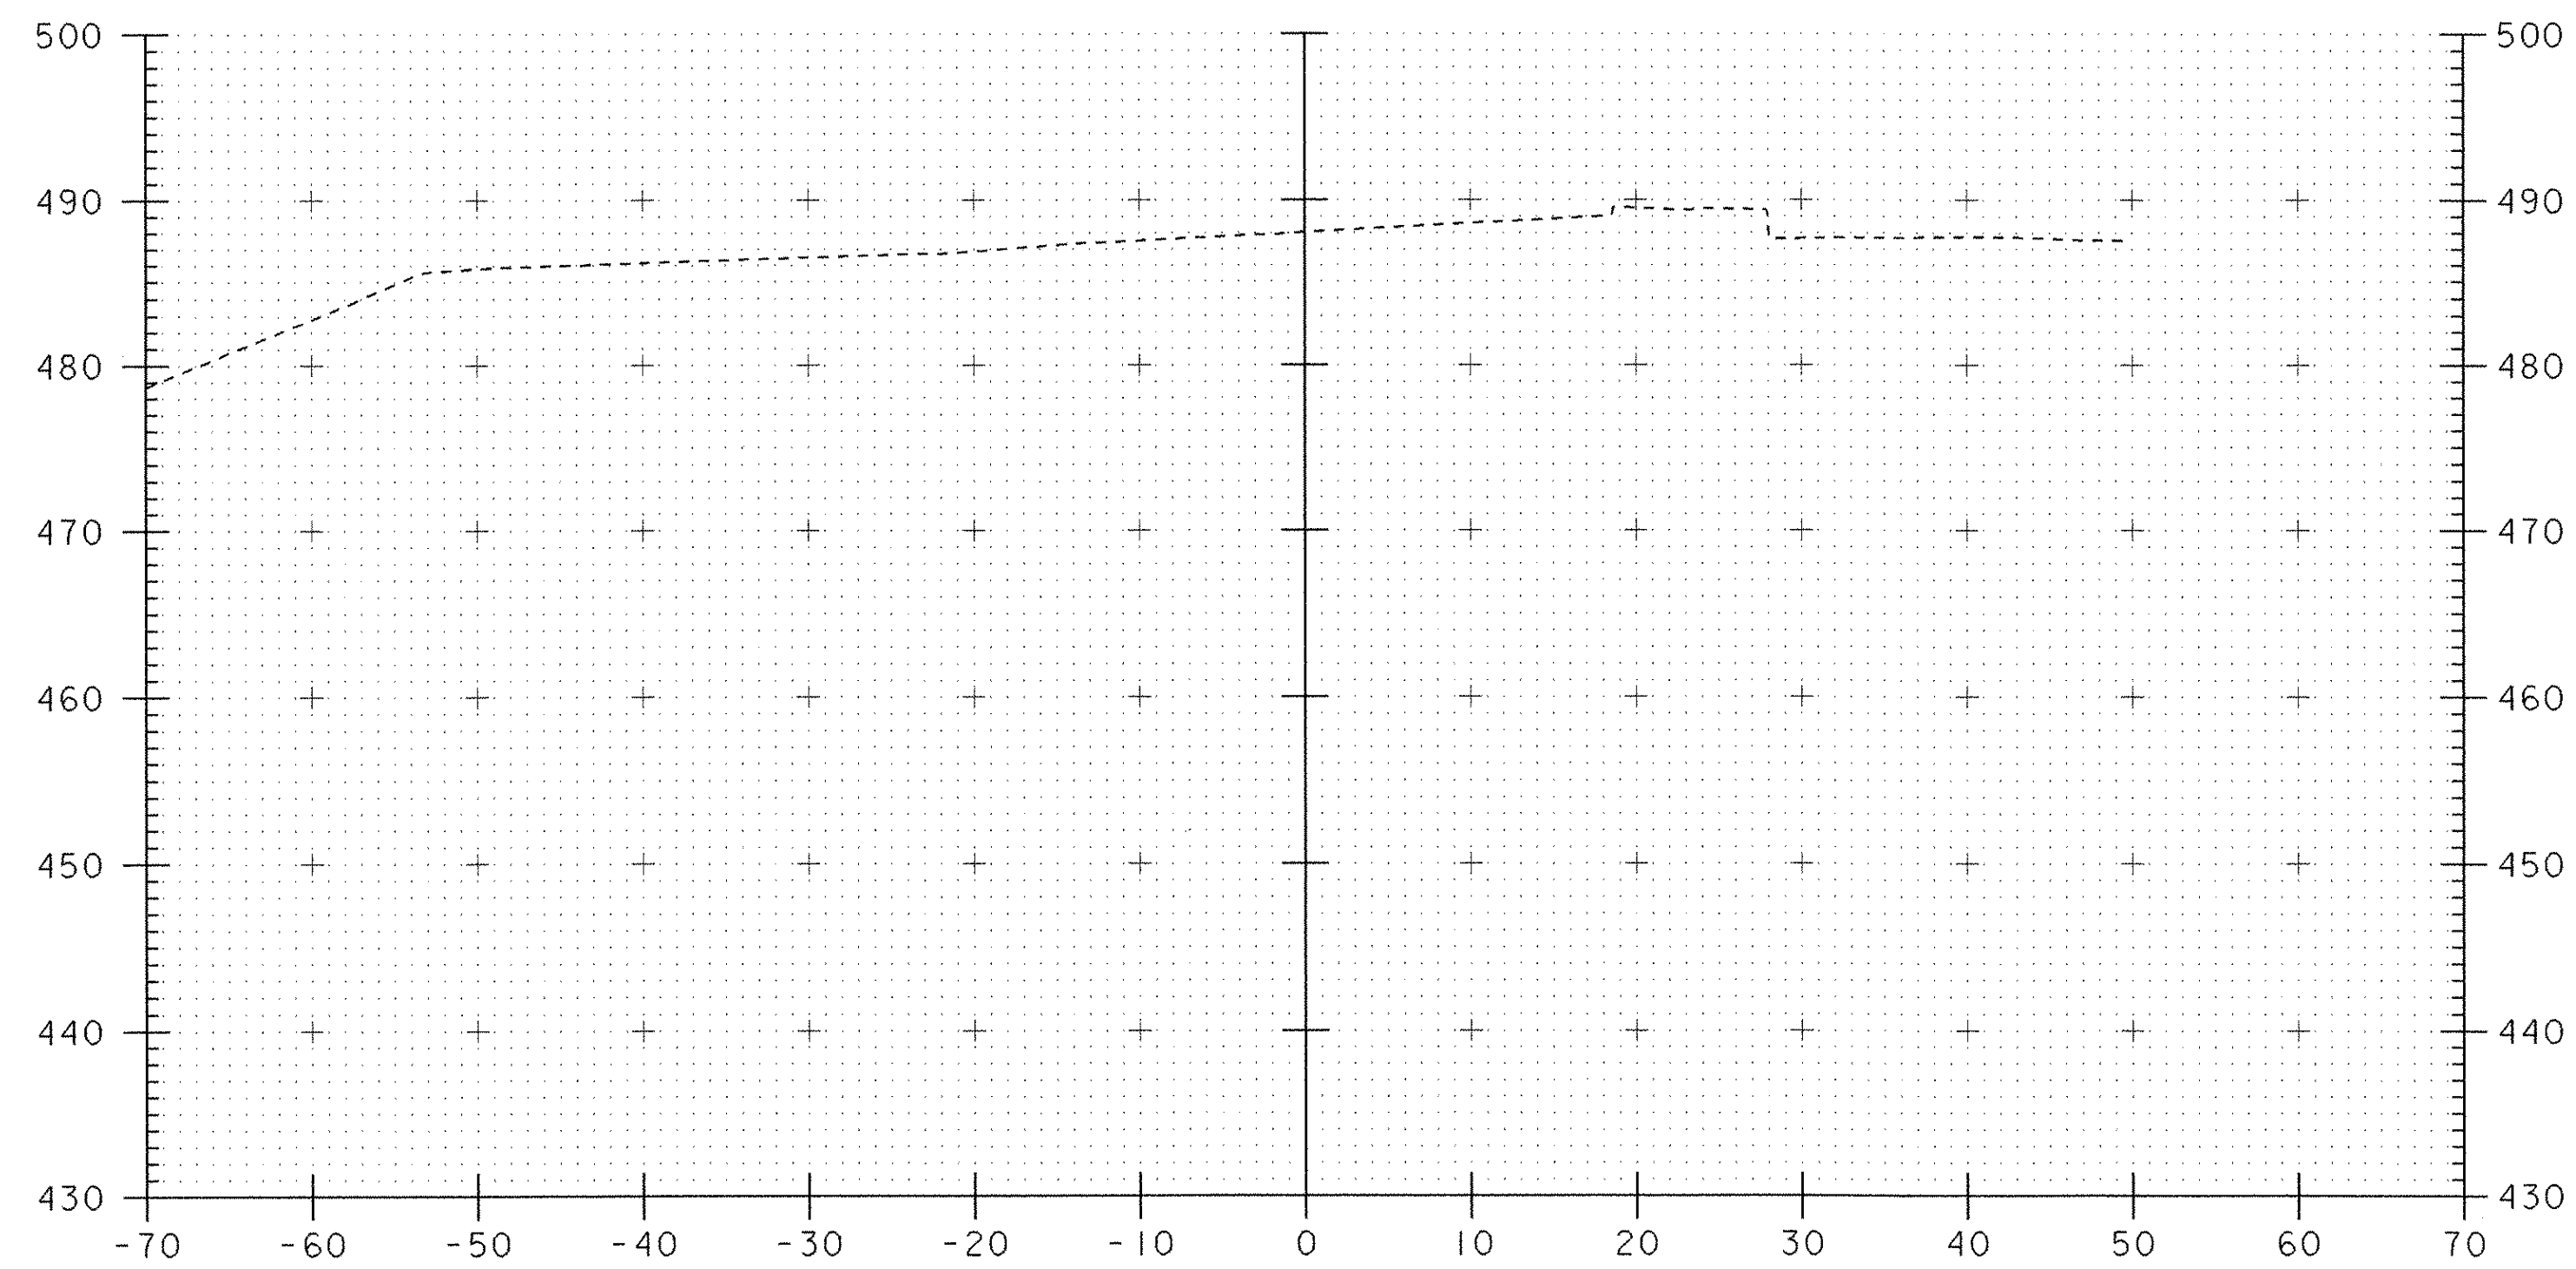

22+00

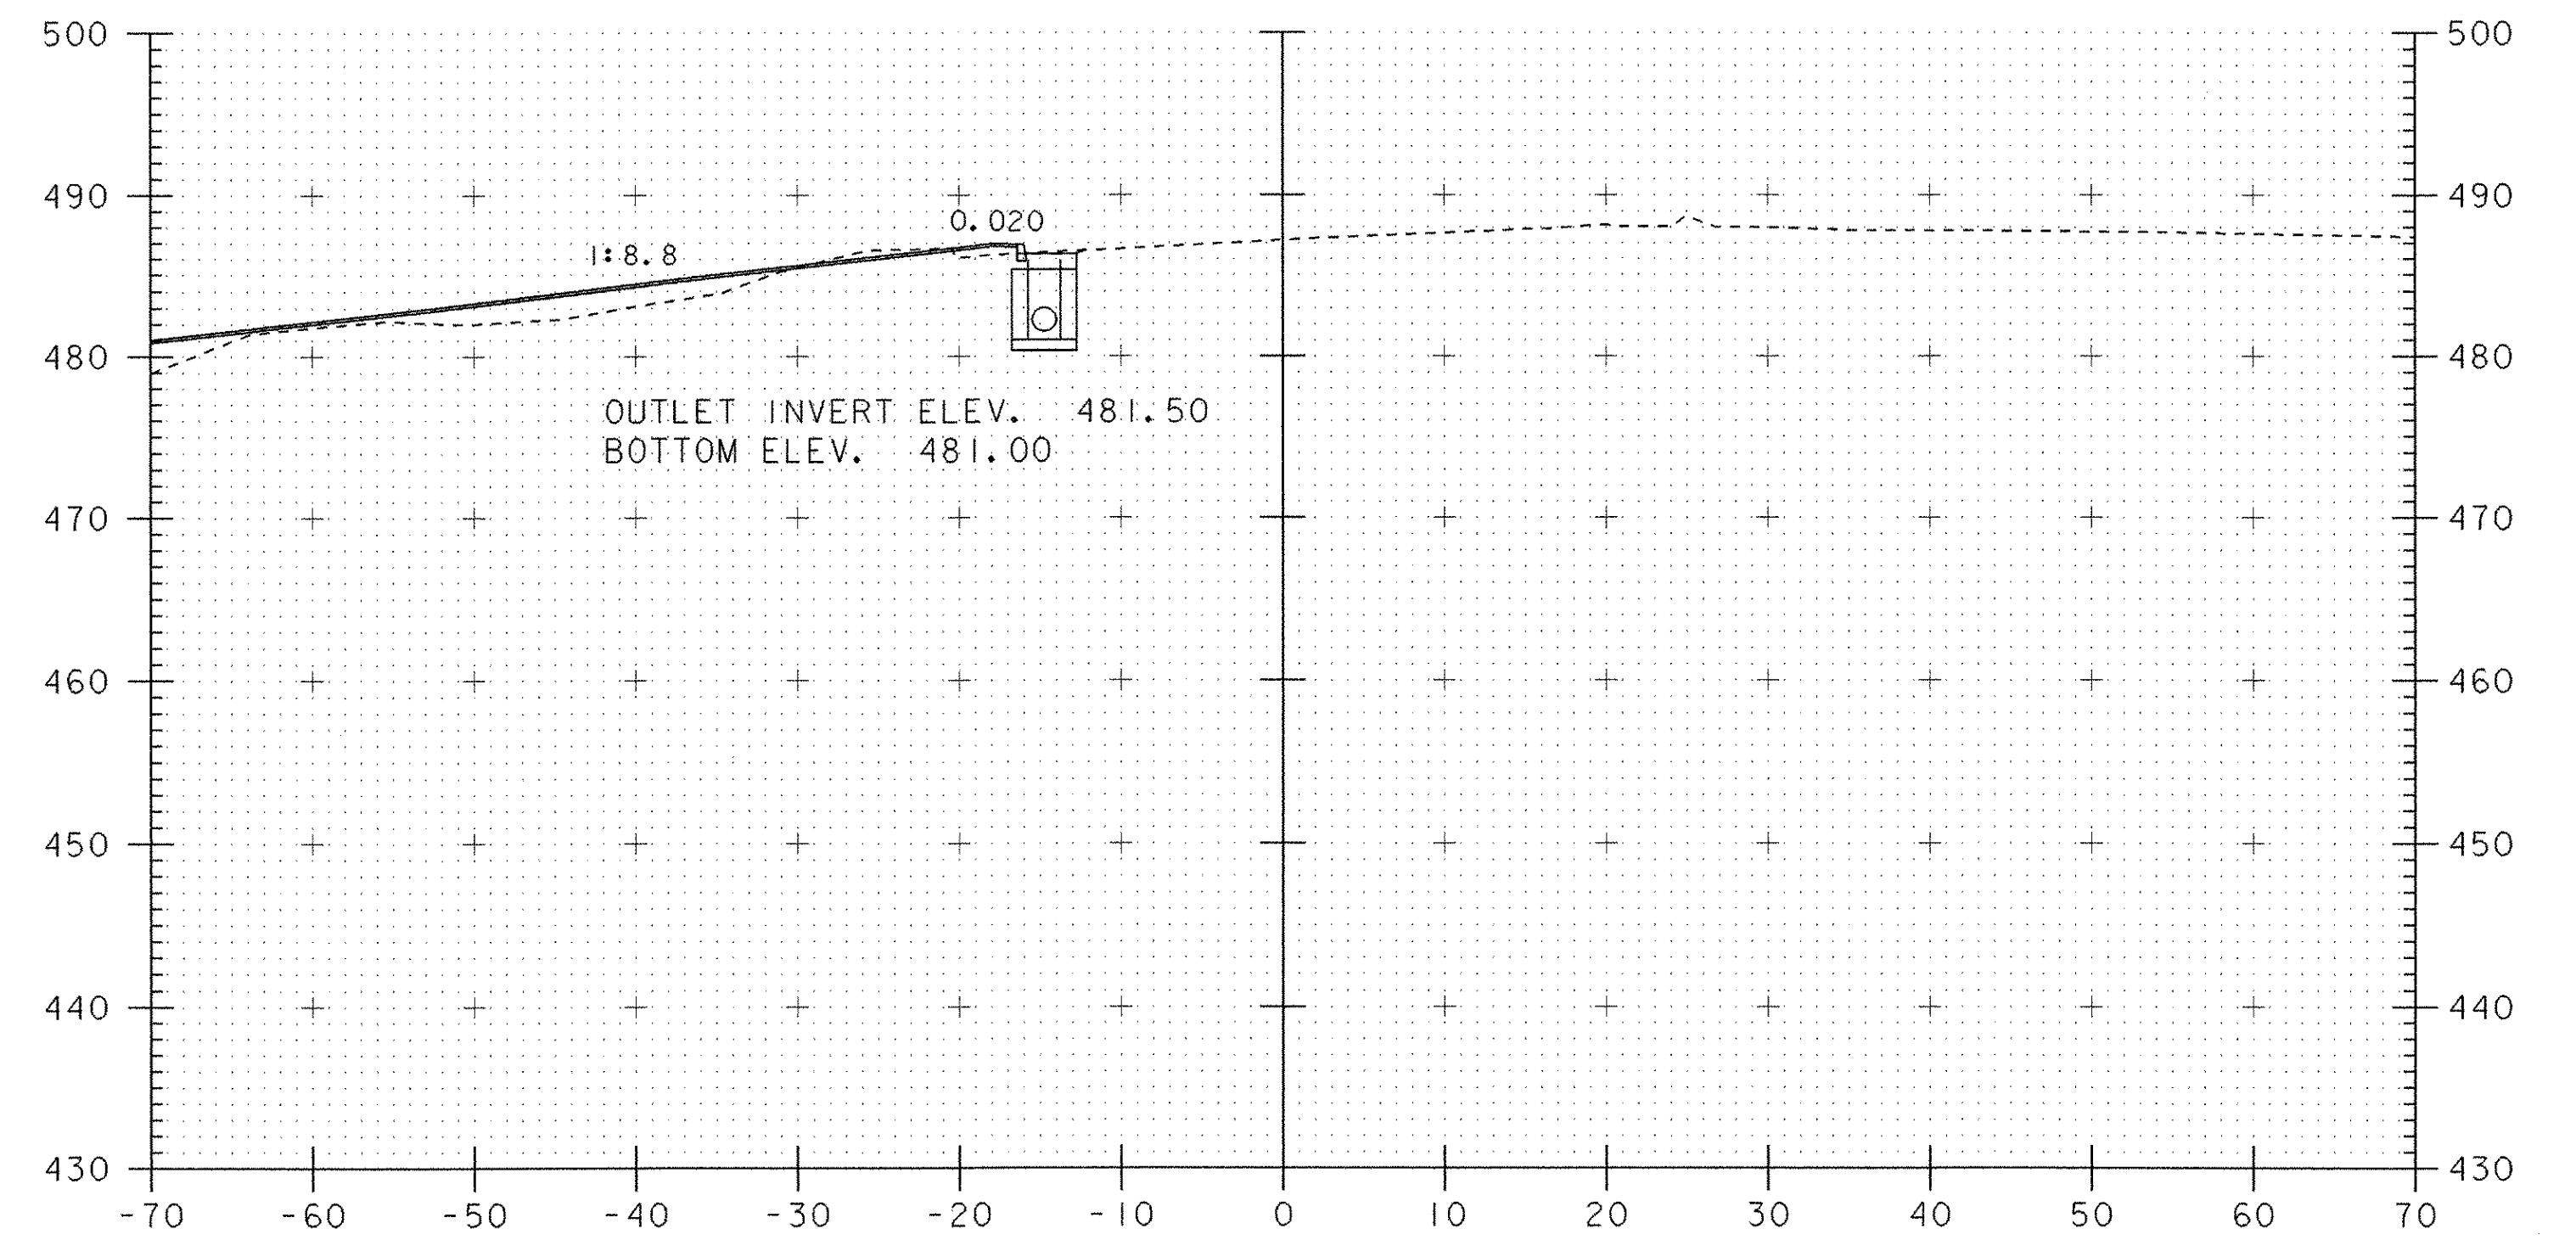

22+85

STATION 22+85 LT  
BEGIN NEW 18" OPTION PIPE  
CONSTRUCT NEW 4' X 4' CONC. DI



PROJECT: Royalton	PROJECT NO.: BRZ 1444(22)
DESIGN FILE NAME: 89j099/structures/sj099s16.dgn	PLOT DATE: 25-SEP-2000
IPARM FILE NAME: sj099s02.i	
VT.14 CROSS SECTIONS 22+00 TO 23+00	
SHEET: 106 OF 118	