


STATION 23+20 LT
END NEW 18" OPTION PIPE (2)
BEGIN NEW 24" OPTION PIPE
CONSTRUCT NEW 4' X 4' RCDI W/ PRECAST COVER

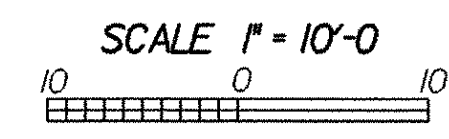

PROJECT: Royalton	PROJECT NO.: BRZ 1444(22)
DESIGN FILE NAME: 89j099/structures/sj099six.dgn	PLOT DATE: 25-SEP-2000
IPARM FILE NAME: sj099s03.i	
VT. 14 CROSS SECTIONS 23+50 TO 25+00	
SHEET: 107 OF 118	