




56+00

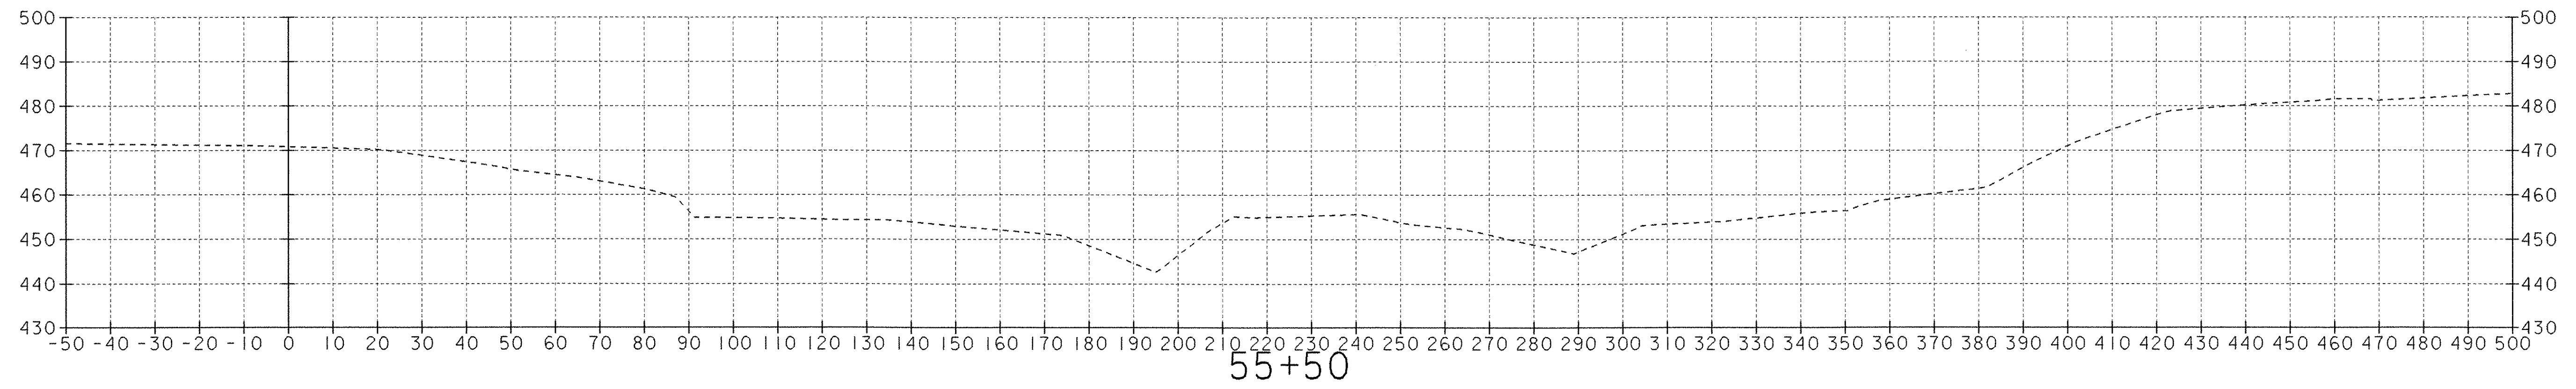

55+50

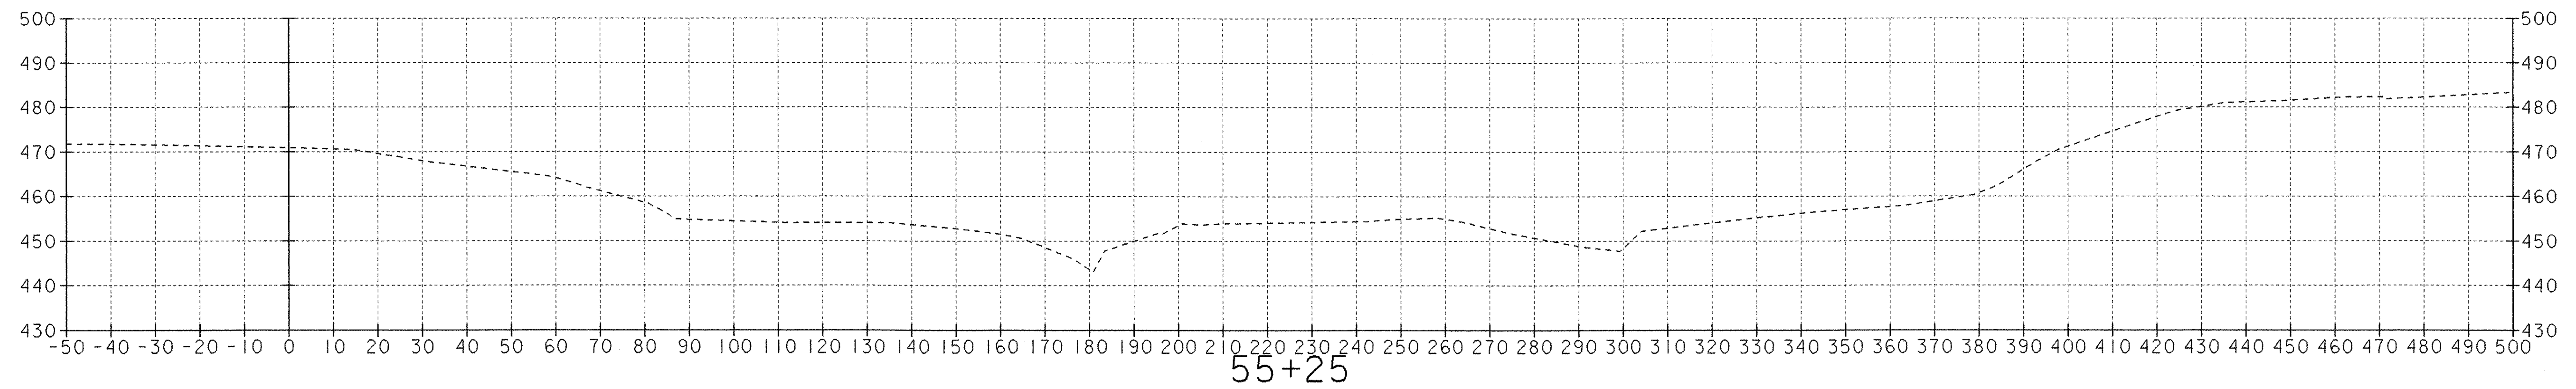

55+25

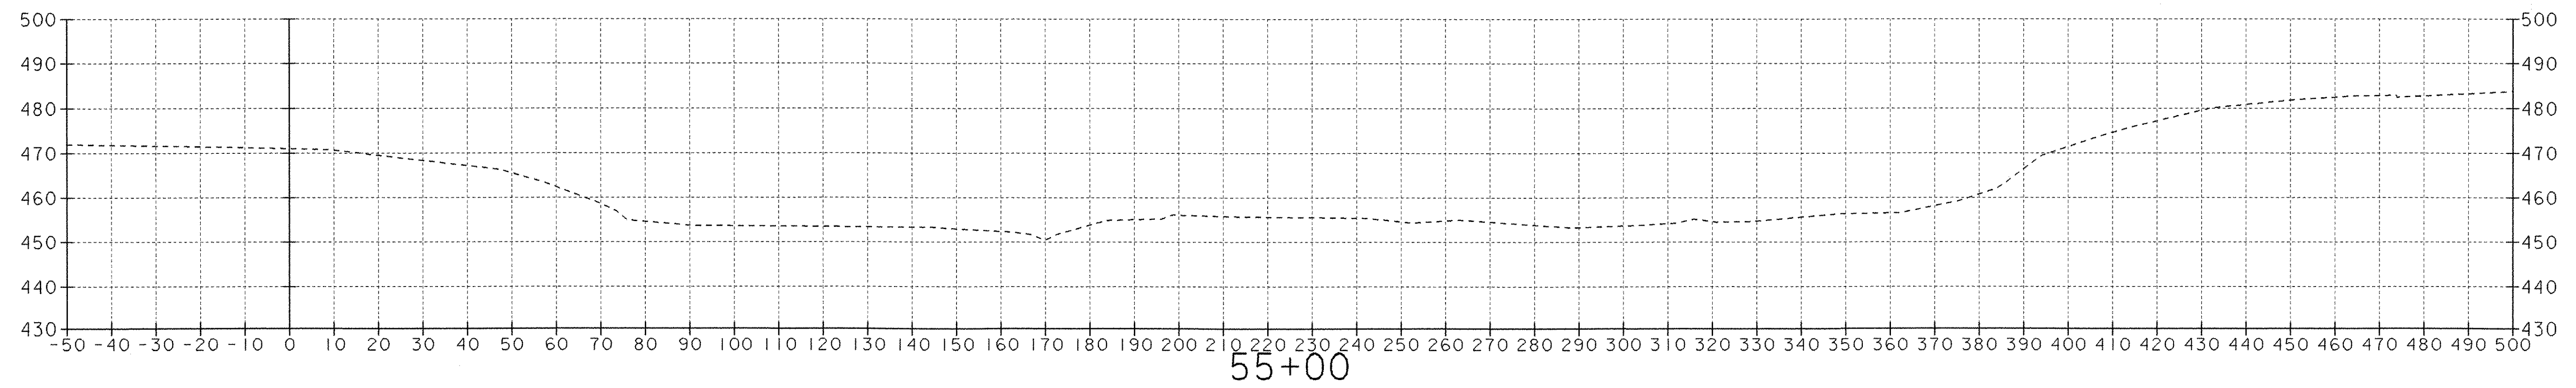

55+00

SCALE 1" = 20'-0"

PROJECT: ROYALTON	PROJECT NO.: BRZ 1444(22)
DESIGN FILE NAME: 89j099/structures/sj099chx.dgn	PLOT DATE: 25-SEP-2000
IPARM FILE NAME: sj099c09.i	
CHANNEL CROSS SECTIONS 55+00 - 56+00	
SHEET: 118 OF 118	