


RECEIVED  
CND BY: [Signature]  
APR 23 2002

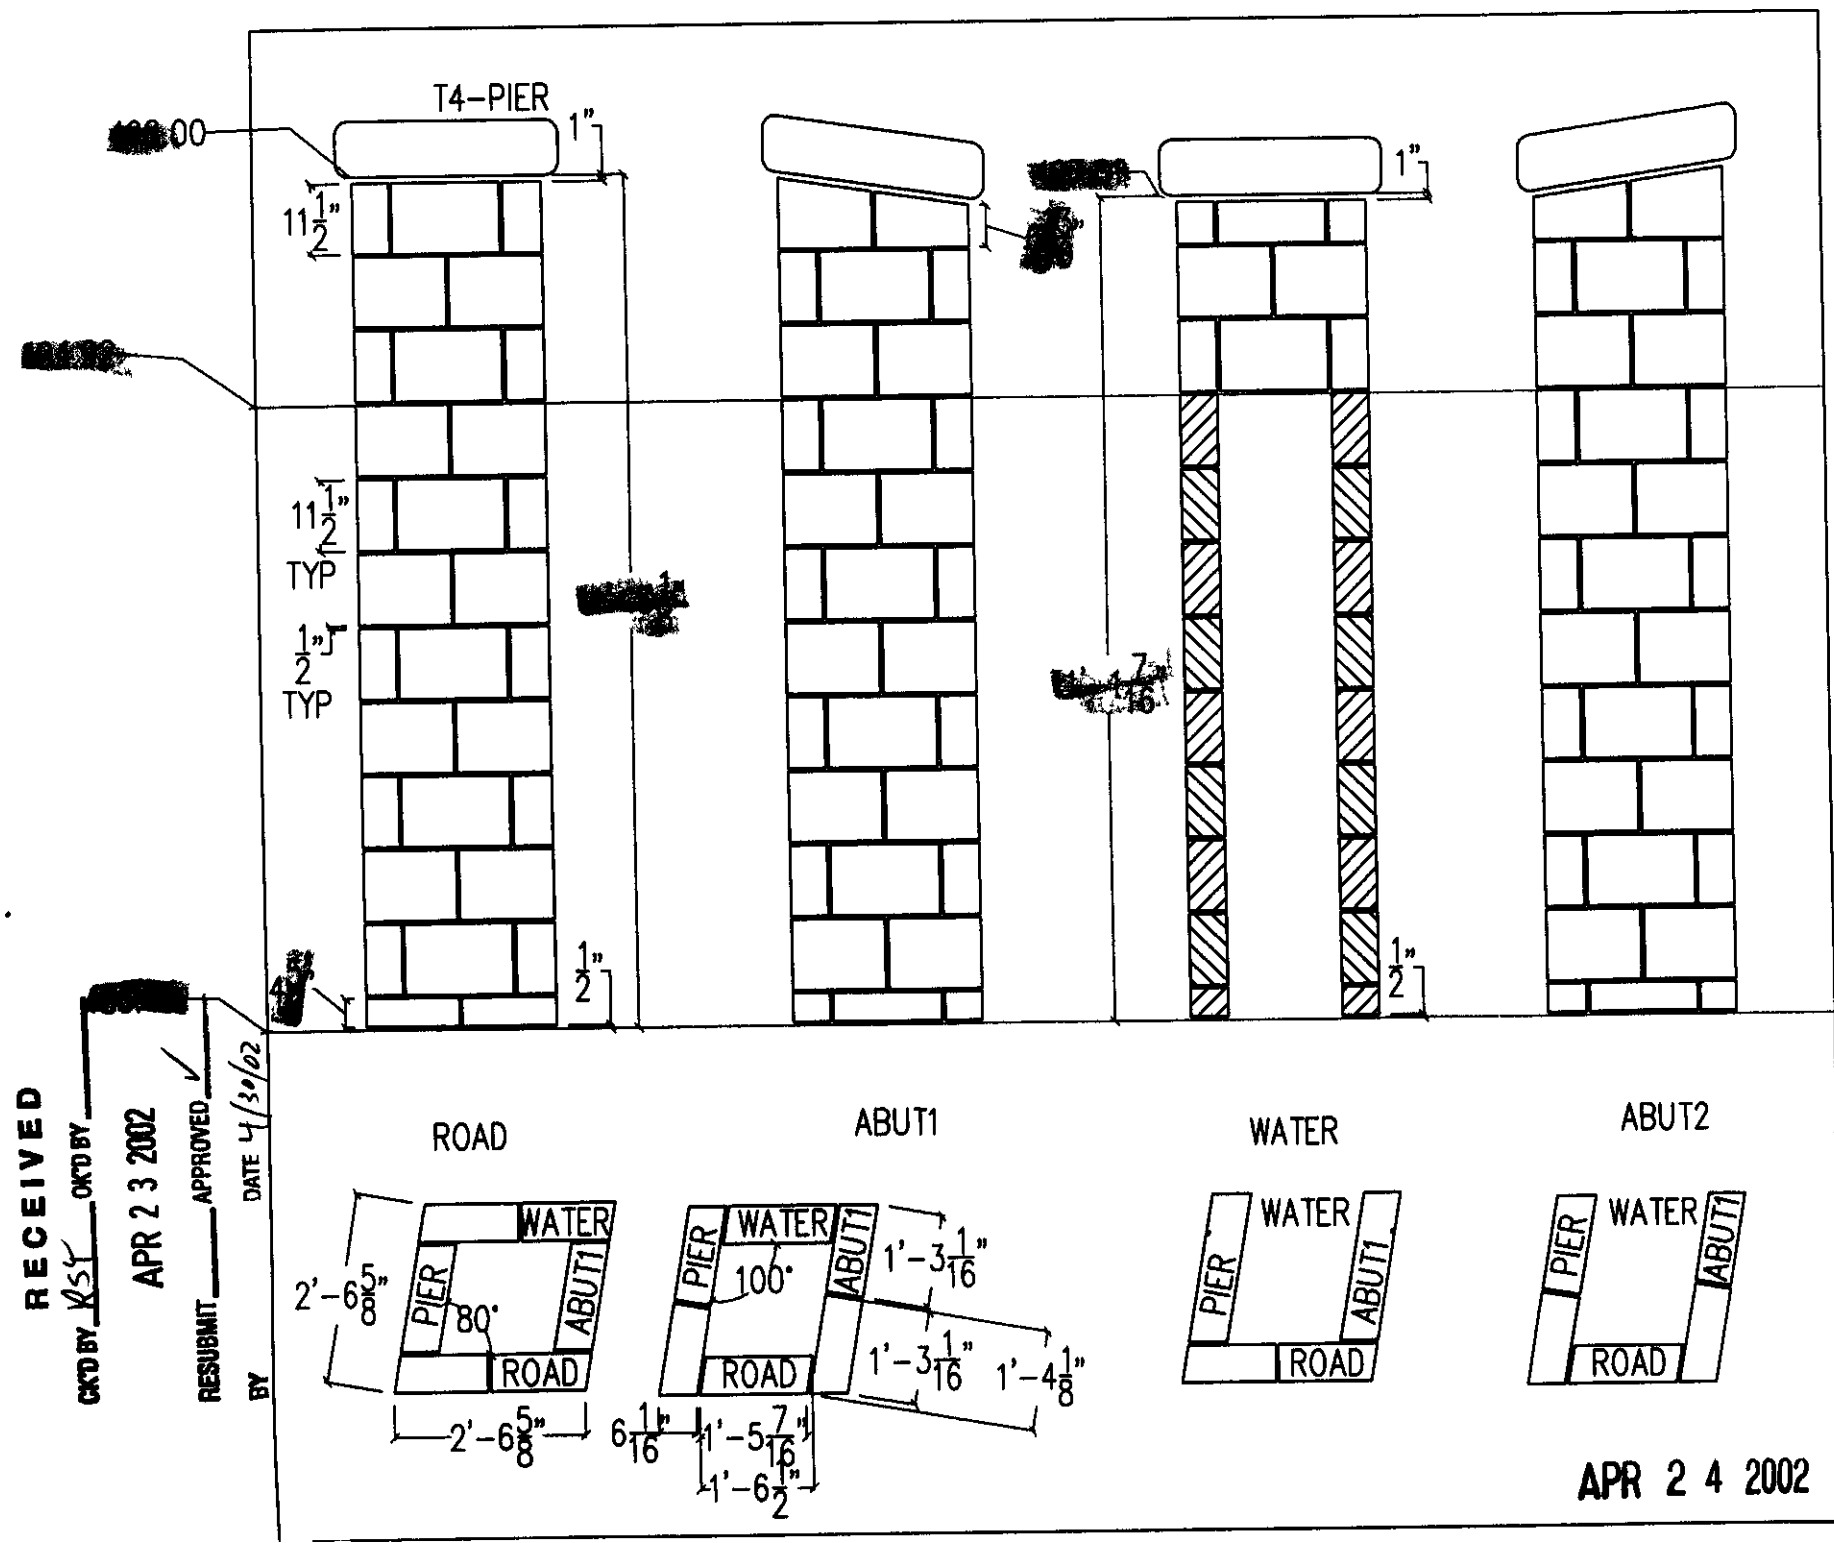

APR 24 2002