



NOTE:
FIELD CUT ALL SPLAY EDGES AROUND CAP TYPICAL AT ALL TOWERS AT PIER AND ABUTMENTS.

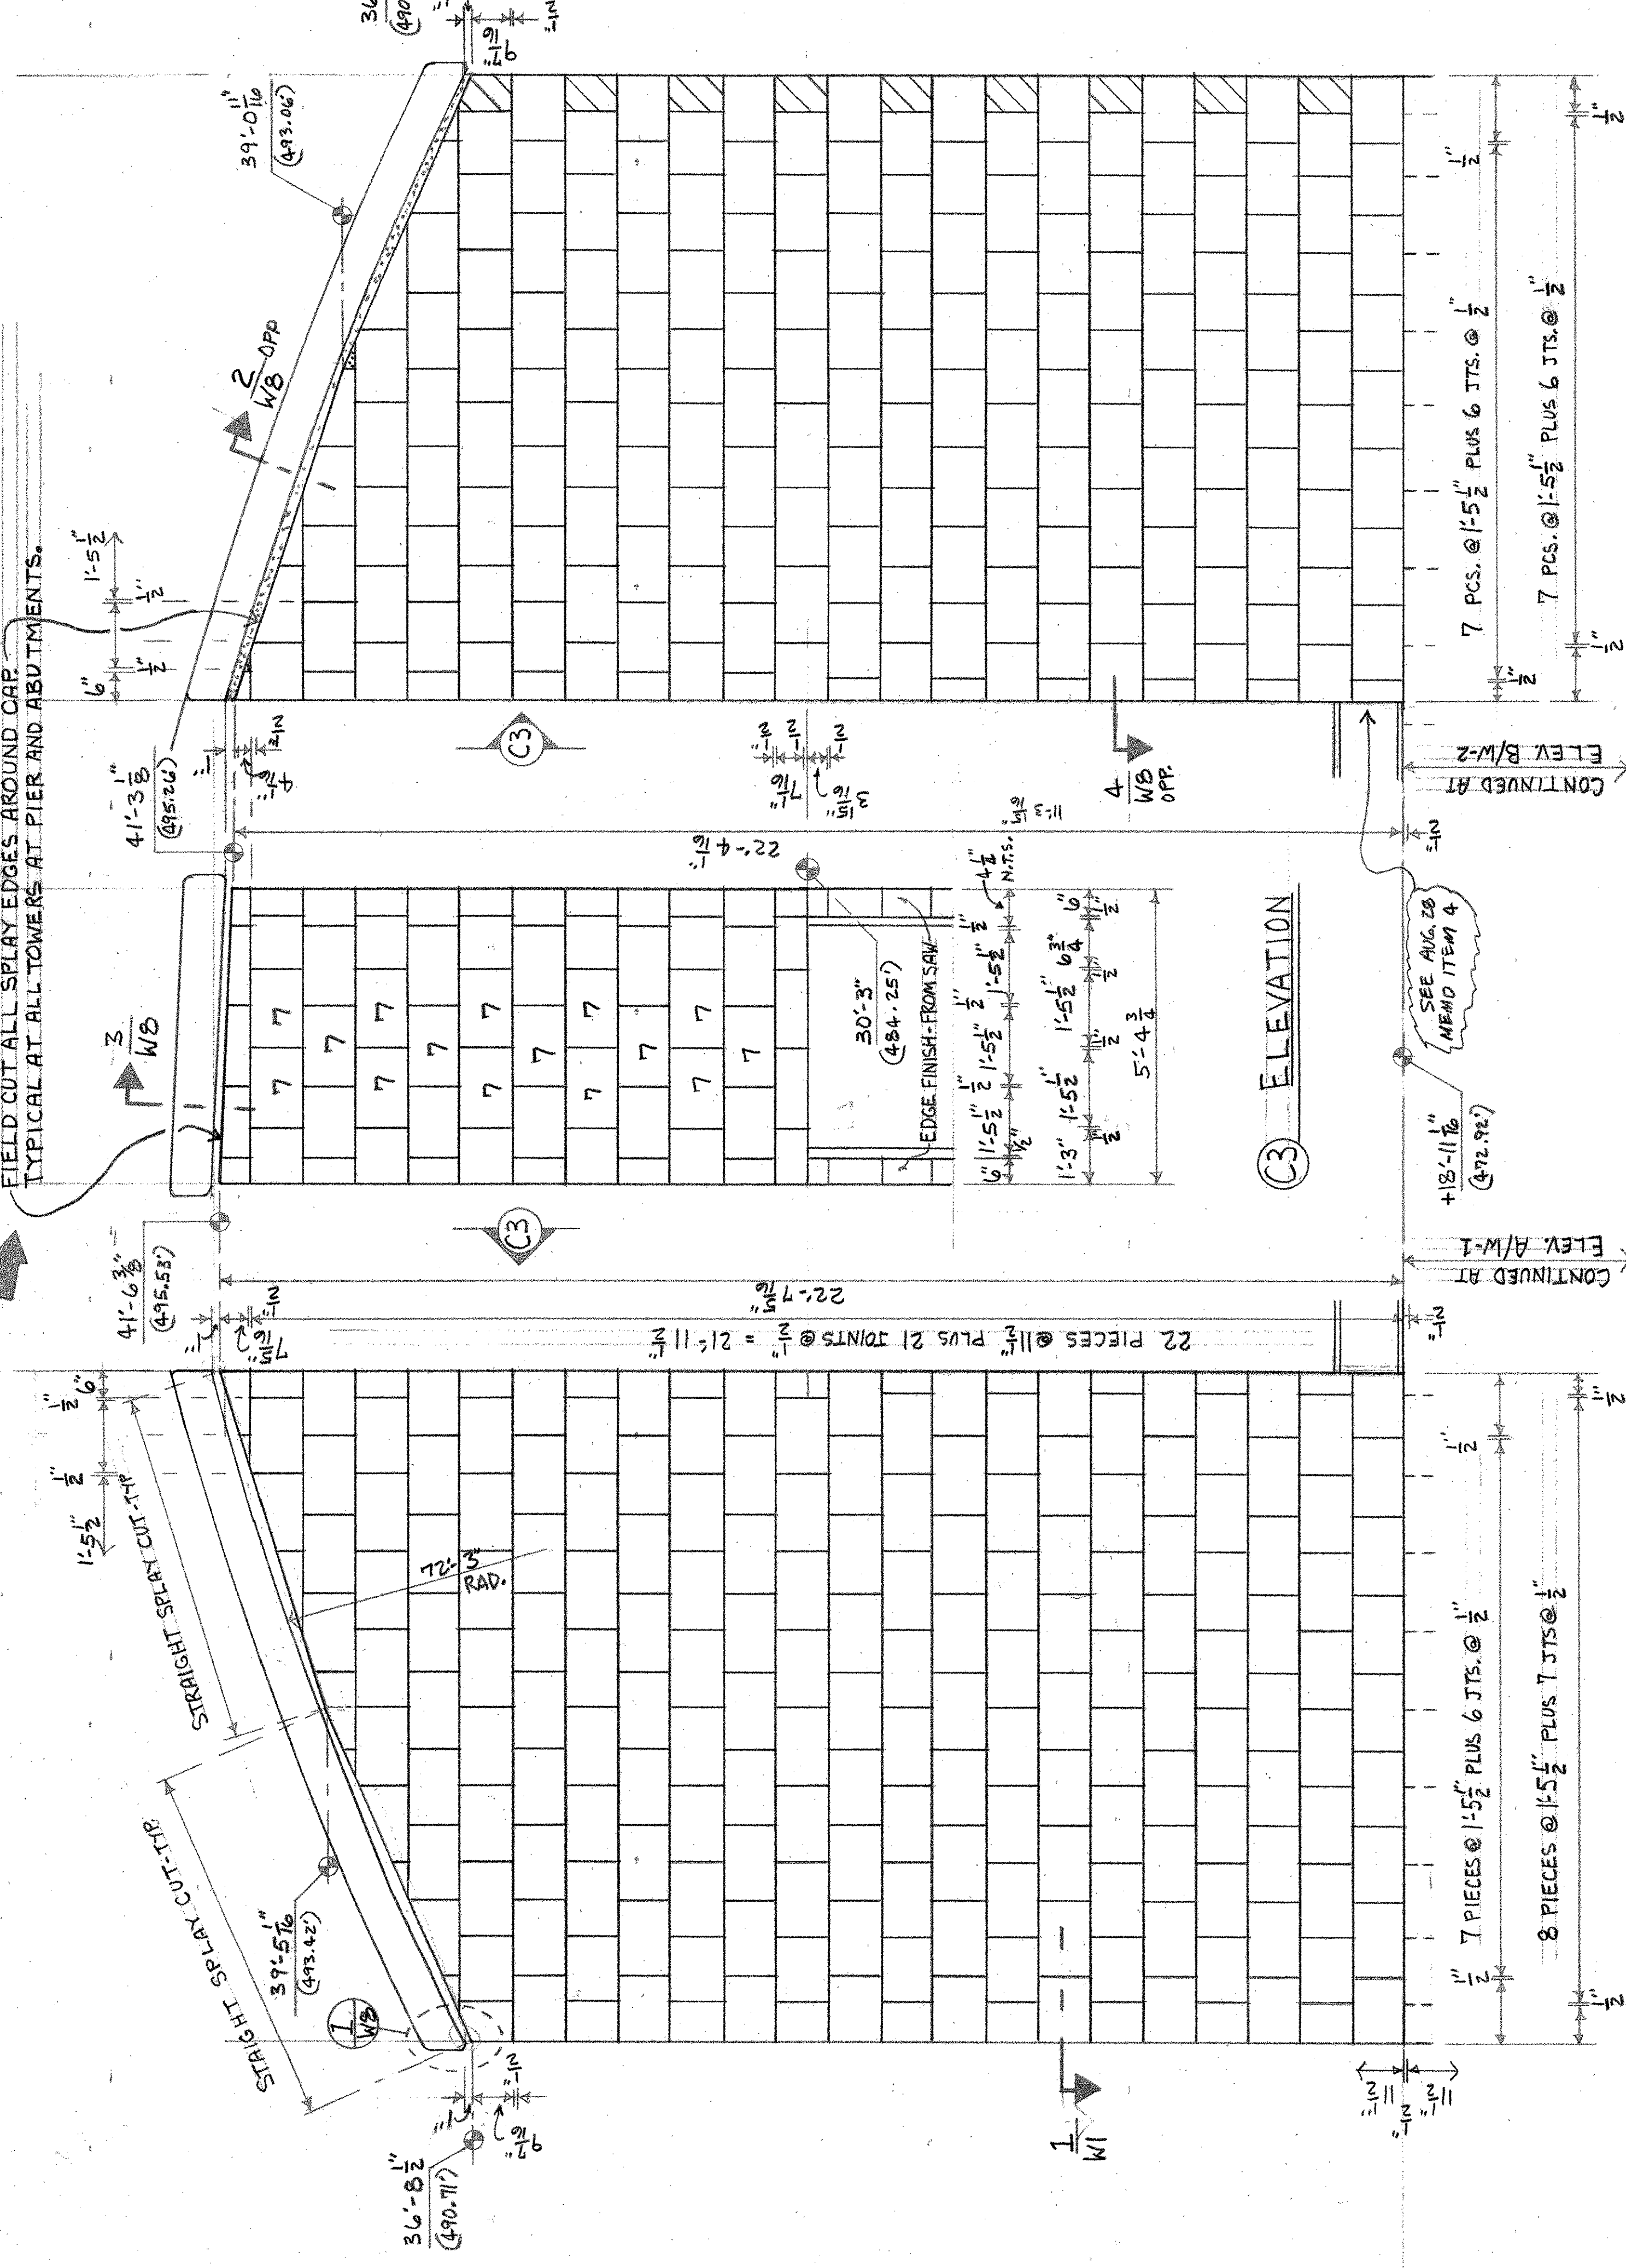


C2 ELEVATION

C4 ELEVATION

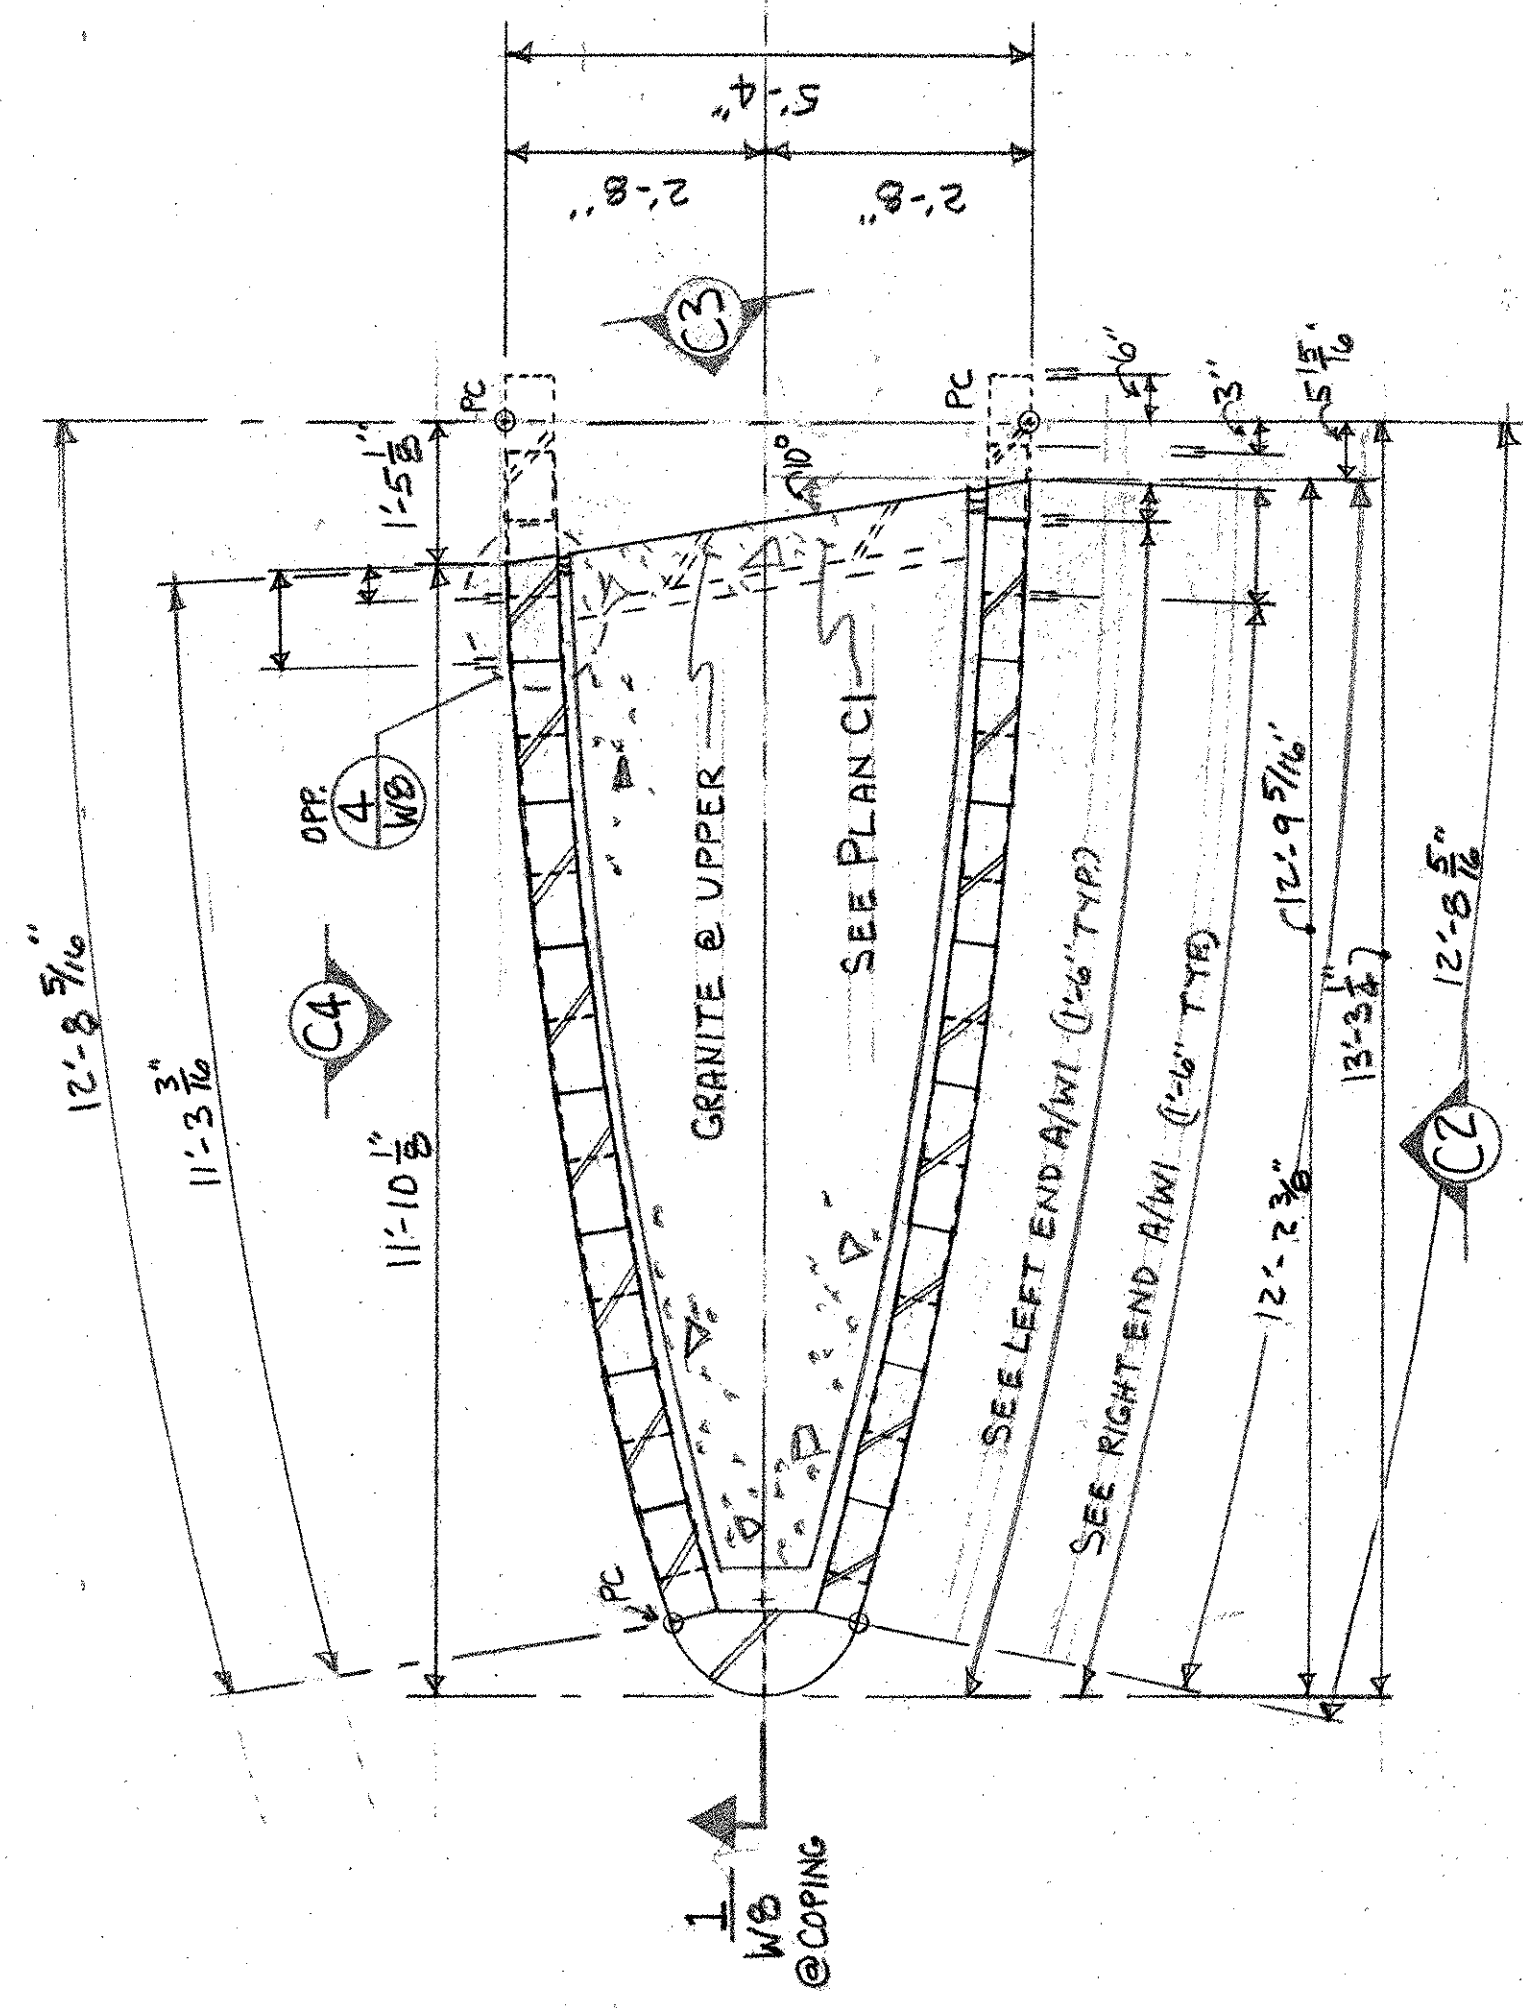

C PLAN

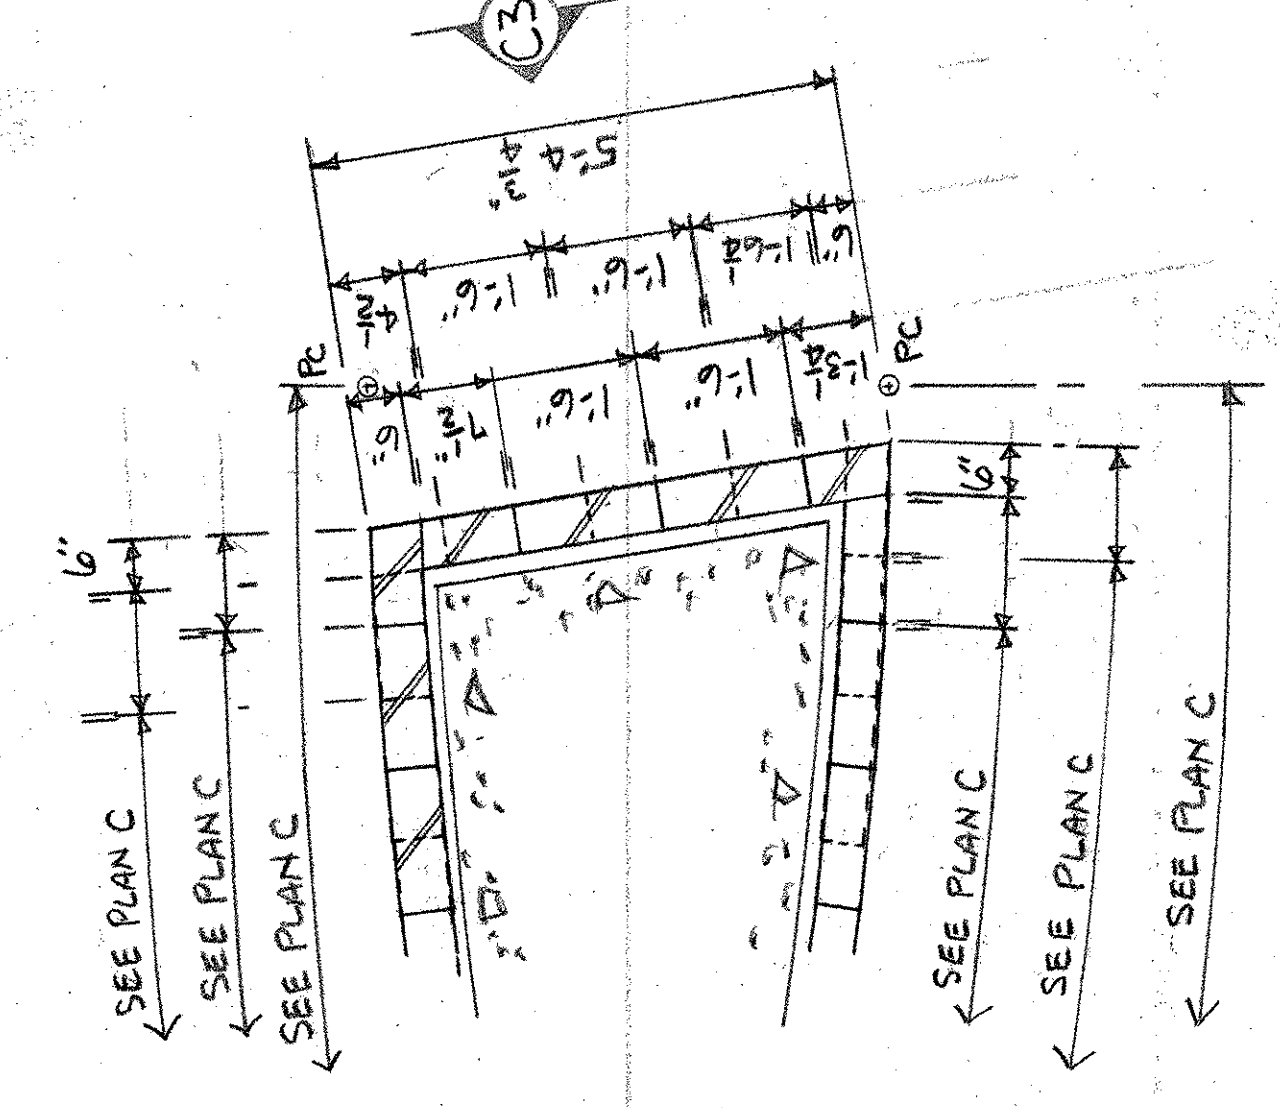

C1 PLAN

KEY PLAN
SEE W-1 & W-2

NOTE: This shop drawing represents specifications and our construction, and existing conditions. It is not to be used for construction without the approval of our customer. Approval delay results in the customer's responsibility. We are not liable for conditions not shown on this drawing. Trade names address information is provided for reference only. We assume no responsibility for the use of this drawing by other parties.

CKD BY: _____
RESUBMIT BY: _____