



21'-6 13/16"
 13 PIECES @ 1'-5 1/2" PLUS 12 JTS. @ 1/2" = 19'-5 1/2"
 13 PCS. @ 1'-5 1/2" PLUS 12 JTS. @ 1/2" = 19'-5 1/2"

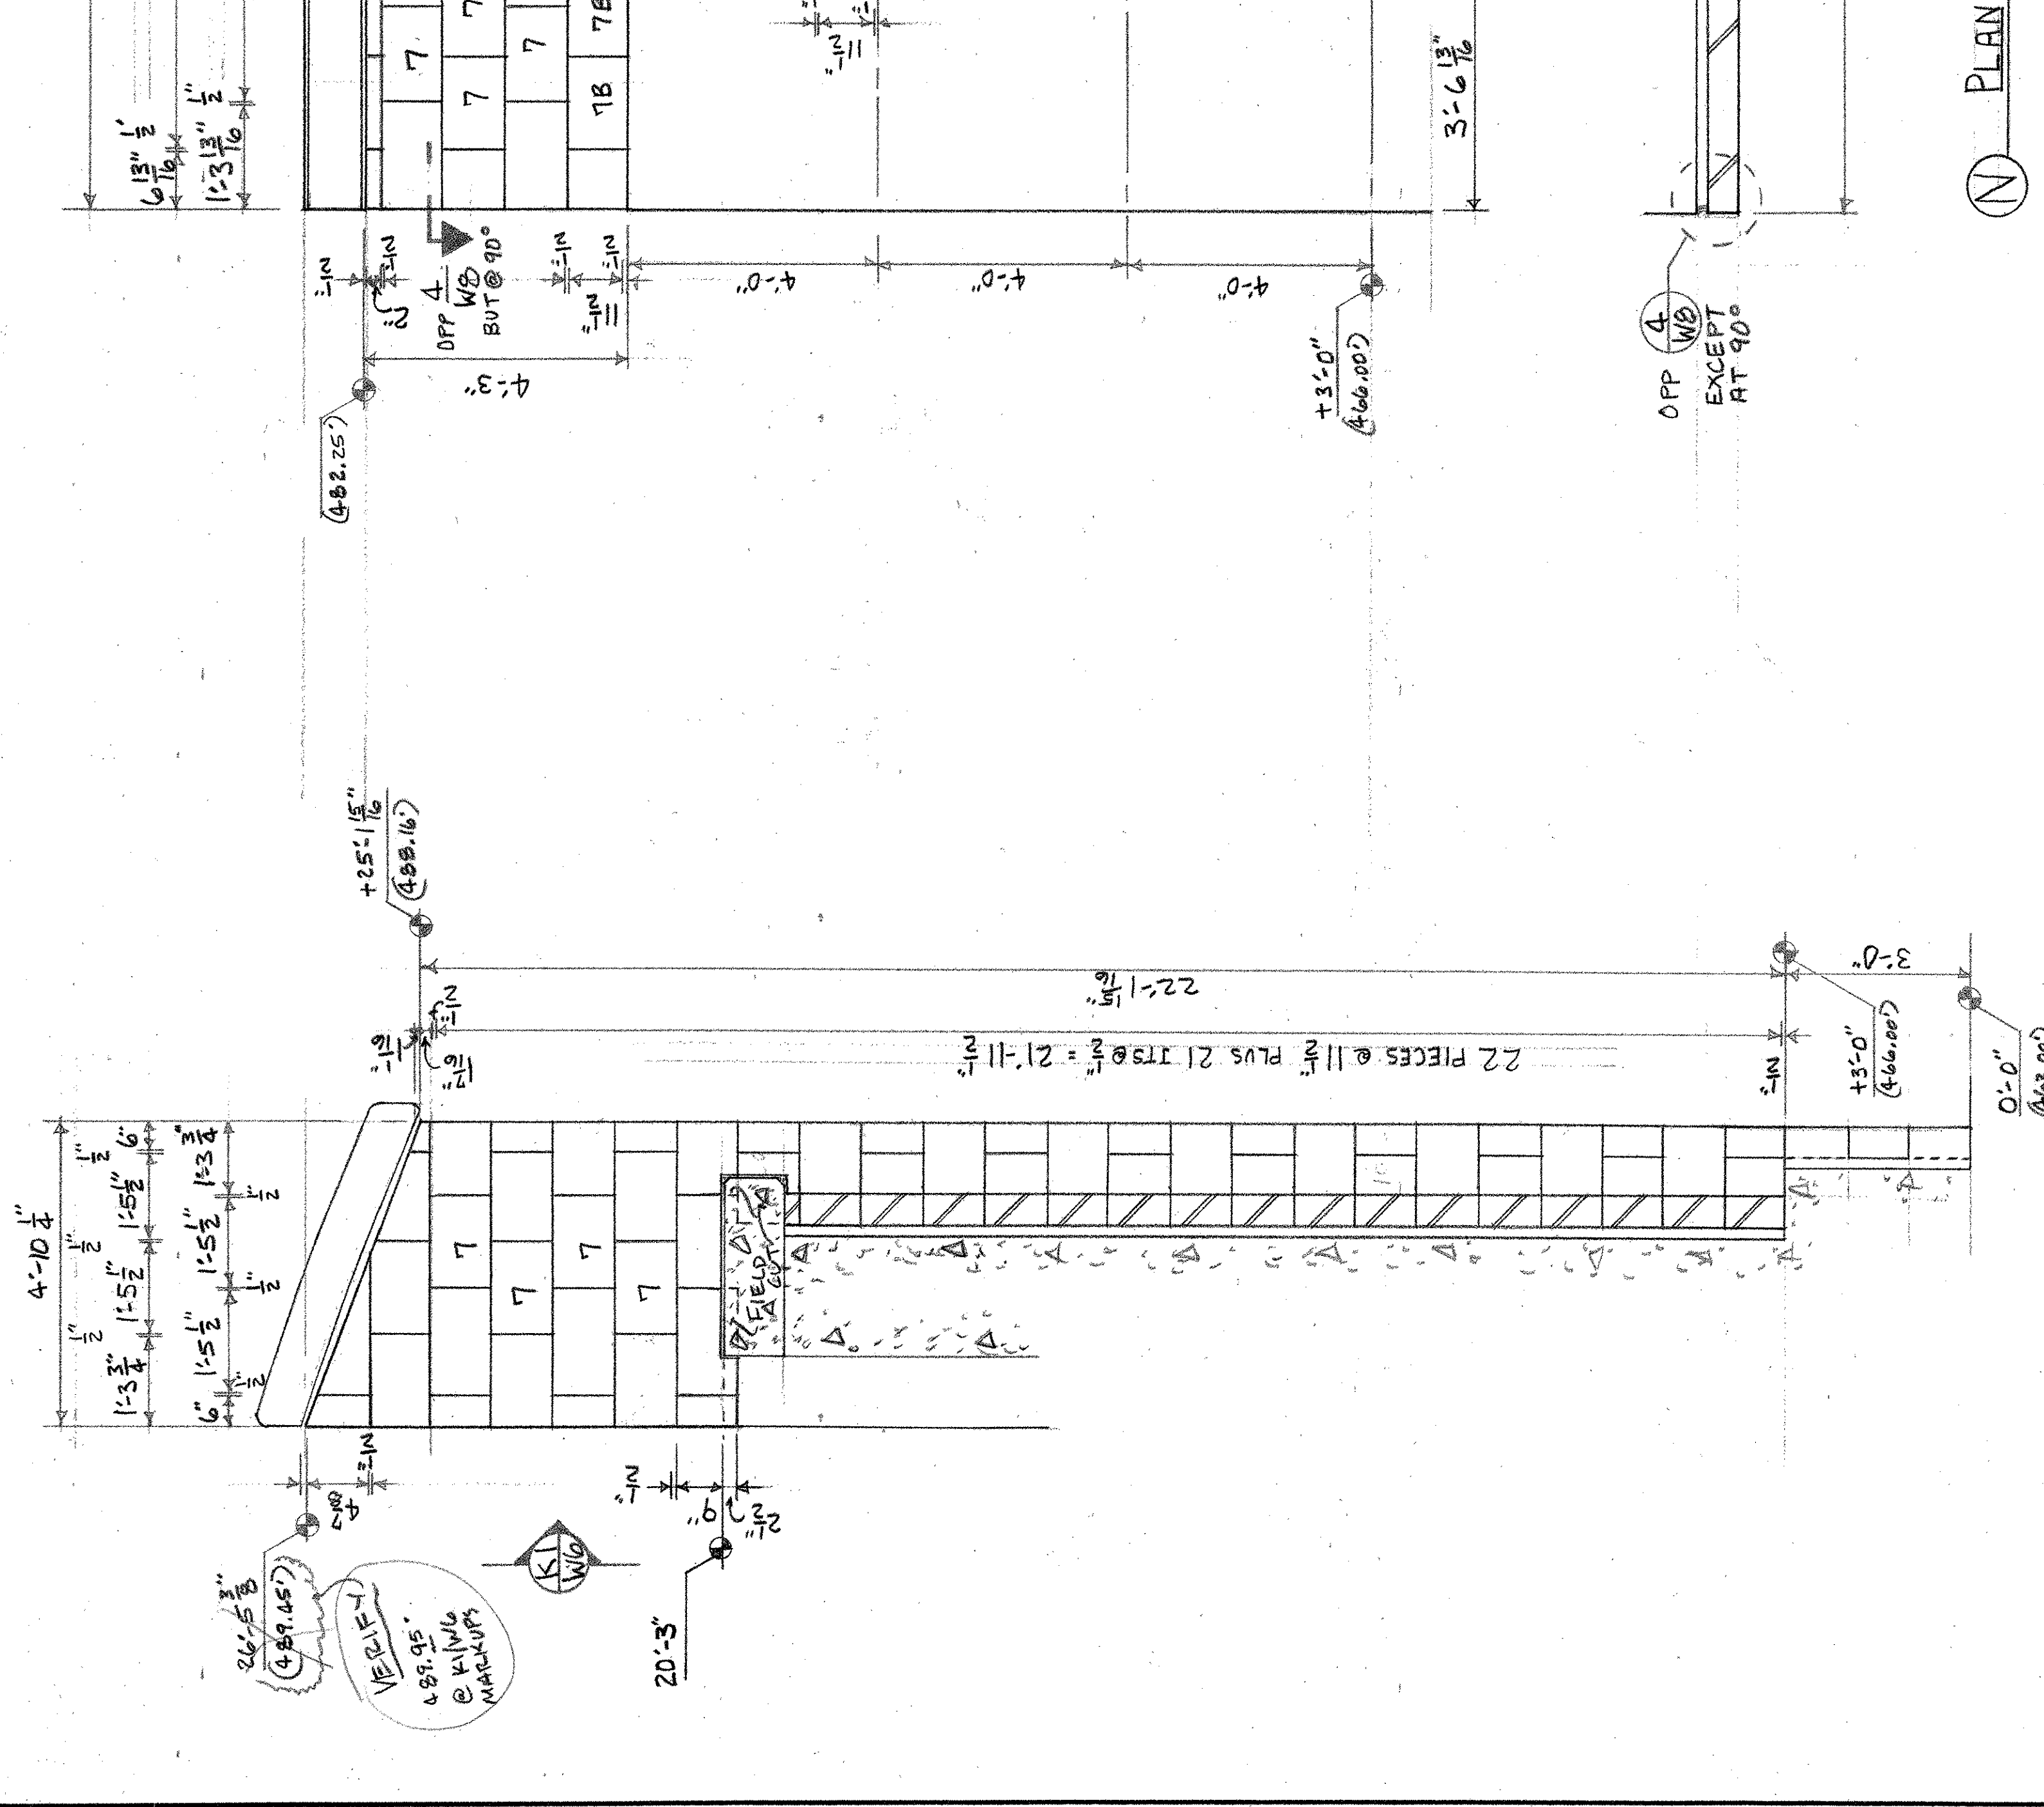

(12) ELEVATION

(N) PLAN & ELEVATION - WINGWALL # 3

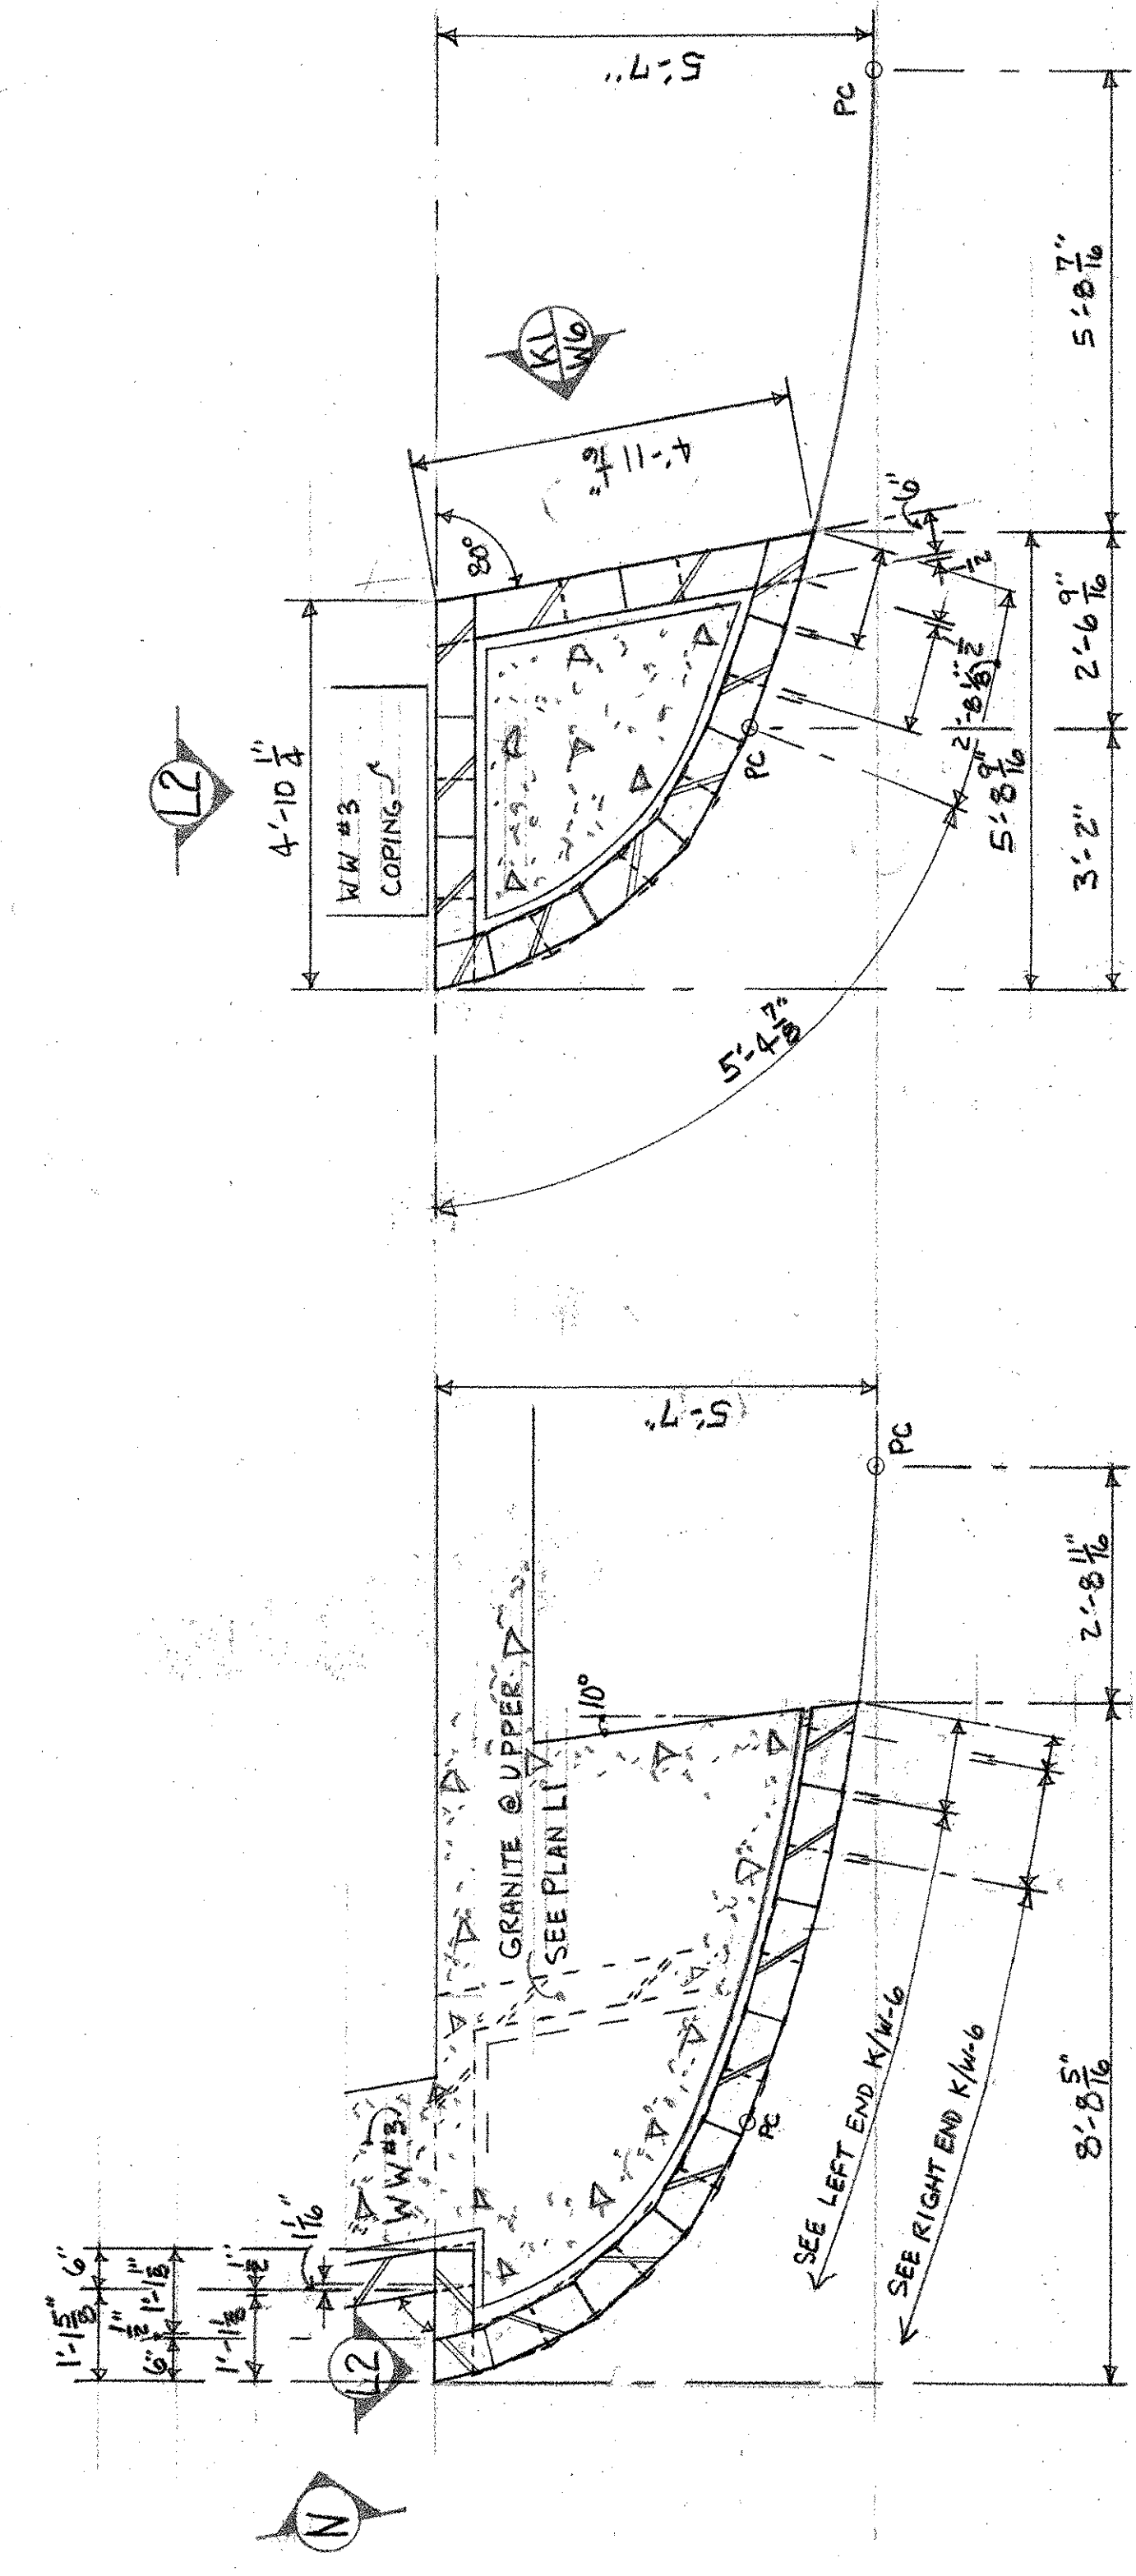

(L) PLAN

(11) PLAN

KEY PLAN
 SEE SHEET W-6

NOTE: This shop drawing represents the manufacturer's interpretation of the specifications, and our contract documents. It is not to be used for construction without the approval of the architect. No stone will be scheduled for procurement until the manufacturer has received approval from the architect. Any stone fabricated in accordance with this drawing is the property of the manufacturer. We assume no responsibility for the accuracy of the information shown on this drawing at the time they are approved. We assume no responsibility for the accuracy of the information shown on this drawing by other means.