



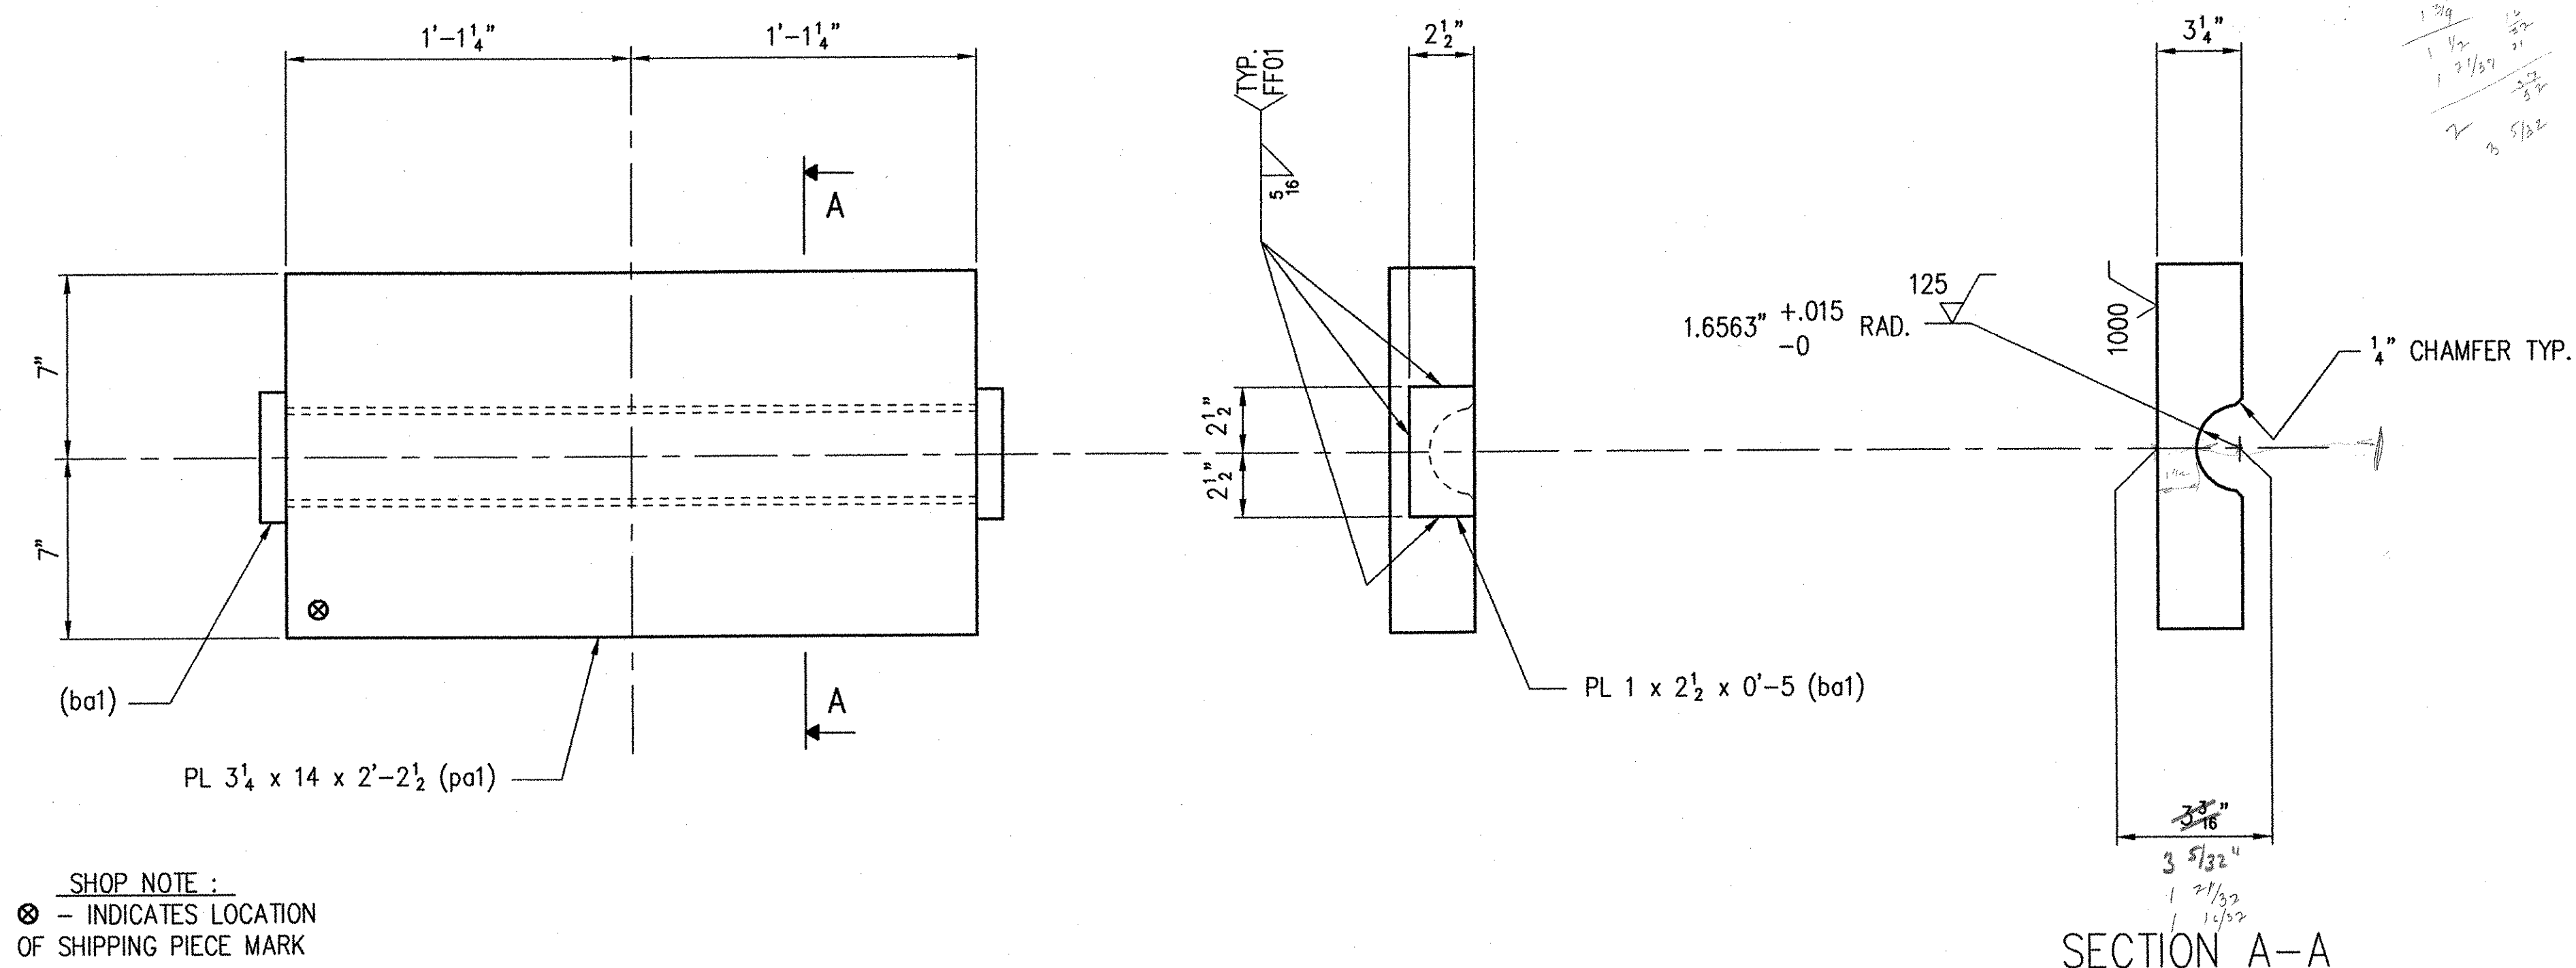

5 - SOLE PLATE ASSEMBLY - 1A

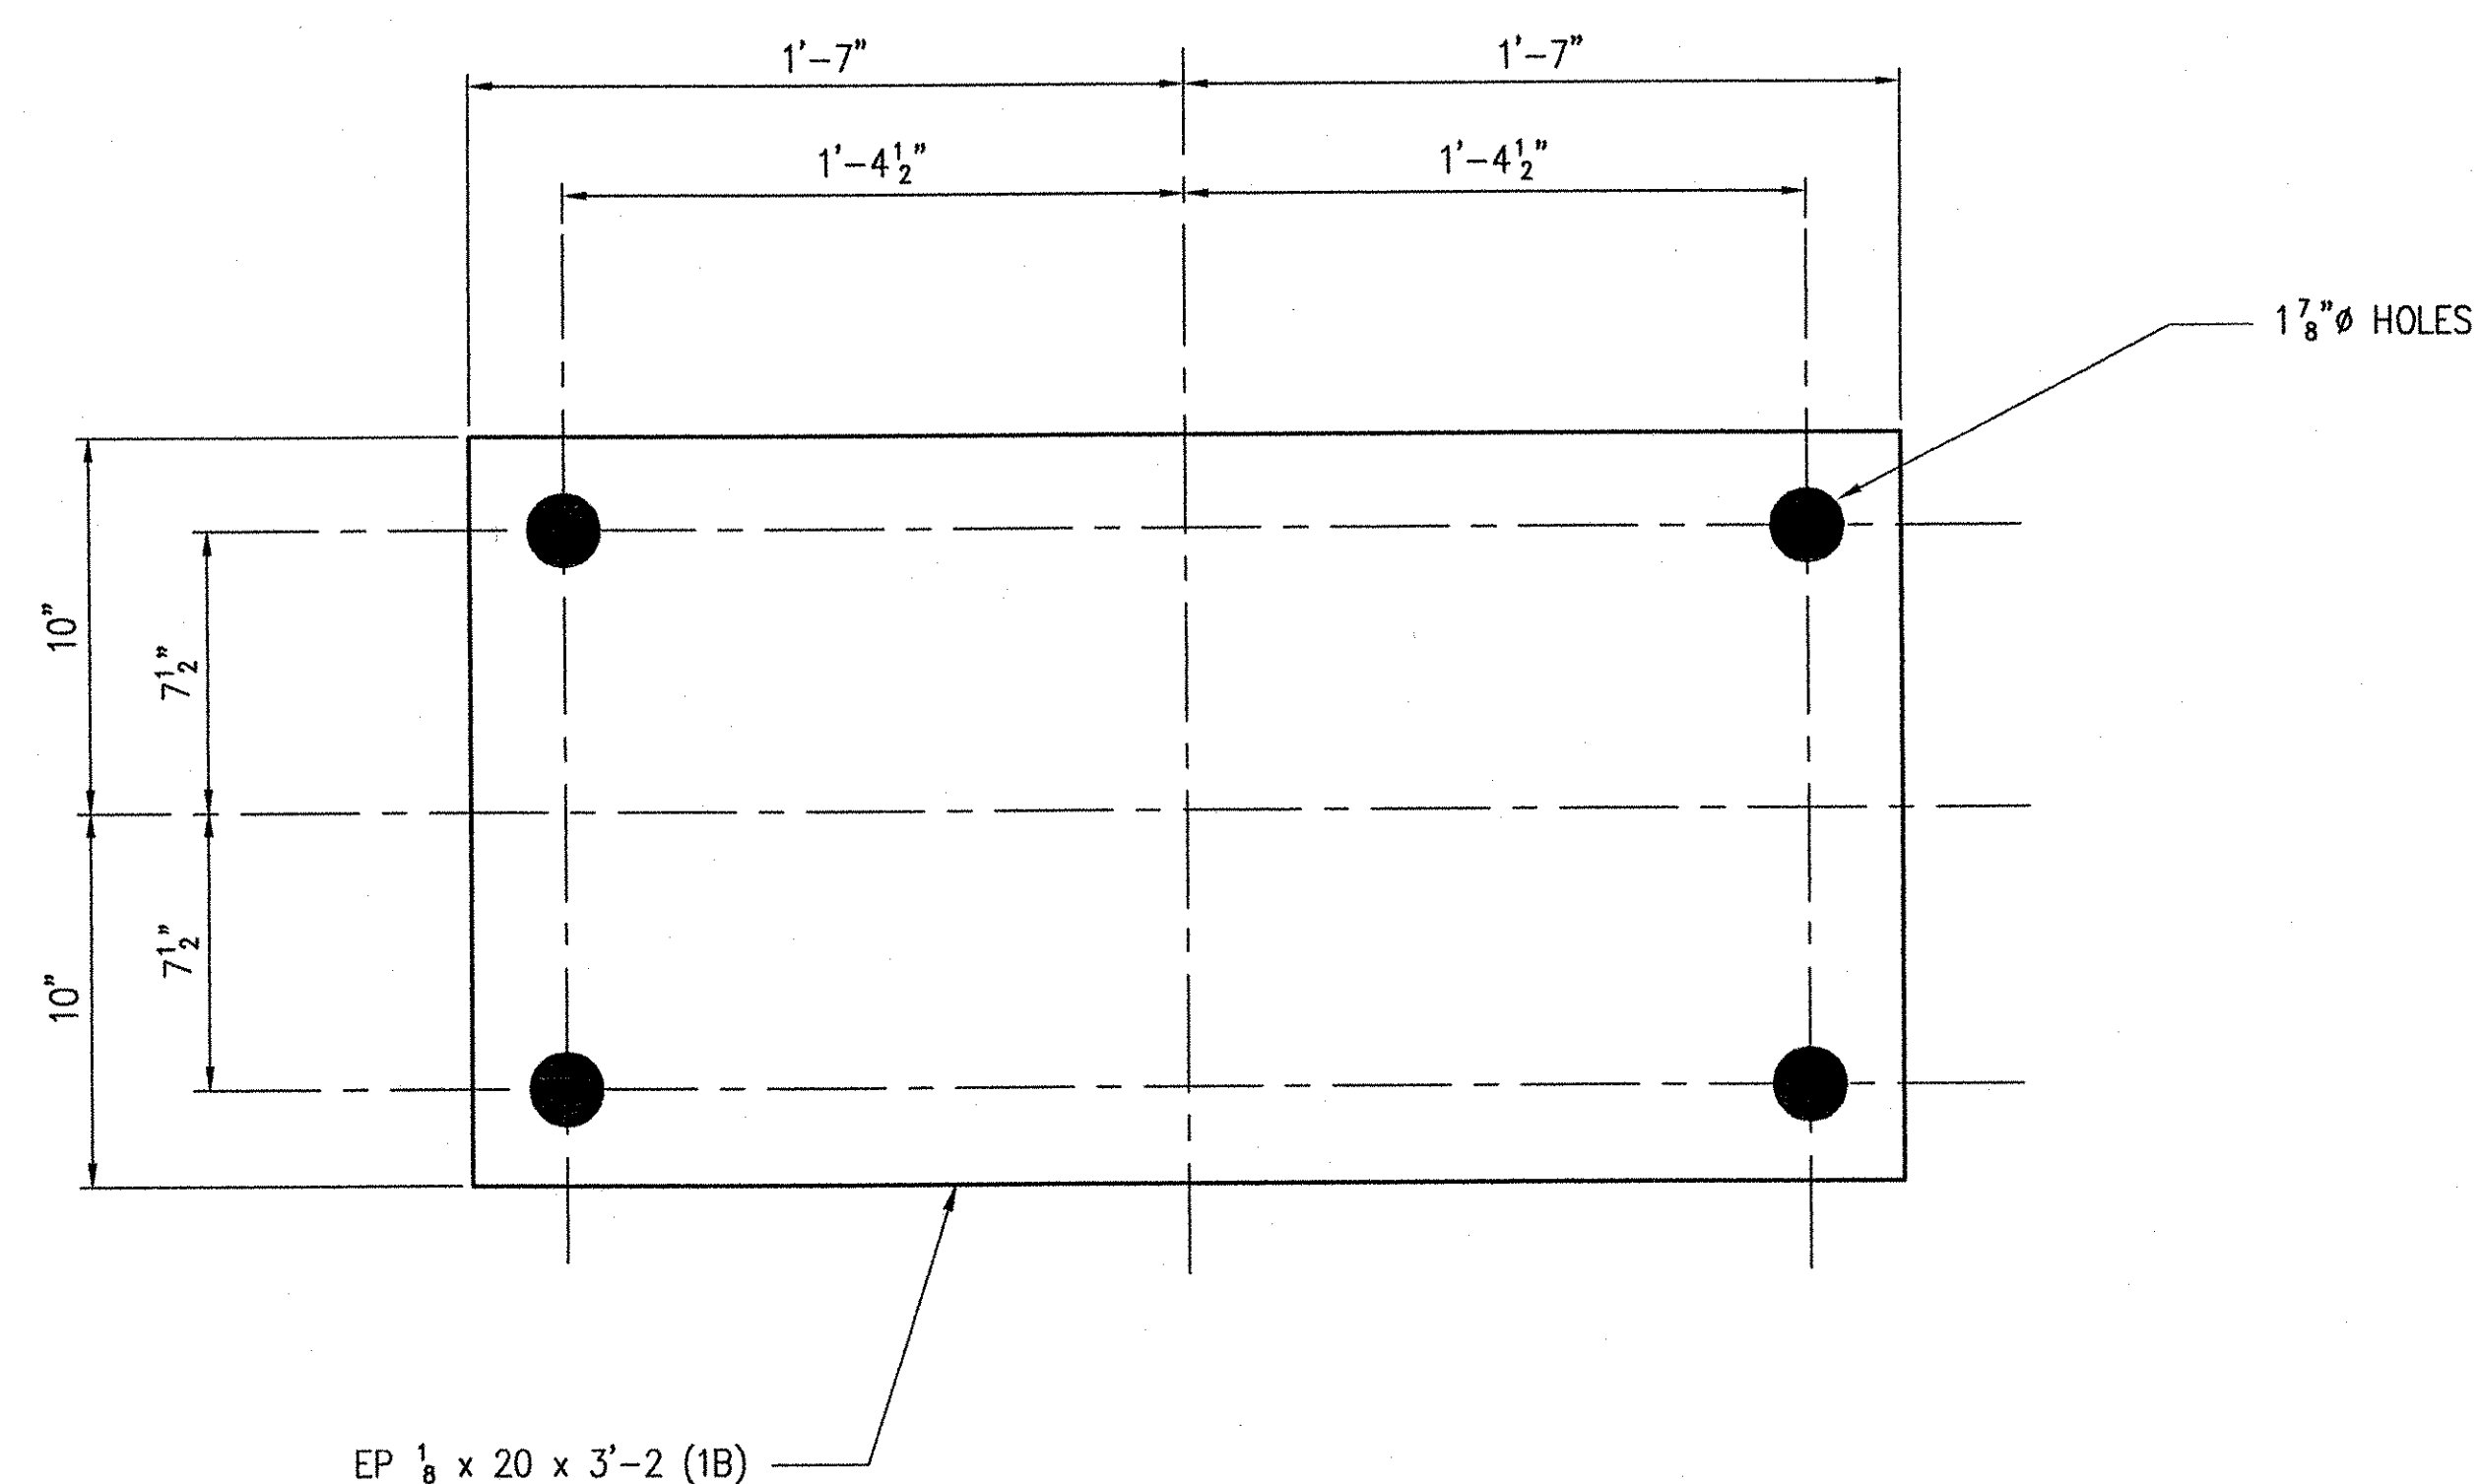

5 - BEARING PADS - 1B

RECEIVED
BY WSD CRD BY RSY
MAR 12 2001
APPROVED AS NOTED
BY OPW DATE 3/27/01

LINE	NO. REQD.	DESCRIPTION	LENGTH	MK	REMARKS	PART NO.
1	5	SOLE PLATE ASSEMBLY		1A	METALIZE/PAINT	
2	5	PL 3 1/4 x 14 A709 GR. 50	2'-2 1/2	pa1	MACH./ ADD MAT'L. FOR MACH.	
3	5	PL 1 x 2 1/2 A709 GR. 50	0'-5	ba1		19-60
4						
5						
6	5	BEARING PADS		1B	B	
7	5	EP 1/8 x 20	3'-2	1B	SEE NOTE 4	
8						
9						
REV.	DESCRIPTION	DATE	INT.
ANY AND ALL BACKCHARGES WILL BE REJECTED UNLESS WRITTEN CONSENT IS GIVEN BY LEWIS ENGINEERING COMPANY PRIOR TO ANY WORK PERFORMED FOR OUR ACCOUNT. SUCH REJECTION MEANS THAT INVOICES WILL NOT BE HONORED OR DEDUCTIONS FROM PAYMENT WILL BE CHARGED BACK.			



LEWIS ENGINEERING COMPANY

4201 NOREA DRIVE - CHASKA, MINNESOTA 55318 - (612) 368-3000

PROJECT

STATE PROJECT

FEDERAL PROJECT

CUSTOMER

LOCATION

DESCRIPTION

— ROYALTON/ RTE. NO. TH 1, CL 1 BRIDGE NO. 3

— AC BRZ 1444(22)

—

— BECK & BELLUCCI, INC.

— WINDSOR COUNTY, VT

— PIER FIXED BEARING DETAILS

ORIG.

W.P. chkd JCK

Drawn By TSF

Chk'd. By NY

Date: 2/01

SHEET NO. 1 OF 2	Job. No. : 2034.1121.1
------------------	------------------------