
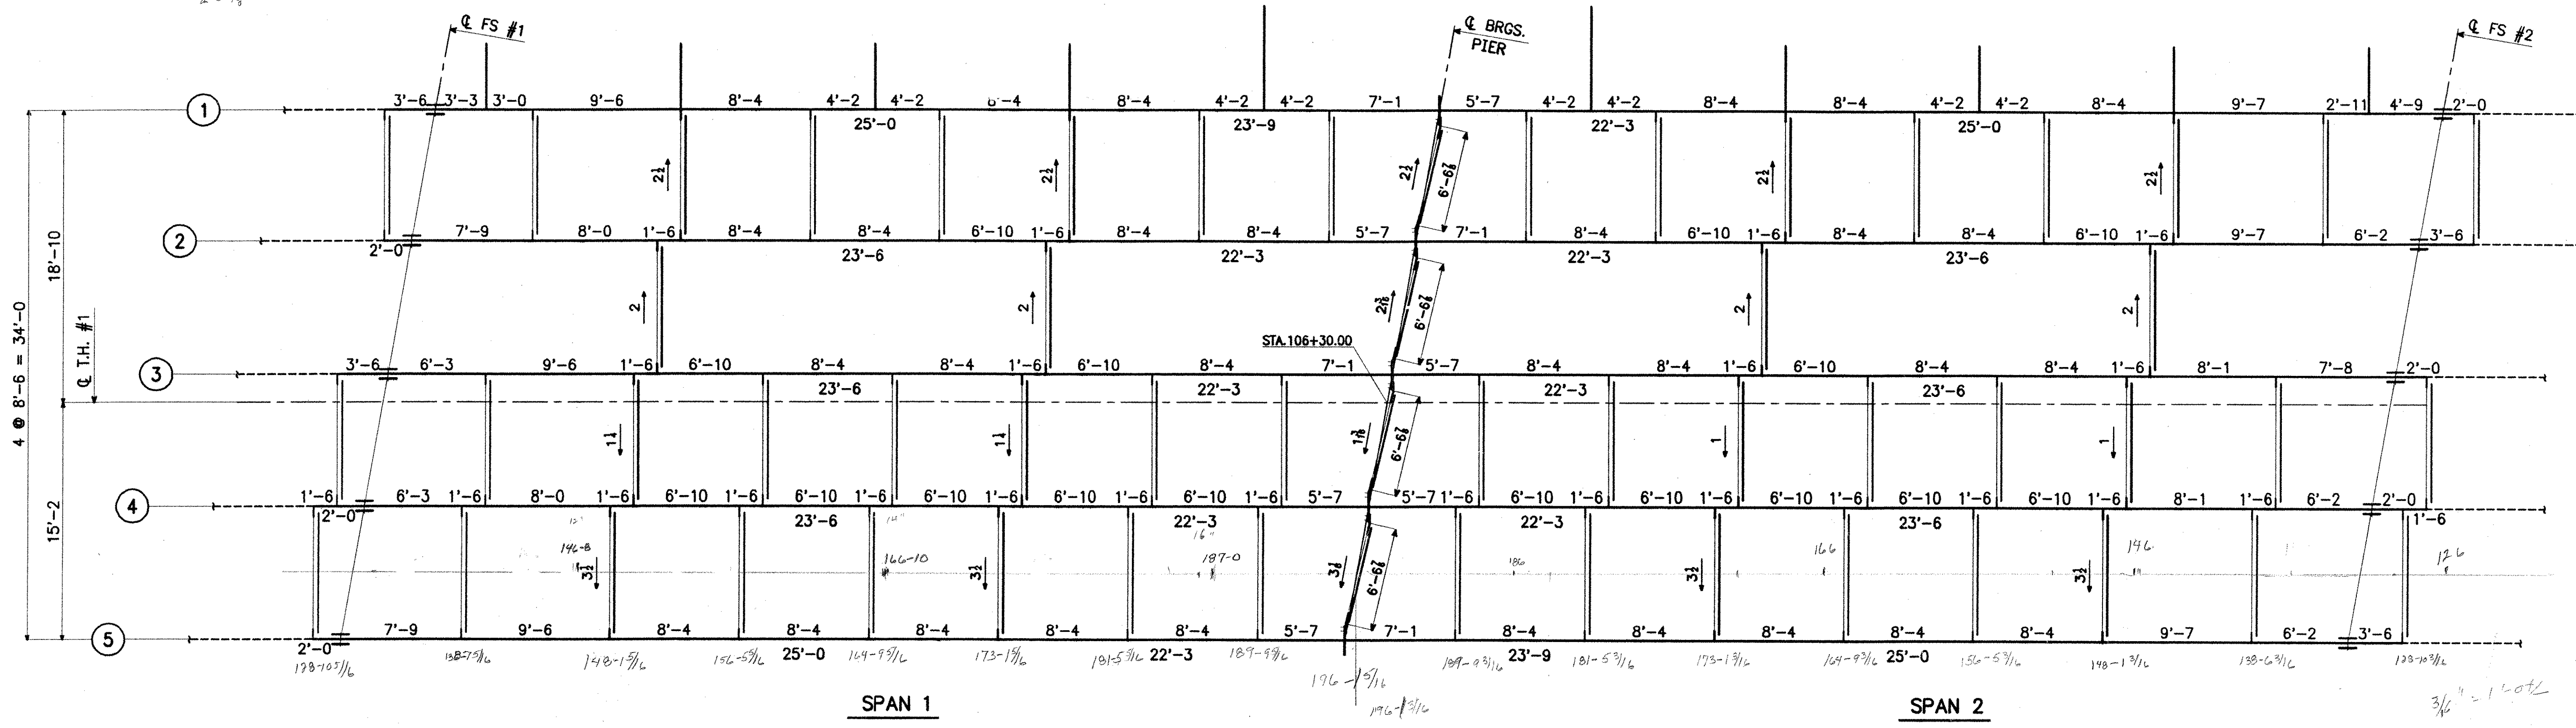


WORK ORDER NO.	DRAWING NO.	REV.
15873	WS1	B

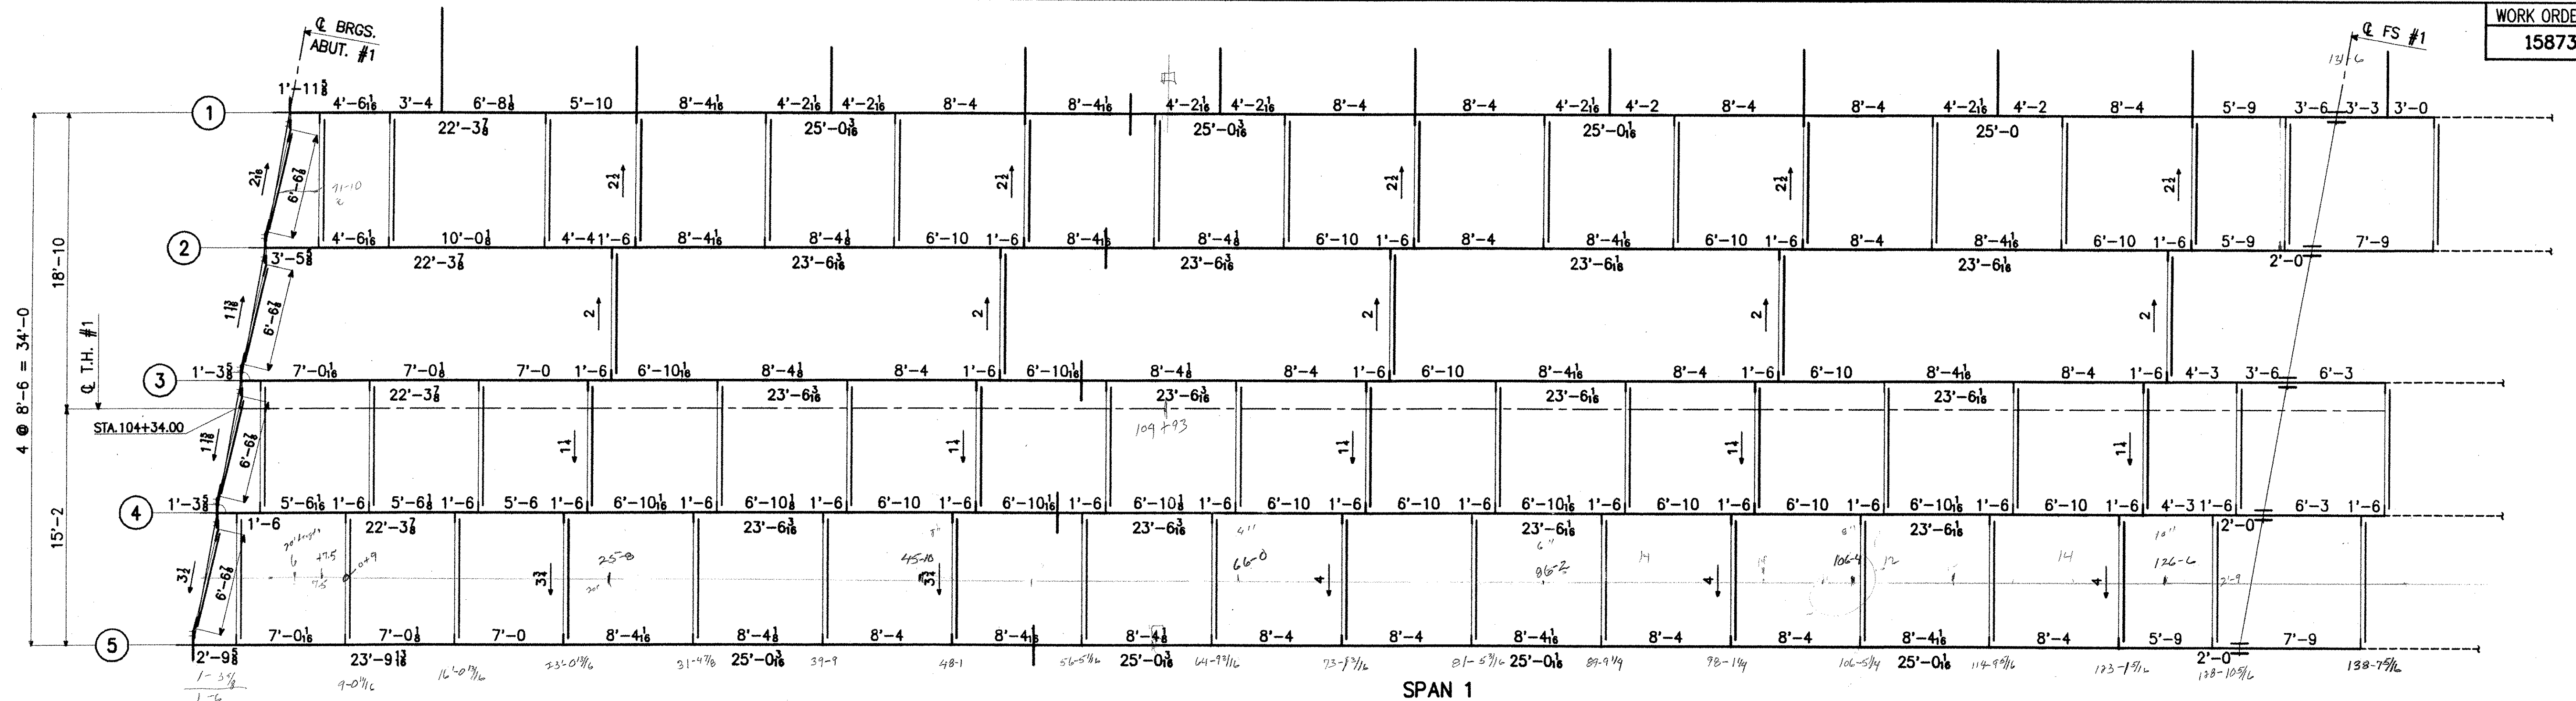

CALC PLAN

RECEIVED
 CK'D BY WGS OK'D BY _____
 AUG 27 2001
 RESUBMIT BY CPW APPROVED ✓
 DATE 8/30/01

- NOTES:**
- ALL LONGITUDINAL LENGTHS ARE DEVELOPED ALONG THE TOP OF WEB.
 - ALL TRANSVERSE DIMENSIONS ARE IN A HORIZONTAL PLANE.
 - ← ARROW POINTS TO LOW END.
 - BEARING STIFFENERS AND ENDS OF GIRDERS AND GIRDERS SHALL BE VERTICAL AFTER FULL DEAD LOAD DEFLECTION.

ITEM NO. 506.55		BR. NO. 3		PROJ. NO. BRZ 1444(22)	
TITLE: CALC PLAN					
APPROVED:					
PRINT DIST.					
5	4-7-01	APPR.			
ORIG.		FAB.			
5	7-13-01	APP			
5	8-24-01	APP			
National Eastern Corporation Plainville, Connecticut					
JOB: T.H. 1 OVER THE WHITE RIVER ROYALTON, VERMONT					
CUSTOMER: BECK & BELLUCCI, INC.					
DESIGNER: VERMONT AGENCY OF TRANSPORTATION					
WORK ORDER NO.		DRAWING NO.		REV.	
15873		WS1		B	
CHECKED	TS	3/01			
DRAWN	AV	3/01			